


OLD MAIN BUILDING
FLAGPOLE
LODGING
RESEARCH BUILDING
RESEARCH BUILDING
COOLING TOWER
MEDICAL RESEARCH BUILDING
AUXILIARY GENERATOR
SWITCHGEAR PAD
ADMINISTRATION BUILDING
RETAIL STORE
TRANSFORMER PAD
CANTEEN BUILDING
RESEARCH BUILDING
TEMP. OFFICE BUILDING
SUB-STATION
SUB-STATION
SMOKING SHELTER
TELEPHONE EQUIP. BUILDING
RETAIL STORE STORAGE
M.R.I. BUILDING
RADIATION THERAPY BUILDING
RESEARCH FACILITY
VERITY CREDIT UNION
FISHER HOUSE
MAIN HOSPITAL BUILDING

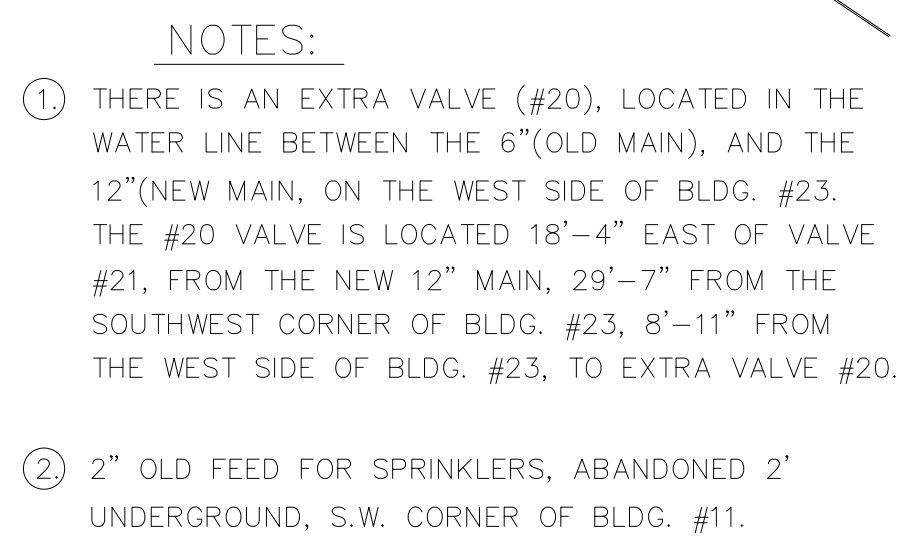

LEGEND

INDICATES WATER LINE ————

INDICATES WATER SHUT OFF VALVE —●—

INDICATES FIRE HYDRANT ●

[illegible]Department of
Veterans Affairs