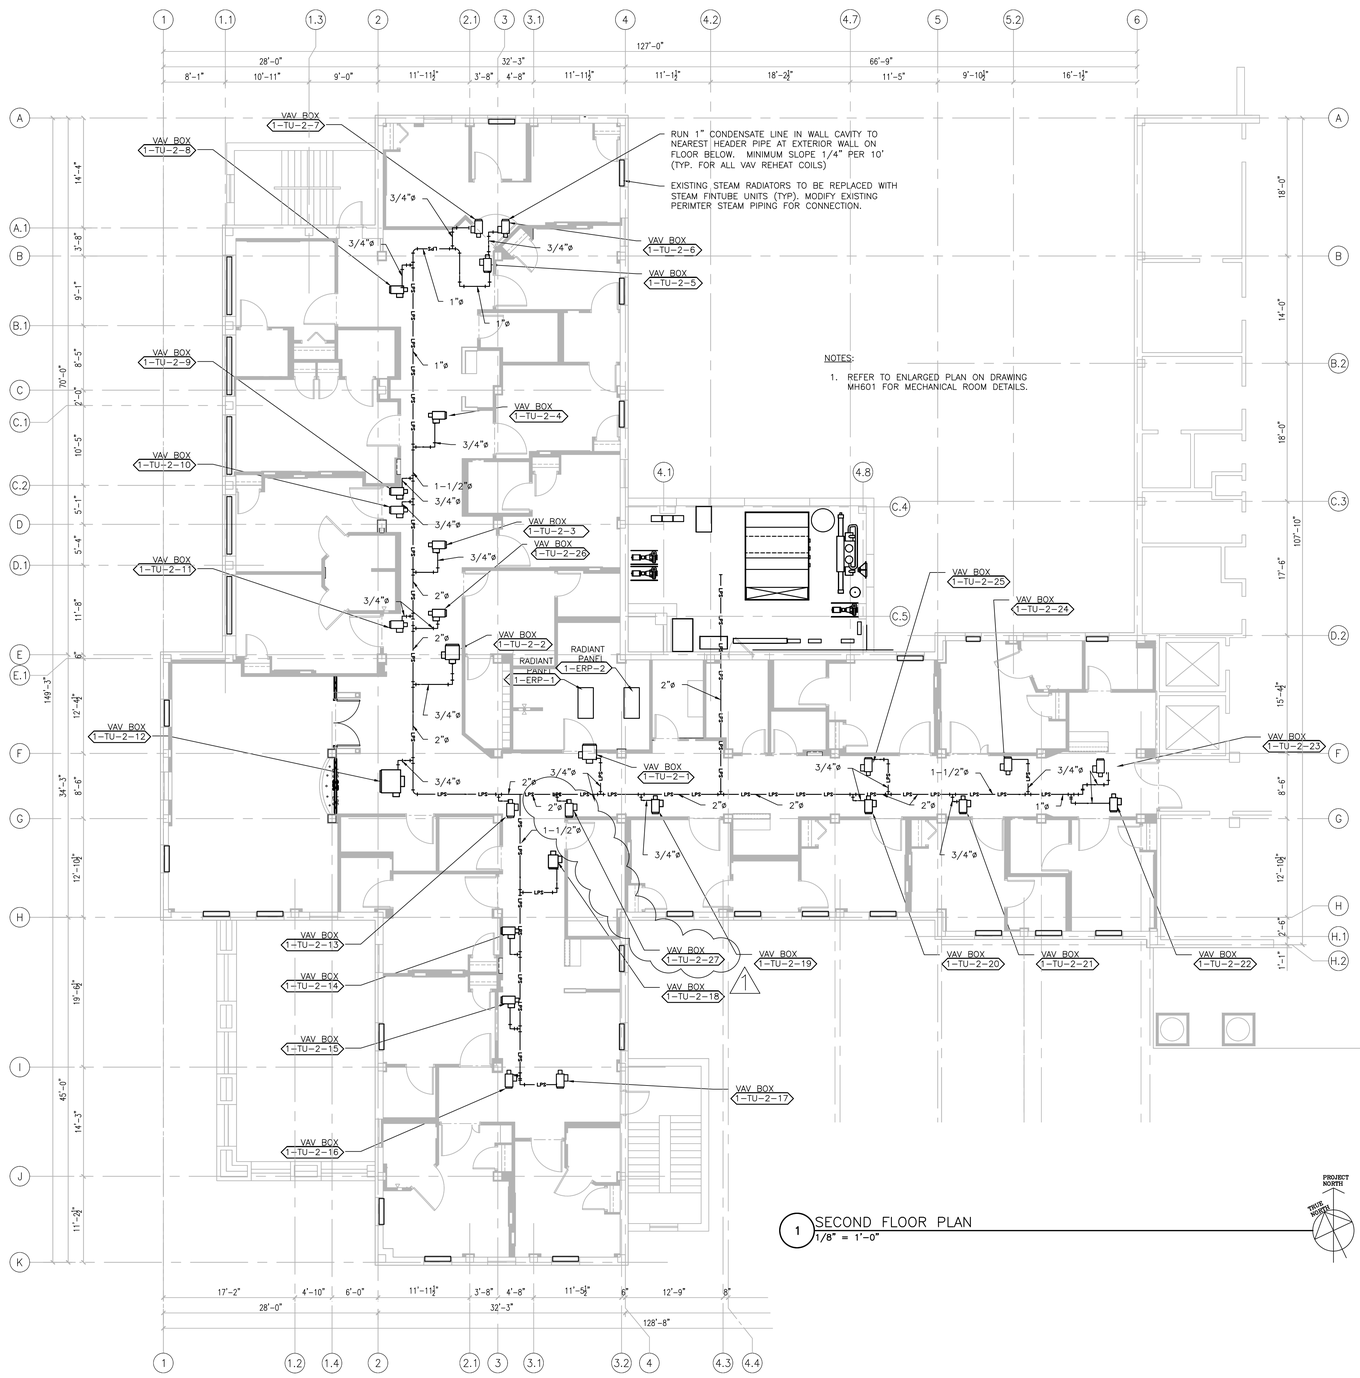

1 SECOND FLOOR PLAN
1/8" = 1'-0"

Addendum 1	6/21/12
100% Submission	7/02/10
90% Submission	5/27/10
60% Submission	4/22/10
Revisions	Date

VA WESTERN NEW YORK HEALTHCARE SYSTEM
3495 BAILEY AVENUE
BUFFALO, NEW YORK 14215

URS
BUFFALO, NY.,
77 GOODELL ST
716-856-5636
Architect

stamp

CARDIOLOGY	DATE	ENGINEERING MANAGER	DATE
INFECTION CONTROL	DATE	CARELINE MANAGER	DATE
SAFETY OFFICER	DATE	CHIEF OF STAFF	DATE

MEDICAL CENTER DIRECTOR DATE

ASSOCIATE MEDICAL CENTER DIRECTOR DATE

Drawing Title
SECOND FLOOR ("WARD B") MECHANICAL PIPING PLAN

Project Title
RENOVATION OF BLDG #1, 2ND FLOOR, B-WARD

Location
V.A.M.C. BATAVIA, NEW YORK

Date
JULY 2, 2010 (UPDATED 10/07/10)

Station No.
528

Building Number	Checked	Drawn
09-352 MH-203		

Office of Facilities
Department of Veterans Affairs