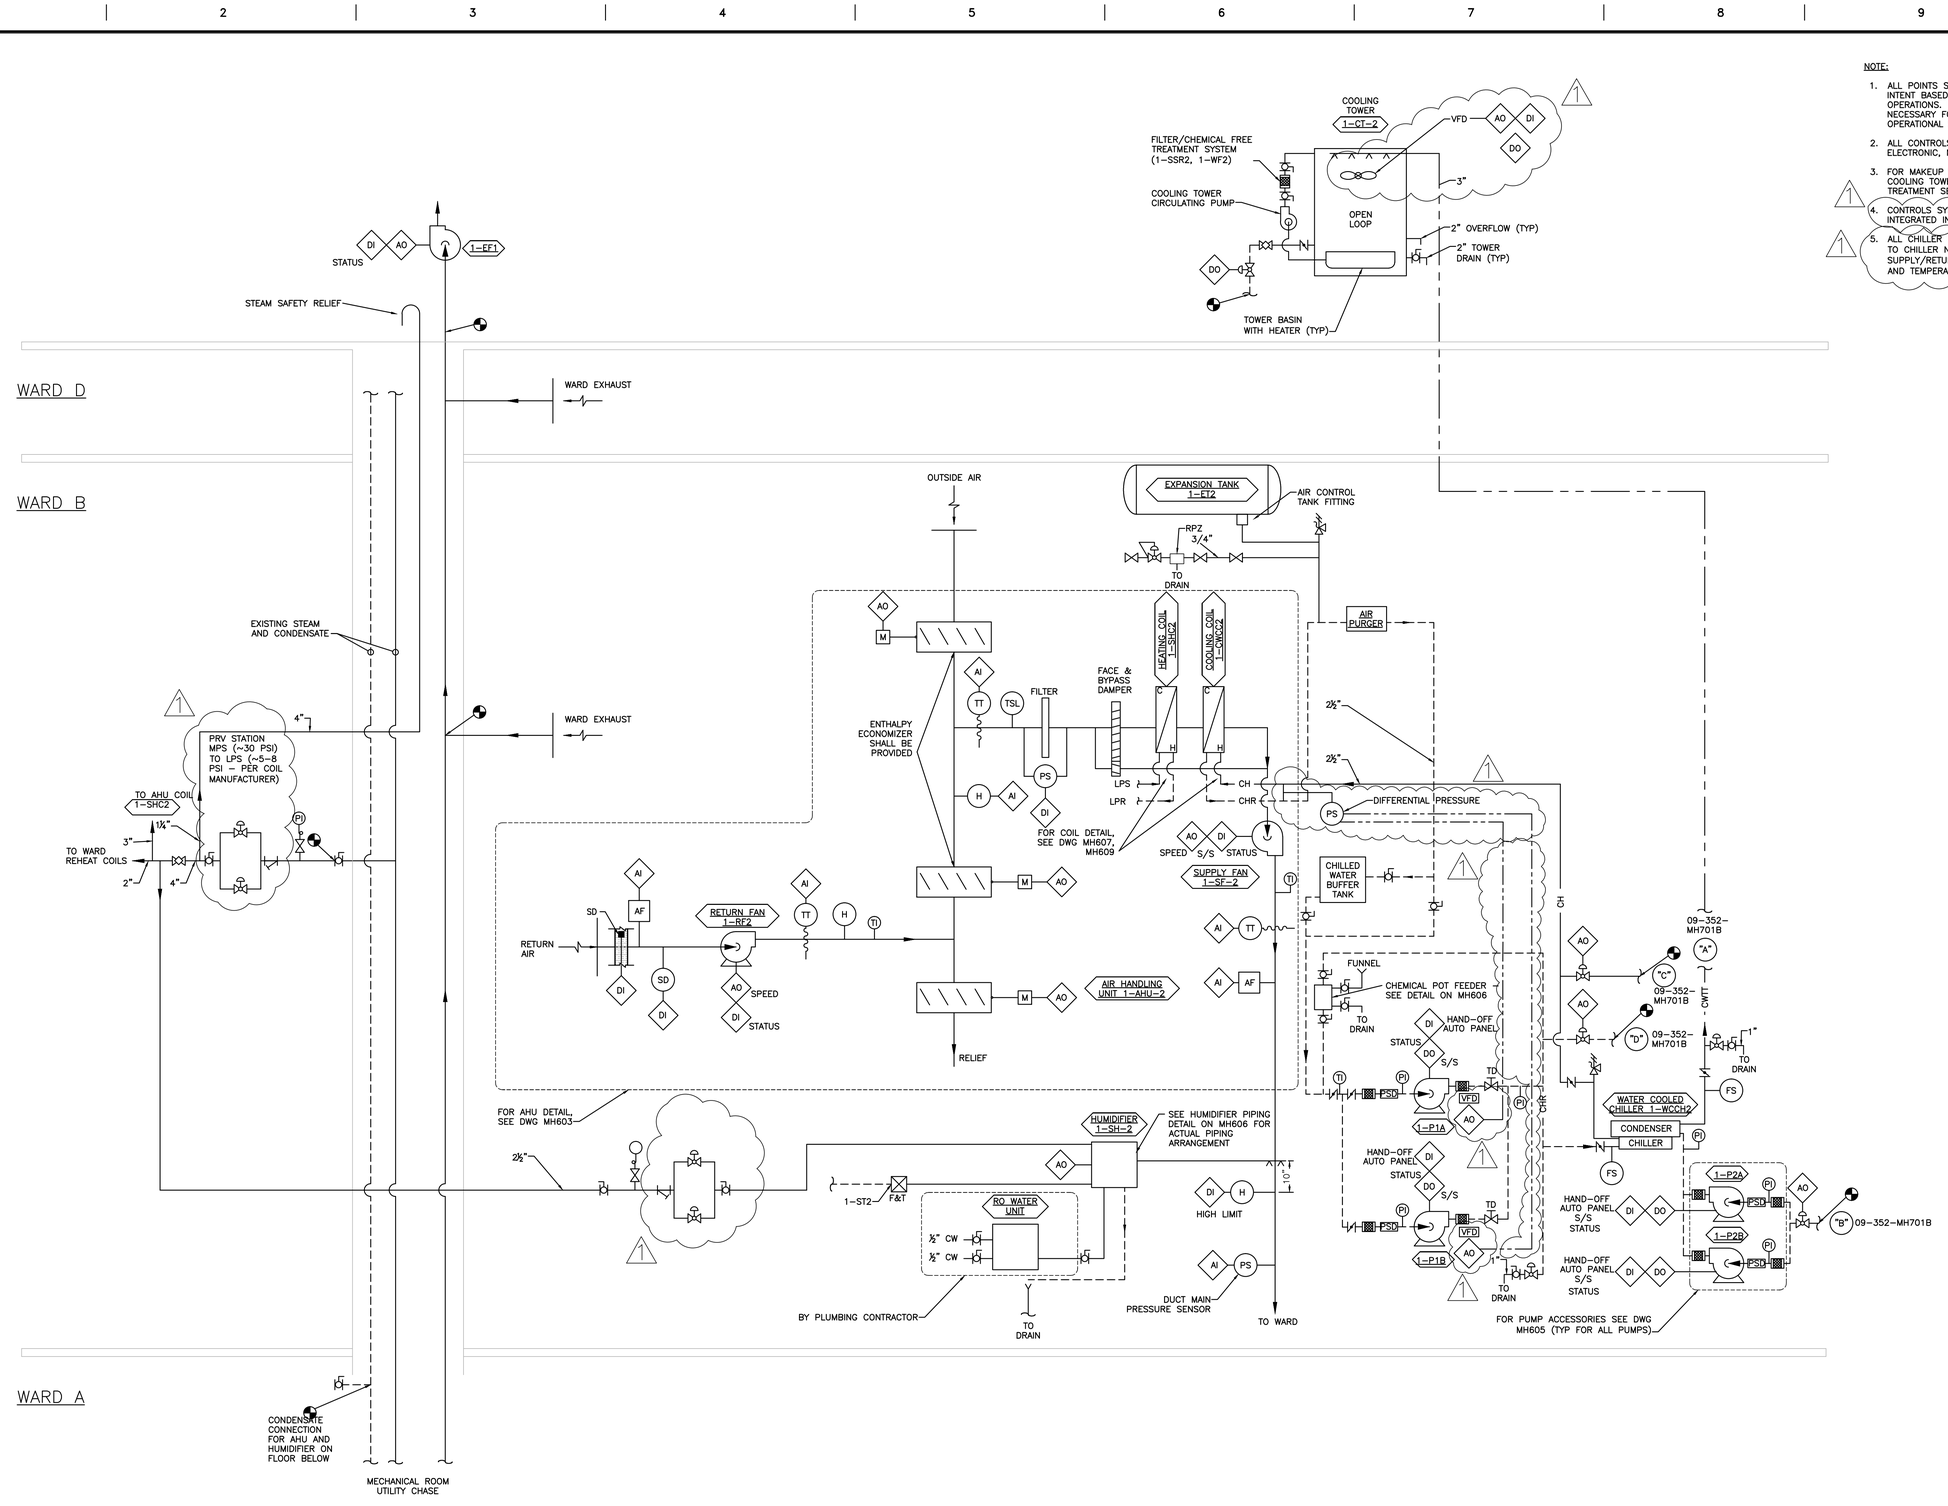

Revisions	Date
Addendum 1	6/21/12
100% Submission	7/02/10
90% Submission	5/27/10
60% Submission	4/22/10

VA WESTERN NEW YORK HEALTHCARE SYSTEM
3495 BAILEY AVENUE
BUFFALO, NEW YORK 14215

URS — BUFFALO, NY., 77 GOODELL ST 716-856-5636
Architect

stamp

CARDIOLOGY	DATE	ENGINEERING MANAGER	DATE
INFECTION CONTROL	DATE	CARELINE MANAGER	DATE
SAFETY OFFICER	DATE	CHIEF OF STAFF	DATE

MEDICAL CENTER DIRECTOR DATE

ASSOCIATE MEDICAL CENTER DIRECTOR DATE

Drawing Title: MECHANICAL PIPING SCHEMATIC

Project Title: RENOVATION OF BLDG #1, 2ND FLOOR, B-WARD

Building Number: 1 | Checked: AAA | Drawn: BBB

Location: V.A.M.C. BATAVIA, NEW YORK

Date: JULY 2, 2010 (UPDATED 10/07/10)

Station No.: 528

09-352 MH-701A

Office of Facilities — Department of Veterans Affairs