


NTS

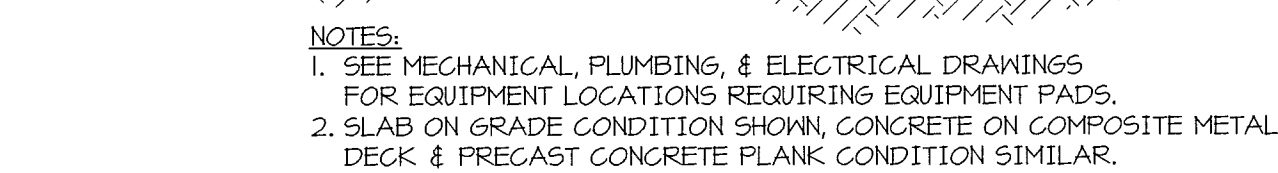


NOTE: PER RFI #15 RESPONSE, $\frac{1}{4}$ "x2x8x0'-8" BEARING PLATES WITH (2)-1/2"x4"x4" HEADED STUDS 5' GAGE, CENTERED ON $\frac{1}{4}$ " $\frac{1}{4}$ " BE USED IN PLACE OF THE BEARING PLATE ASSEMBLIES SHOWN. SHOP WELD BOTTOM STUDS/ANCHORS AND FIELD WELD BEAM BOTTOM FLANGE TO TOP OF BEARING $\frac{1}{4}$ " $\frac{1}{4}$ " USE THIS PLATE FOR ALL BEAMS BEARING ON CMU. LENGTH OF $\frac{1}{4}$ " $\frac{1}{4}$ " TO MATCH BEARING LENGTH SHOWN IN I250.2 SCHEDULE WHEN GREATER THAN 8" LENGTH OF BEARING.

12



$$I'' = I' - \emptyset''$$


NTS

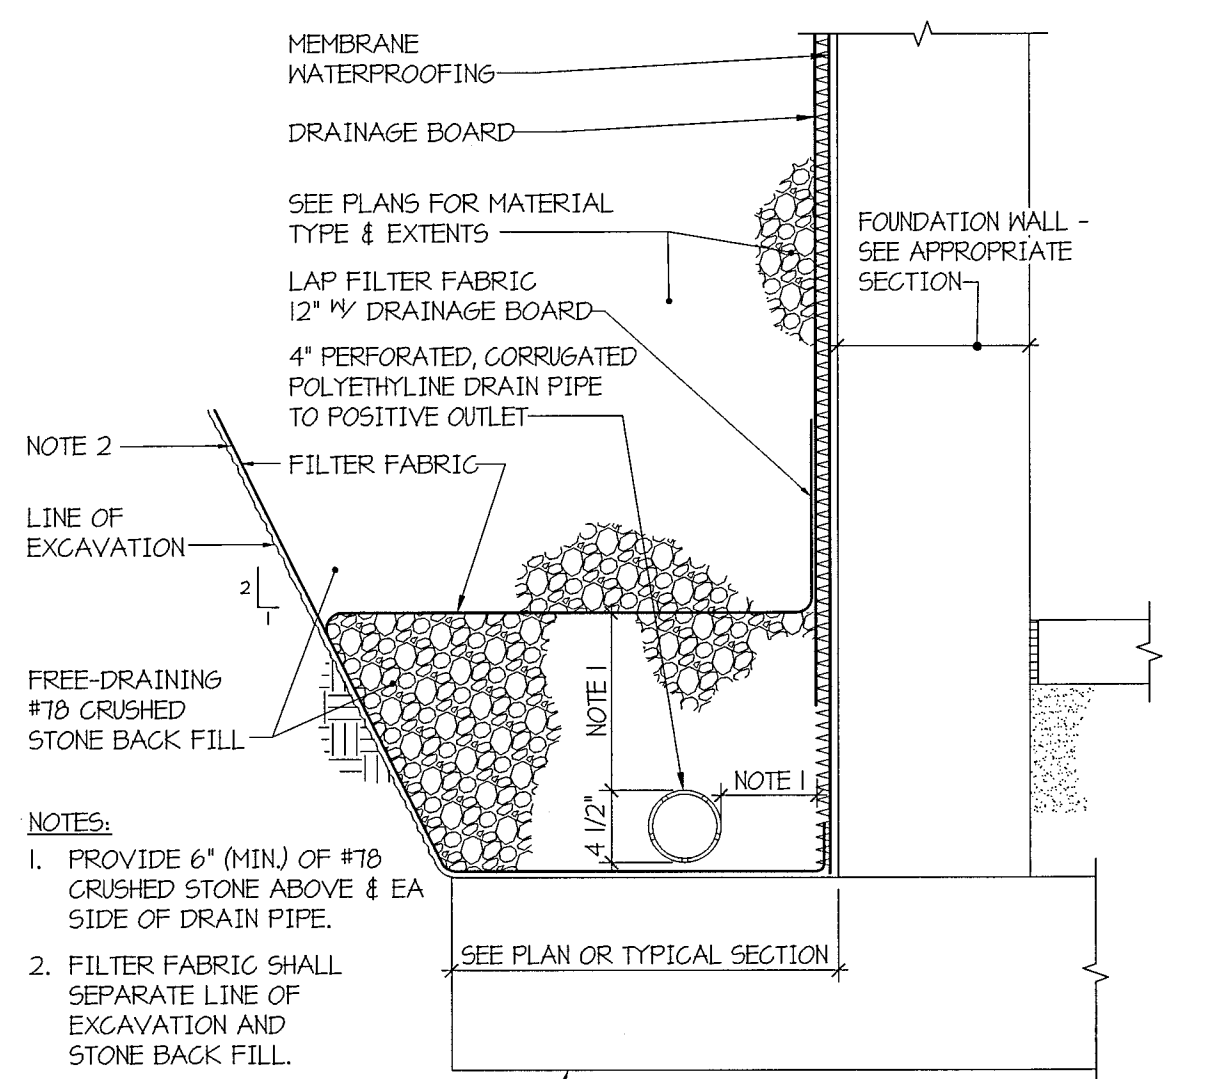

NTS


BEAM SIZE	PLATE SIZE	HEADED STUDS
W8, W12	PL 1/2"x12"x1'-0"	6 - 5/8"φ x 6"
W14, W16	PL 1/2"x12"x1'-4"	8 - 5/8"φ x 6"
W24	PL 1/2"x12"x2'-0"	12 - 5/8"φ x 6"

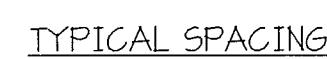



NTS



NTS | ||

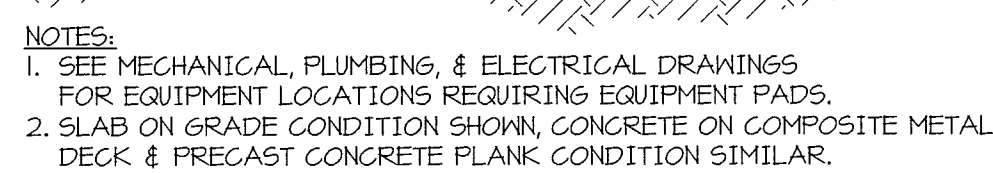

NTS

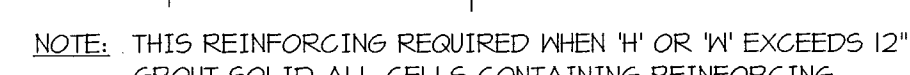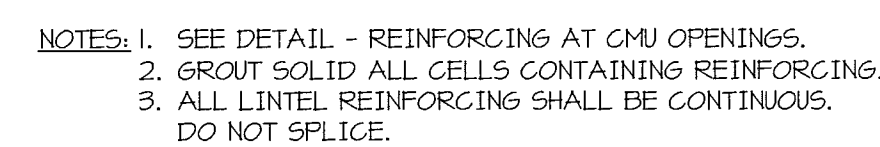

NTS | ||



$$\frac{3}{4}'' = 1'-0''$$


NTS



NTS


CONSULTANTS:

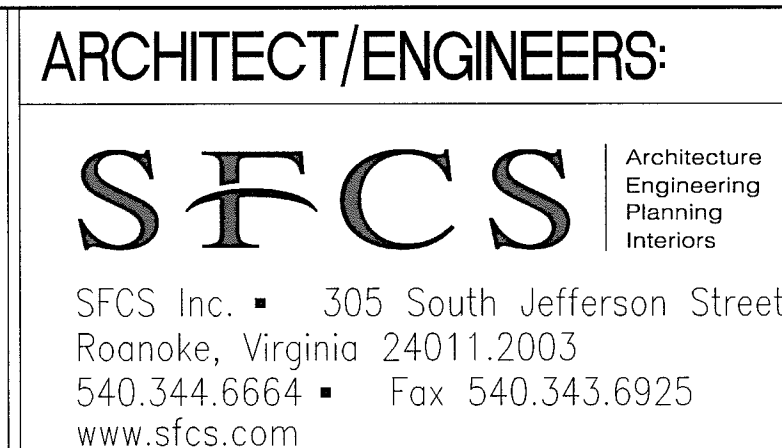

Approved: Project Director

Location	Beckley, West Virginia
----------	------------------------

Drawn PJW	Drawing Number S0.2 Dwg <u>45</u> of
--------------	---

 Department of
Veterans Affairs