GENERAL NOTES:
1. SEE DRAWING GI010 AND GI011 FOR PROJECT GENERAL NOTES, ABBREVIATIONS, SYMBOLS AND LEGENDS, ETC.

KEYNOTE LEGEND

KEY	DESCRIPTION
DE1	REMOVE EXISTING ROOFING SYSTEM IN ITS ENTIRETY. PREPARE EXISTING CONCRETE ROOF SLAB FOR NEW FLOOR FINISHES.
DE2	REMOVE EXISTING FLOOR DRAIN/ROOF DRAIN/VENT PIPE/ETC. & PATCH FLOOR WITH CONCRETE TO FULL THICKNESS OF EXISTING FLOOR SLAB & PROVIDE 2 HOUR FLOOR RATING. SEE ALSO MECH. DRAWINGS & #/AS502
DE3	REMOVE EXISTING EXTERIOR WALL, BRICK & APC COPING DOWN TO BELOW EXISTING FLOOR/ROOF SLAB LEVEL IN PREPARATION FOR NEW CONSTRUCTION.
DE4	SAWCUT NEW OPENING IN EXISTING CONCRETE FLOOR/ROOF SLAB FOR NEW STAIR EXTENSIONS. SEE ALSO STRUCTURAL DRAWINGS.
DE5	REMOVE EXISTING CURTAIN WALL AND INTERIOR FURRING WALLS UP TO ABOVE NEW ADDITION ROOF.
DE6	REMOVE EXISTING WINDOW & SILL WALL BELOW IN PREPARATION FOR NEW CONSTRUCTION.
DE7	REMOVE EXISTING ROOF ACCESS LADDER IN ITS ENTIRETY.
DE8	REMOVE EXISTING BRICK VENEER CLADDING TO EXTERIOR SHEATHING & DOWN TO FLOOR LEVEL. PREPARE WALL AND FLOOR FOR NEW FINISHES.
DE9	REMOVE VERTICAL SLOT OF EXISTING EXTERIOR BRICK TO EXPOSE STUD WALL WEATHER BARRIER MEMBRANE IN PREPARATION FOR NEW EXTERIOR WEATHER BARRIER TIE-IN.
DE15	REMOVE EXISTING EXHAUST DUCT/FAN ROOF CURB.
DE17	FILL EXISTING OPENING W/ CONCRETE FULL THICKNESS OF EXISTING. SEE 8&9/AS502
DE18	REMOVE EIFS FROM WDW. SILL DOWN TO 3RD FLOOR LEVEL
DP3	REMOVE EXISTING WALL FOR NEW WORK AS INDICATED ON PLANS. PATCH ANY REPAIRS REQUIRED ON REMAINING WALLS.

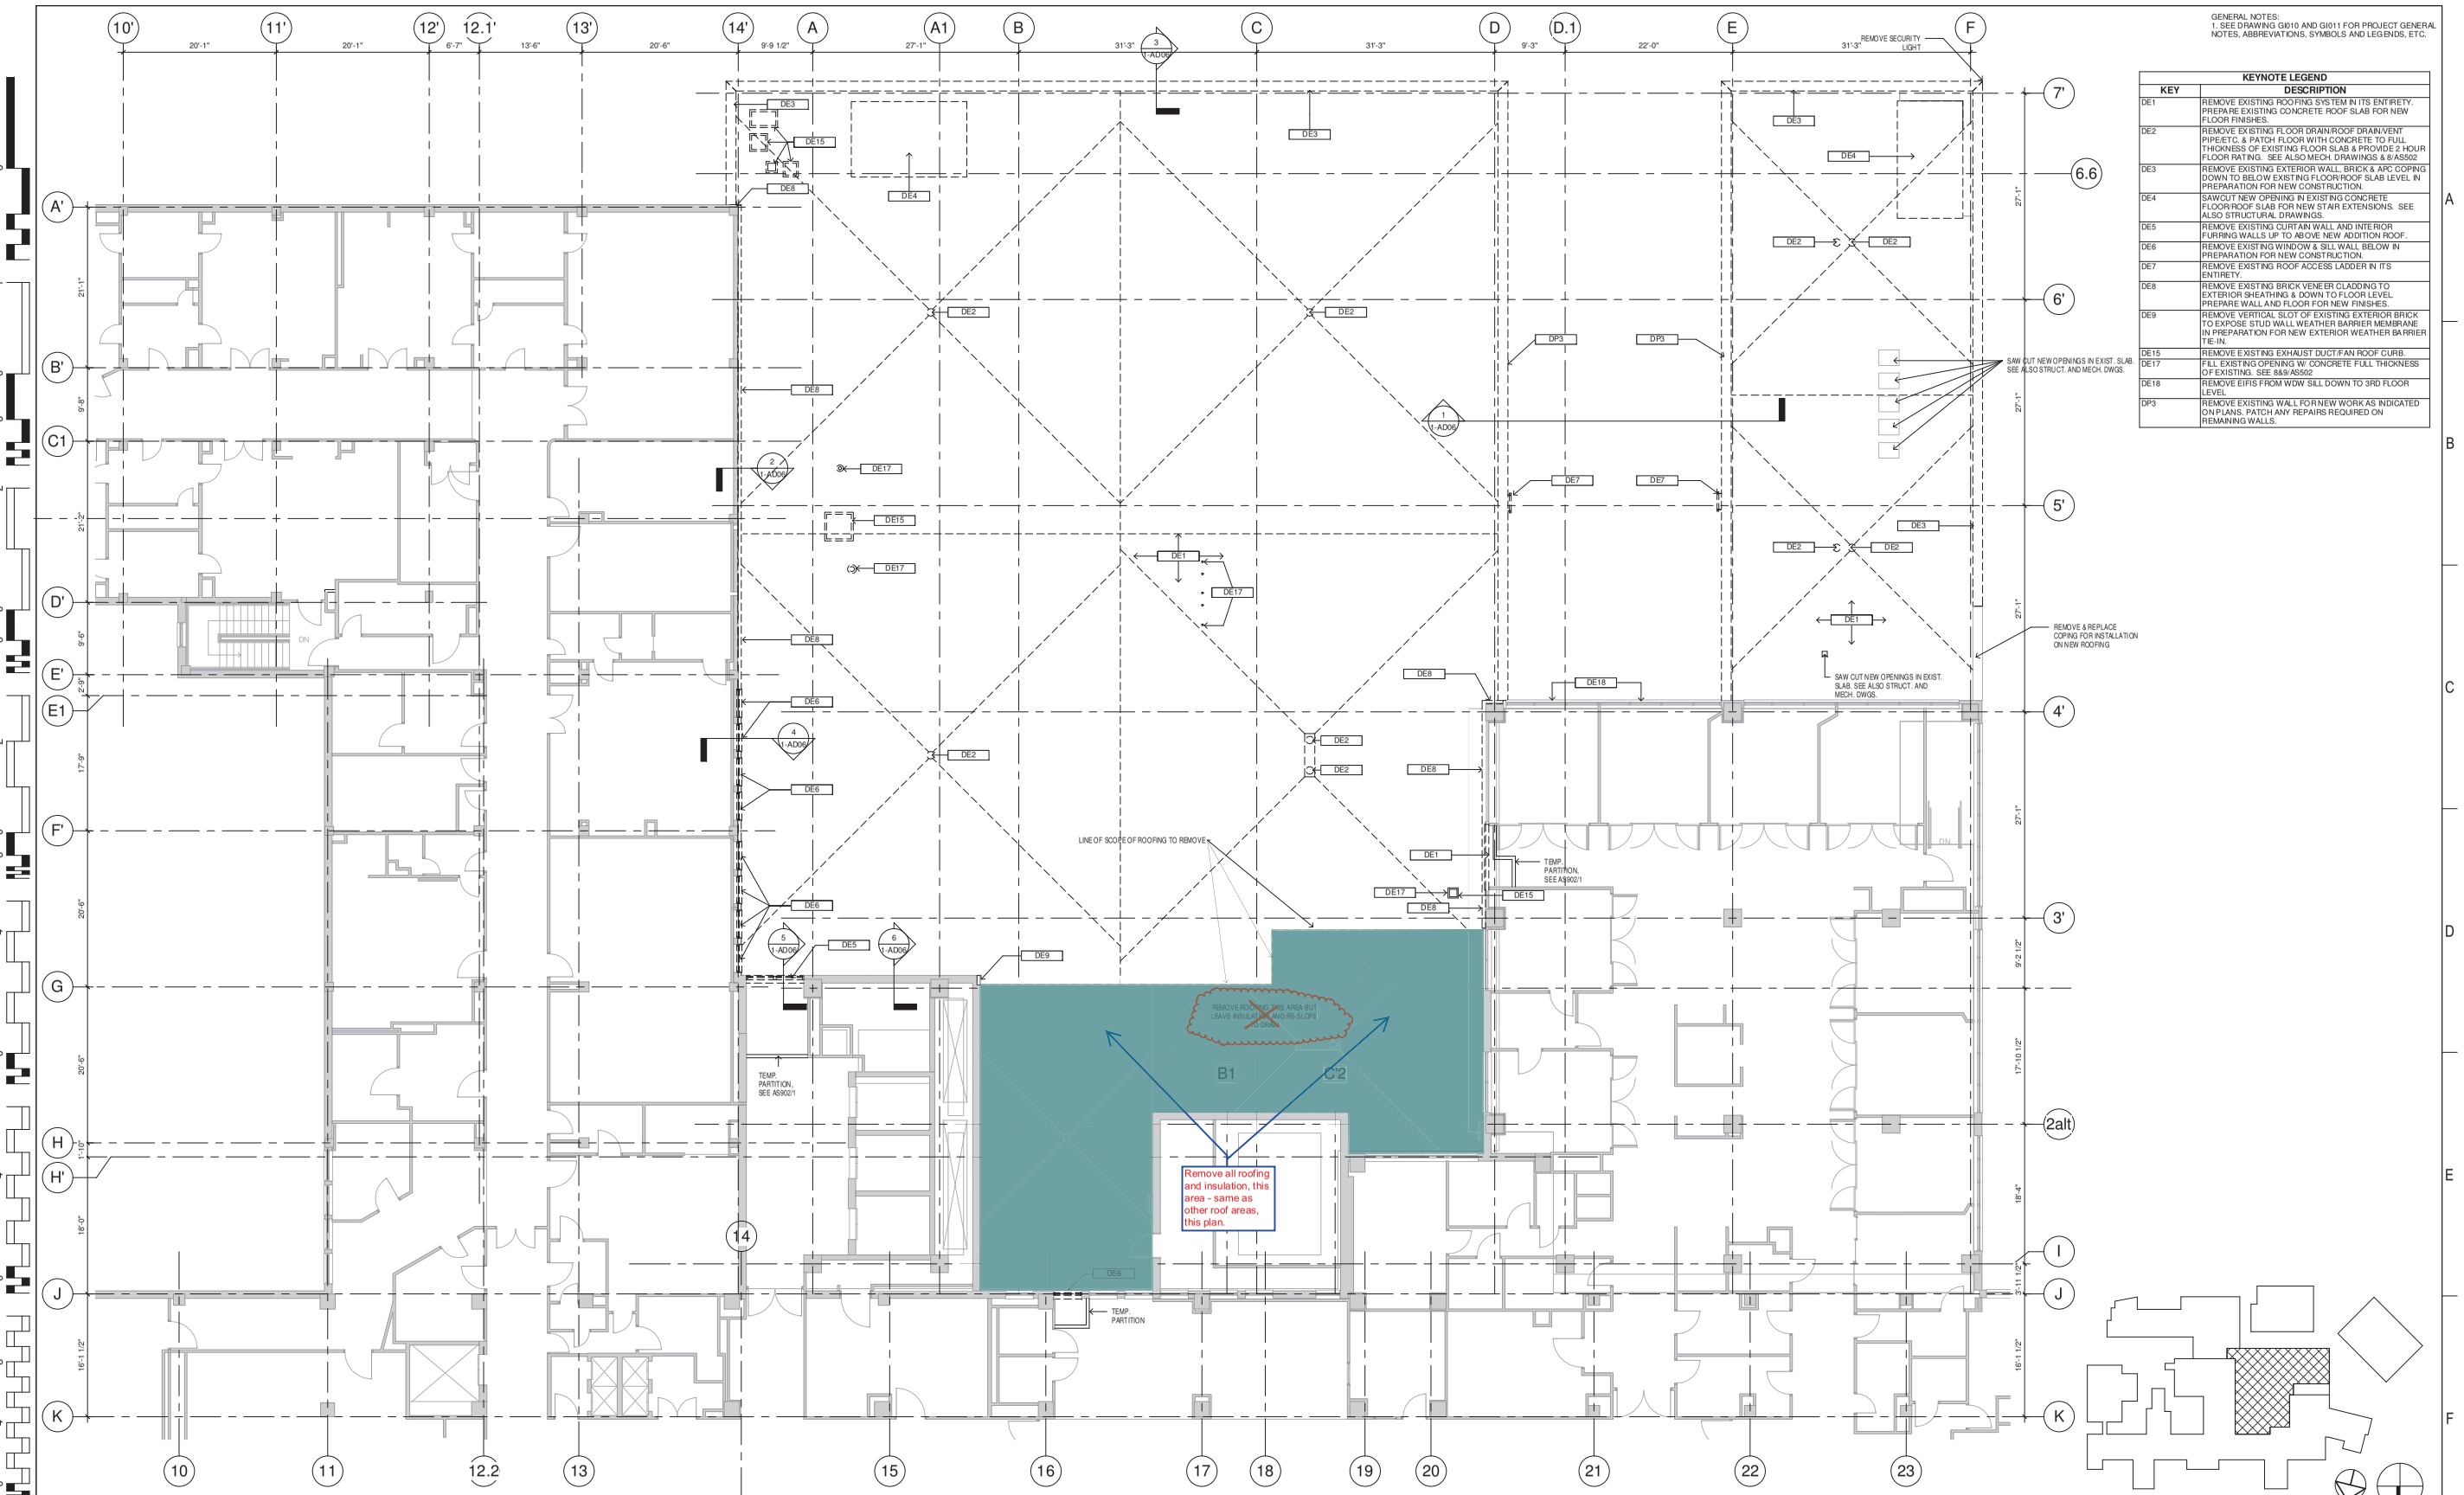

04.FOURTH FLOOR- 1/8" PLAN DEMO - PHASE 1
1/8" = 1'-0"

Revisions:	Date

CONSULTANTS:

MECH/ELEC/PLUMBING	STRUCTURAL	FIRE PROTECTION
Ellerbe Becket, Inc	Ellerbe Becket, Inc	FP&C CONSULTANTS, INC
800 LaSalle Ave, Suite 250 Minneapolis, MN 55402	800 LaSalle Ave, Suite 250 Minneapolis, MN 55402	One Ward Parkway Suite 200 Kansas City, MO 64112
t: 612.376.2000 f: 612.376.2271	t: 612.376.2000 f: 612.376.2271	t: 816.931.3377 f: 816.931.3378

CERTIFICATION/SEAL.

ARCHITECT/ENGINEERS/COST ESTIMATORS:

ELLERBE BECKET
2380 McGee Street, Suite 200
Kansas City, MO 64108
816 561 4443

Ellerbe Becket, Inc.
Ellerbe Becket Architects and Engineers, Inc.
Ellerbe Becket Architects and Engineers
2009

Drawing Title: **FOURTH FLOOR DEMO PLAN - PHASE 1**

Approved: Project Director

Project Title: **RELOCATE SURGICAL OPERATING ROOMS, IOWA CITY IA**

Location: **IOWA CITY, IOWA 52246**

Date: **MAY 30, 2012** | Checked: **J.F.** | Drawn: **L.S.**

Project Number: **636-403**

Building Number: **1**

Drawing Number: **1-AD04A**

Dwg. 12 of 130

Construction & Facilities Management CFM
Department of Veterans Affairs

C:\Users\belsje\My Revit\BIM_2012\01_Models\Arch\4611.01 VA_IOWACITY_11_belsje.rvt
5/30/2012 10:17:25 AM