


1808.8842 square ft.

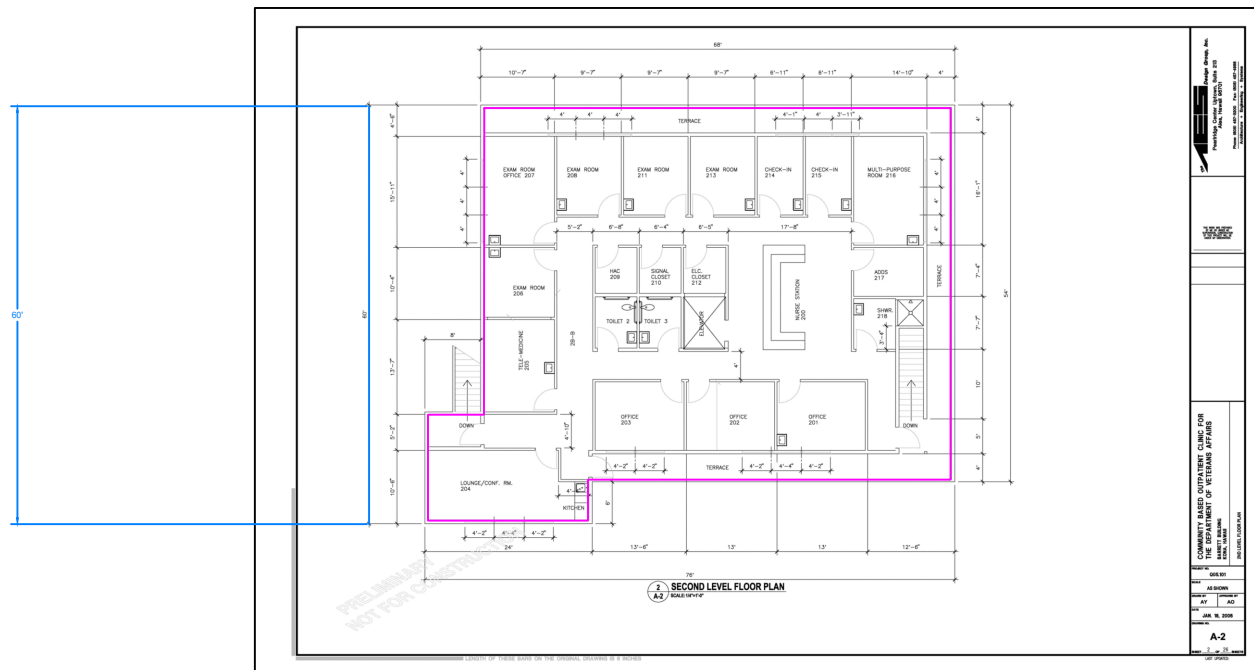

3779.7671 square ft.