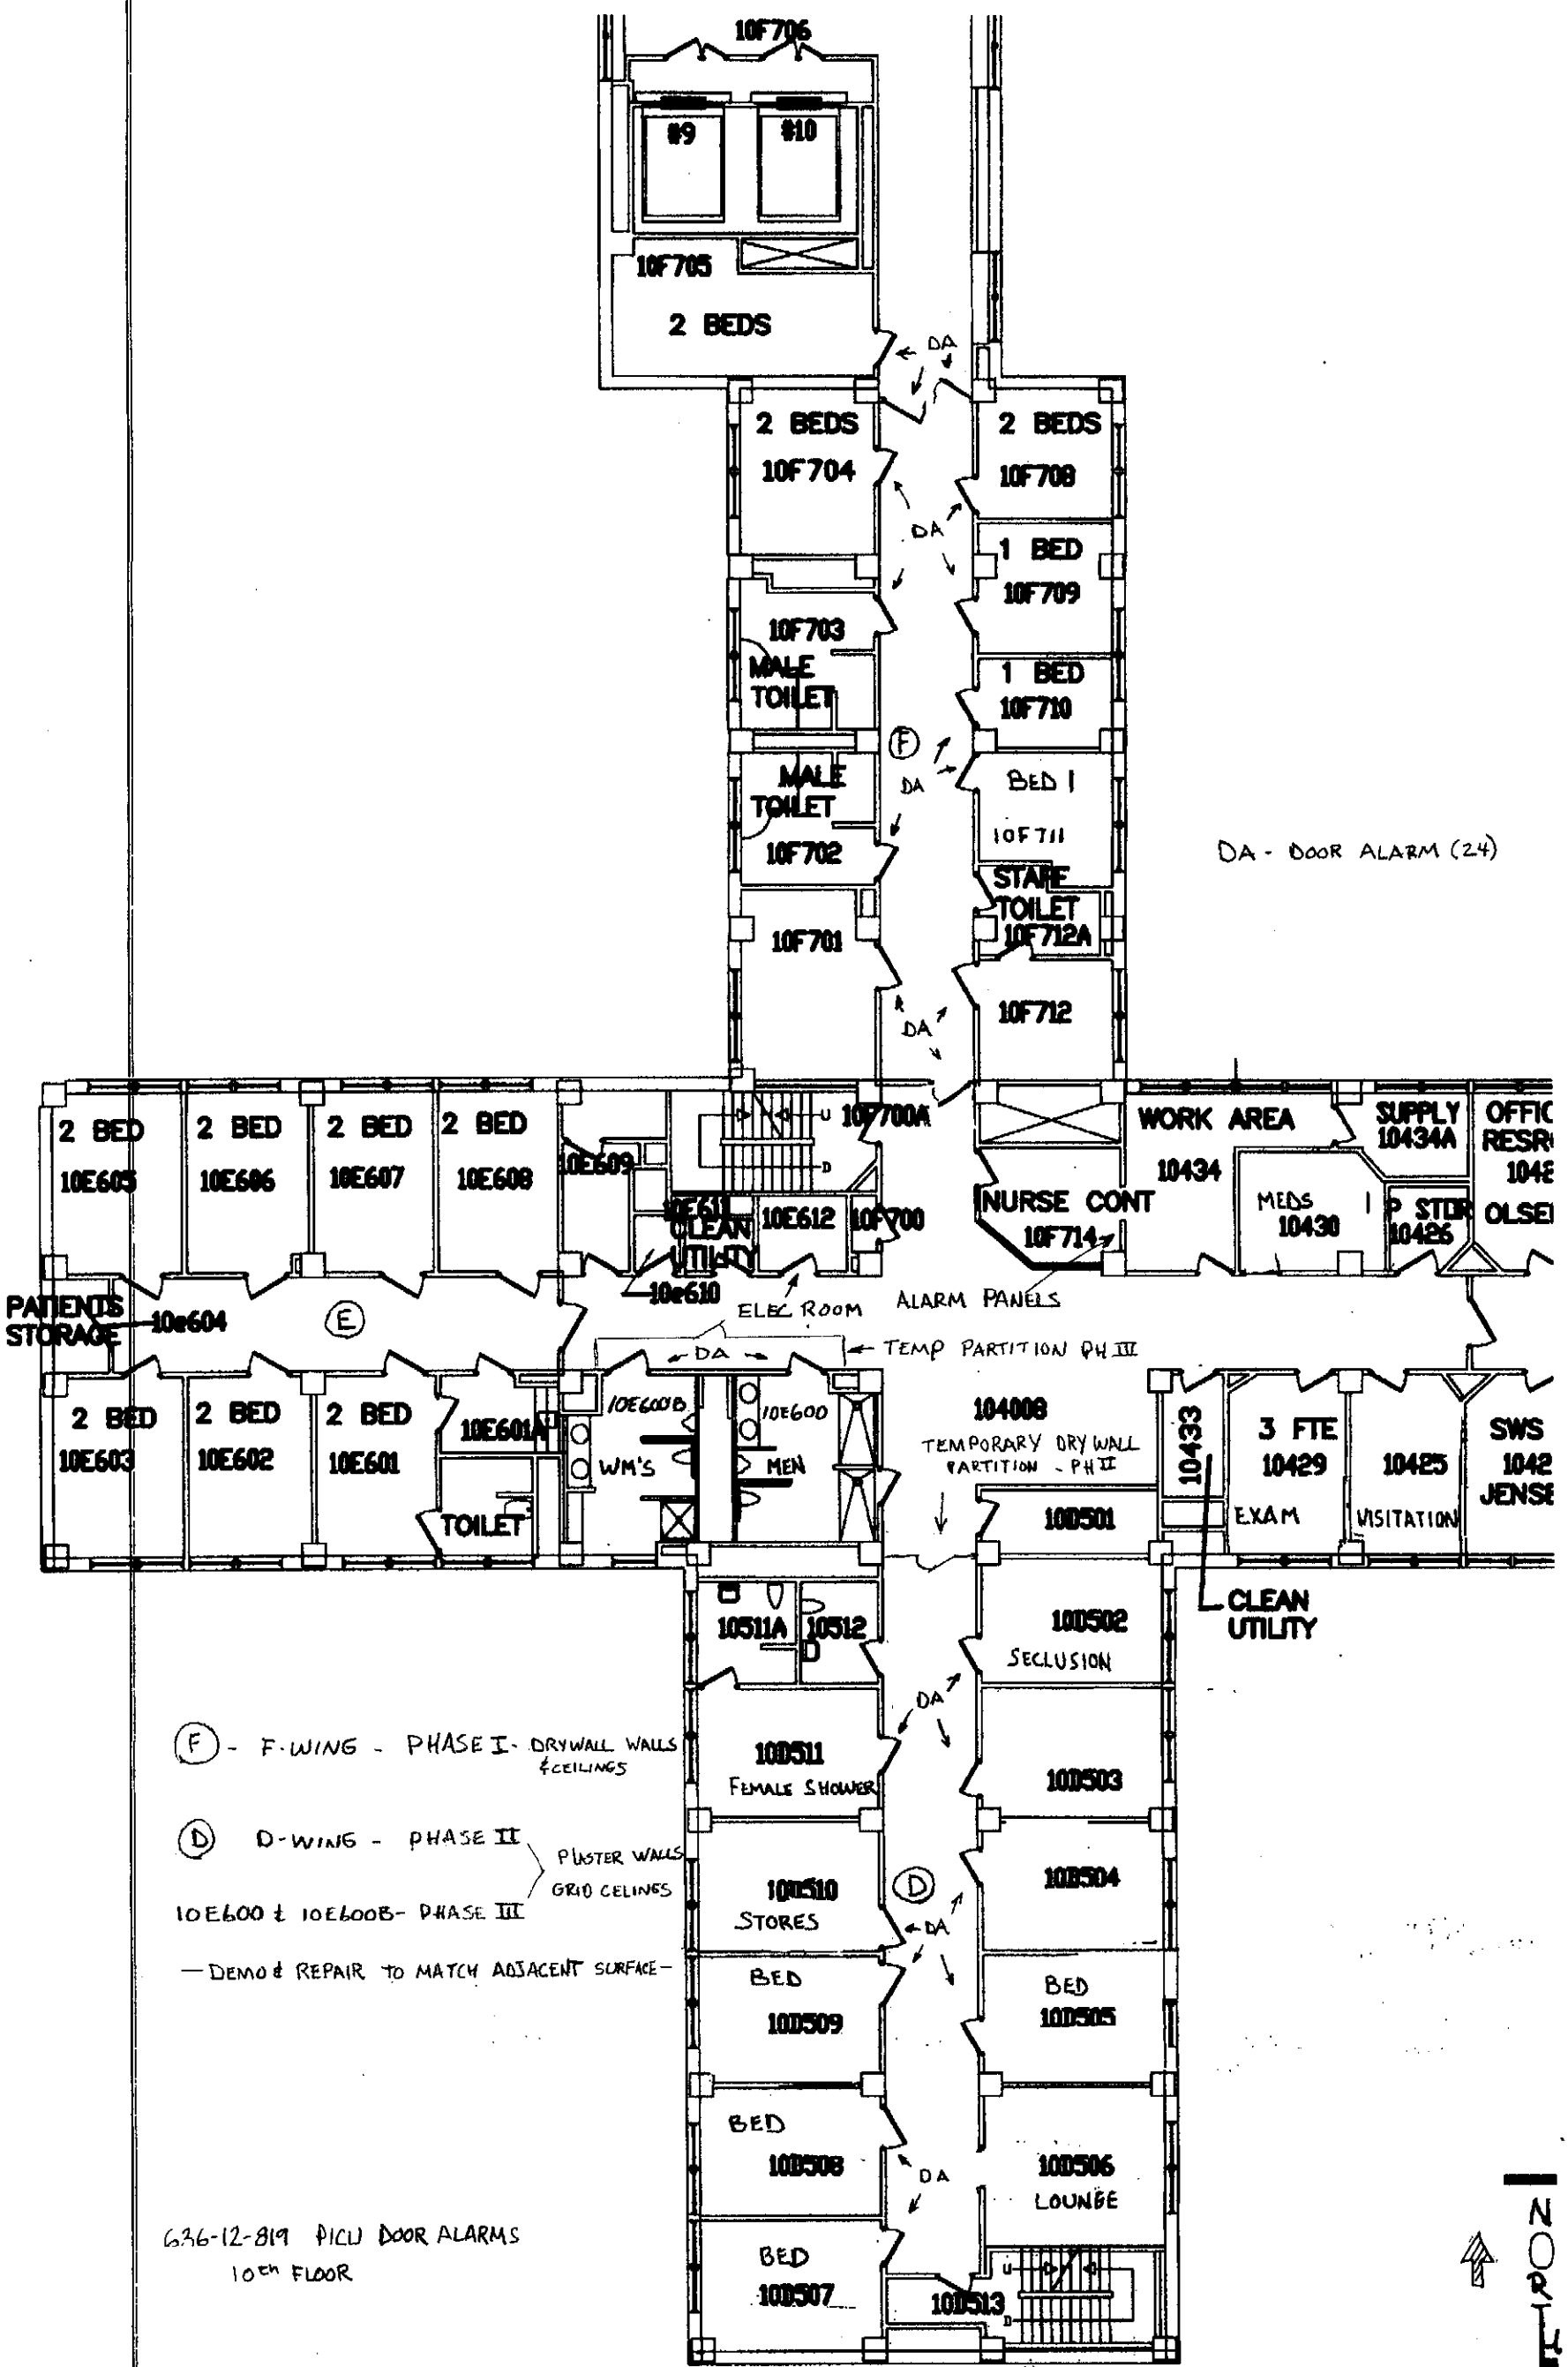
10F706
#9
#10
10F705
2 BEDS
DA
2 BEDS
10F704
2 BEDS
10F708
1 BED
10F709
10F703
MALE TOILET
1 BED
10F710
MALE TOILET
10F702
BED 1
10F711
STAFF TOILET
10F712A
10F701
10F712
DA - DOOR ALARM (24)
2 BED
10E605
2 BED
10E606
2 BED
10E607
2 BED
10E608
10E609
10F700A
WORK AREA
10434
SUPPLY
10434A
NURSE CONT
10F714
MEDS
10430
10E611
CLEAN UTILITY
10E612
10F700
10e610
PATIENTS STORAGE
10e604
ELEC ROOM
ALARM PANELS
TEMP PARTITION PH III
2 BED
10E603
2 BED
10E602
2 BED
10E601
10E601A
TOILET
10E600B
WM'S
10E600
MEN
10400B
TEMPORARY DRYWALL PARTITION - PH II
10433
3 FTE
10429
EXAM
10425
VISITATION
10D501
CLEAN UTILITY
10511A
10512
10D502
SECLUSION
10D511
FEMALE SHOWER
10D503
10D510
STORES
10D504
BED
10D509
BED
10D505
BED
10D508
10D506
LOUNGE
BED
10D507
10D513
F - F-WING - PHASE I - DRYWALL WALLS & CEILINGS
D - D-WING - PHASE II
PLASTER WALLS
GRID CEILINGS
10E600 & 10E600B - PHASE III
— DEMO & REPAIR TO MATCH ADJACENT SURFACE —
636-12-819 PICU DOOR ALARMS
10th FLOOR
NORTH