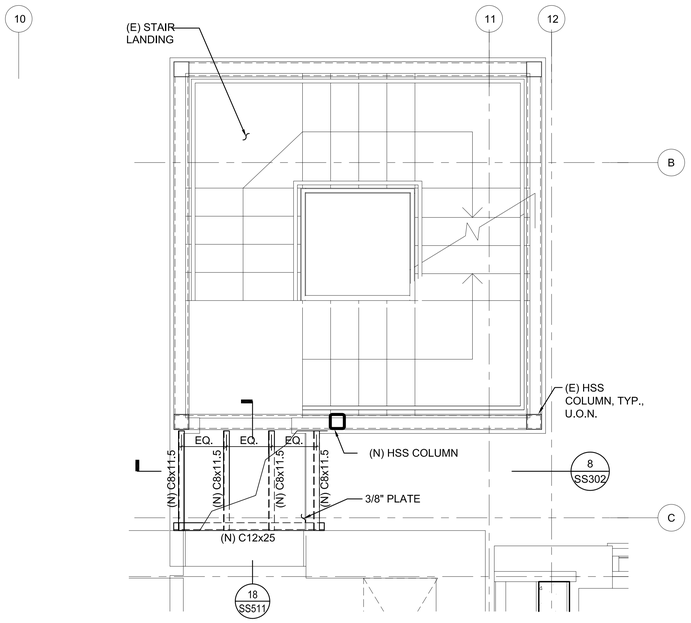

18 SECOND FLOOR EXTERIOR STAIR CONNECTION - PARTIAL PLAN
1/2" = 1'-0"

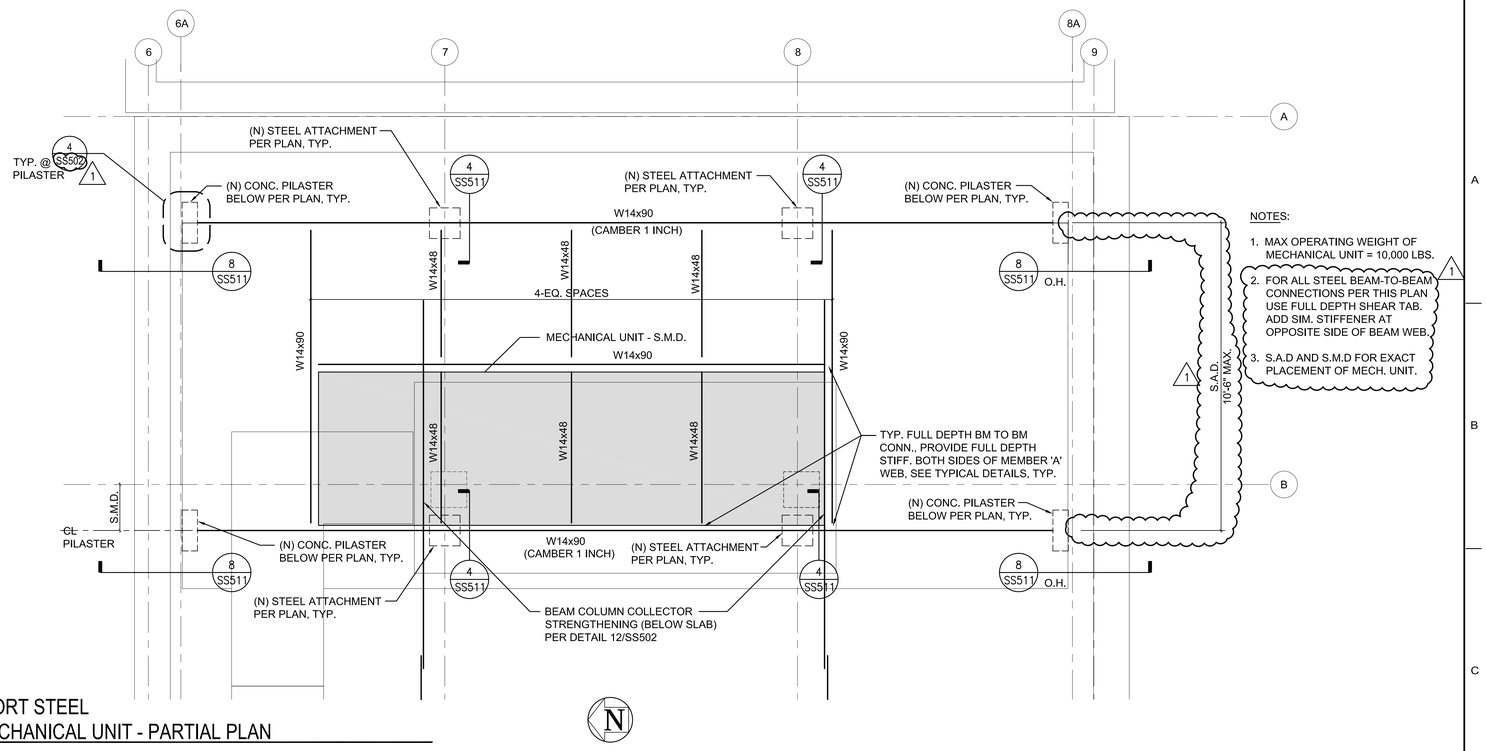

14 (N) SUPPORT STEEL AT (N) MECHANICAL UNIT - PARTIAL PLAN
1/2" = 1'-0"

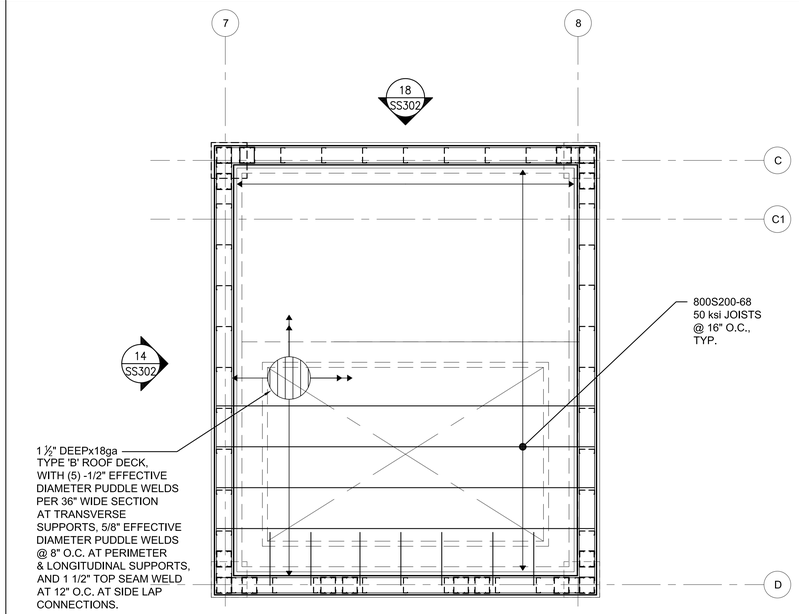

16 (N) PENTHOUSE ROOF - PARTIAL PLAN
1/2" = 1'-0"

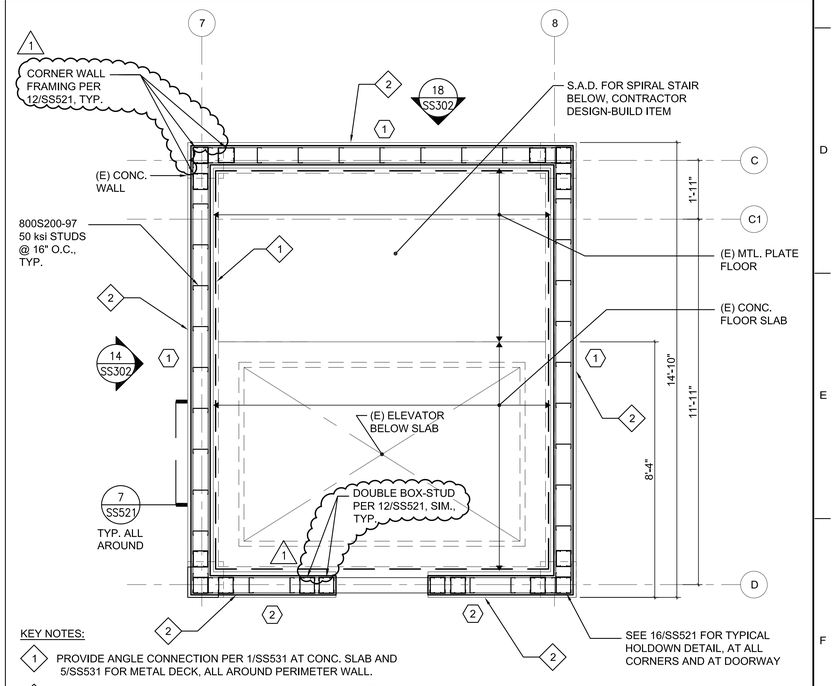

8 PENTHOUSE (E) MECHANICAL LEVEL - PARTIAL PLAN
1/2" = 1'-0"

Revisions	Date
1 AMENDMENT # 1	6/22/2012

Consultants

Degenkolb
DEGENKOLB ENGINEERS
235 Montgomery Street, Suite 500
San Francisco, CA 94104
415.392.6952 Phone
415.981.3157 Fax
www.degenkolb.com
B0584008.00

Reviewing Agency - Fire Protection

AON
Aon Risk Solutions | Global Risk Consulting | Fire Protection Engineering
777D Bernardo Plaza Court, Suite 116 | San Diego, CA 92128
t +1.858.673.5645 | f + 1.858. 673.5640
AonFPE.com
Project# 2010114
Fire Protection | Code | Risk | Life Safety | Security Consulting

JAMES G. MOLLOY — CIVIL STRUCTURAL — EXPIRES 12/31/13 — No. 17640

Architects/Engineers

RBB ARCHITECTS INC
10980 Wilshire Boulevard
Los Angeles, California
90024-3905
Telephone 310 473 3555
Facsimile 310 473 3555
www.rbbinc.com

917 7th St. 2nd Floor Ste. 3
Sacramento, California
95814
Telephone 310 473 3555
Facsimile 310 473 3555
www.rbbinc.com

Drawing Title
PARTIAL PLANS
Scale
AS NOTED
Approved Project Director

Project Title
VA SIERRA NEVADA HEALTHCARE SYSTEM
BLDG 1A SEISMIC CORRECTIONS
Project No. RBB #1013700
VA Contract No. VA261-P-088
Location
975 KIRMAN AVE., RENO, NEVADA 89502
Date 06/08/2012
Checked WG
Drawn MM

VA Project No. 654-336
Building No. 1A
Drawing No. **SS402**

Office of Construction and Facilities Management

AMENDMENT # 1