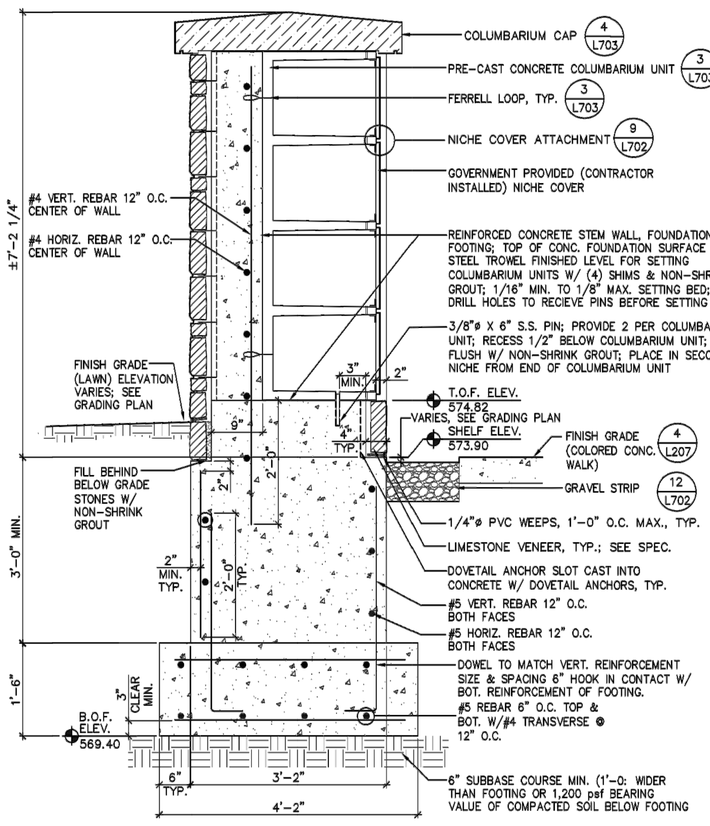

1 COLUMBARIUM WALL SECTION – SINGLE-SIDED

SCALE 1"=1'-0"

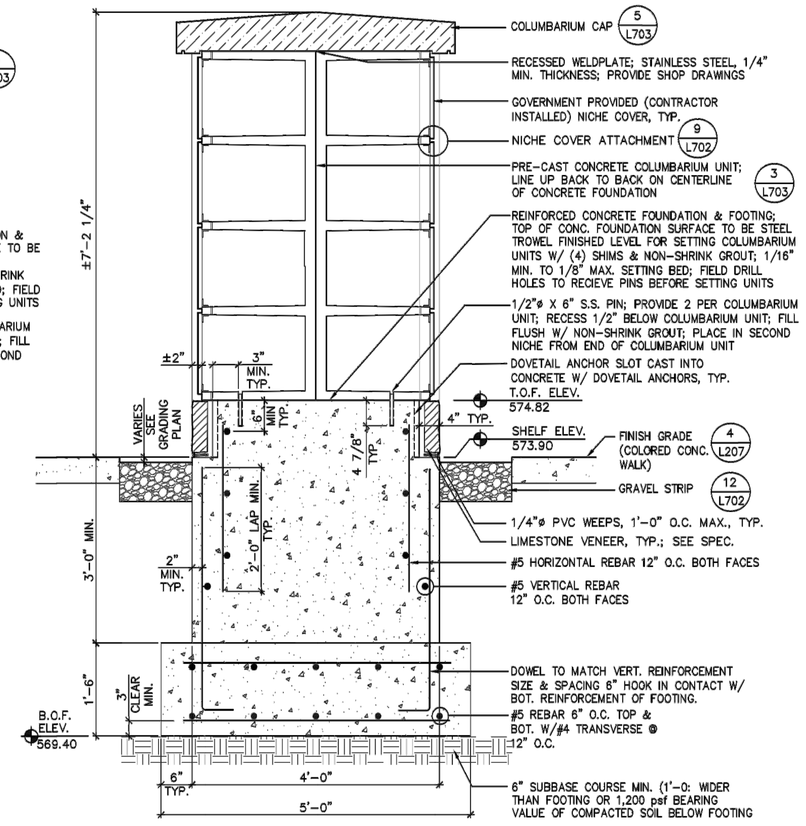

2 COLUMBARIUM WALL SECTION – DOUBLE-SIDED (TYPE 1)

SCALE 1"=1'-0"

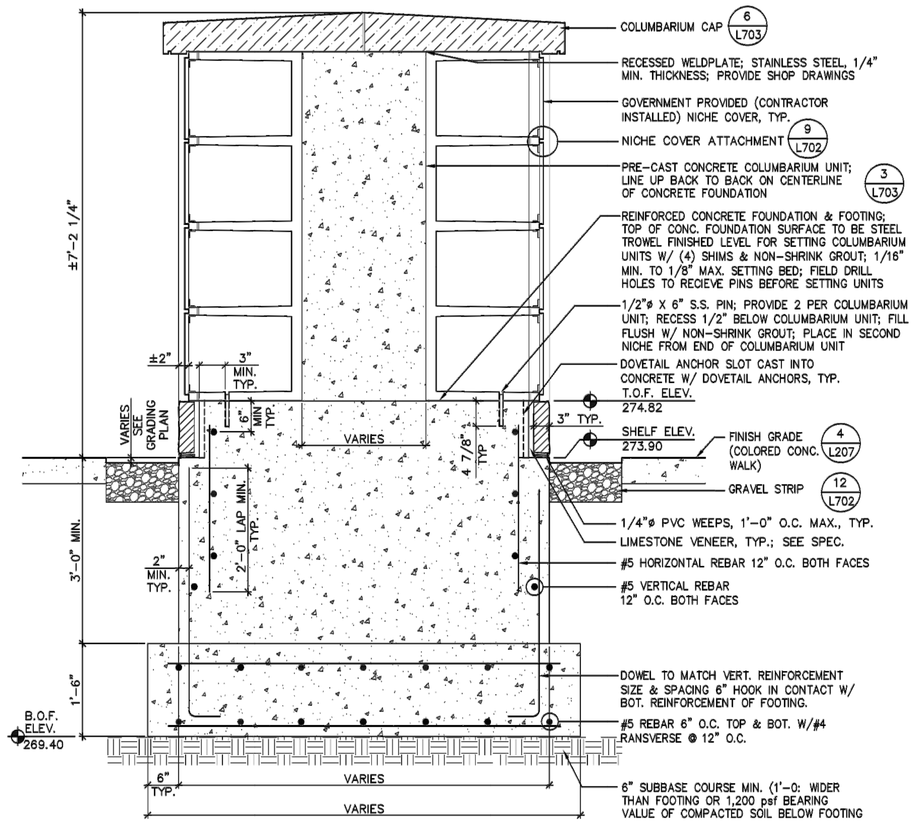

3 COLUMBARIUM WALL SECTION – DOUBLE-SIDED (TYPE 2)

SCALE 1"=1'-0"

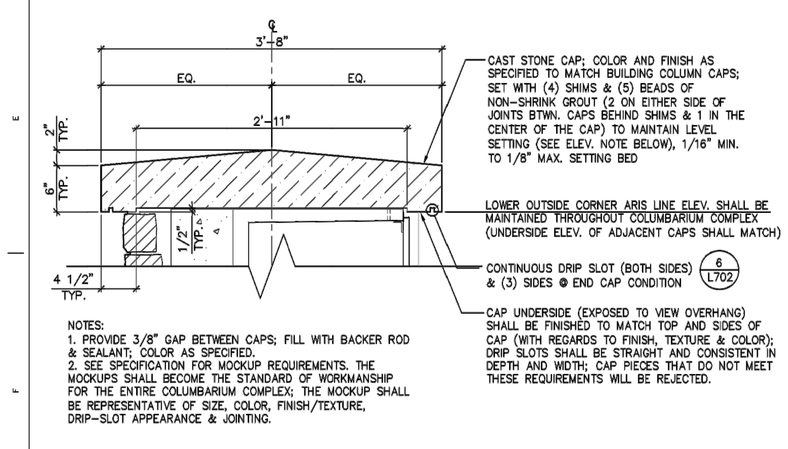

NOTES:
1. PROVIDE 3/8" GAP BETWEEN CAPS; FILL WITH BACKER ROD & SEALANT; COLOR AS SPECIFIED.
2. SEE SPECIFICATION FOR MOCKUP REQUIREMENTS. THE MOCKUPS SHALL BECOME THE STANDARD OF WORKMANSHIP FOR THE ENTIRE COLUMBARIUM COMPLEX; THE MOCKUP SHALL BE REPRESENTATIVE OF SIZE, COLOR, FINISH/TEXTURE, DRIP-SLOT APPEARANCE & JOINTING.

4 SINGLE-SIDED COLUMBARIUM CAP SECTION

SCALE: 1" = 1 1/2"

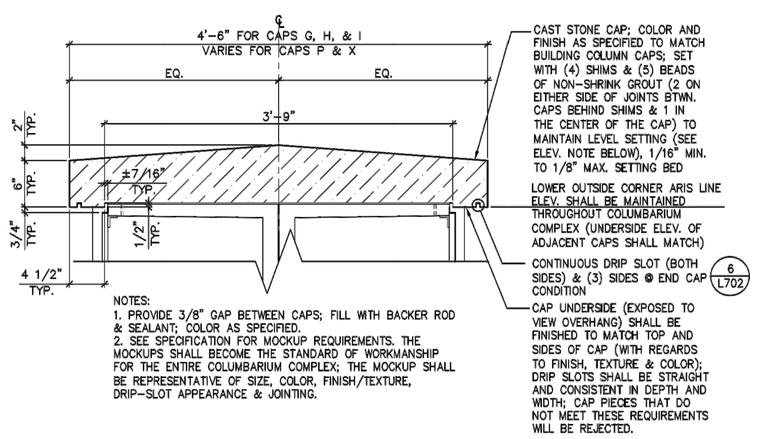

NOTES:
1. PROVIDE 3/8" GAP BETWEEN CAPS; FILL WITH BACKER ROD & SEALANT; COLOR AS SPECIFIED.
2. SEE SPECIFICATION FOR MOCKUP REQUIREMENTS. THE MOCKUPS SHALL BECOME THE STANDARD OF WORKMANSHIP FOR THE ENTIRE COLUMBARIUM COMPLEX; THE MOCKUP SHALL BE REPRESENTATIVE OF SIZE, COLOR, FINISH/TEXTURE, DRIP-SLOT APPEARANCE & JOINTING.

5 DOUBLE-SIDED COLUMBARIUM CAP SECTION (TYPE 1)

SCALE: 1" = 1 1/2"

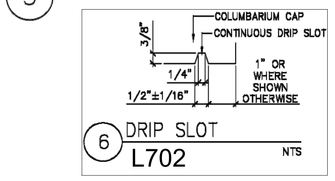

6 DRIP SLOT L702

NTS

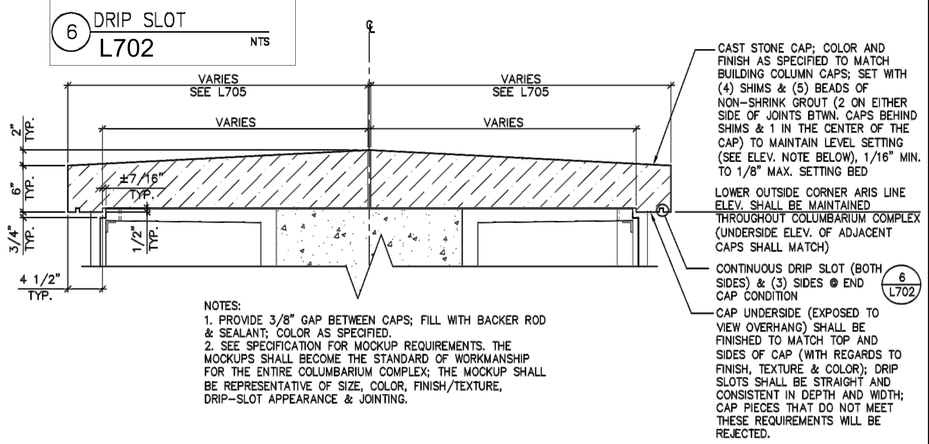

NOTES:
1. PROVIDE 3/8" GAP BETWEEN CAPS; FILL WITH BACKER ROD & SEALANT; COLOR AS SPECIFIED.
2. SEE SPECIFICATION FOR MOCKUP REQUIREMENTS. THE MOCKUPS SHALL BECOME THE STANDARD OF WORKMANSHIP FOR THE ENTIRE COLUMBARIUM COMPLEX; THE MOCKUP SHALL BE REPRESENTATIVE OF SIZE, COLOR, FINISH/TEXTURE, DRIP-SLOT APPEARANCE & JOINTING.

6 DOUBLE-SIDED COLUMBARIUM CAP SECTION (TYPE 2)

SCALE: 1" = 1 1/2"

CAD FWD: L701-L706 COLUMB DWGS (PWRS) SET.dwg, 10/18/2016 11:08:08 AM, Administrator

Revisions	Date

PREPARED BY:
Missman STANLEY & ASSOCIATES, P.C.
Civil Engineering • Environmental Services • GIS • Landscape Architecture • Surveying
1011 27th Avenue, Rock Island, Illinois 61201-6040
Phone (309) 788-7844 Fax (309) 788-7891

CONSULTANTS:
the LA group Landscape Architecture and Engineering, P.C.
40 Long Alley, Saratoga Springs, NY 12866
518/587-8100 Telefax 518/587-0180
Web: www.thelagroup.com
ARCHITECTURE

MEXUS STUDIOS
401 EAST ILLINOIS STREET
SUITE 401
CHICAGO, ILLINOIS 60611
(312) 661-0778
INTERIOR DESIGN

Aqua Engineering, Inc.
Irrigation System Design, Water Management, and Water Feature Engineering
4803 Innovation Drive, Fort Collins, Colorado 80525
Phone (970) 229-9668, FAX (970) 226-3855

Seal & Signature

NATIONAL CEMETERY ADMINISTRATION

Drawing Title: COLUMBARIUM DETAILS
Approved: Fred J. Naun, Director, Project Management Service
Approved: David C. Starkie, Project Manager

Project Title: ROCK ISLAND NATIONAL CEMETERY EXPANSION
Building Number: .
Checked: MKM LRR
Drawn: RAP MAM
Location: ROCK ISLAND, ILLINOIS

Submittal: RECORD DRAWINGS
Date: JANUARY 1, 2009
Project No.: 821PC2026
Drawing No.: L-703
Sheet 43 of 131

RECORD DRAWINGS

RECORD PLAN - COLUMBARIUM DETAILS

NOT TO SCALE

Revisions	Date

one inch = one hundred feet (0, 100, 200; 10)

NATIONAL CEMETERY ADMINISTRATION

FINAL FOR CONSTRUCTION

Drawing Title: **RECORD PLAN - COLUMBARIUM DETAILS**	Project Title: **COLUMBARIUM CAP REPLACEMENT**			Date: **7/6/2017**
				Project No.: **MM774-17-003**
Approved: Division Chief	Building Number: *****	Checked	Drawn: **RNE**	DRAWING NO. **L-3**
Approved: Service Director	Location: **ROCK ISLAND NATIONAL CEMETERY**			Dwg. **4** Of **4**