



TYPICAL ROOM

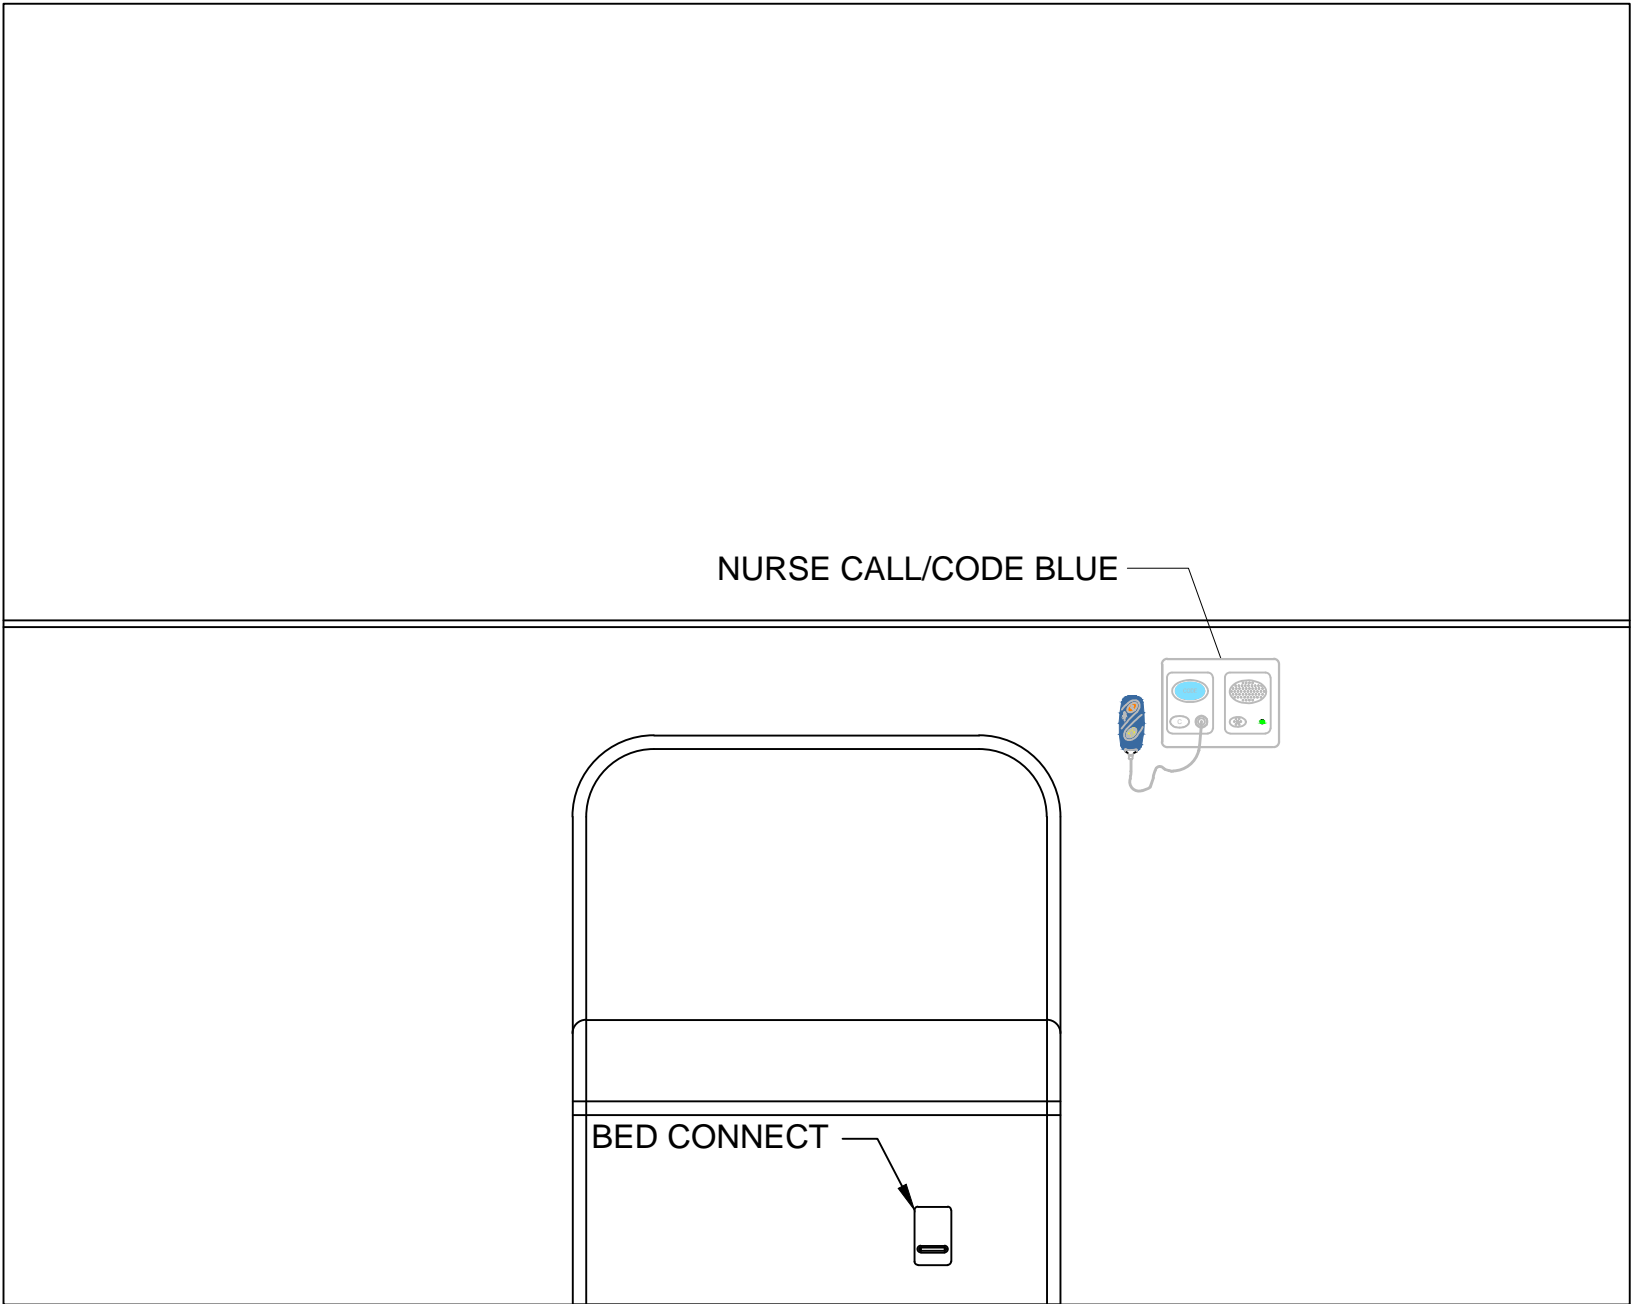

EXISTING

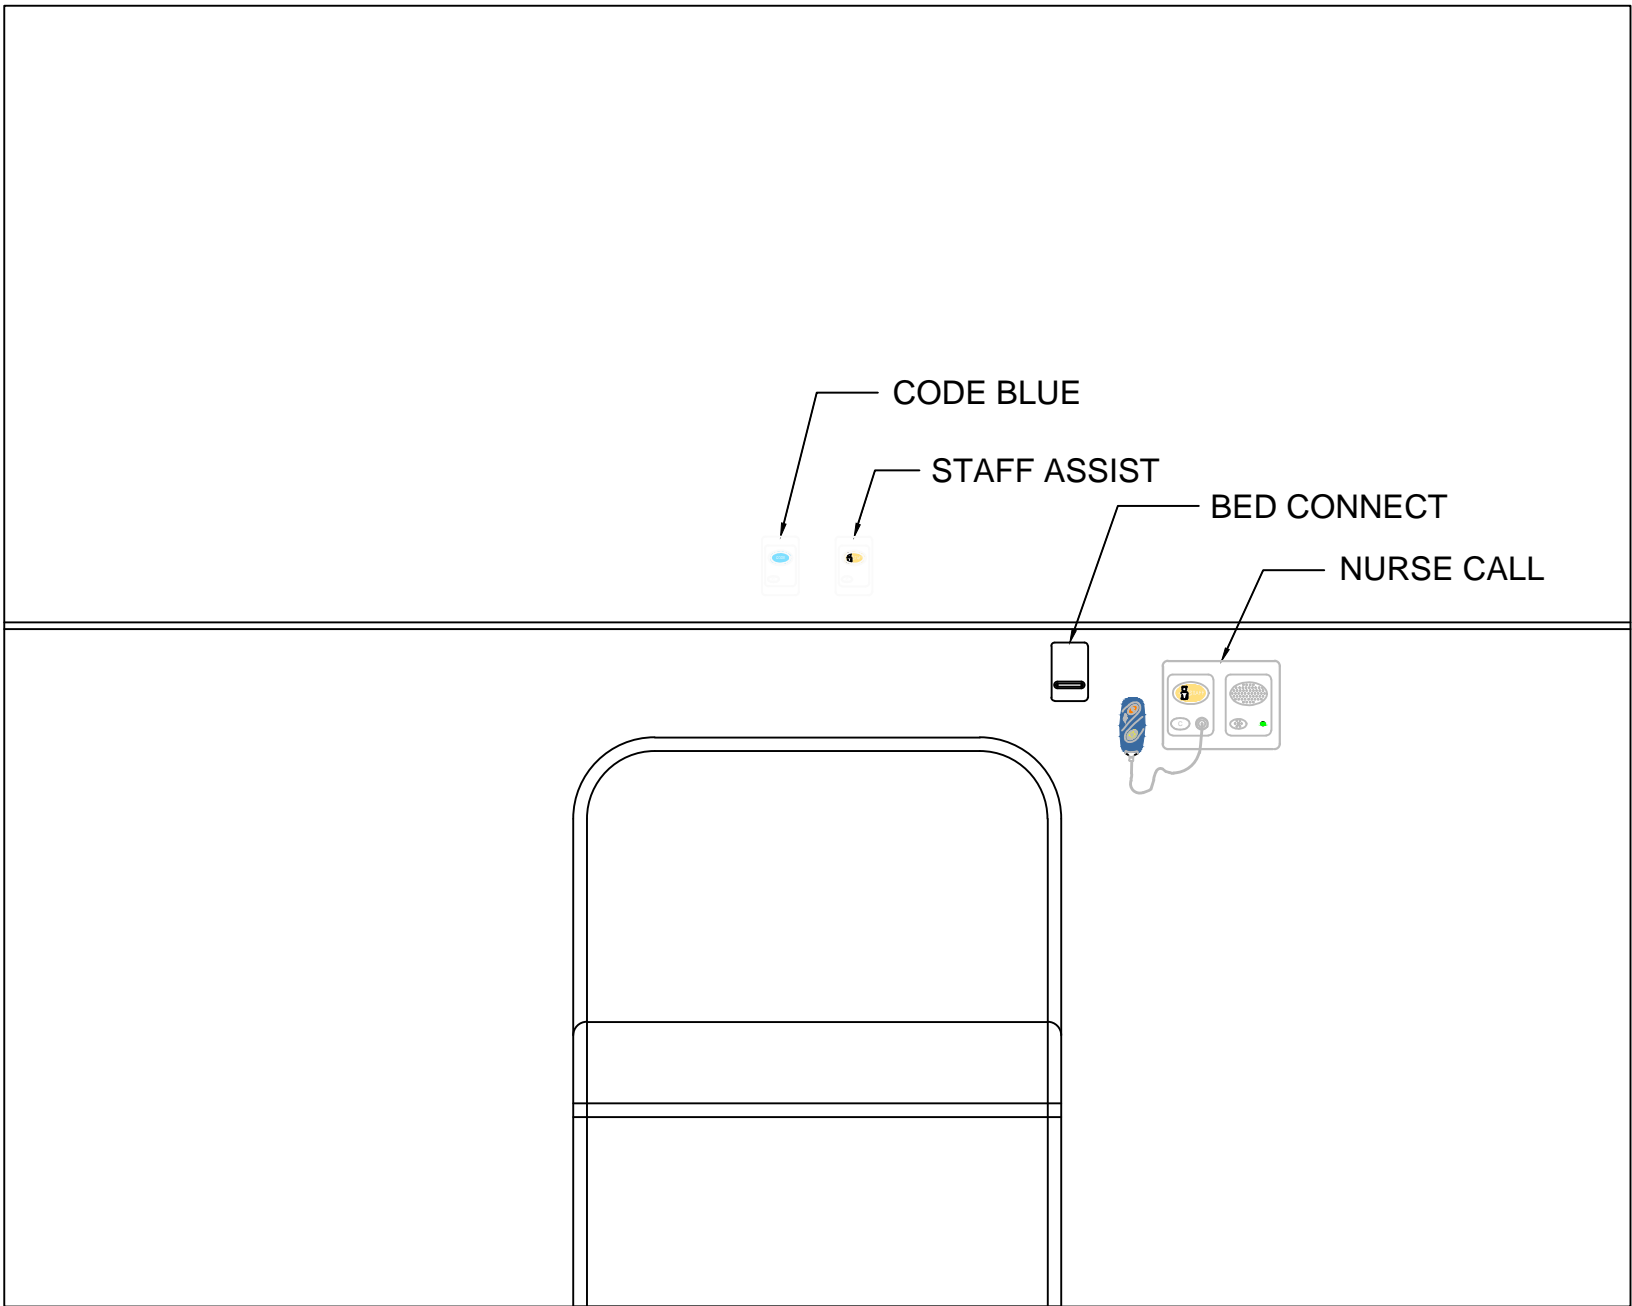

NEW

LEGEND

- ROOM TO BE HAVE MODIFICATIONS DONE
- EXISTING PATIENT STATION Type 1 IP-CPG /P (Ergo Plus Pendant) with IP-TALKTWO Intercom /CB = Code Blue
- REPROGRAMED PATIENT STATION Type 1 IP-CPG /P (Ergo Plus Pendant) with IP-TALKTWO Intercom /SA = Staff Assist
- 37 PIN CONNECTION FOR BED
- CODE BLUE CALLPOINT
- STAFF ASSIST CALLPOINT
- ZONE SOUNDER
- Valcom Display LED DISPLAY
- AN-PD1 LED ANNUNCIATOR
- S SPEAKER
- X NUMBER OF PATIENT STATION/ CODE BLUE
- NGTC IP-ODL4-RGB, OVERDOOR LIGHT W/Tone
- IP-ODL4-RGB, OVERDOOR LIGHT W/Tone

NAME\_OF\_FACILITY