


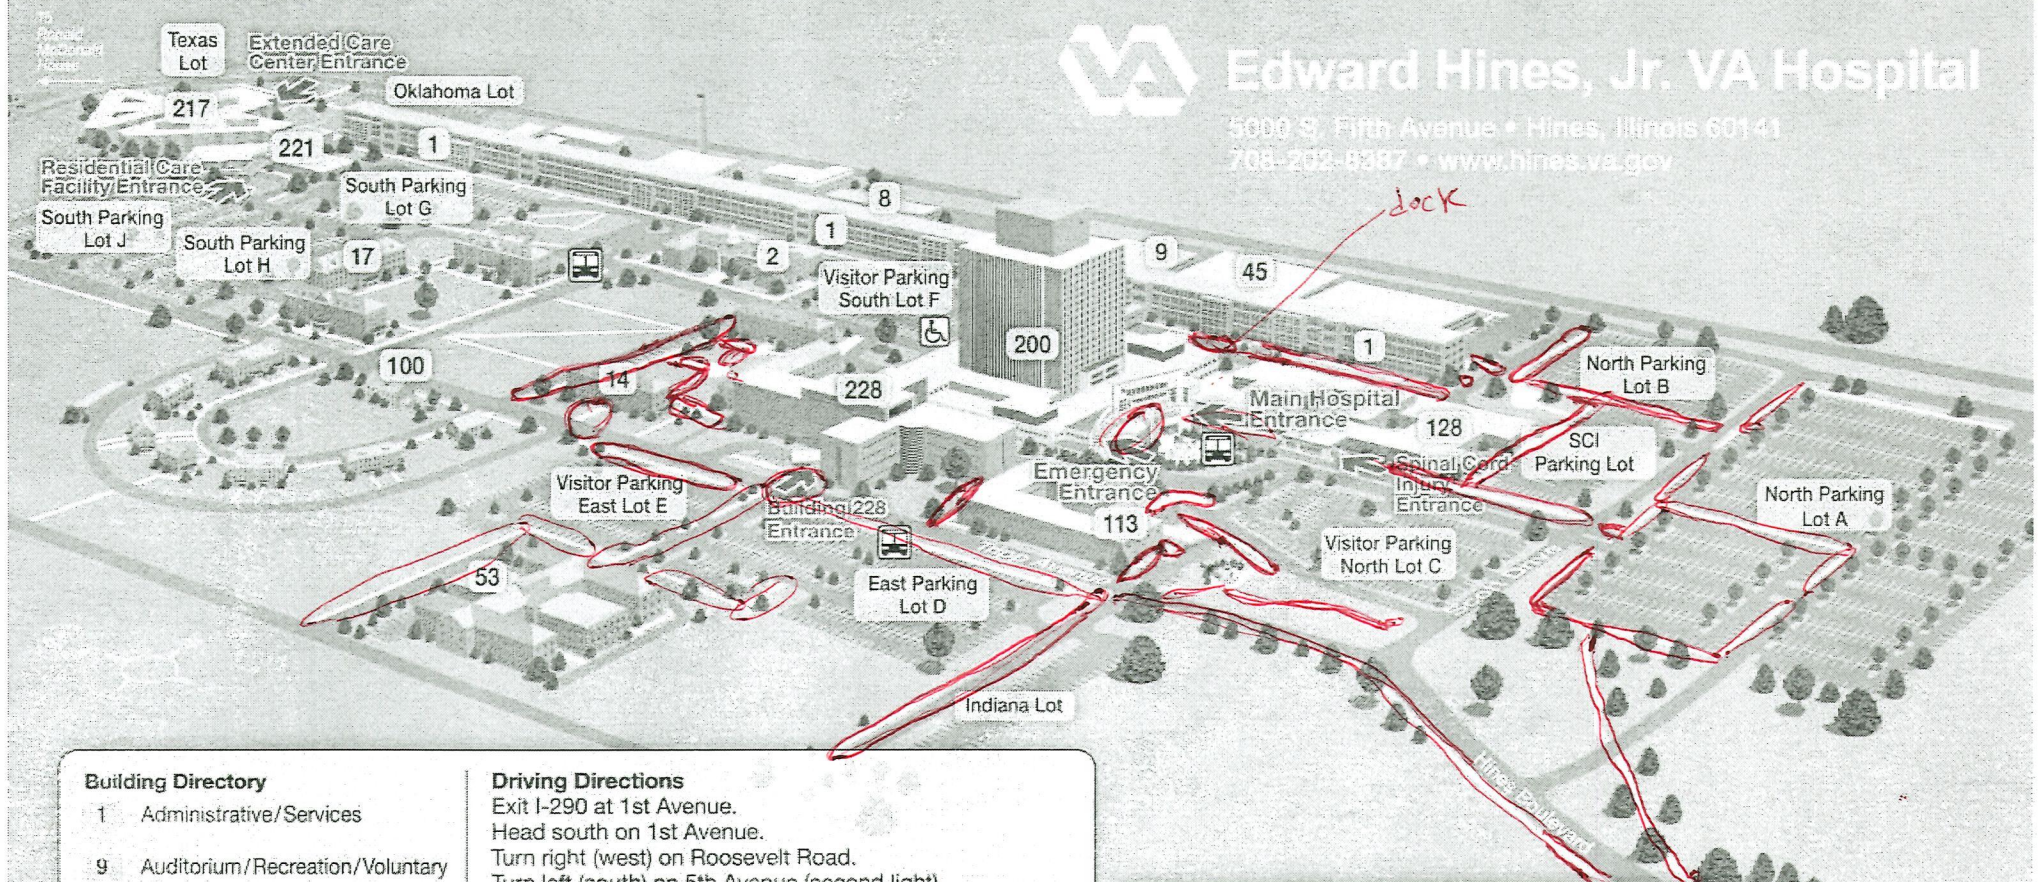

# Edward Hines, Jr. VA Hospital

5000 S. Fifth Avenue • Hines, Illinois 60141  
708-202-8387 • [www.hines.va.gov](http://www.hines.va.gov)



## Building Directory

- 1 Administrative/Services
- 9 Auditorium/Recreation/Voluntary
- 14 Cooke's Manor
- 17 Human Resources
- 45 Retail Store
- 53 Bishop Goedert Residence
- 100 Fisher House
- 113 Blind Center
- 128 Spinal Cord Injury
- 200 Main Hospital
- 217 Extended Care Center
- 221 Residential Care Facility
- 228 Clinical Areas, Prosthetics

## Driving Directions

Exit I-290 at 1st Avenue.  
Head south on 1st Avenue.  
Turn right (west) on Roosevelt Road.  
Turn left (south) on 5th Avenue (second light).

## Parking

Hines is proud to offer FREE Valet parking to our Veteran patients. As you enter the campus through the main gate at 5th Avenue and Roosevelt Road, follow the signs to our Valet parking. Visitors and patients are welcome to park in any parking lot on the campus, keeping in mind that some individual spots have been designated specifically for individuals with disabilities, hospital volunteers or for drop-off and delivery.

## Mass Transit

Hines VA Hospital is served by the #301, #308 and the #331 PACE buses. For more information about public transportation in Chicago, call the Regional Transportation Authority at 312-836-7000.

## For more transit information:

Contact Regional Transportation Authority Travel Information Center, 836-7000 in all Chicago area codes, or 312-836-7000 from anywhere else.

## Legend

- Bus Stop
- Handicapped Parking

