


DIAGRAM #5 ASBESTOS MISCELLANEOUS MATERIAL LOCATIONS

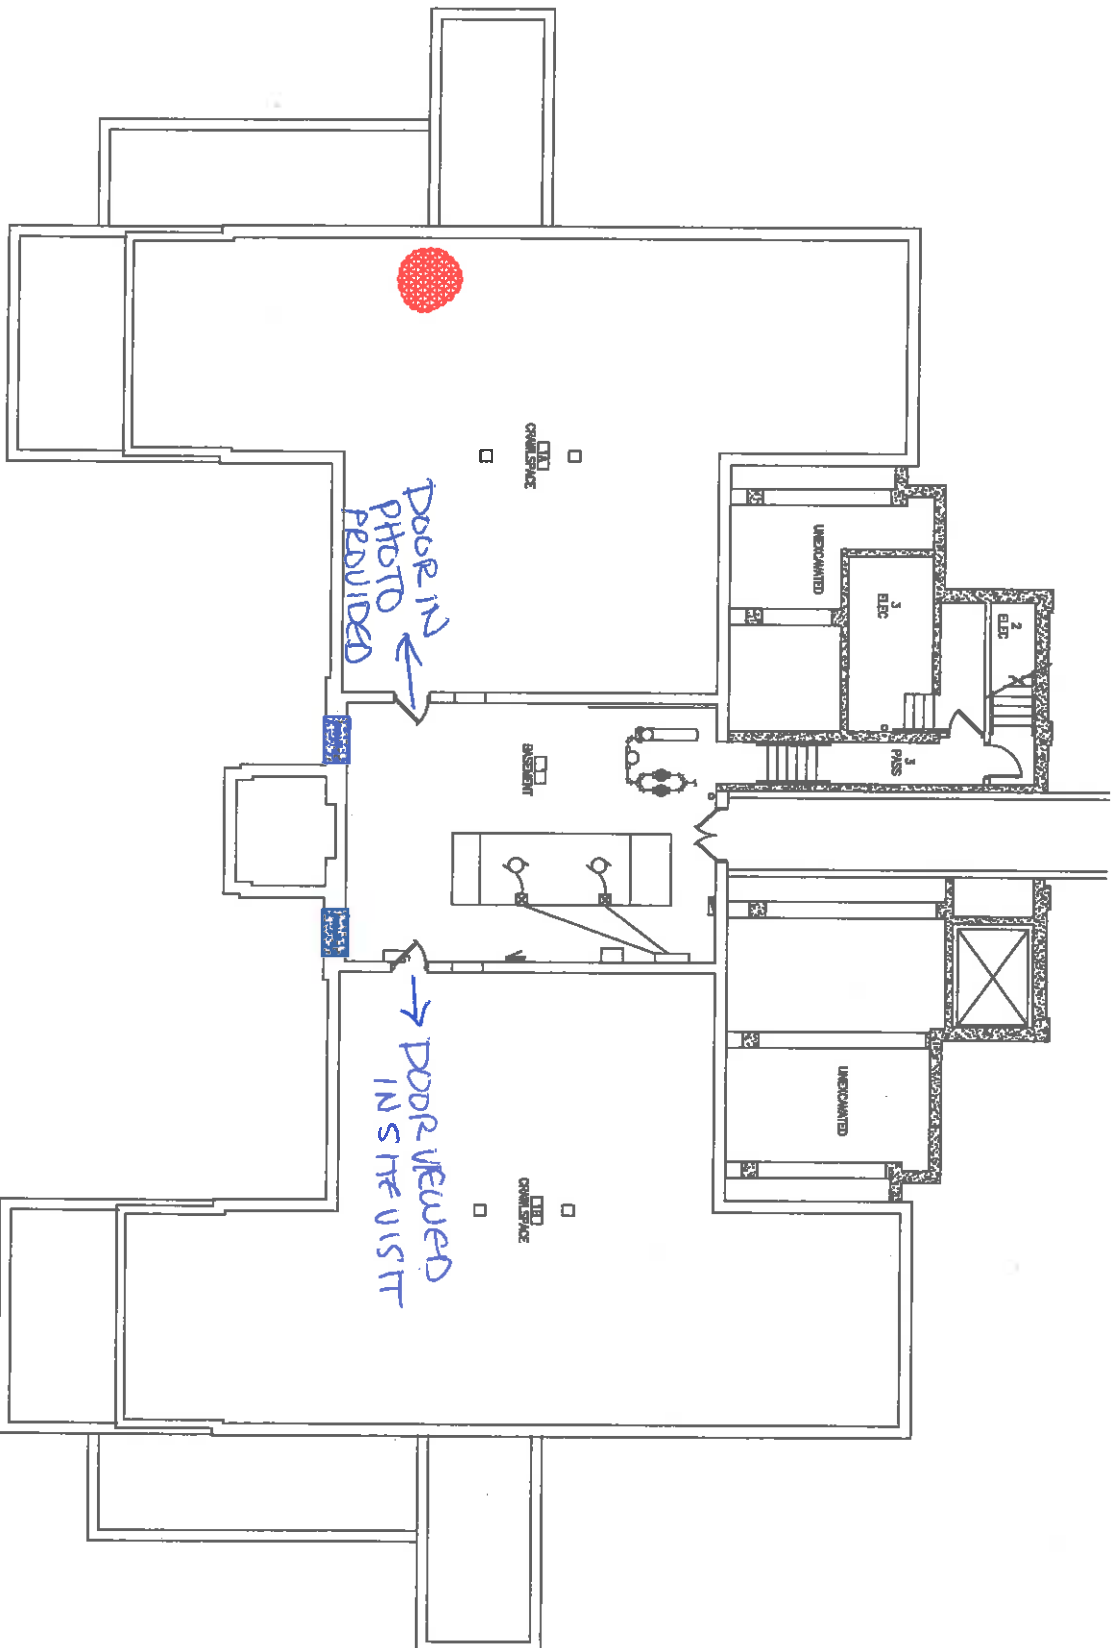

BUILDING 3
BASEMENT