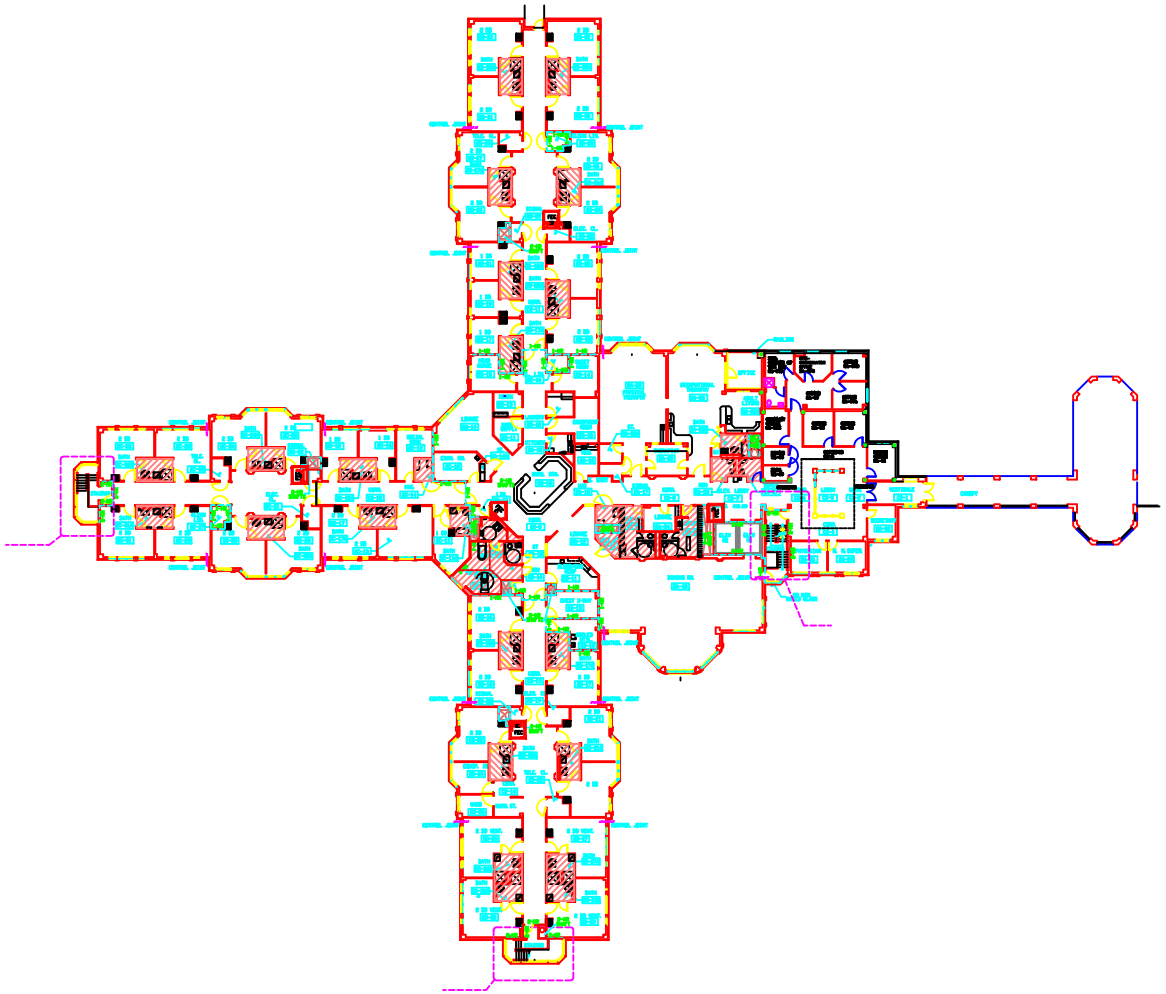

BRECC 2ND FLOOR
SCALE: 1/16" = 1'

RECORD DRAWING

THIS DRAWING, AS PREPARED BY THE CONTRACTOR OF RECORD, HAS BEEN REVIEWED FOR GENERAL CONTENT BY ZRPI AND SHOULD BE MADE PART OF THE OWNERS PERMANENT RECORDS.

ZEIDLER ROBERTS PARTNERSHIP, INC.

DEPRESSED SLAB

GENERAL NOTES

1) SEE APPENDIX "A" OF THE MASTER CONSTRUCTION SPECIFICATION (EQUIPMENT AND ACCESSORIES GUIDE LIST) FOR CASEWORK & EQUIPMENT DESCRIPTIONS & QUANTITIES FOR EACH RM. TYPE(SEE DRWG 20-10 FOR RM. G-10 EQUIP.)
2) SEE APPENDIX "B" OF THE MASTER CONSTRUCTION SPECIFICATION FOR WOOD TRIM DESCRIPTIONS AND COMBINATIONS.
3) BEAM & SLAB FIREPROOFING- UL ASSEMBLY D916 (2HR) OR EQUIVALENT W/ FIBER FIRE-PROOFING SPRAY
4) COLUMN FIREPROOFING- UL ASSEMBLY X764(2HR) OR EQUIVALENT W/ FIBER FIRE-PROOFING SPRAY ±1 3/16" THICK, SUCH AS X813.
5) ALL BASEMENT CORNER GUARDS ARE TO BE STAINLESS STEEL. SEE FINISH SCHEDULE AND FINISHES LIST IN 09050 OF THE MCS FOR OTHER BUMPER AND CORNER GUARD TYPES.
6) SEE ROOM FINISH SCHEDULE & FLOOR AND WALL PATTERN DRAWINGS IN 09050 OF THE MCS FOR CARPET AND TILE TYPES & LAYOUTS.
7) INCLUDE 6"(16GA) MTL PLATES IN STUD WALL CONSTRUCTION (@2'-6", 5'-0",6'-8" A.F.F.) WHERE CASEWORK & SHELVING OCCUR.
8) THIS IS A FULLY SPRINKLERED BUILDING.

No.	Revisions	Date	By
1	ADDENDUM NO.1	3 31 95	
	FINAL SUBMISSION	2 28 95	

"ALL DRAWINGS, SPECIFICATIONS AND RELATED DOCUMENTS ARE THE COPYRIGHT PROPERTY OF THE ARCHITECT AND MUST BE RETURNED UPON REQUEST. REPRODUCTION OF DRAWINGS, SPECIFICATIONS AND RELATED DOCUMENTS IN PART OR WHOLE IS PROHIBITED WITHOUT THE ARCHITECT'S WRITTEN PERMISSION."

CONTRACTOR MUST CHECK AND VERIFY ALL DIMENSIONS ON THE JOB.

THIS DRAWING SHALL NOT BE USED FOR CONSTRUCTION PURPOSES UNLESS CONTRIBUTED BY:

Zeidler Roberts Partnership Inc.
Architects

BALTIMORE VA
REHAB. & EXTENDED
CARE CENTER
BALTIMORE

N

Drawn	Scale
JA	1/16"= 1'-0"
Checked	Date
-	

Title
SECOND FLOOR PLAN

Project No.	Drawing No.	Rev. No.
94M211	20-5	0