


\* MAP IS NOT TO SCALE  
\*\* MEASUREMENTS ARE APPROXIMATE

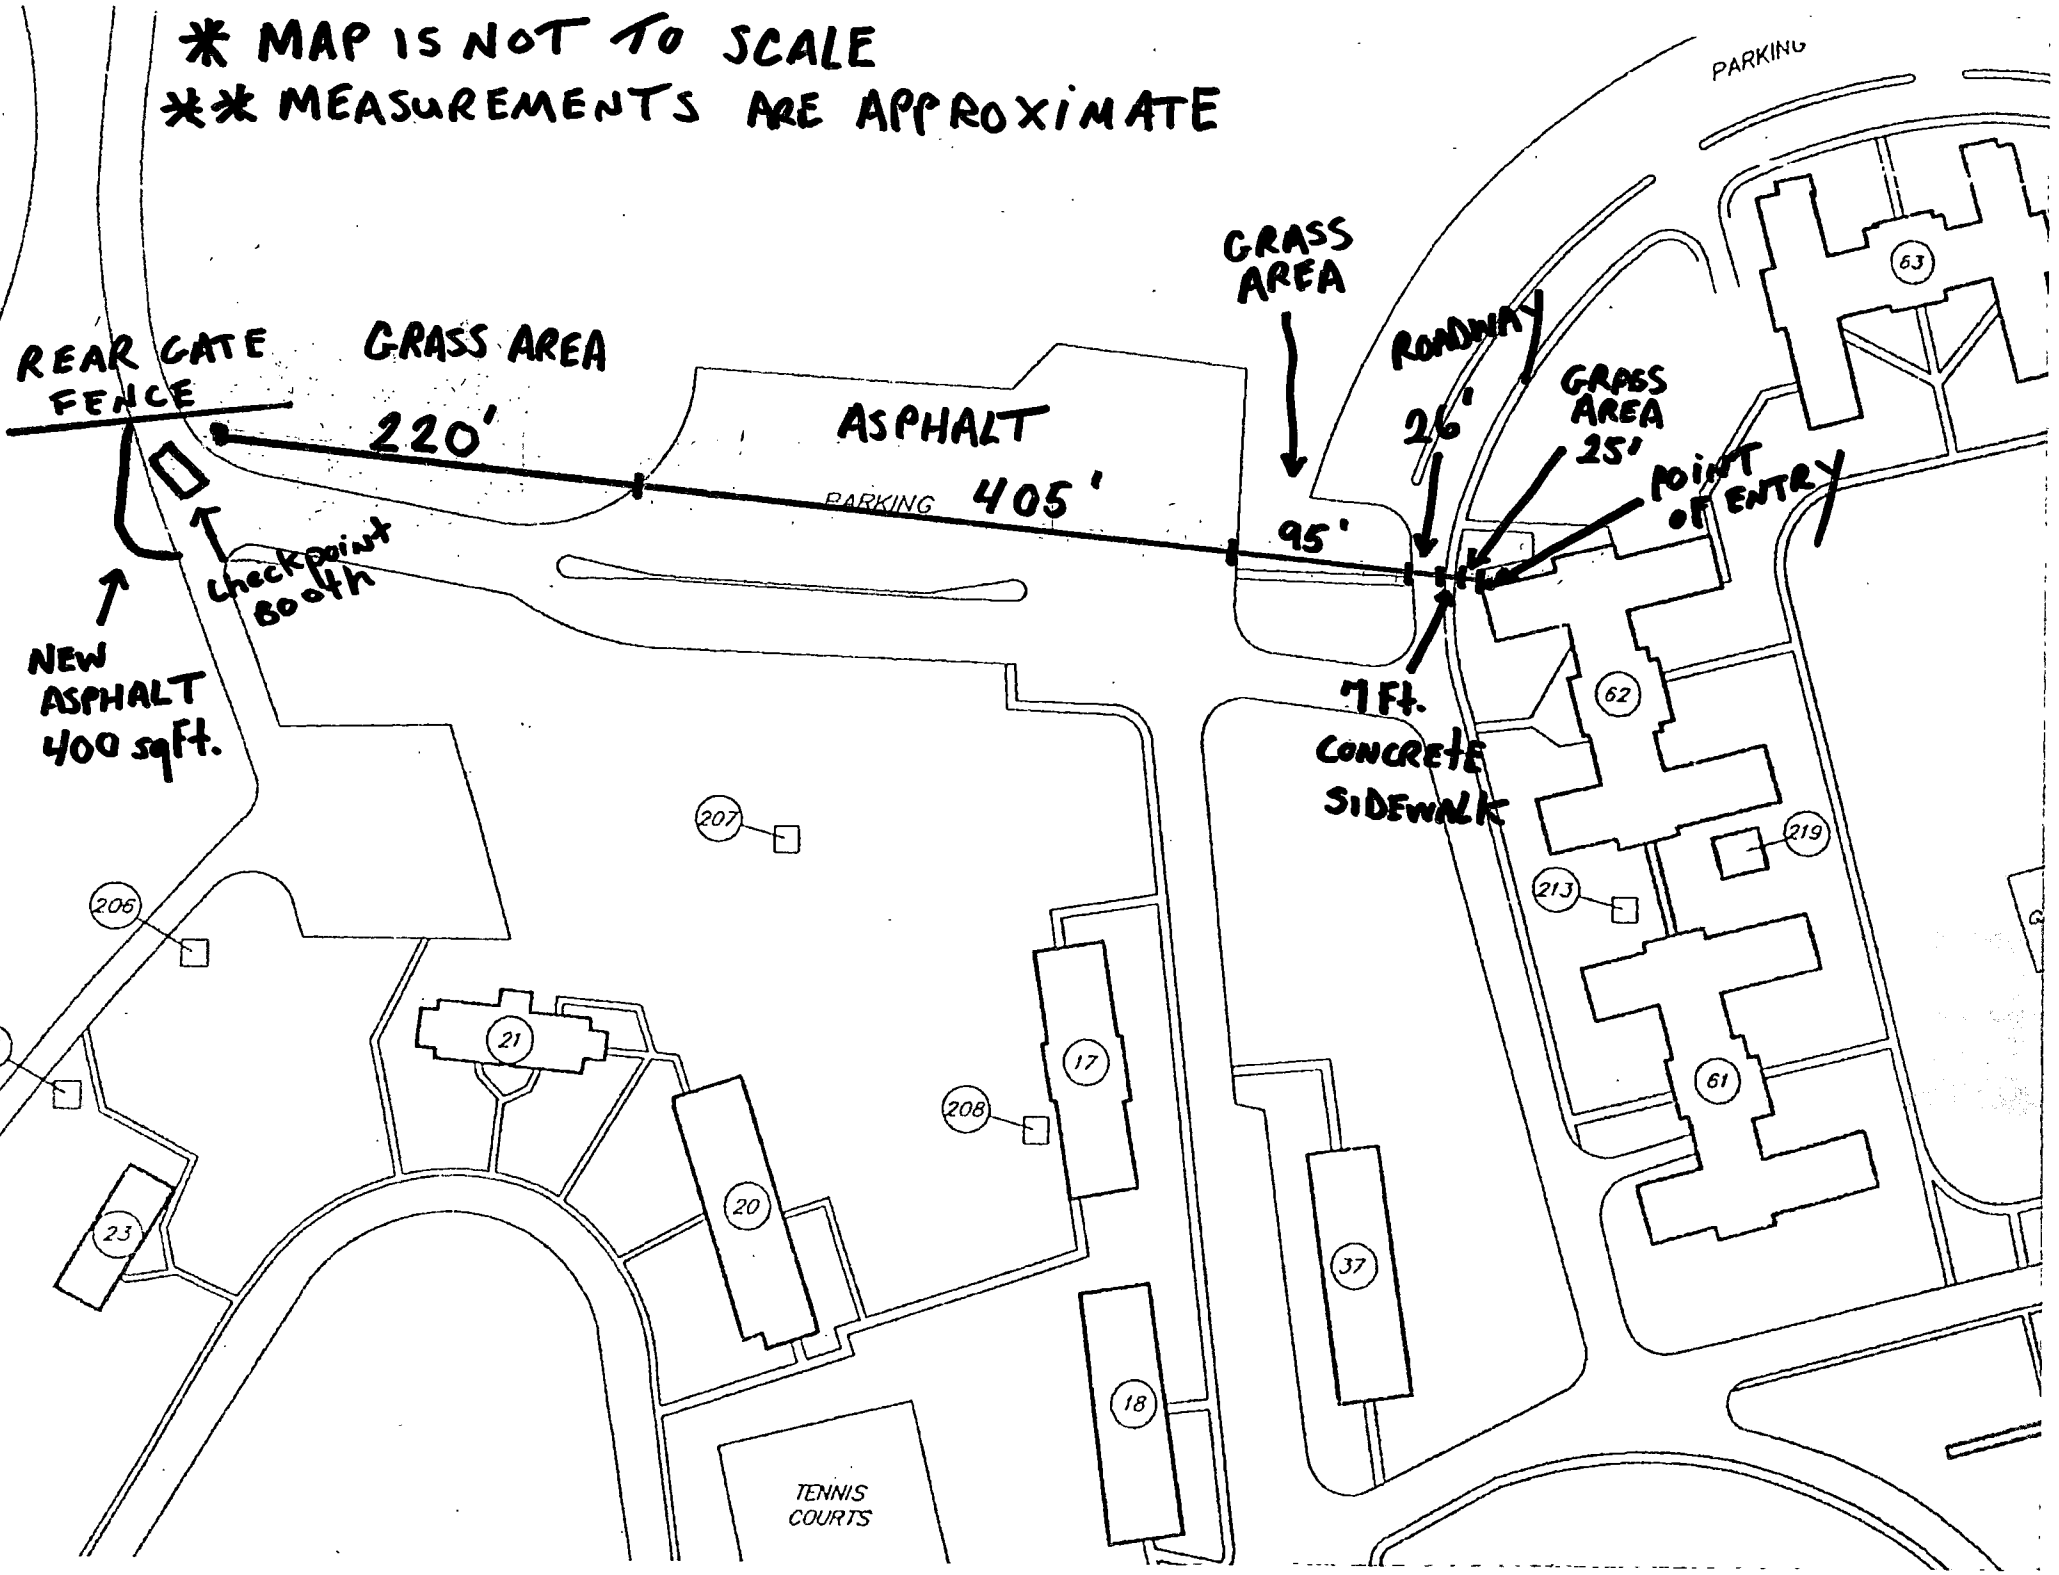

REAR GATE FENCE

GRASS AREA  
220'

ASPHALT  
PARKING 405'

GRASS AREA

ROADWAY

GRASS AREA  
25'

POINT OF ENTRY

95'

26'

7 FT.  
CONCRETE  
SIDEWALK

NEW ASPHALT  
400 sqft.

CHECKPOINT BOOTH

TENNIS COURTS

PARKING

206

207

21

23

20

208

17

18

213

219

37

61

62

63