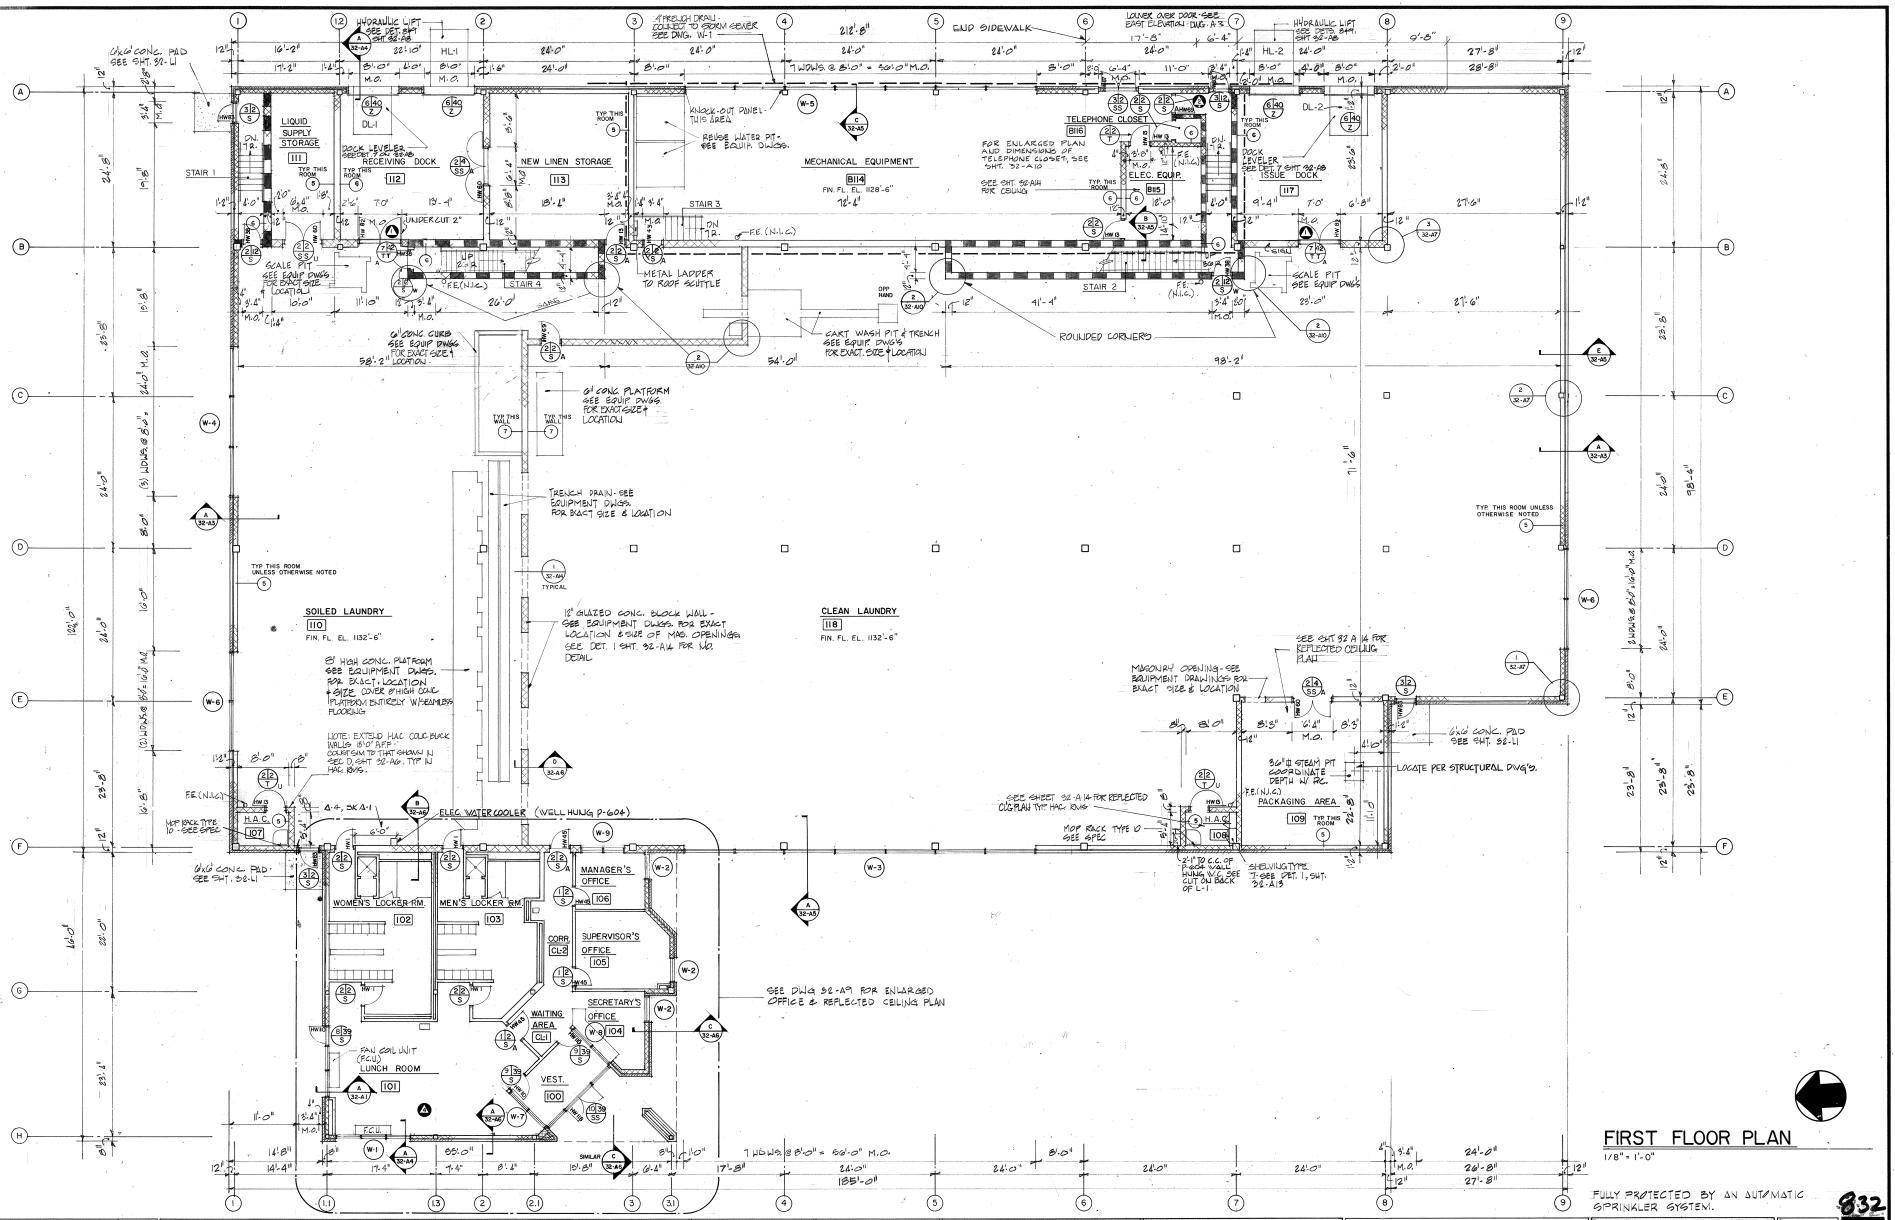

FIRST FLOOR PLAN

1/8" = 1'-0"

FULLY PROTECTED BY AN AUTOMATIC SPRINKLER SYSTEM.

832

Revisions	Date
REVISE DRS TO SINGLE ACTING	10/6/84
REVISE DR. TO 'C' LABEL	10/6/84
GEN. - HARDWARE SETS INDICATED	10/8/84
ADDED WINDOW SEAT DETAIL	10/3/84
AS BUILT DRAWINGS	11/6/81

Engineer
DODSON ENGINEERING, INC.
1404 COMMONWEALTH BLDG. 316 FOURTH AVE.
PITTSBURGH, PA. 15222 (412) 261-6515

Architect
CARL G. BAKER CORPORATION
EDGETOWN SQUARE, SUITE 100
1005 BEAVER GRADE RD.
CORAOPOLIS, PA. 15108 (412) 262-2668

Engineer
HORNFECK ENGINEERING, INC.
1503 COMMONWEALTH BLDG. 316 FOURTH AVE.
PITTSBURGH, PA. 15222 (412) 281-5644

Engineer
BRACE ENGINEERING, INC.
9270 OLD PERRY HWY. P.O. BOX 15128
PITTSBURGH, PA. 15237 (412) 367-7700

Drawing Title: FIRST FLOOR PLAN
1/8" = 1'-0"

Approved Project Director

Drawn

Checked

Project Title: CENTRAL LAUNDRY FACILITY
VETERANS ADMINISTRATION MED. CENTER

Date

Project No: 645-017

Building Number: 32

Location: HIGHLAND DRIVE, PITTSBURGH, PA. 15206

DRAWING NO: 32-A-1

Dwg. 1 Of 14

Veterans Administration