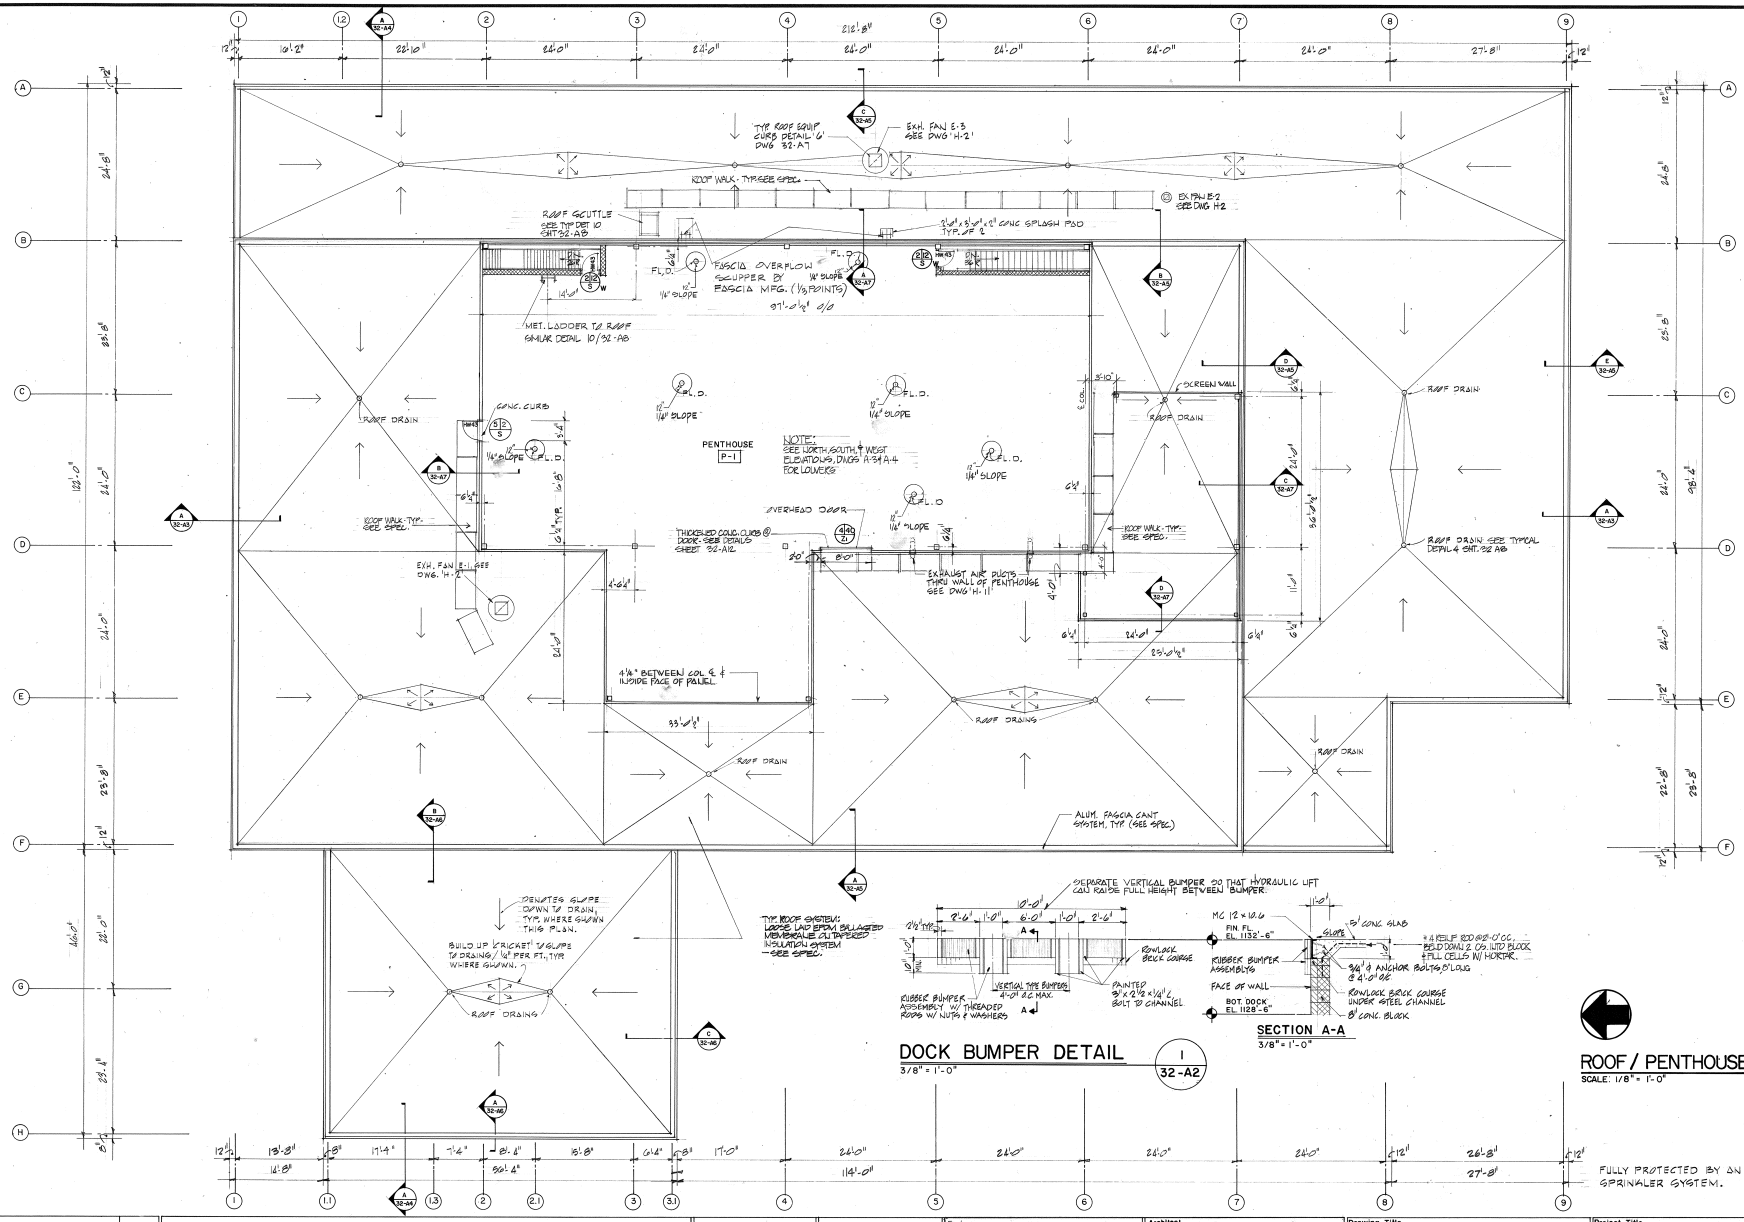


## DOCK BUMPER DETAIL

3/8" = 1'-0"

1 / 32-A2

## SECTION A-A

3/8" = 1'-0"

## ROOF / PENTHOUSE PLAN

SCALE: 1/8" = 1'-0"

| | | | | | | | | |
|---|---|---|---|---|---|---|---|---|
| AS BUILT DRAWINGS | 1/27/87 | | Engineer: DODSON ENGINEERING, INC. 1404 COMMONWEALTH BLDG. PITTSBURGH, PA. 15222 — 316 FOURTH AVE. (412) 261-6515 | Architect: CARL G. BAKER CORPORATION EDGETOWN SQUARE, SUITE 100 1000 BEAVER GRADE RD. CORAOPOLIS, PA. 15108 (412) 262-2668 | Drawing Title: ROOF & PENTHOUSE PLAN 1/8" = 1'-0" | Project Title: CENTRAL LAUNDRY FACILITY VETERANS ADMINISTRATION MED. CENTER | Date | |
| Revisions | Date | | Engineer: HORNFECK ENGINEERING, INC. 1503 COMMONWEALTH BLDG. PITTSBURGH, PA. 15222 — (412) 281-5644 | Engineer: BRACE ENGINEERING, INC. 9270 OLD PERRY HWY. P.O. BOX 15128 PITTSBURGH, PA. 15237 (412) 367-7700 | Approved Project Director | Drawn / Checked | Project No: 645-017 | |
| | | | | | | Building Number: 32 | DRAWING No: 32-A-2 | |
| | | | | | | Location: HIGHLAND DRIVE, PITTSBURGH, PA 15206 | Dwg. 2 of 14 | |

Veterans Administration