PLANTING INDEX

NO.	NAME	SIZE	QUANTITY	COMMENTS
①	JAP BLACK PINE (PINUS THUNBERGII)	6'-8'	6	PLANT 12'0"O.C.
②	DWARF WINGED EUONYMUS	2'-3'	114	PLANT 3'-0"O.C.
③	PURPLE LEAF PLUM (PRUNUS CERISIFERA)	8'-10'	8	PLANT 30'-0" O.C.
④	JAP. CHERRY (PRUNUS SERRULATA KWANZAN)	4'-5'	3	PLANT 9'-0"O.C.
⑤	WHITE BIRCH (BETULA VERRUCOSA)	10'-12'	7	PLANT 18'0"O.C.

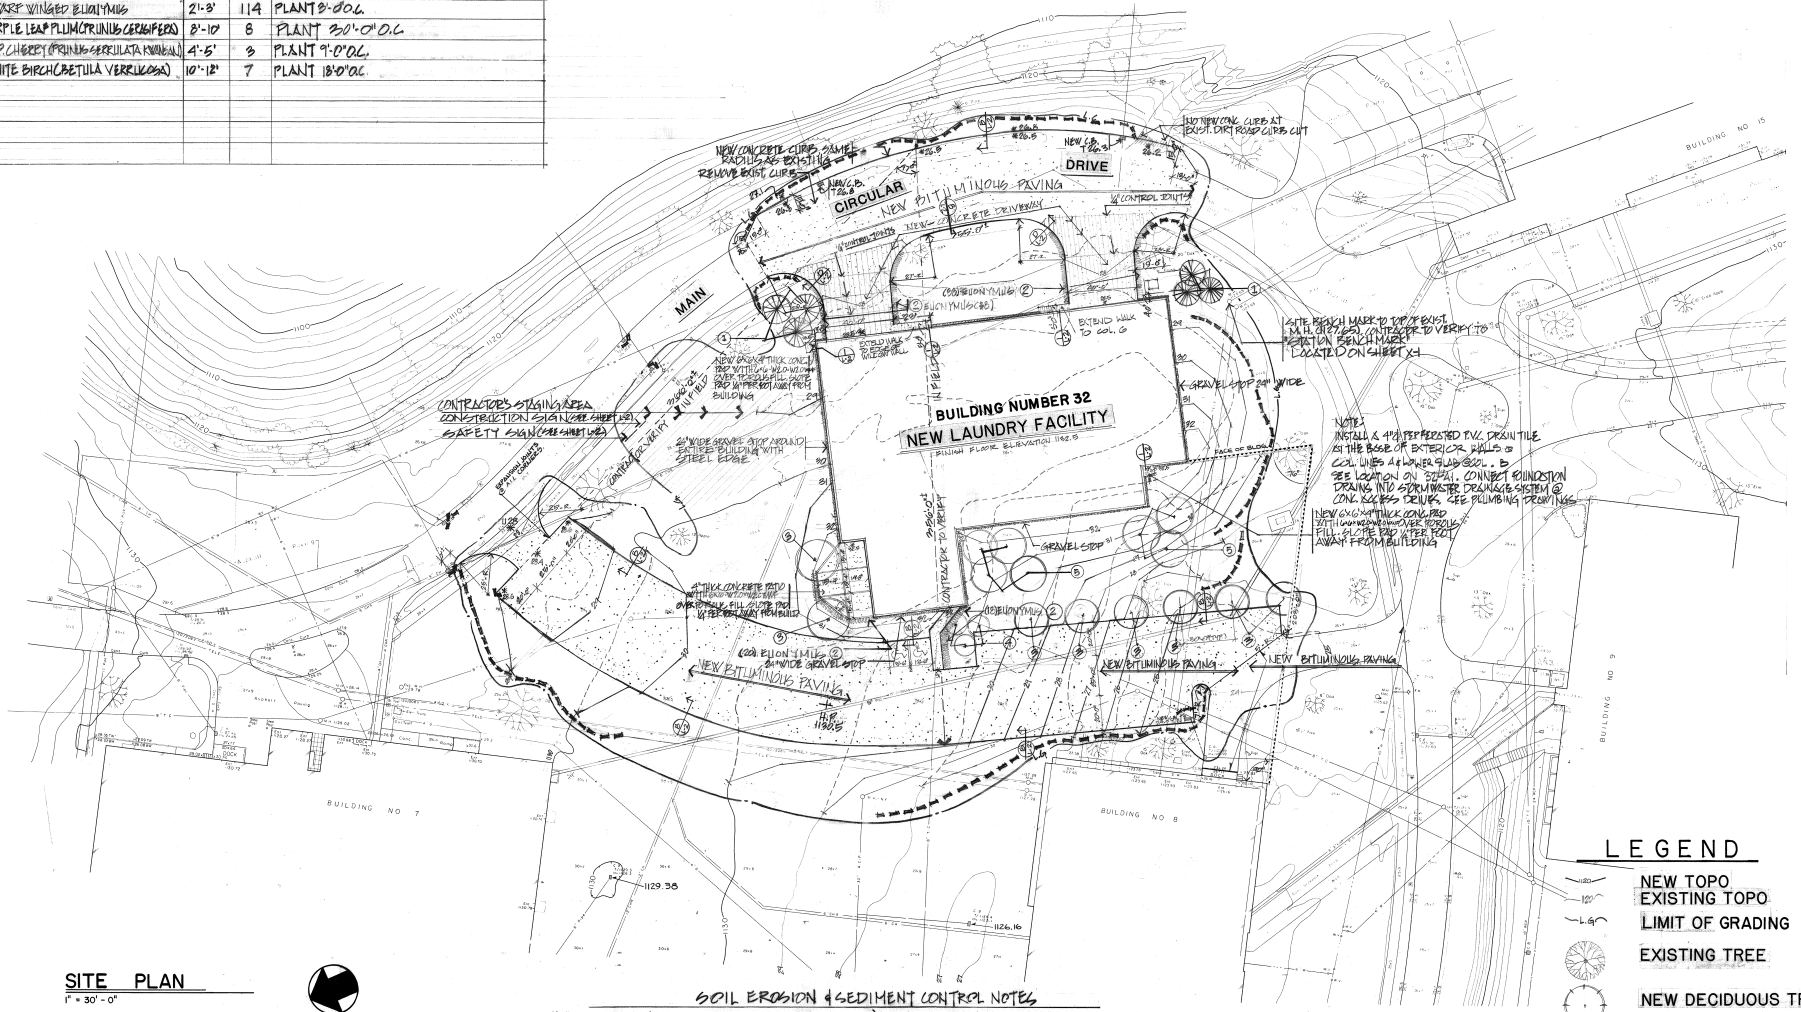

SITE PLAN

1" = 30'-0"

0 30' 60' 90' 120'

SOIL EROSION & SEDIMENT CONTROL NOTES

1) ALL CONSTRUCTION SHALL BE IN ACCORDANCE WITH STATE OF PA. SOIL EROSION CONTROL STANDARDS
2) CRUSHED STONE (MINIMUM 6 INCH DEPTH) SHALL BE PLACED AT ALL CONSTRUCTION & SITE ACCESS POINTS. STONE SHALL BE PLACED PRIOR TO CONSTRUCTION & MAINTAINED IN GOOD CONDITION.
3) ALL AREAS DISTURBED BY GRADING & NOT CONSTRUCTED UPON FOR 30 DAYS, SHALL BE COVERED WITH STRAW (3810.6.1(2)(9)). MULCH TO BE ANCHORED.
4) ALL DRIVES & PAVED AREAS SHALL BE STABILIZED WITH BASE PAVEMENT COURSE IMMEDIATELY UPON ESTABLISHMENT OF FINAL GRADE
5) ALL CATCH BASINS ADJACENT TO PROJECT SITE TO BE PROVIDED WITH STRAW BALES & SHALL BE MAINTAINED UNTIL COMPLETION OF PROJECT
6) ALL DISTURBED AREAS WITHIN THE GRADING LIMITS AND BEYOND SHALL BE SEEDED AS SPECIFIED

LEGEND

- NEW TOPO
- EXISTING TOPO
- LIMIT OF GRADING
- EXISTING TREE
- NEW DECIDUOUS TREE
- NEW CONIFER TREE
- NEW SHRUB
- ANCHORED STRAW BALES

832

Revisions	Date
45 BUILT DWG'S	1/6/87

Engineer: DODSON ENGINEERING, INC. — 1404 COMMONWEALTH BLDG. 345 FOURTH AVE. PITTSBURGH, PA. 15222 (412) 261-6515

Architect: CARL G. BAKER CORPORATION — EDGETOWN SQUARE, SUITE 100, 1005 BEAVER GRADE RD. CORAOPOLIS, PA. 15108 (412) 262-2668

Engineer: HORNFECK ENGINEERING, INC. — 1503 COMMONWEALTH BLDG. 345 FOURTH AVE. PITTSBURGH, PA. 15222 (412) 281-5644

Engineer: BRACE ENGINEERING, INC. — 9270 OLD PERRY HWY. P.O. BOX 15128 PITTSBURGH, PA. 15237 (412) 367-7700

Drawing Title: SITE & EROSION CONTROL PLAN

Project Title: CENTRAL LAUNDRY FACILITY — VETERANS ADMINISTRATION MED CENTER

Date:

Project No: 645-017

Approved Project Director:

Drawn:

Checked:

Building Number: 32

DRAWING NO: 32-L-1

Location: HIGHLAND DRIVE, PITTSBURGH, PA 15206

Dwg 1 of 3

Veterans Administration