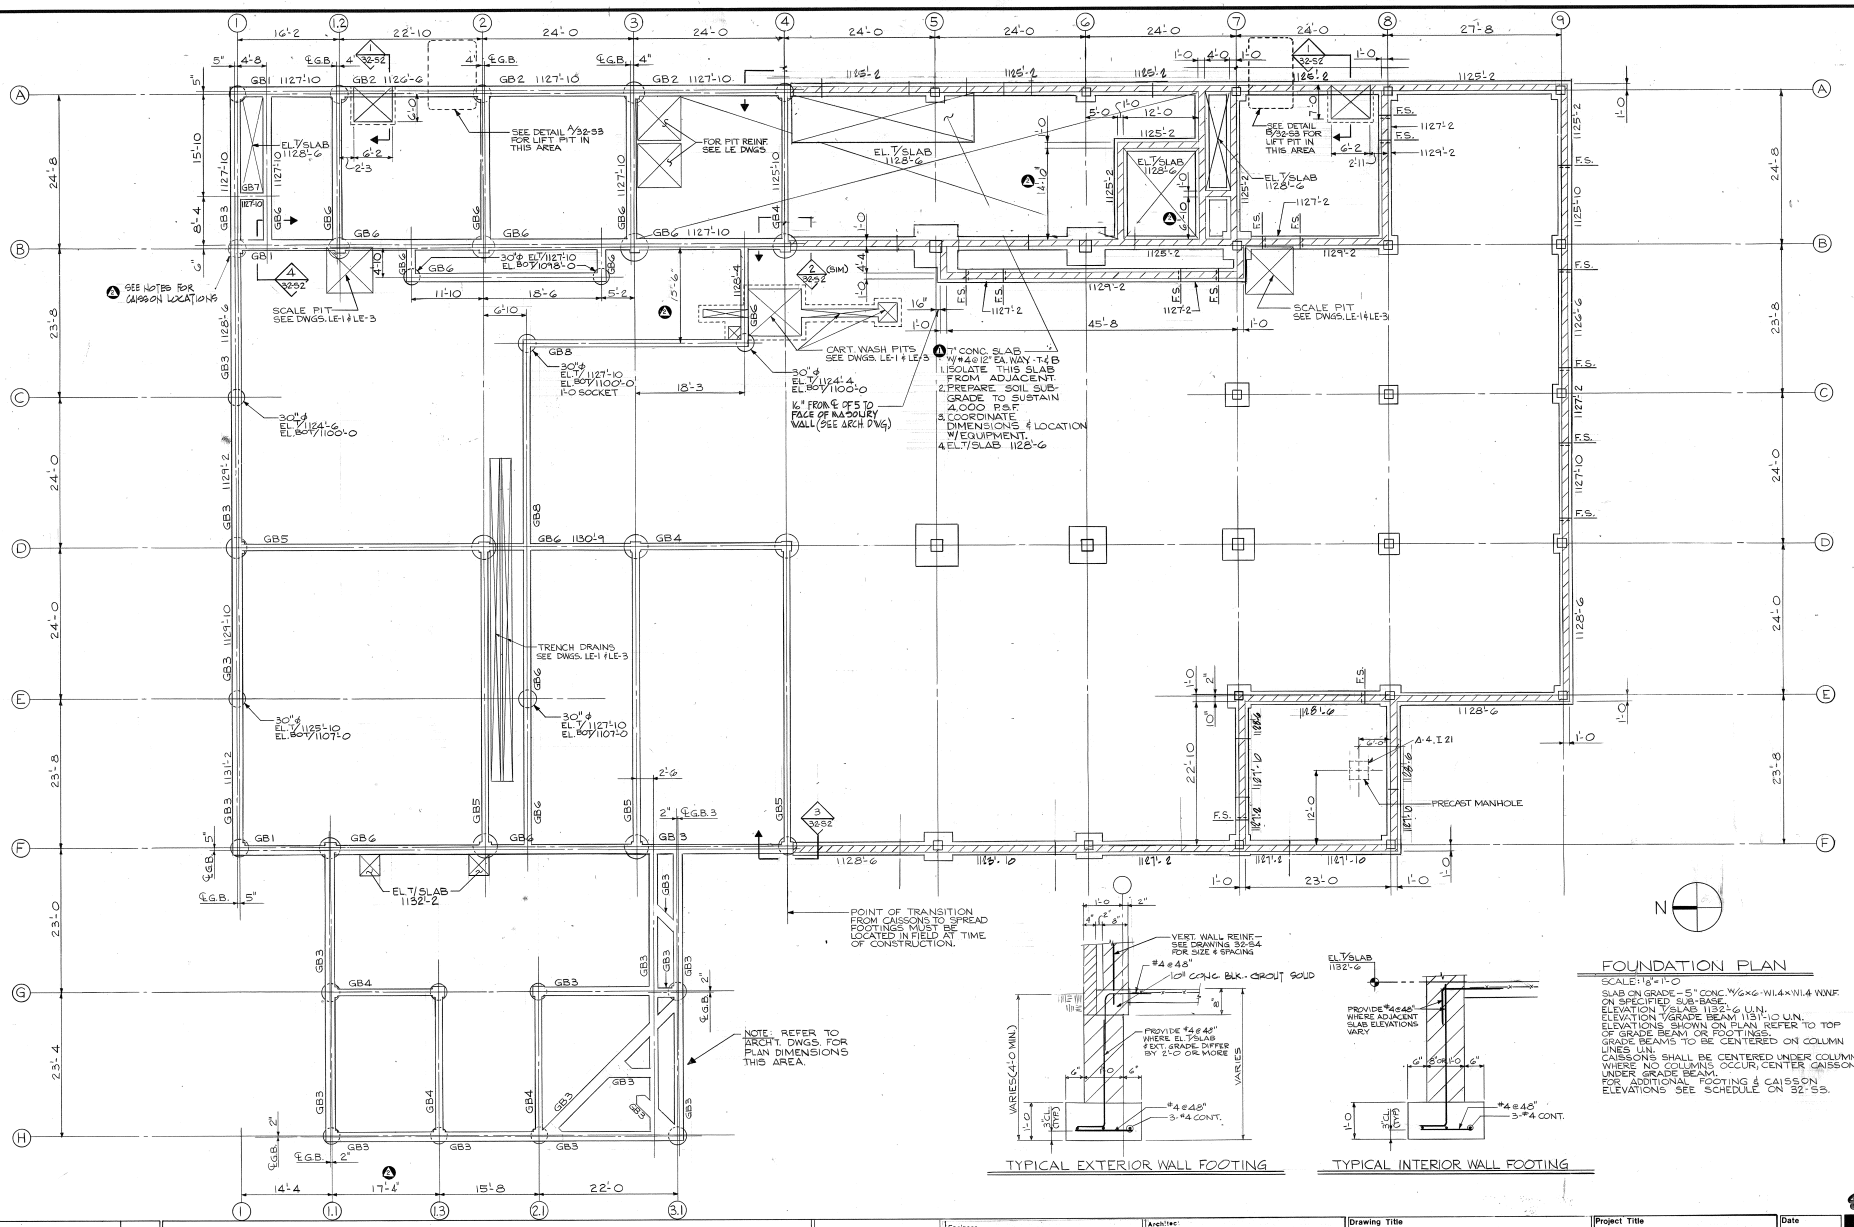

FOUNDATION PLAN

SCALE: 1/8" = 1'-0

SLAB ON GRADE - 5" CONC. W/ 6x6 - W1.4 x W1.4 W.W.F. ON SPECIFIED SUB-BASE.
ELEVATION T/SLAB 1132'-6 U.N.
ELEVATION T/GRADE BEAM 1131'-10 U.N.
ELEVATIONS SHOWN ON PLAN REFER TO TOP OF GRADE BEAM OR FOOTINGS.
GRADE BEAMS TO BE CENTERED ON COLUMN LINES U.N.
CAISSONS SHALL BE CENTERED UNDER COLUMNS. WHERE NO COLUMNS OCCUR, CENTER CAISSON UNDER GRADE BEAM.
FOR ADDITIONAL FOOTING & CAISSON ELEVATIONS SEE SCHEDULE ON 32-55.

Revisions	Date
A AS BUILT DRAWINGS	1/31/85
A GENERAL	11/28/84
A REVISED SLAB FOR TANKS	10/8/84

FRANK C. BRACE — REGISTERED PROFESSIONAL ENGINEER — No. 21734 — COMMONWEALTH OF PENNSYLVANIA

Engineer: DODSON ENGINEERING, INC. — 1404 COMMONWEALTH BLDG. 316 FOURTH AVE. PITTSBURGH, PA. 15222 (412) 261-6515

Architect: CARL G. BAKER CORPORATION — 971 THIRD STREET P.O. BOX 520 BEAVER, PA. 15009 (412) 774-8054

Engineer: HORNFECK ENGINEERING, INC. — 1503 COMMONWEALTH BLDG. 316 FOURTH AVE. PITTSBURGH, PA. 15222 (412) 281-9614

Engineer: BRACE ENGINEERING, INC. — 9270 OLD PERRY HWY. P.O. BOX 15128 PITTSBURGH, PA. 15237 (412) 367-7700

Drawing Title: FOUNDATION PLAN

Approved Project Director: J.P. Brace

Drawn: D.A.B.

Checked: J.J.C.

Project Title: CENTRAL LAUNDRY FACILITY — VETERANS ADMINISTRATION MED. CENTER

Building Number: 32

Location: HIGHLAND DRIVE PITTSBURGH, PA

Date:

Project NO: 645-017

DRAWING NO: 32-S-1

Dwg. 1 of 6

Veterans Administration