
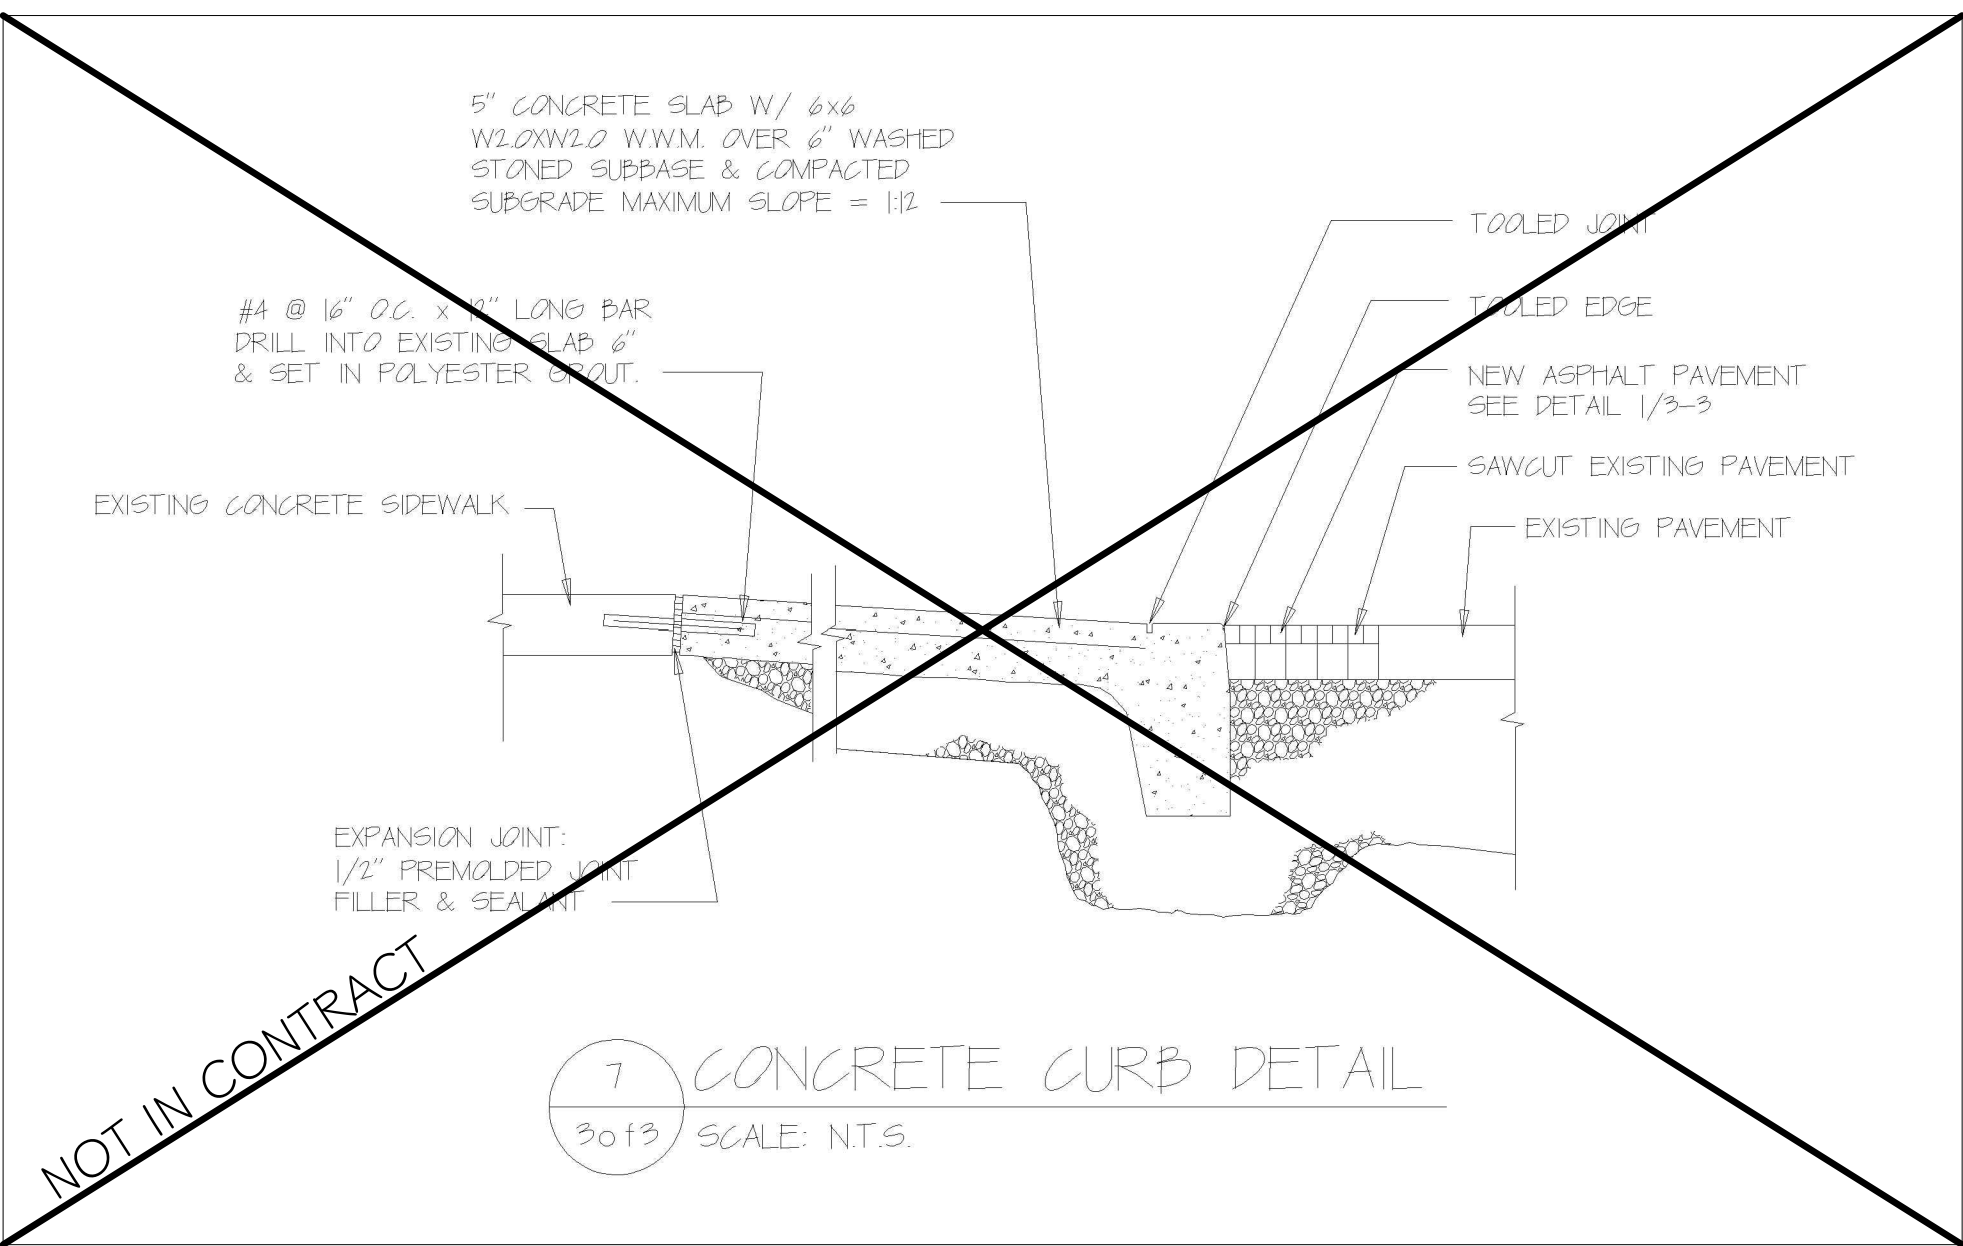
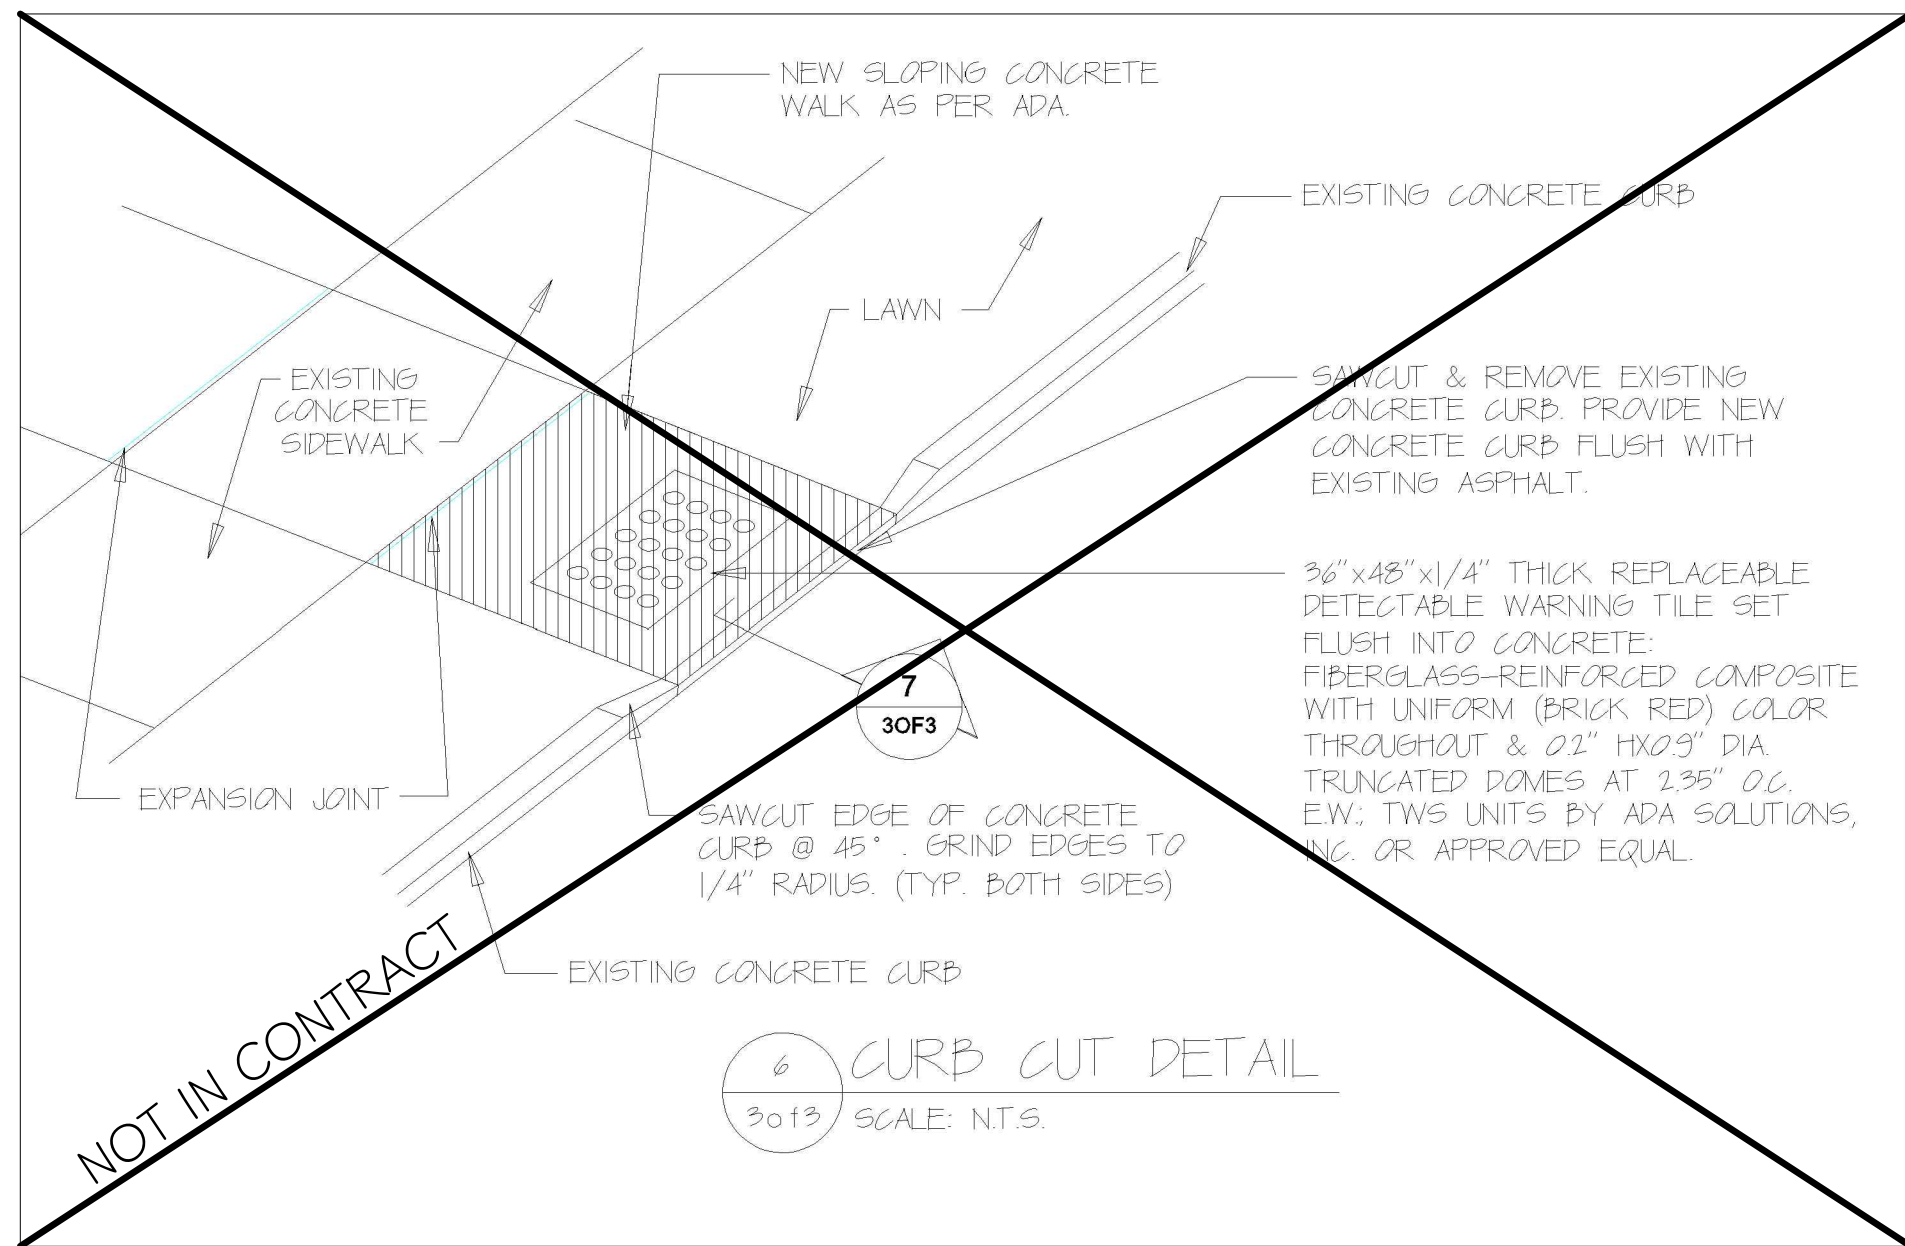
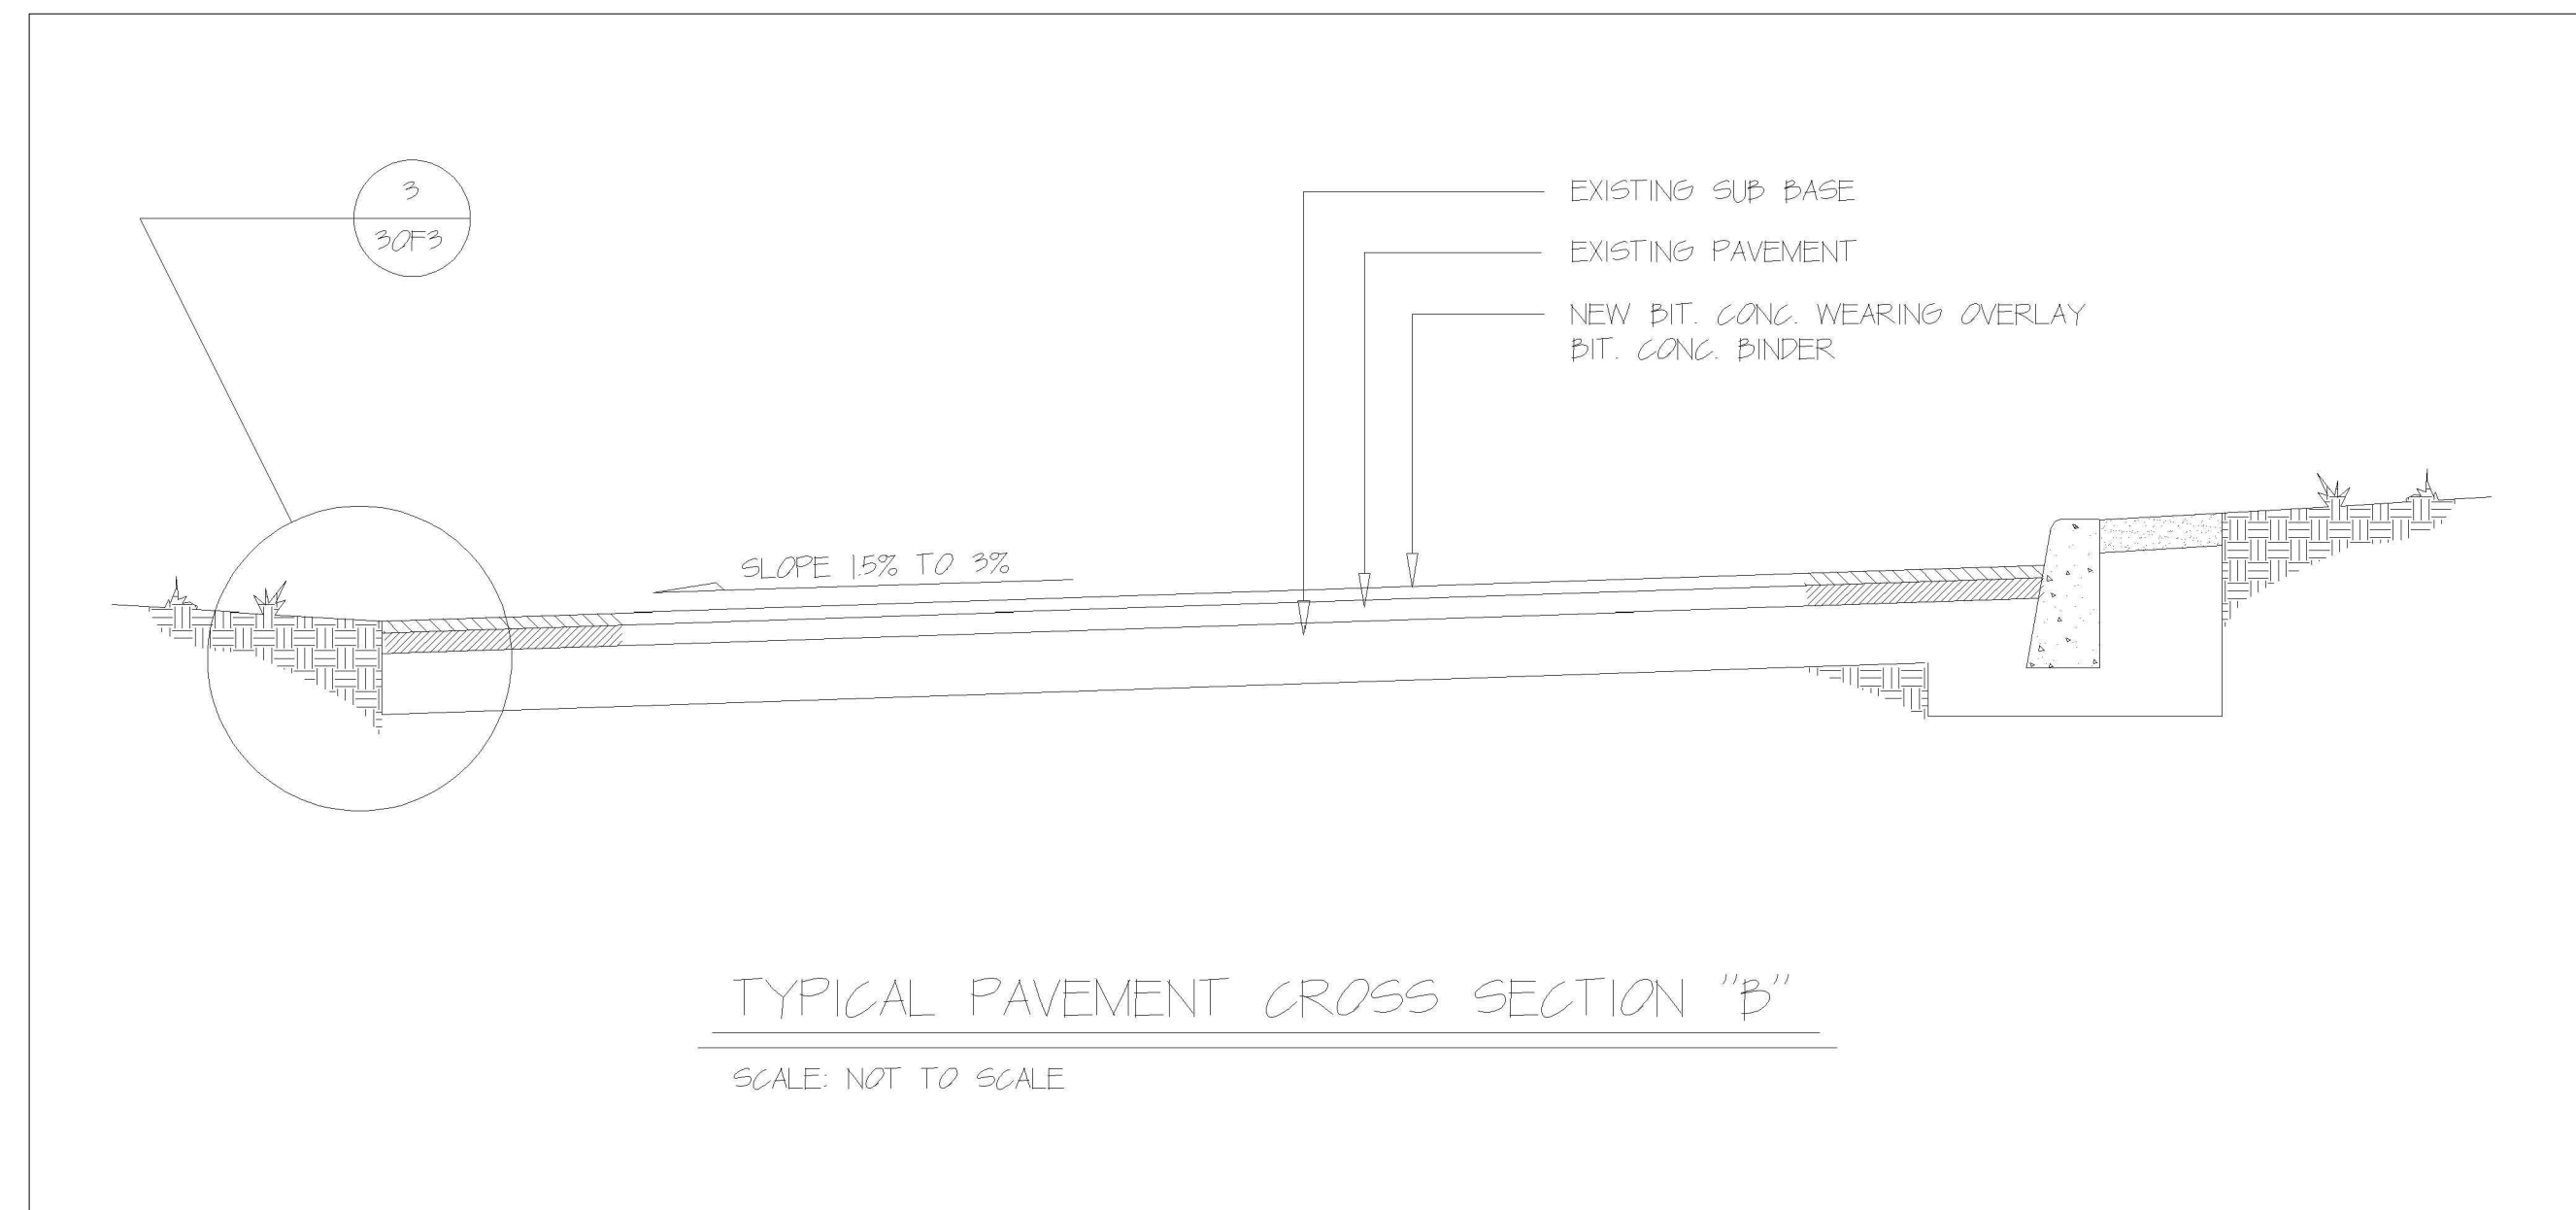


- GENERAL NOTES:
1. CONTRACTOR SHALL VERIFY EXISTING CONDITIONS AND DIMENSIONS AT THE JOB SITE PRIOR TO BIDDING THE PROJECT.
 2. ALL TRAFFIC CONTROL AND ALL SAFETY DEVICES INCLUDING SIGNAGE SHALL BE PROVIDED BY THE CONTRACTOR.
 3. PRIOR TO COMMENCEMENT OF WORK, THE CONTRACTOR SHALL SUPPLY & INSTALL BARRICADES AS DEEMED NECESSARY BY THE COTR.
 4. THE CONTRACTOR SHALL PROVIDE COPIES OF ALL MATERIAL DELIVERY "BATCH" TICKETS TO THE PROJECT COTR.
 5. ALL WORK TO BE COMPLETED DURING NORMAL WORK HOURS MONDAY THROUGH FRIDAY 8:00AM TO 4:30PM.
 6. ANY CHANGE TO NORMAL WORK HOURS MUST BE REQUESTED AND APPROVED BY THE VA MEDICAL CENTER. REQUESTS FOR CHANGE MUST BE MADE IN WRITING, TO THE PROJECT COTR, 2 DAYS PRIOR TO PLANNED WORK.
 7. GRIND/MILL/REMOVE EXISTING ASPHALT CONCRETE PAVING SURFACE TO 3" DEPTH. REMOVE ALL MATERIALS FROM THE FACILITY AND DISPOSE OF IN A PROPER MANNER.
 8. PREPARE REMAINING ASPHALT MATERIAL FOR THE INSTALLATION OF NEW ASPHALT OVERLAY IN ACCORDANCE WITH NYS DOT STANDARDS.
 9. IN ALL AREAS WHERE NEW PAVEMENT IS BOUNDED BY EXISTING PAVEMENT, THE PAVEMENT SHALL BE SAW CUT PERPENDICULAR TO THE TOTAL DEPTH OF MATERIAL TO BE REMOVED. NEW PAVEMENT SHALL HAVE A SMOOTH TRANSITION TO EXISTING PAVING.
 10. NEW ASPHALT CONCRETE PAVEMENT SHALL CONSIST OF 15" OF TYPE 3 DENSE BINDER & 15" OF 7" WEARING COURSE.
 11. ALL MANHOLES, HANDHOLES, DROP INLETS, CURB DRAINS AND VALVE BOXES SHALL BE ALTERED TO MAINTAIN EXISTING ELEVATION OF NEW PAVEMENT.
 12. ALL FACILITY PARKING AREAS & ROADWAYS SHALL BE KEPT FREE OF ANY CONSTRUCTION DEBRIS. THE CONTRACTOR SHALL BE RESPONSIBLE FOR CLEANING IMPACTED AREAS AT THE END OF EACH WORK DAY.
 13. THE CONTRACTOR SHALL BE REPAIR ANY AREAS DISTURBED BY NEW CONSTRUCTION TO ORIGINAL CONDITIONS.

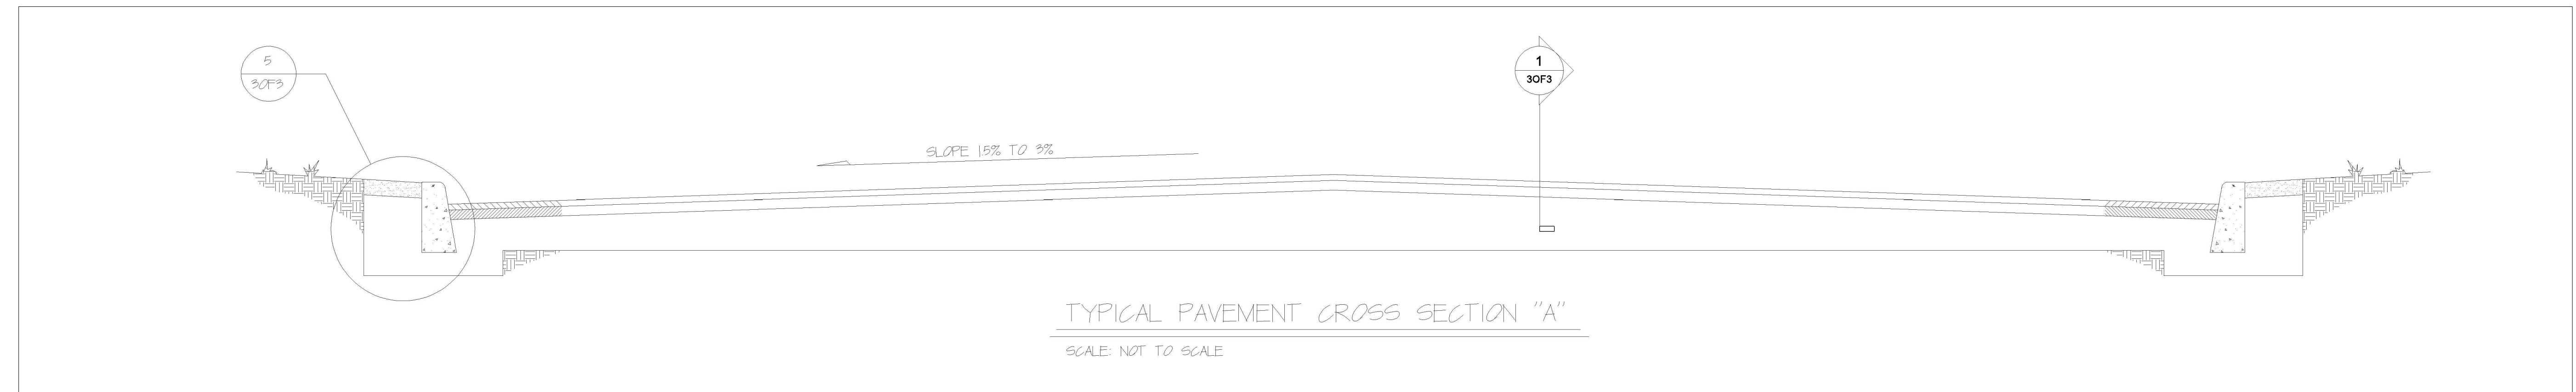

Revisions	Date

Drawing Title NOTES & DETAILS	
Approved: Engineering Project Manager	Date
Approved: Medical Center Director	Date

Project Title RENOVATE ROADS & SIDEWALKS		
Building No STATION	Checked JAY	Drawn JHH
Location BATH, NEW YORK		

Date 05/11/2012
Project No 528A6-12-623
DRAWING NO VAMC-528A6-1740
S-2
Dwg. 3 Of 3

V.A.