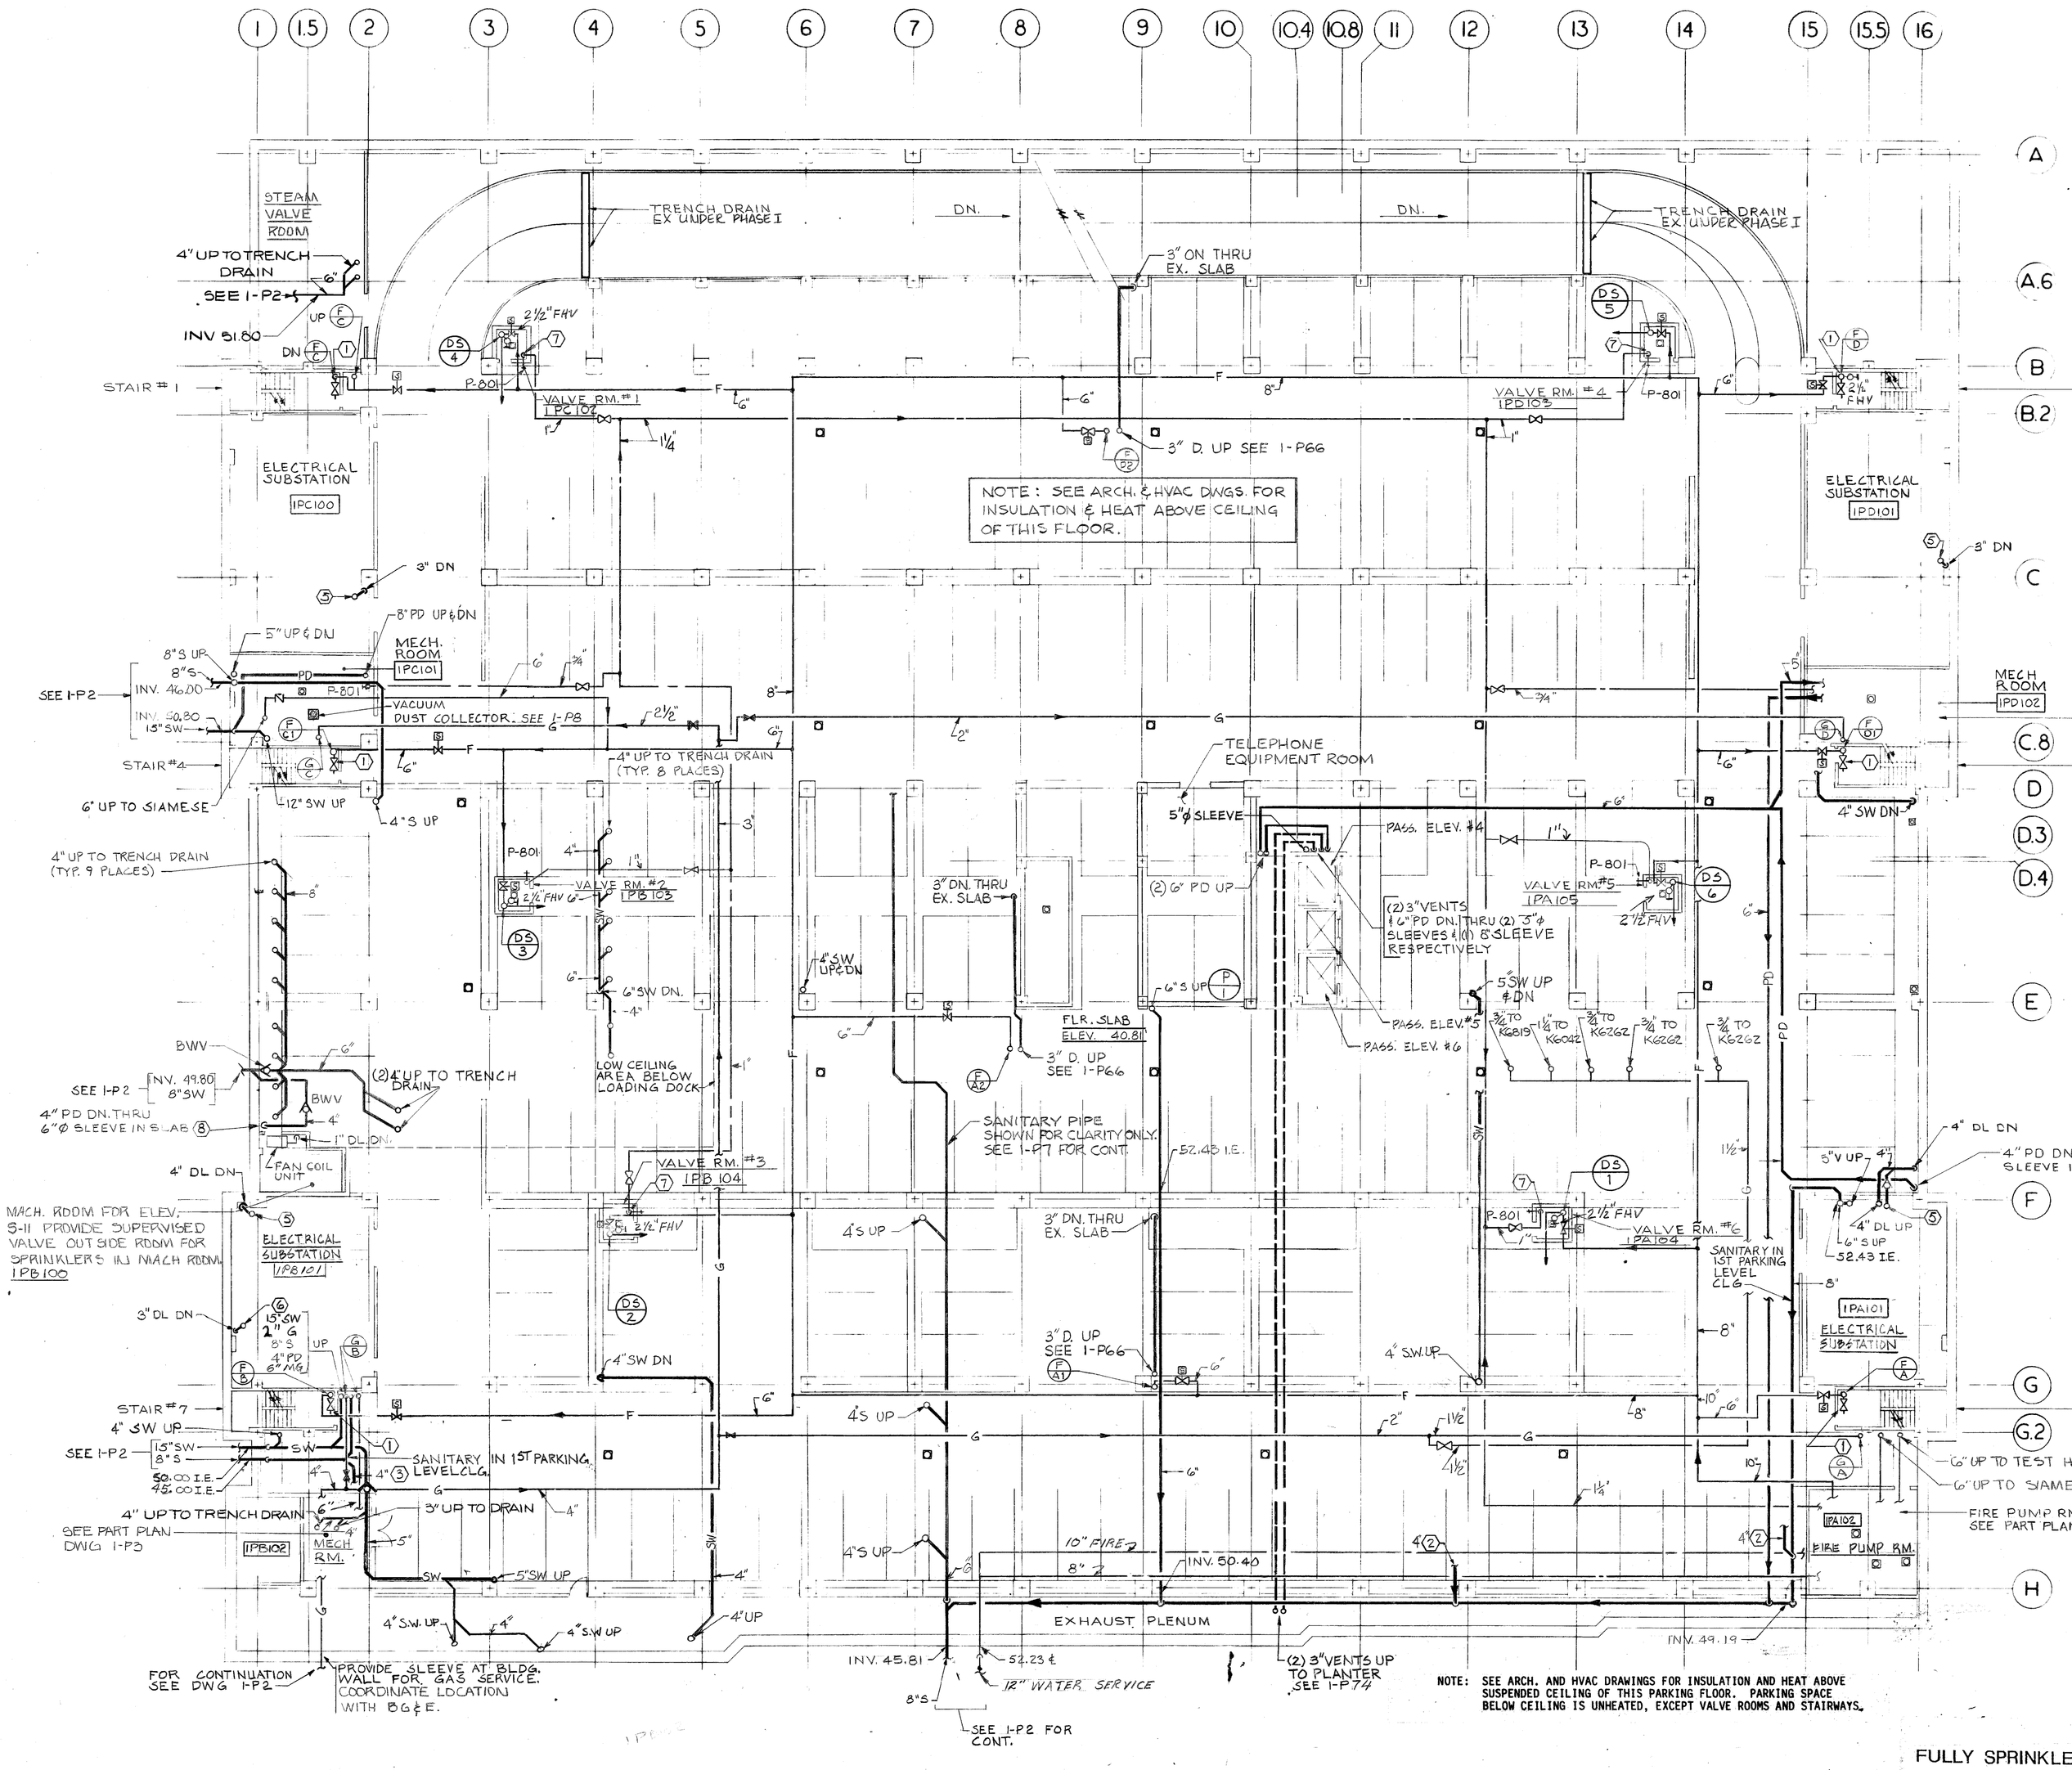

DRAWING NOTES: (APPLY TO THIS DRAWING ONLY)

1. ALL DRAINS ON THIS DRAWING ARE EXISTING. PROVIDED UNDER PHASE I. ALL OTHER INDICATED WORK TO BE PROVIDED UNDER THIS CONTRACT PHASE.
2. ALL PIPING SHOWN ON THIS DRAWING IS ABOVE CEILING UNLESS OTHERWISE INDICATED.
3. DRY SPRINKLER SYSTEM PIPING FOR THIS FLOOR SHALL BE ABOVE CEILING.
4. PROVIDE 3' X 3' ACCESS DOOR IN CEILING AT EACH SUPERVISED VALVE. LABEL DOOR "FIRE VALVE ABOVE".
5. SEE DRAWING 1-P4 FOR DRY SPRINKLER SYSTEM CONVERAGE DESCRIPTION.

SPECIAL NOTES: (APPLY TO THIS DRAWING ONLY)

(1) 6" F. UP AND DOWN THROUGH 8" DIAMETER SLEEVE IN SLAB. LOCATE 2-1/2" F.D.V. AT FLOOR LANDING 60" A.F.F.
(2) SEE DRAWING 1-P6 FOR CONTINUATION.
(3) SEE DRAWING 1-P7 FOR CONTINUATION.
(4) SEE DRAWING 1-P9 FOR CONTINUATION.
(5) 3" UP TO 3" D-B.
(6) 3" UP to 3" DSB.
(7) 1" CW DOWN.
(8) PROVIDE HEAT TAPE AND INSULATION OVER TAPE FOR ALL SUMP PUMP DISCHARGE PIPING. FROM CHECK VALVE TO CEILING OF FIRST PARKING LEVEL. TYPICAL FOR PUMPS NO. 50, 51, 52, 53, 54, 55, 56. HEAT TAPE PROVIDED UNDER ELECTRICAL DIVISION.

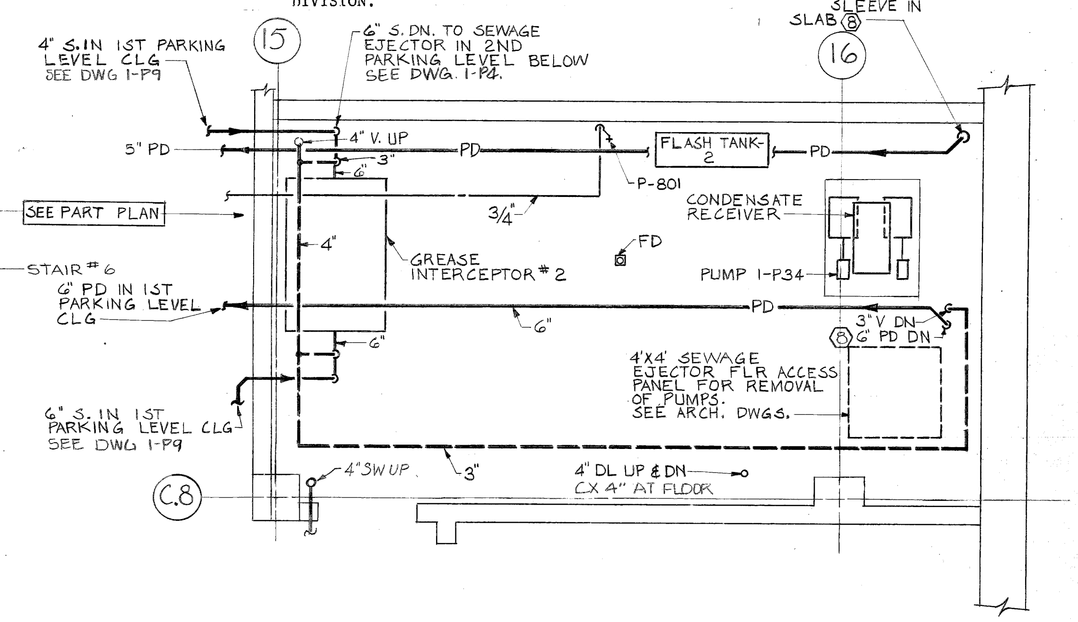

PART PLAN ROOM 1PD102

SCALE: 1/4"=1'-0"

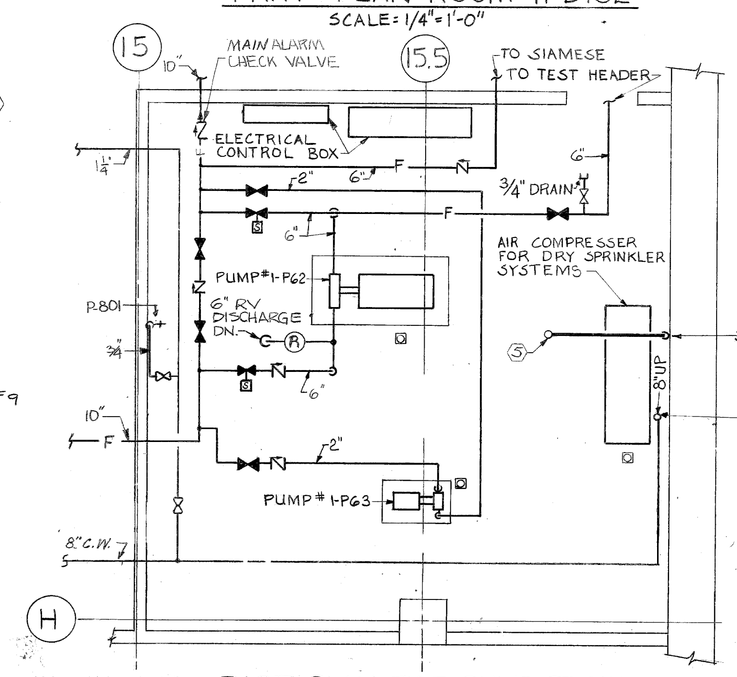

PART PLAN FIRE PUMP ROOM

SCALE: 1/4"=1'-0"

NOTE: SEE ARCH. AND HVAC DRAWINGS FOR INSULATION AND HEAT ABOVE SUSPENDED CEILING OF THIS PARKING FLOOR. PARKING SPACE BELOW CEILING IS UNHEATED, EXCEPT VALVE ROOMS AND STAIRWAYS.

8-0-1-1164

FULLY SPRINKLERED

RECORD DRAWING
CORRECTED ON BASIS OF DATA FURNISHED BY THE RESIDENT ENGINEER

"AS BUILT" 6/17/99
Revisions Date

Key Plan

NORTH

STATE OF MARYLAND RICHARD D. TUTT No. 11811 PROFESSIONAL ENGINEER
Seal

RTKL/CSD/HENRY ADAMS (J.V.)
ARCHITECTS AND ENGINEERS
400 E. PRATT STREET
BALTIMORE, MD 21202

HENRY ADAMS, INC.
Consulting Engineers
Baltimore, Maryland

Drawing Title: 1ST PARKING FLOOR PLAN PLUMBING

Approved Project Director: J. Albert Miller

Scale: 1/16"=1'-0"

Checked:

Project Title: 324 - BED REPLACEMENT HOSPITAL - PHASE II

Building Number: 1

Location: VAMC - BALTIMORE, MD.

Date: 9/1/88

Project No.: 511-001D

DRAWING NO.: 1-P5

Dwg. 6 Of 74

Veterans Administration

VA FORM 08-6231, OCT 1978

H.A. JOB NO. V-002