

**REQUEST FOR INFORMATION (RFI)
36C250-18-B-0081**

PROJECT NUMBER:	610-15-100	Please ensure that before submitting questions or requests for clarification that you thoroughly read the solicitation, specifications, drawings and other pertinent documents. When submitting questions on this project the Government requires contractors to specifically identify the specification and/or solicitation section(s) or drawing number(s) in reference to the question or request for clarification submitted. No question or request for clarification will be answered by the Government unless the above requirements are met. Failure to comply may prevent the Government from responding in a timely manner.
PROJECT TITLE:	Demolish Bldgs. 7,10,11,18,24,60 and Connecting Corridors	
PROJECT LOCATION:	Department of Veterans Affairs VA Northern Indiana HCS 1700 E. 38 th Street Marion, IN 46953	

SUBMITTED BY:	Shambaugh & Son, L.P.	CITY/STATE:	Marion, IN
PHONE:	260-224-5007		

TO:
 Felecia Beamen, Contracting Officer
 Department of Veterans Affairs
 Network 10 Contracting Office
 8888 Keystone Crossing, Suite 1100
 Indianapolis, IN 46240
Felecia.Beamen@va.gov

RFI NO.: #E5	DATE:	SPEC/DWG. REFERENCE(s): ED-101 – Coded Note #25
REPLY NEEDED BY: 1-2-2018		

INFORMATION NEEDED:


Can VA provide information as to which building the tamper switches are wired to?

REPLY:

RFI's will be answered by amendment(s) posted to fbo.gov.

See attached.

REPLY FROM: VA Marion Station	DATE: 12-21-17
ATTACHMENTS: 1	COPY TO:

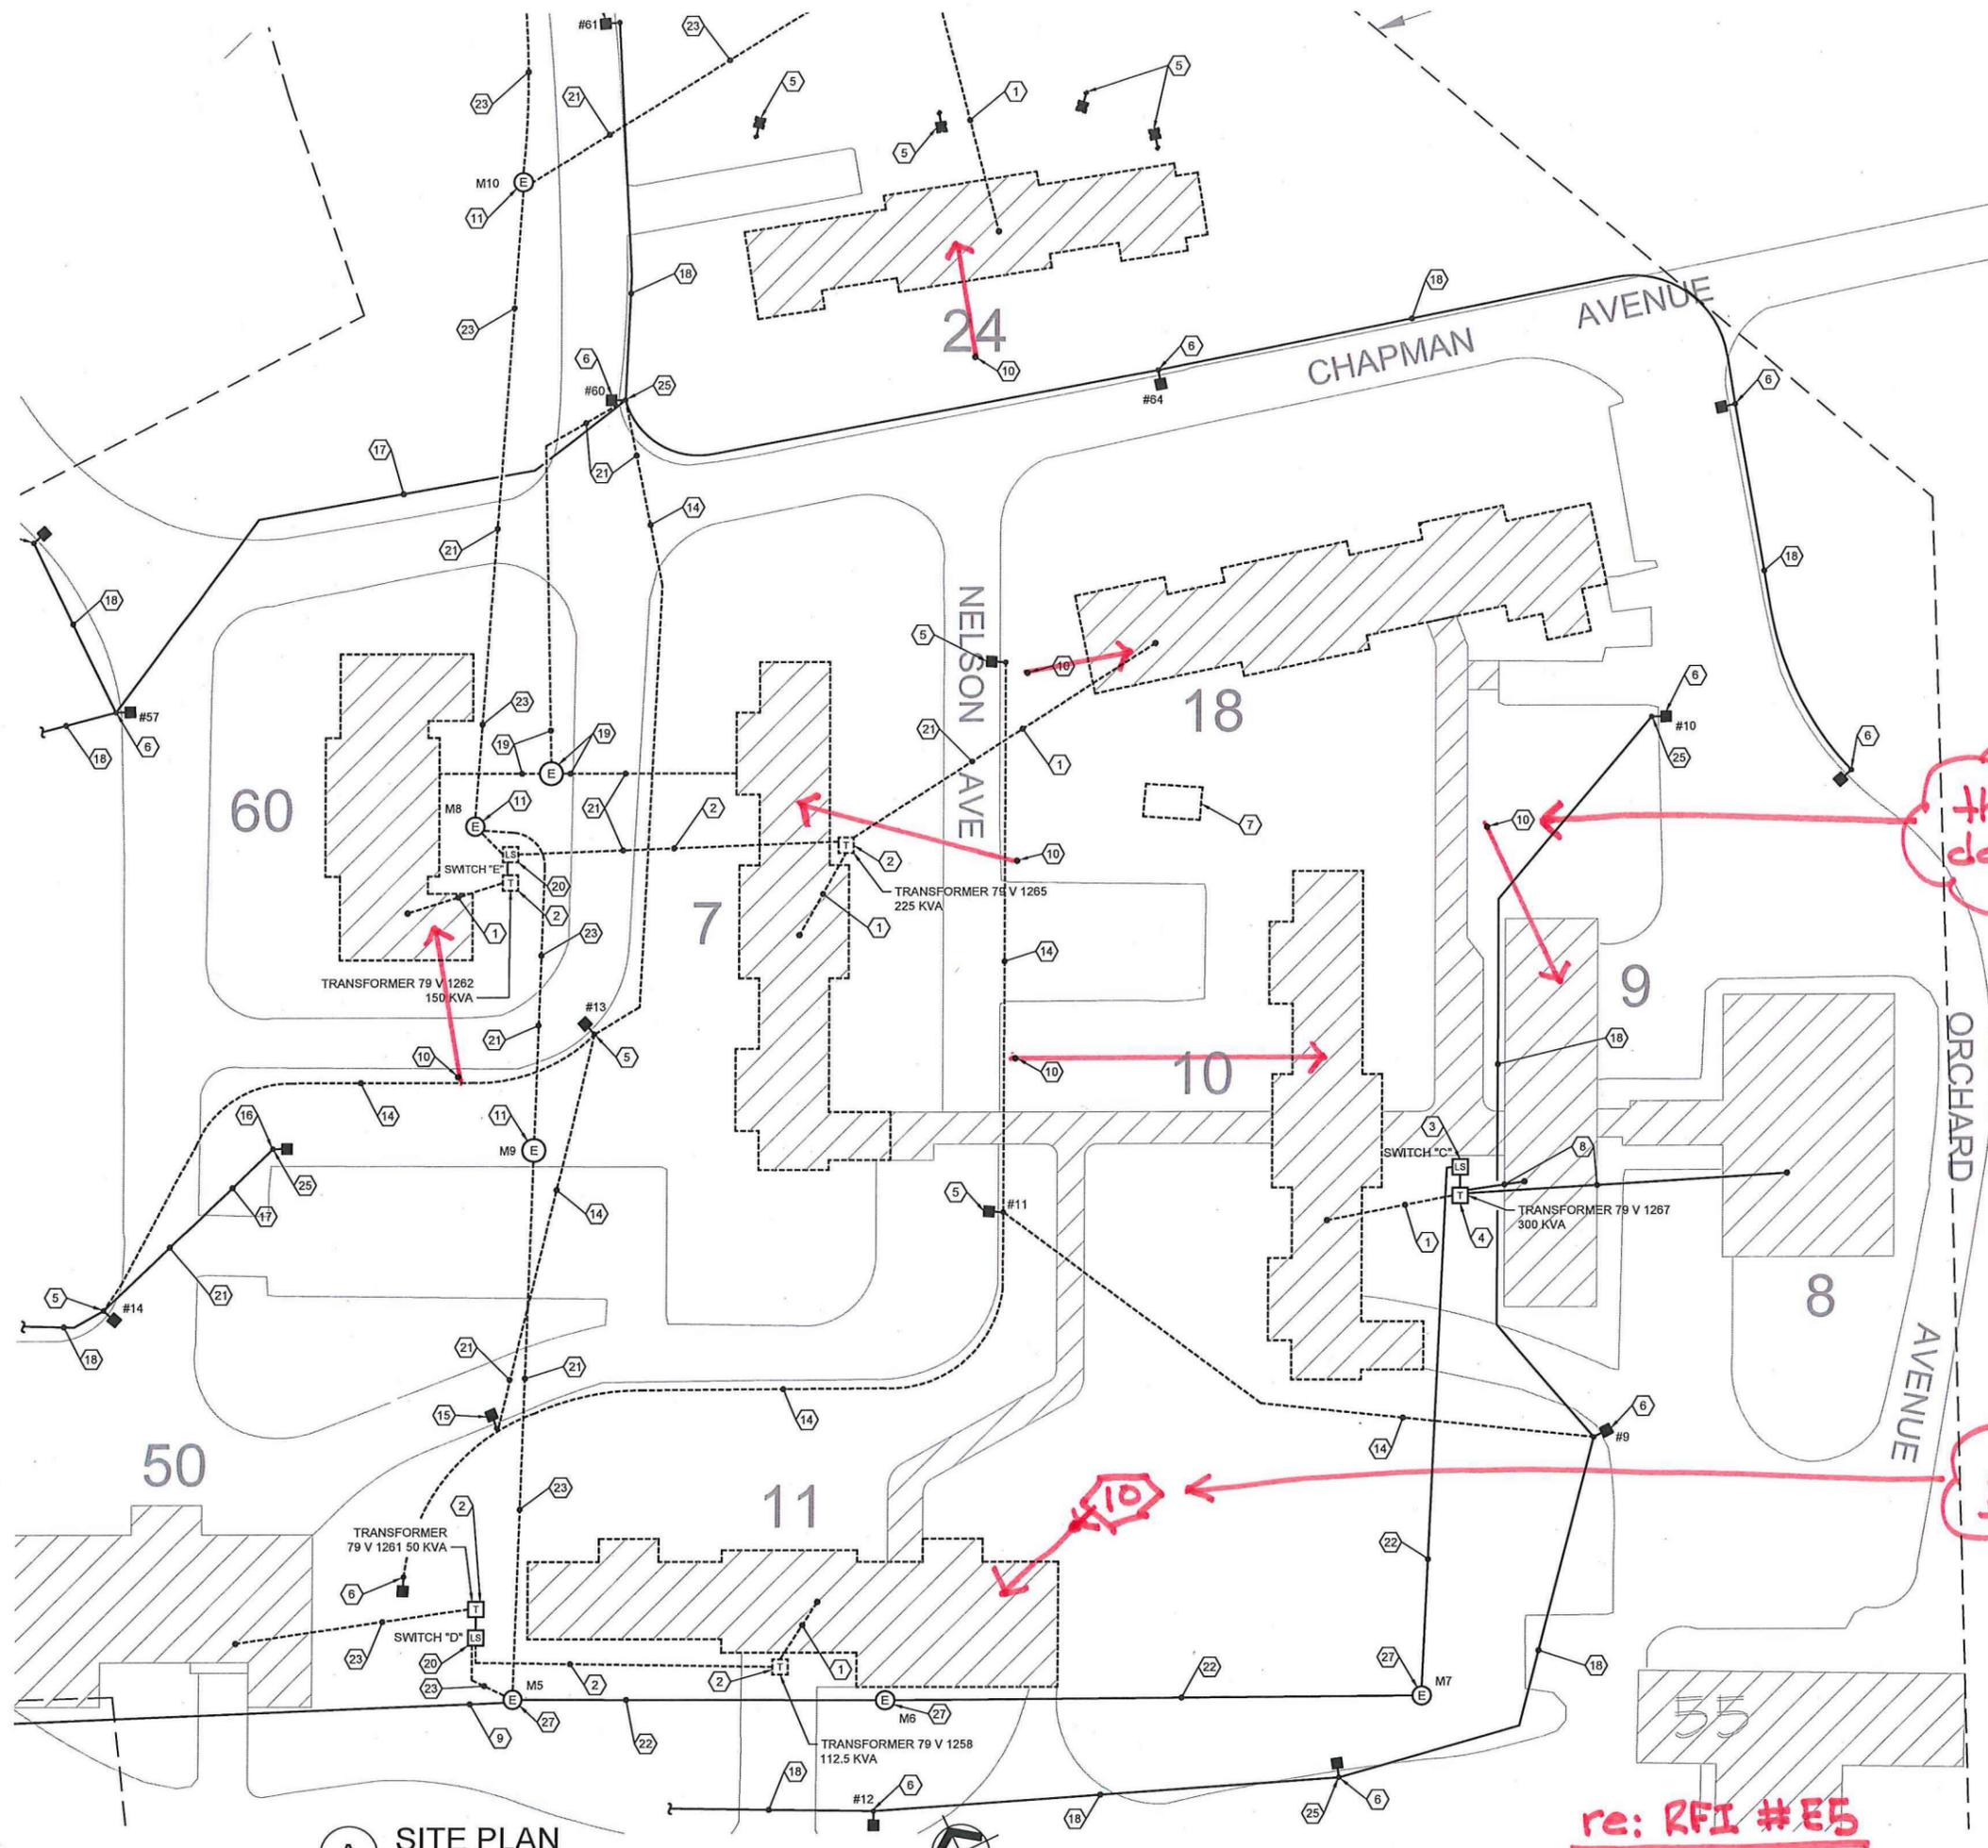

this PIV to remain.
do not remove

add removal of
this PIV

re: RFI # E5

610-15-100
ED-101
12-21-17 Elkins

^ SITE PLAN