

A

B

C

D

E

F

A








B

C


D

E

F

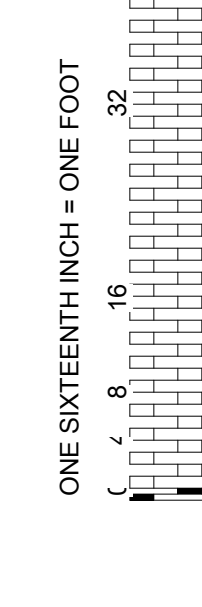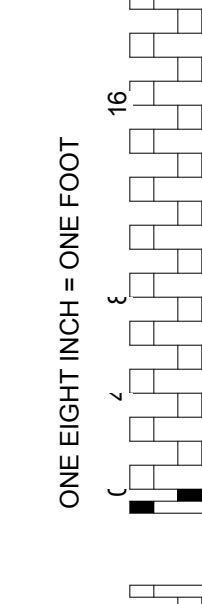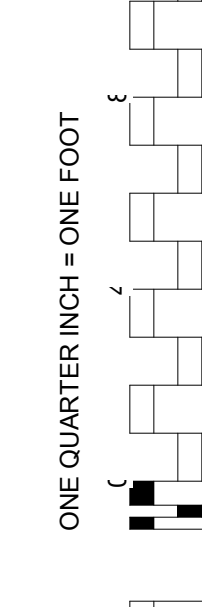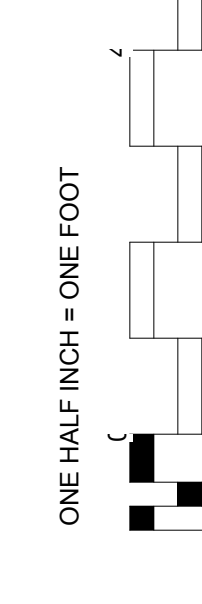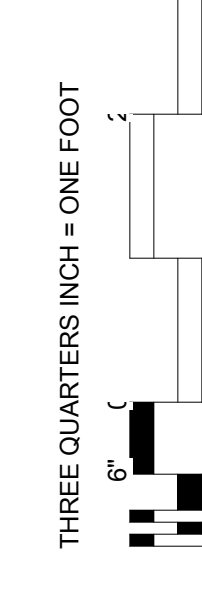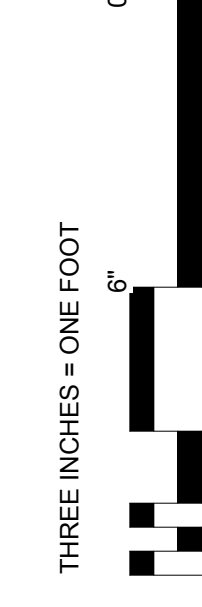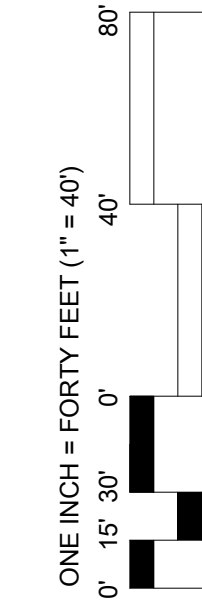

1 RM.4N107 RCP REVISION - CEILING ACCESS PLAN  
SCALE: 1/8" = 1'-0"

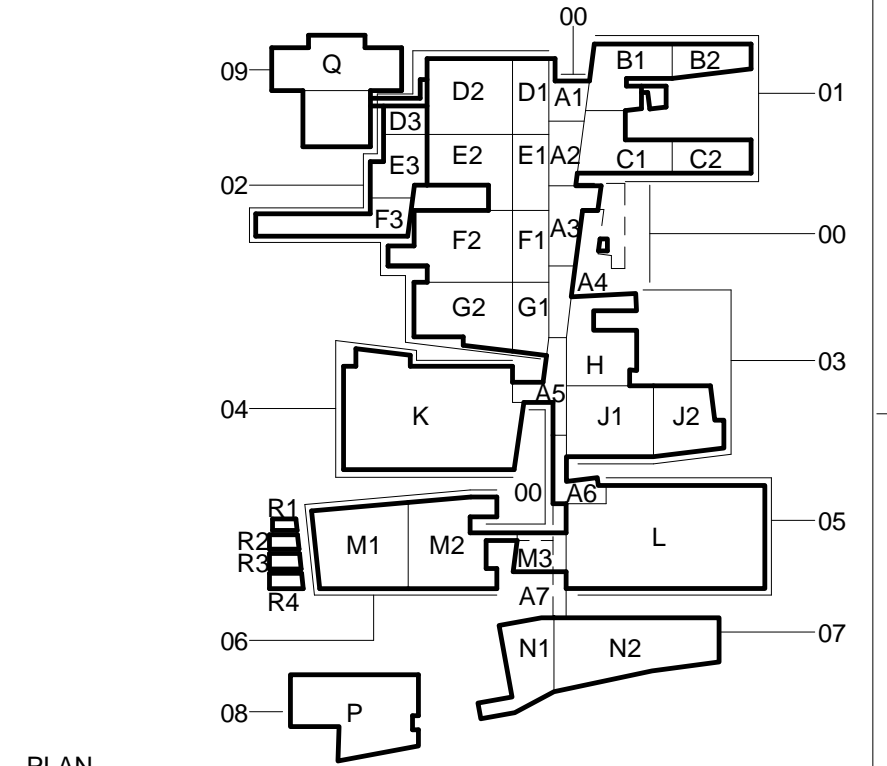

<b>CONSULTANTS:</b>		<b>ARCHITECT/ENGINEERS:</b>		<b>DRAWING TITLE</b> CEP ROOM 4N107 CEILING PROJECT - CEILING ACCESS OPENING		<b>PROJECT TITLE</b> SLVHCS REPLACEMENT MEDICAL CENTER PROJECT		<b>PROJECT NUMBER</b> 629-18-XXXX		<b>BUILDING NUMBER</b>		<b>OFFICE OF CONSTRUCTION AND FACILITIES MANAGEMENT</b> 	
				APPROVED: PROJECT DIRECTOR		LOCATION NEW ORLEANS, LOUISIANA		DOCUMENT SET PACKAGE		DRAWING NUMBER <b>7A104-N1-005</b>			
<b>REVISIONS:</b>						DATE 10/03/17		CHECKED FEMI		DRAWN FEMI			
DATE													