


PROPERTY LINE

W. HOSPITAL ROAD

FREEDOM ROAD

TRUNCATED DOME LOCATION

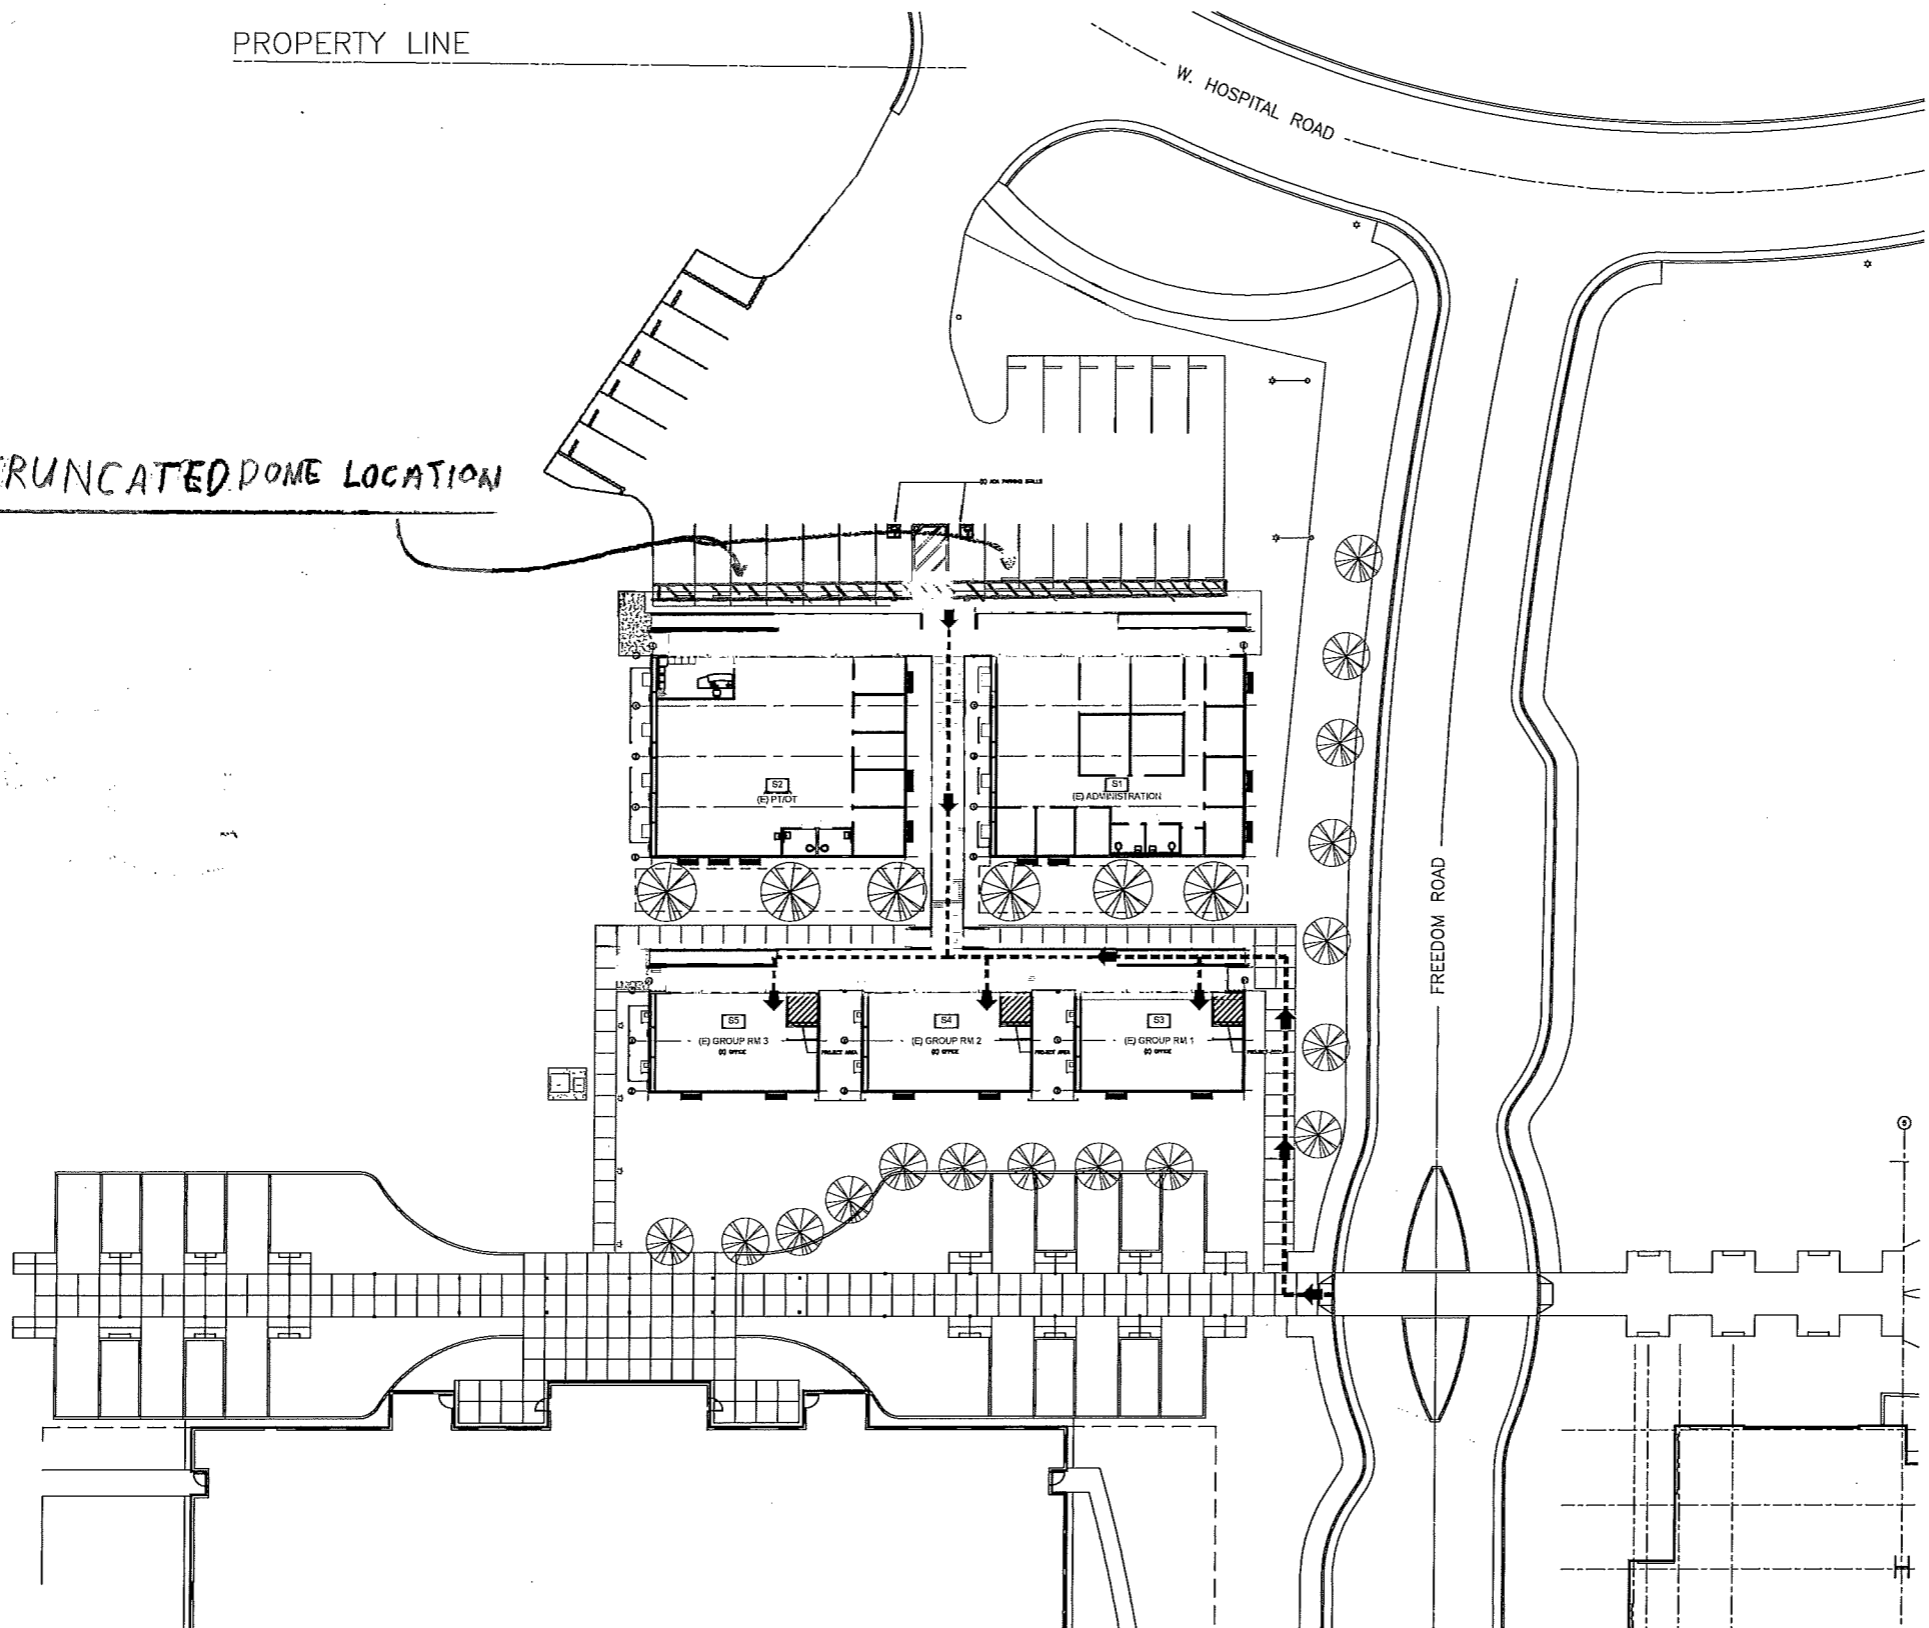

**STOCKTON CBOC SITE PLAN**  
 SCALE: 1/16" = 1'-0"

**LEGEND:**  
 PROJECT AREA  
 PATH OF TRAVEL


<b>Revisions:</b> 1 2 
--