
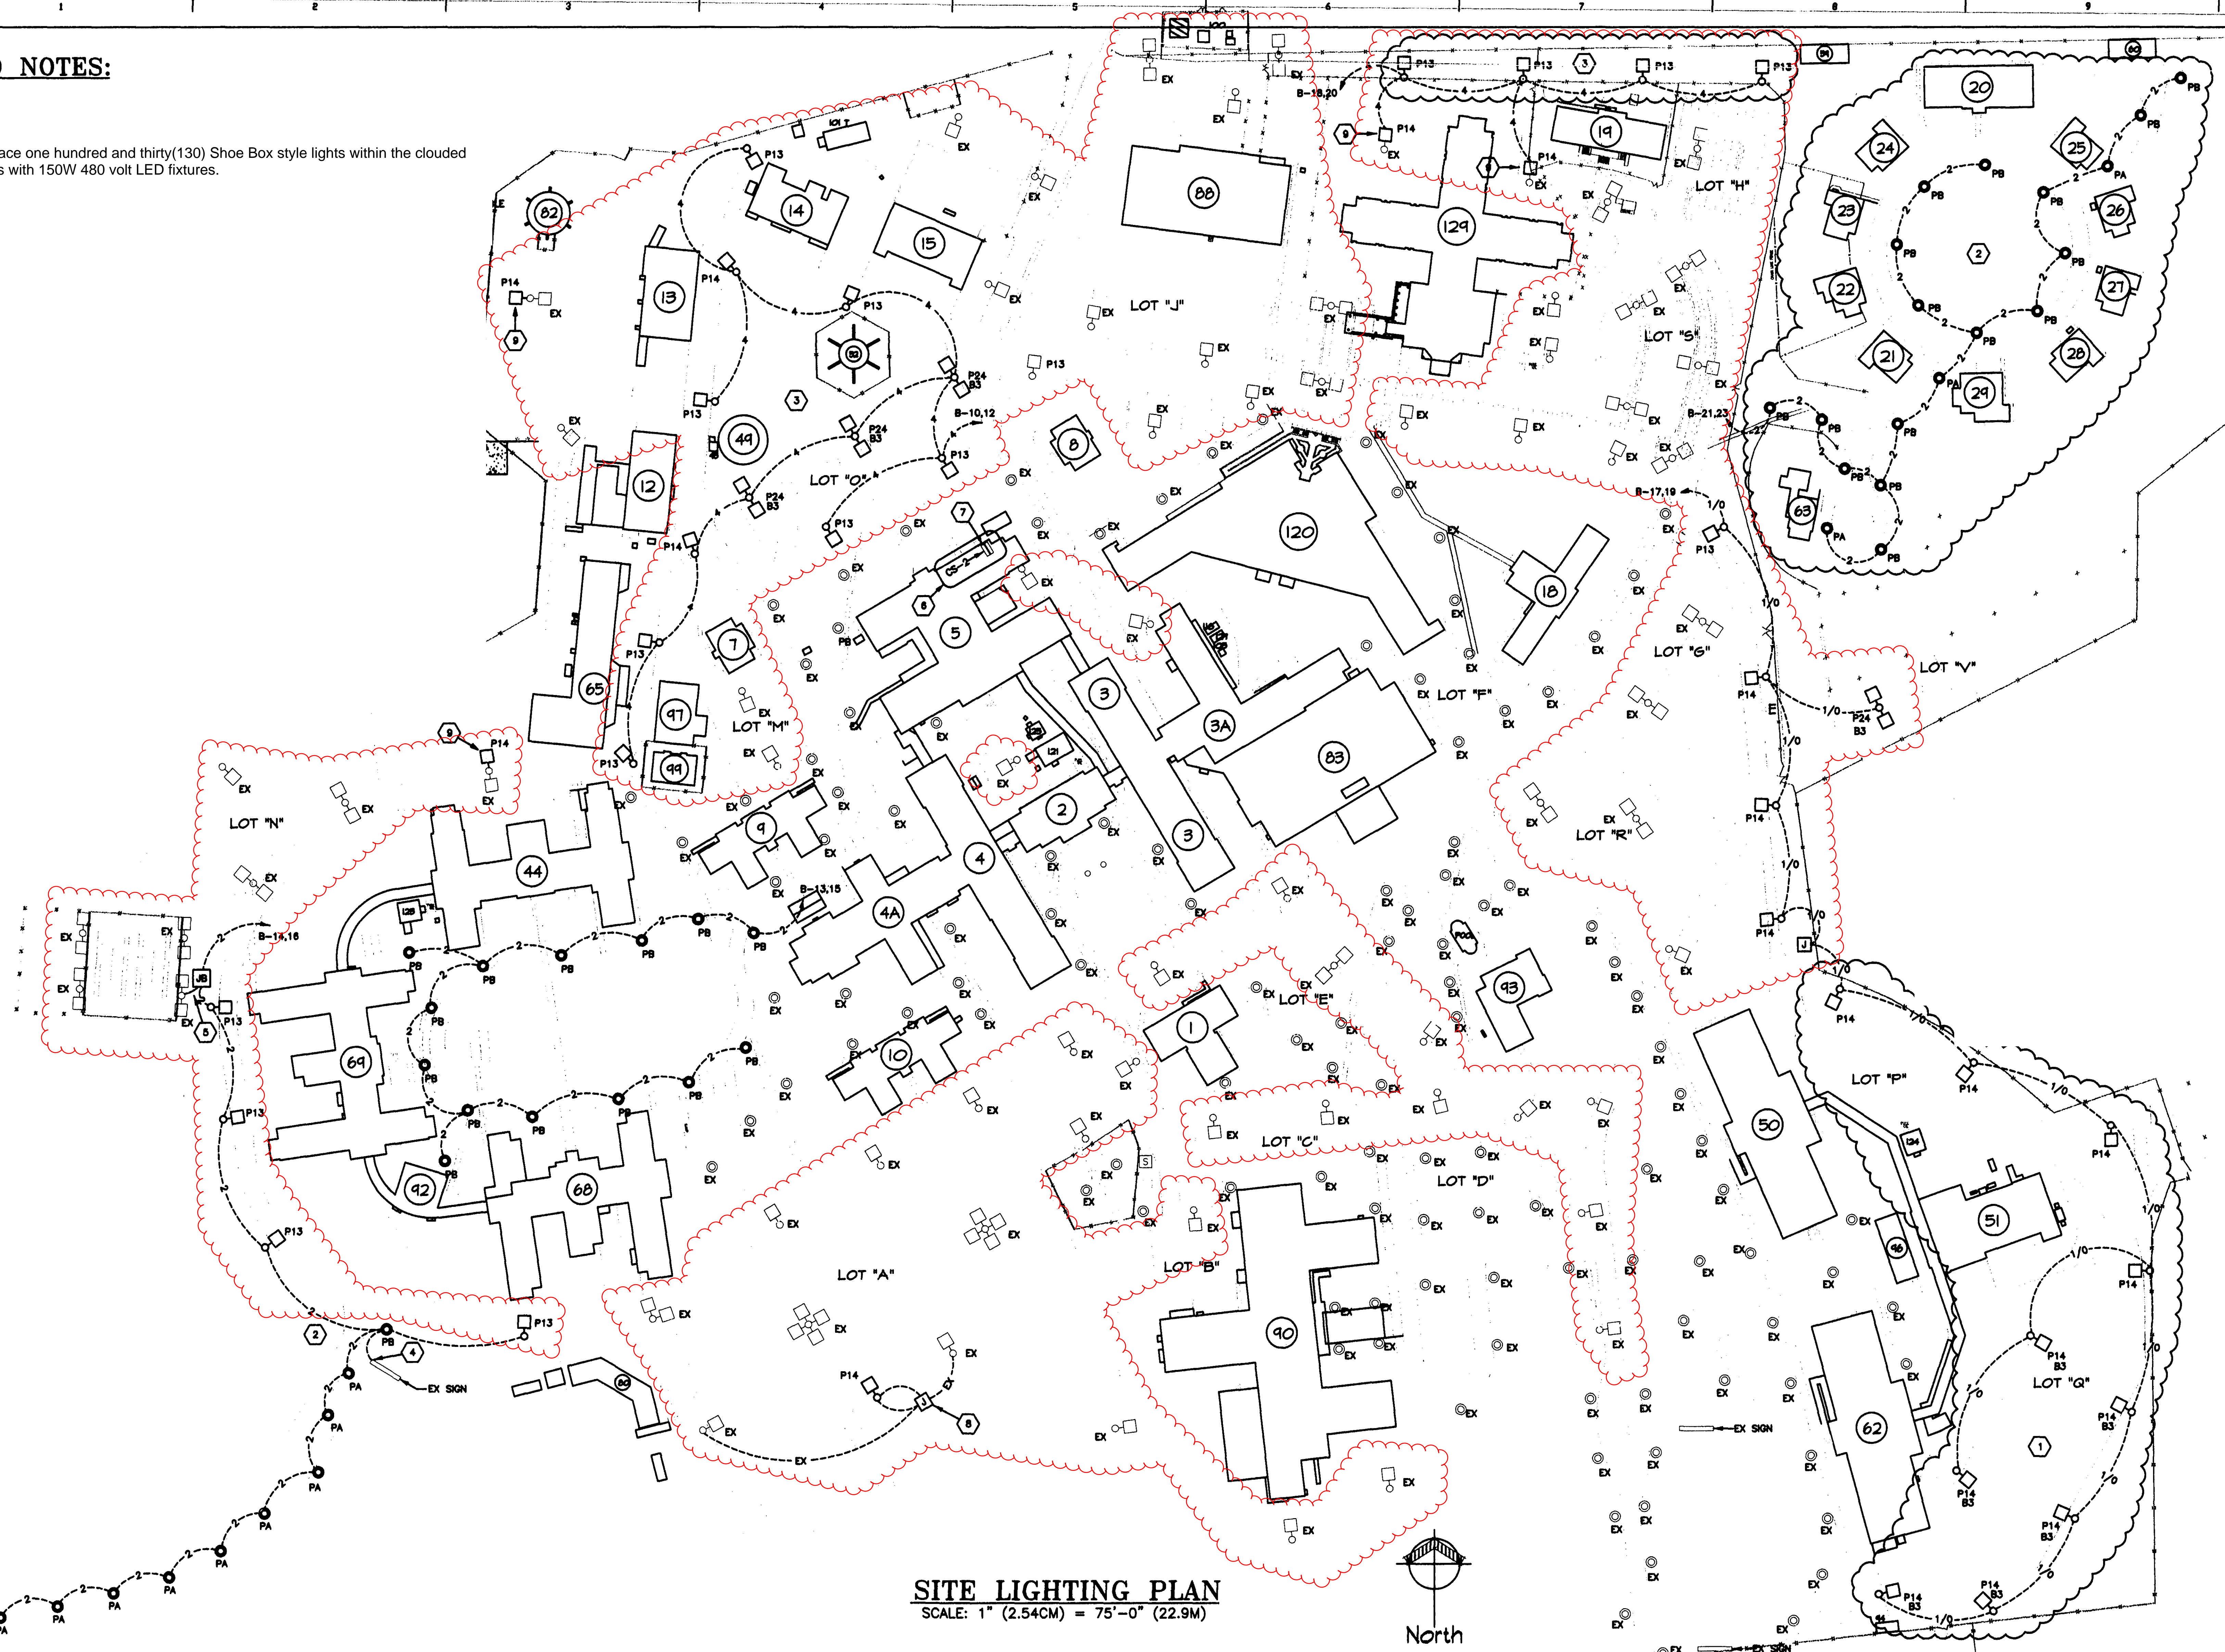
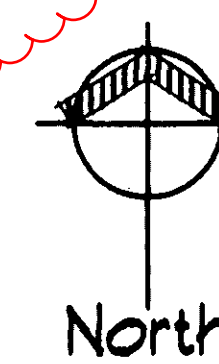


[illegible]

 Replace one hundred and thirty(130) Shoe Box style lights within the clouded areas with 150W 480 volt LED fixtures.



SITE LIGHTING PLAN
SCALE: 1" (2.54CM) = 75'-0" (22.9M)



<div style="display: flex; justify-content: space-between;"> <div style="width: 40%;"> <p>1</p> <p>2</p> <p>3</p> </div> <div style="width: 40%;"> <p>4</p> <p>5</p> <p>6</p> </div> <div style="width: 20%;
