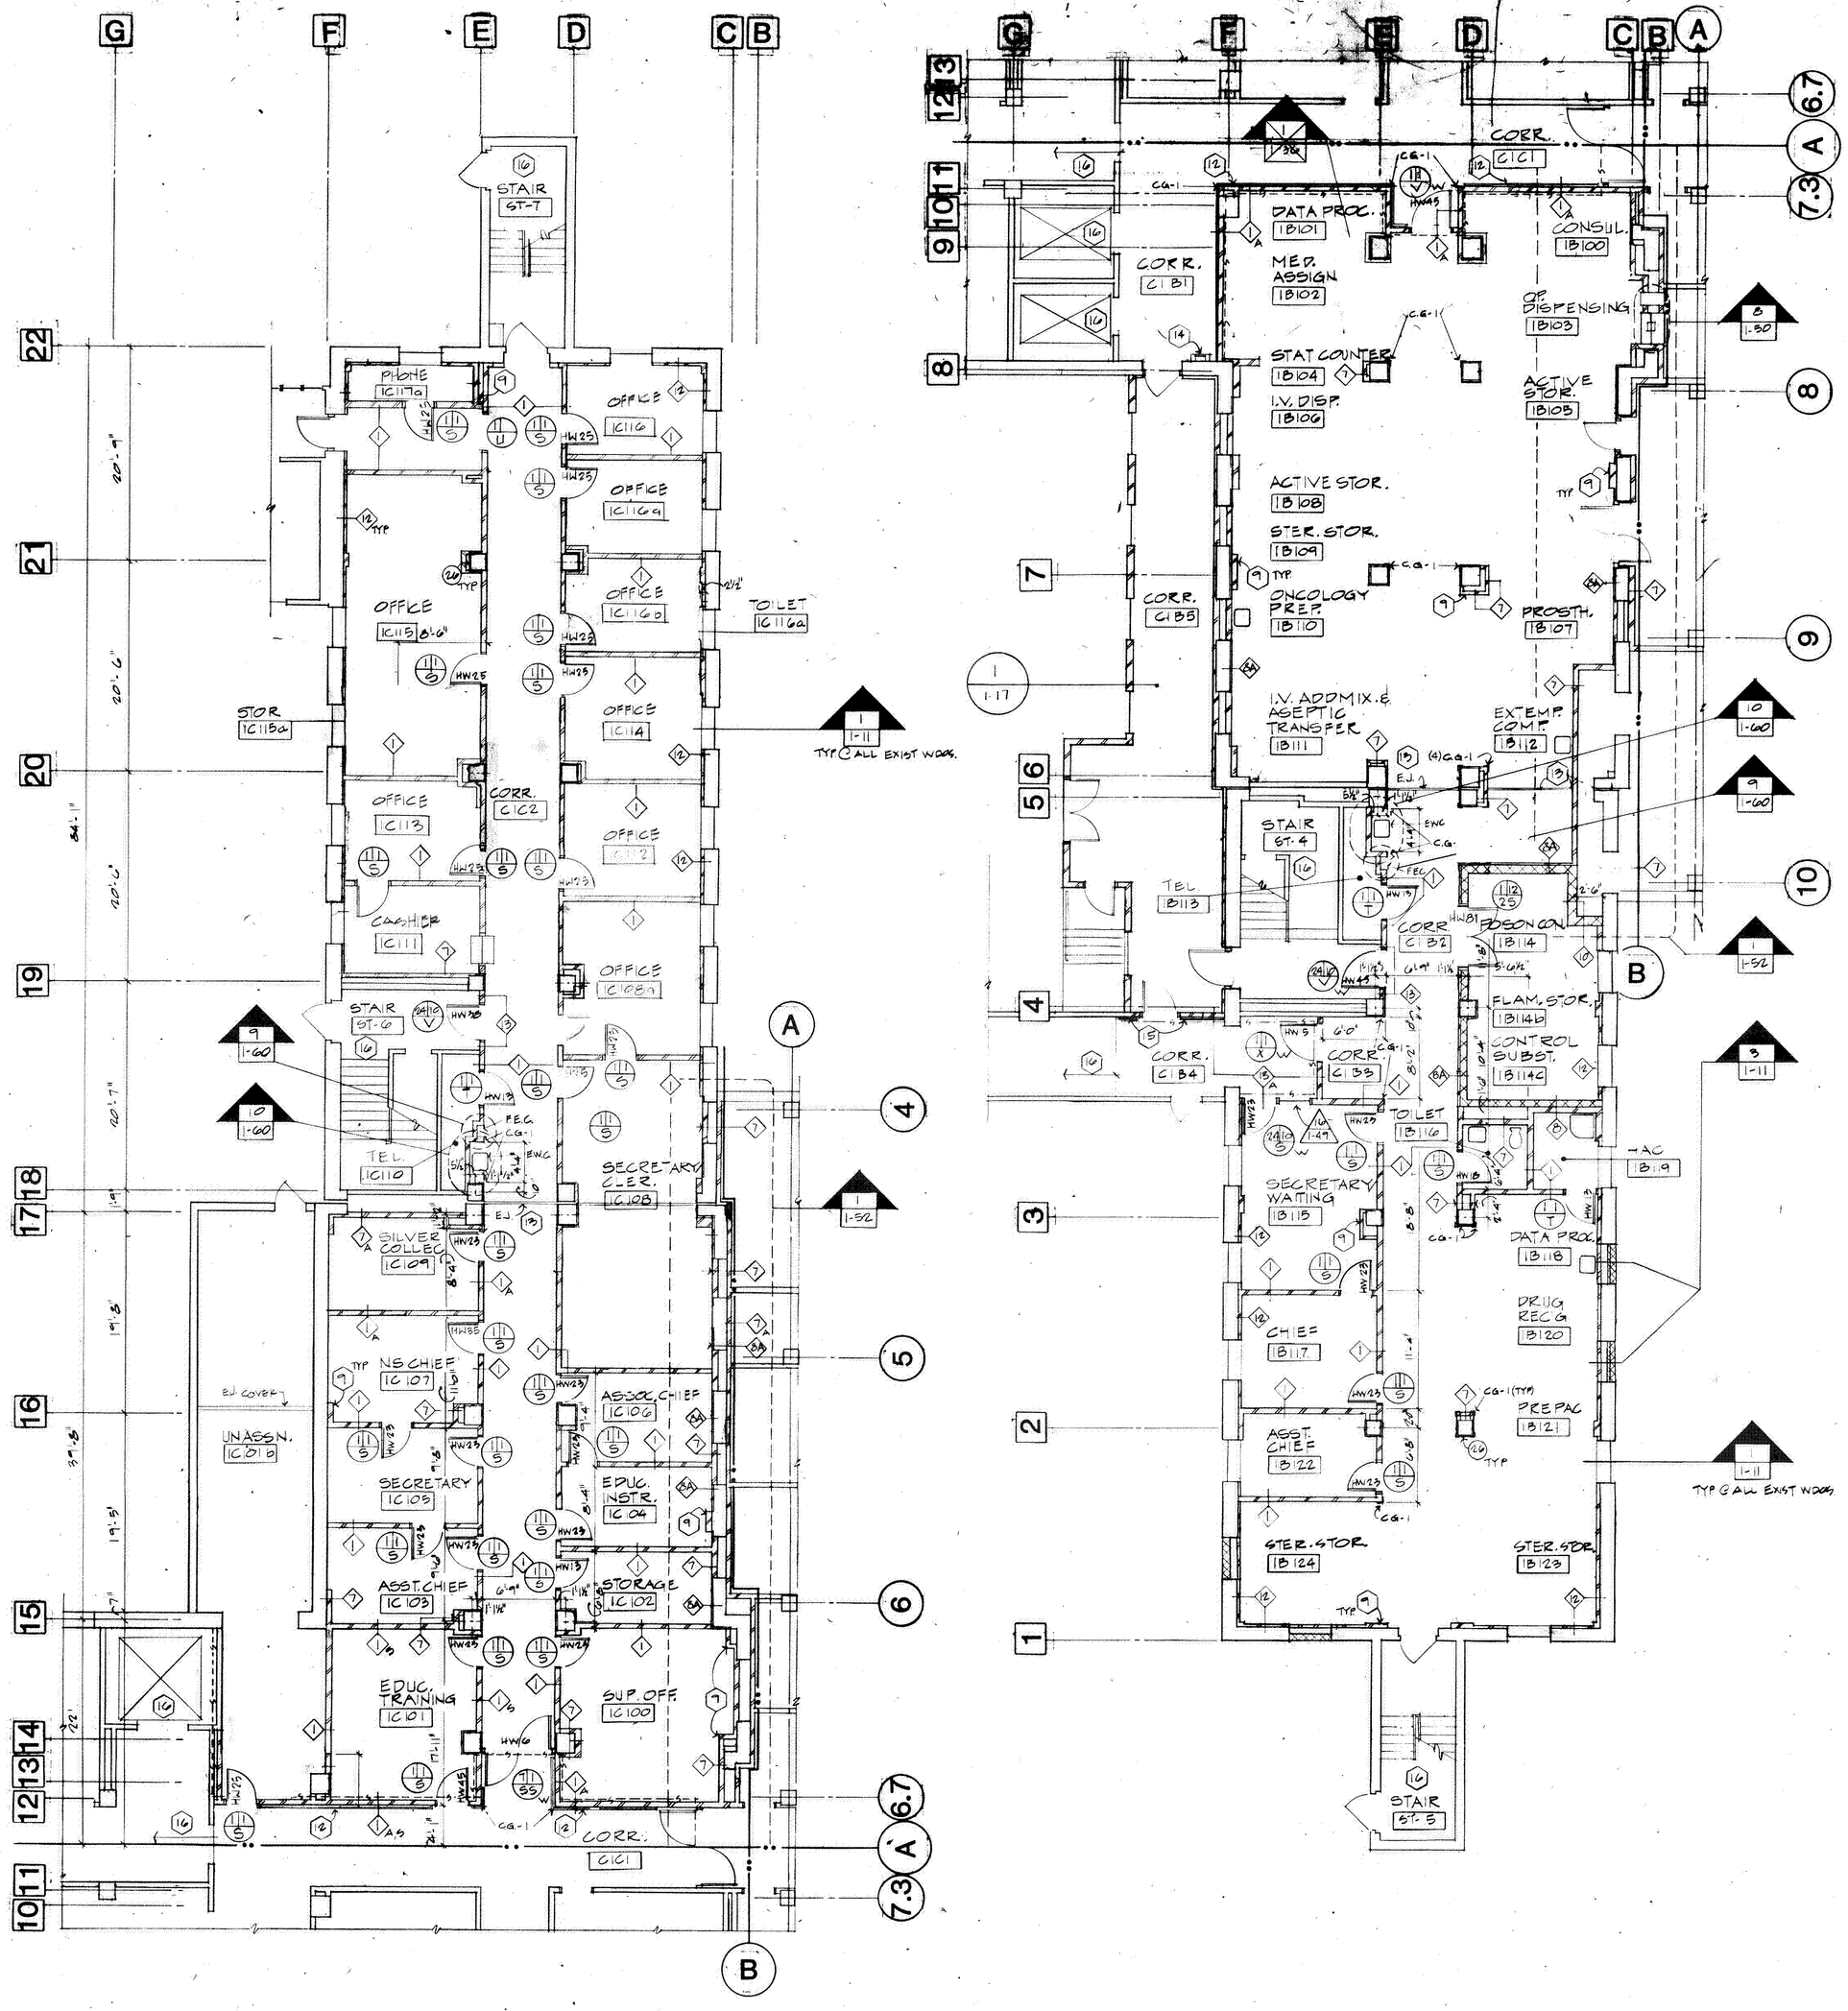

EXIST. WINDOW DETAIL

1/1-11 SCALE 3/4"=1'-0"

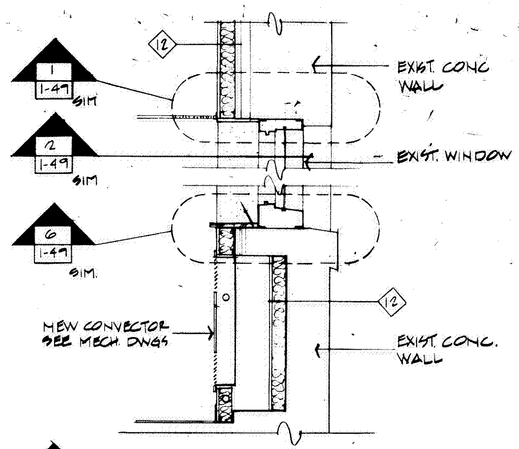

HEAD & JAMB DETAIL

2/1-11 SCALE 3"=1'-0"

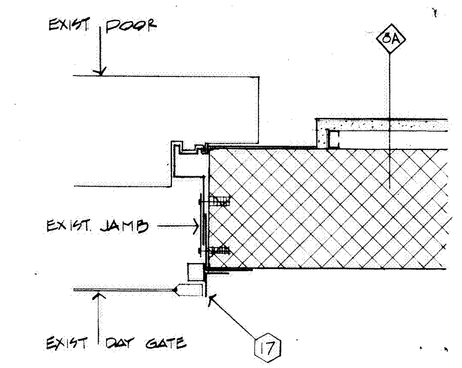

WINDOW CLOSURE DETAIL

3/1-11 SCALE 1"=1'-0"

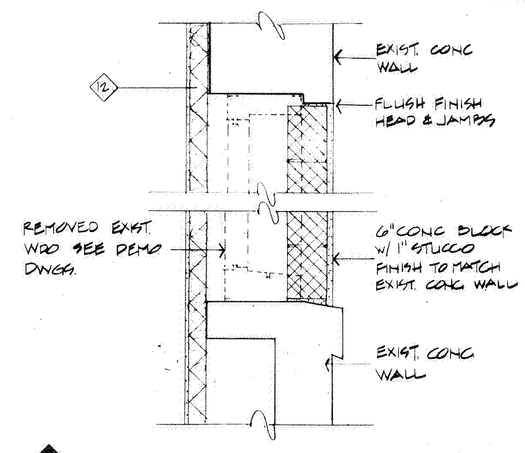

FLOOR PLAN NOTES

1. FOR STANDARD ARCHITECTURAL SYMBOLS, ABBREVIATIONS AND MATERIAL INDICATIONS, REFER TO SHEET 1-X3.
2. FOR LARGE SCALE DUMBWAITER PLANS, SECTIONS AND DETAILS, REFER TO SHEET 1-36.
3. FOR DOOR AND FRAME TYPES AND SIZES, REFER TO SHEET 1-47.
4. FOR INTERIOR WALL TYPES, REFER TO SHEET 1-30.
5. FOR INTERIOR COLUMN PLAN DETAILS, REFER TO SHEET 1-54 AND 1-55.
6. FOR 1/4" PLAN ENLARGEMENTS SHOWING EQUIPMENT, CASEWORK, TOILET ROOM LAYOUTS AND RELATED SCHEDULES AND REFERENCING, REFER TO ARCHITECTURAL DRAWINGS 1-Q-1 THROUGH 1-Q-9.
7. CONTRACTOR TO FIELD VERIFY LOCATION OF EXISTING CORRIDORS WHERE NEW CORRIDORS TIE TO EXISTING CORRIDORS.
8. INTERIOR DIMENSIONS ARE TAKEN TO FACE OF METAL STUD TYPICALLY AT NEW CONSTRUCTION UNLESS NOTED OTHERWISE.
9. CHASE, FURR OUT AS REQUIRED BY MECHANICAL AND ELECTRICAL DRAWINGS.
10. NEW LOCATION OF EXISTING EQUIPMENT REMOVED DURING DEMOLITION. RECONDITION EQUIPMENT AS REQUIRED AND MAKE ALL NECESSARY ADJUSTMENTS FOR INSTALLATION AT NEW LOCATION.
11. C.C. EQUIPMENT, SEE EQUIPMENT DRAWINGS.
12. HANDRAIL, SEE DETAIL 12, SHEET 1-59.
13. EXPANSION JOINT, SEE DETAILS 3, 4 & 5, SHEET 1-53.
14. EXISTING U.S. MAIL CHUTE, PROTECT FROM DAMAGE DURING CONSTRUCTION.
15. REPLACE EXISTING HANDRAIL TO ACCOMMODATE NEW WORK.
16. EXISTING, PROTECT FROM DAMAGE DURING CONSTRUCTION.
17. EXISTING VAULT DOOR REMOVED DURING DEMOLITION. RECONDITION AND MAKE ALL NECESSARY ADJUSTMENTS FOR INSTALLATION AT NEW LOCATION. SEE DETAIL 2, SHEET 1-11.
18. FILL SLOPE AND PENETRATIONS IN EXISTING FLOOR. SLOPE FLOOR TO NEW FLOOR DRAINS TO ACCOMMODATE NEW FLOOR FINISH AND DOOR SWINGS. PROVIDE WATERPROOF MEMBRANE BELOW NEW FLOOR FINISH THROUGHOUT ENTIRE ROOM AND UP PERIMETER WALLS 4".

FIRST FLOOR FINISH ELEVATION : 4618.73'

WALL SYMBOL LEGEND

- 1HR. WALL
- 2HR. WALL
- 1HR. SMOKE WALL
- LEAD LINED WALL

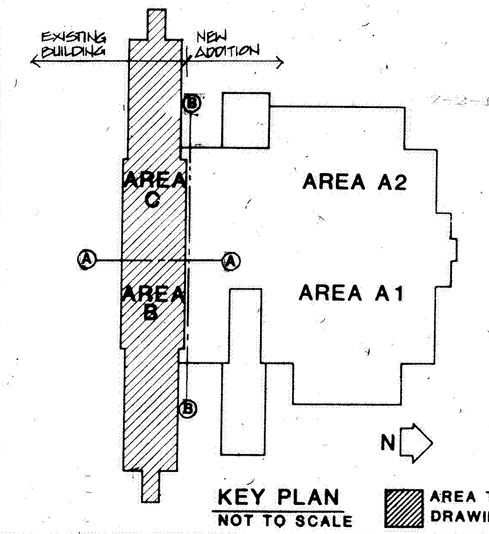

KEY PLAN NOT TO SCALE — AREA THIS DRAWING

FIRE SPRINKLER NOTE

THIS FLOOR HAS A FIRE SPRINKLER SYSTEM INSTALLED UNDER SEPARATE CONTRACT.

RECORD DRAWINGS:

These record drawings (as-built drawings, or corrected specifications) have been prepared based on information submitted, in part, by others. While this information is believed to be reliable, the architect is not responsible for its accuracy, nor for errors or omissions which may have been incorporated into this document as a result.

Revisions	Date

STATE OF COLORADO 5629 GERRY ALLEN DILLON & KENNETH HUNT 8-11-86

A Joint Venture
MCB Architects
1780 S. Bellaire St., Ste. 800/Denver, CO. 80222/Ph. 303-758-7858
DILLON-HUNT P.C. / ARCHITECTURE AND PROJECT MANAGEMENT

Drawing Title: FIRST FLOOR PLAN AREAS B & C 1/8":1'-0"

Approved: Project Director:

Project Title: OUTPATIENT/CLINICAL ADDITION

Date: JULY 16,1986

Project No.: 575-025

Building Number: 1 | Checked | Drawn

Location: VAMC-GRAND JUNCTION, COLORADO

DRAWING NO.: 1-11 Dwg. Of

Veterans Administration

VA FORM 08-6231, FEB. 1983

© U.S. GOVERNMENT PRINTING OFFICE: 1983-400-295