



1 PARTIAL BASEMENT DEMOLITION PLAN- RM CB-93C  
1-A1 SCALE: 1/4" = 1'-0"

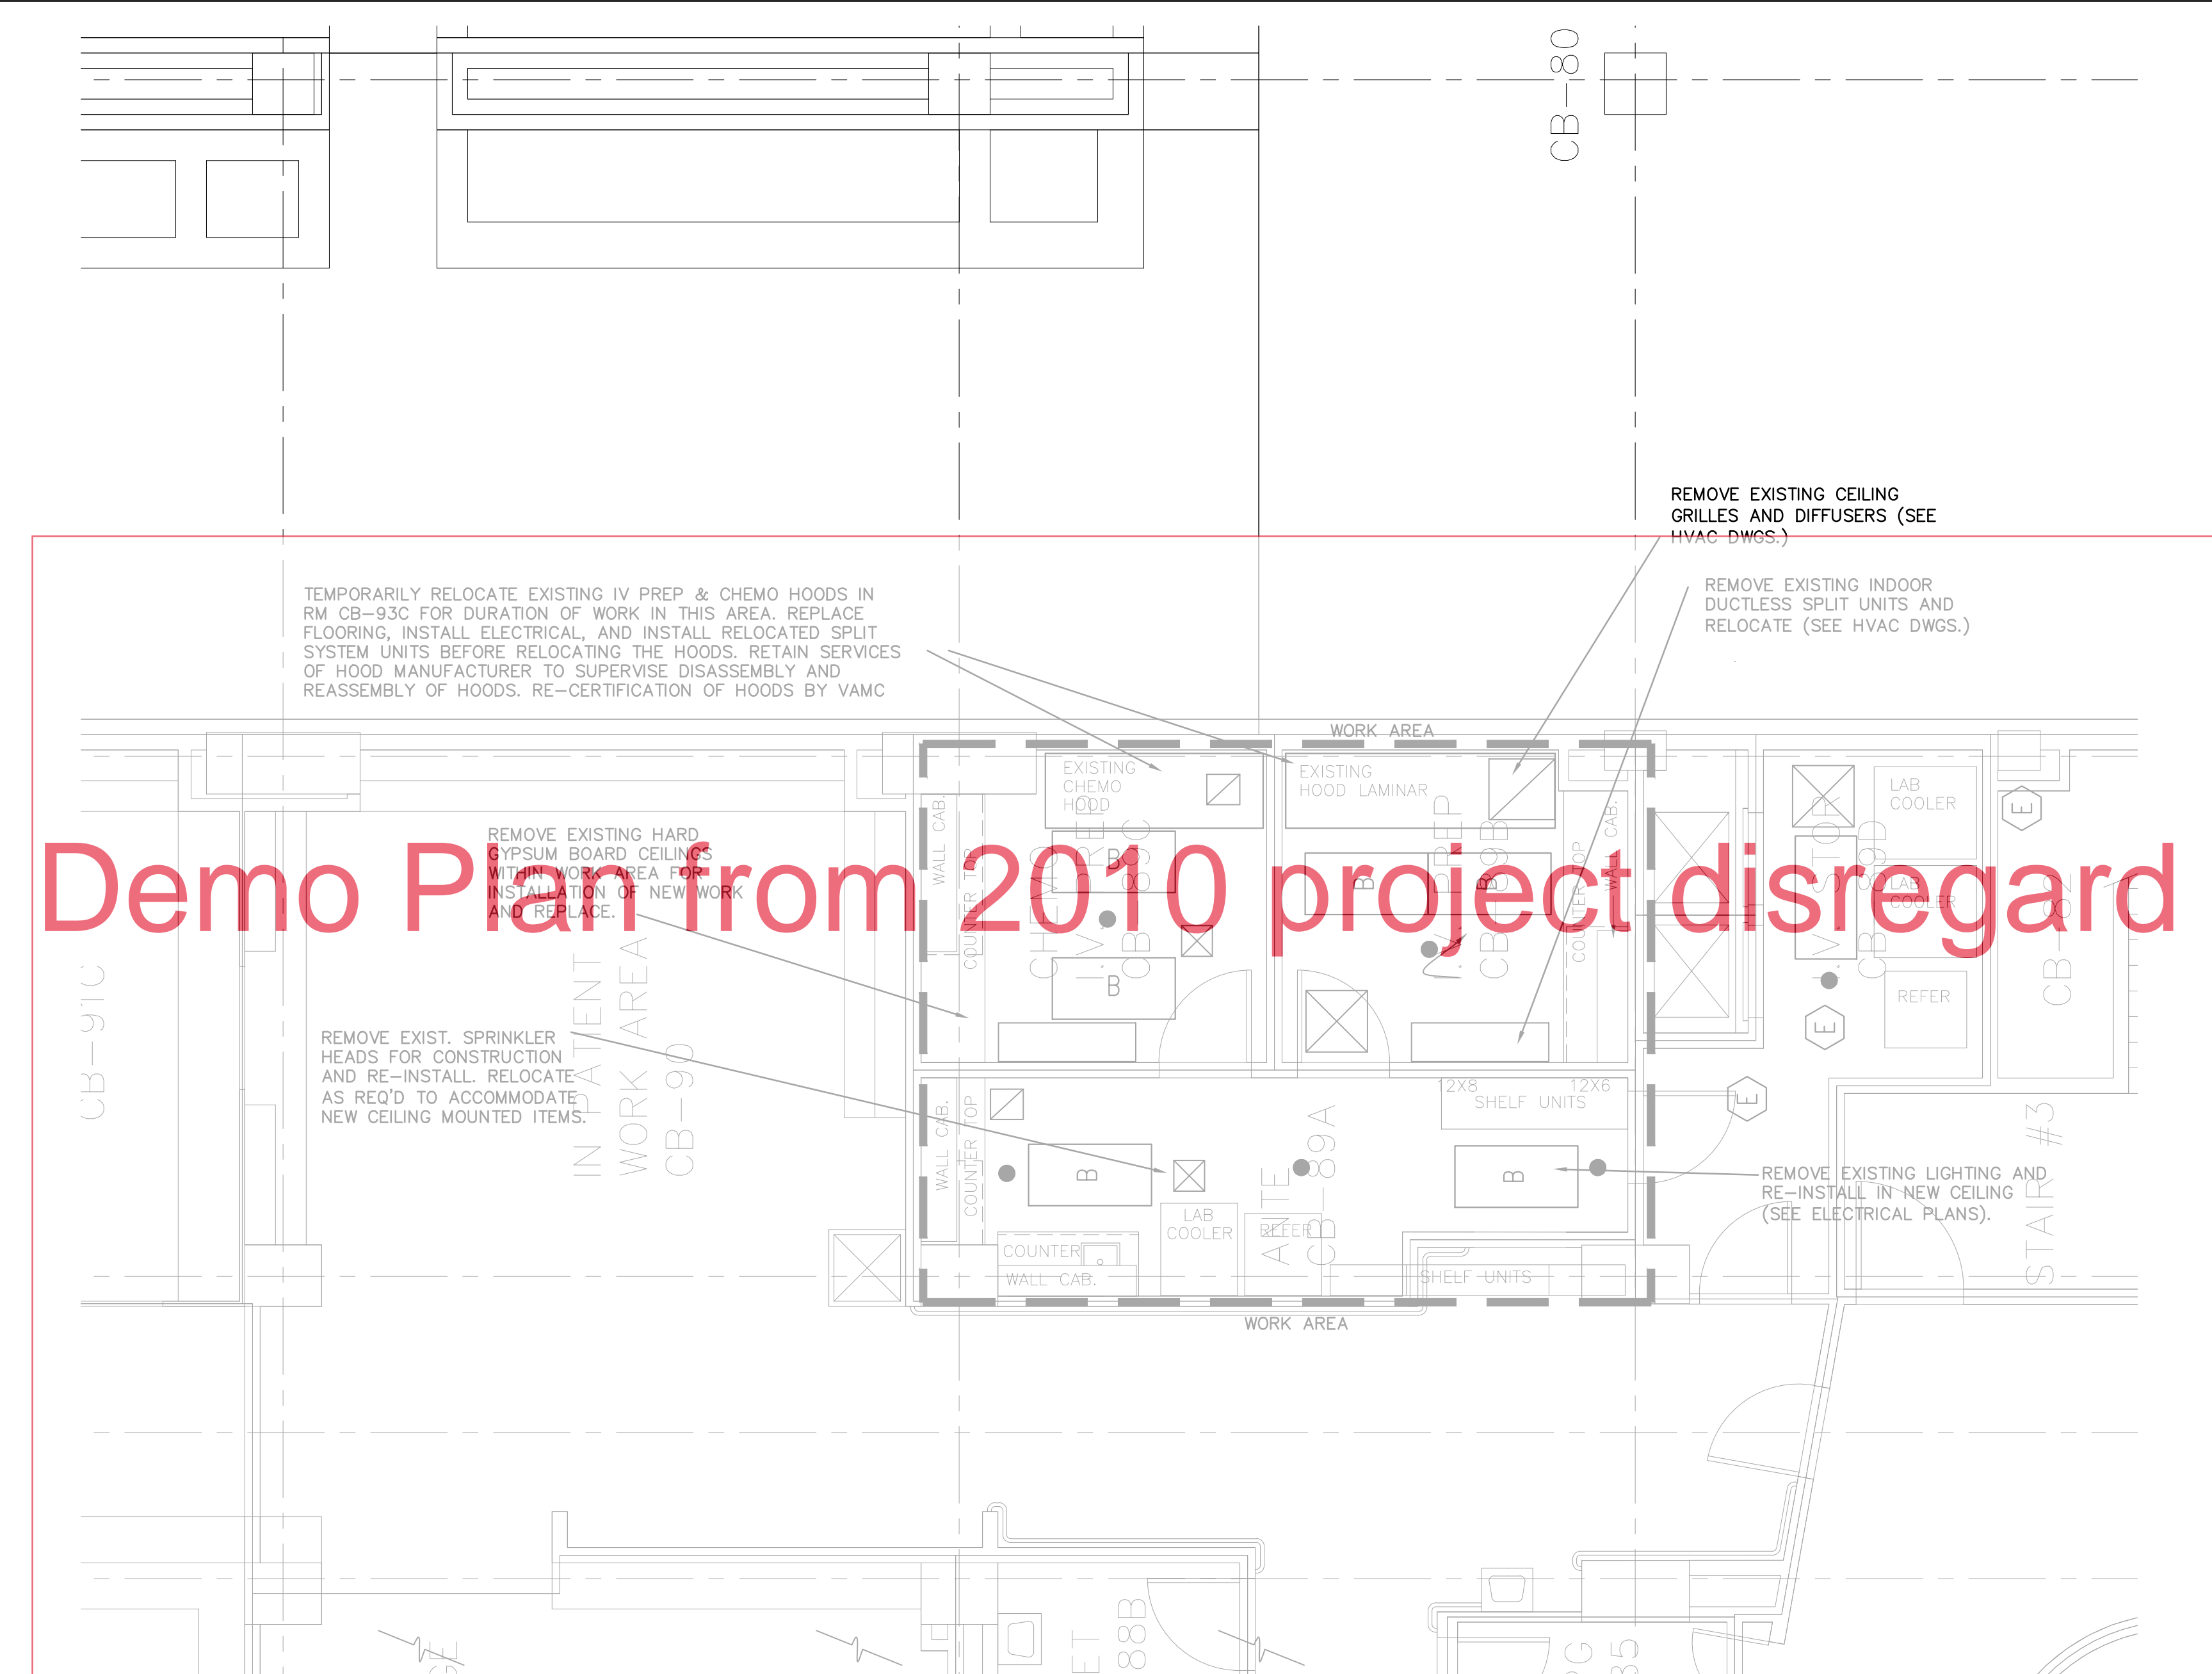


2 PARTIAL BASEMENT NEW WORK PLAN-RM CB-93C  
1-A1 SCALE: 1/4" = 1'-0"




3 PARTIAL PHARMACY DEMOLITION PLAN  
1-A1 SCALE: 1/4" = 1'-0"

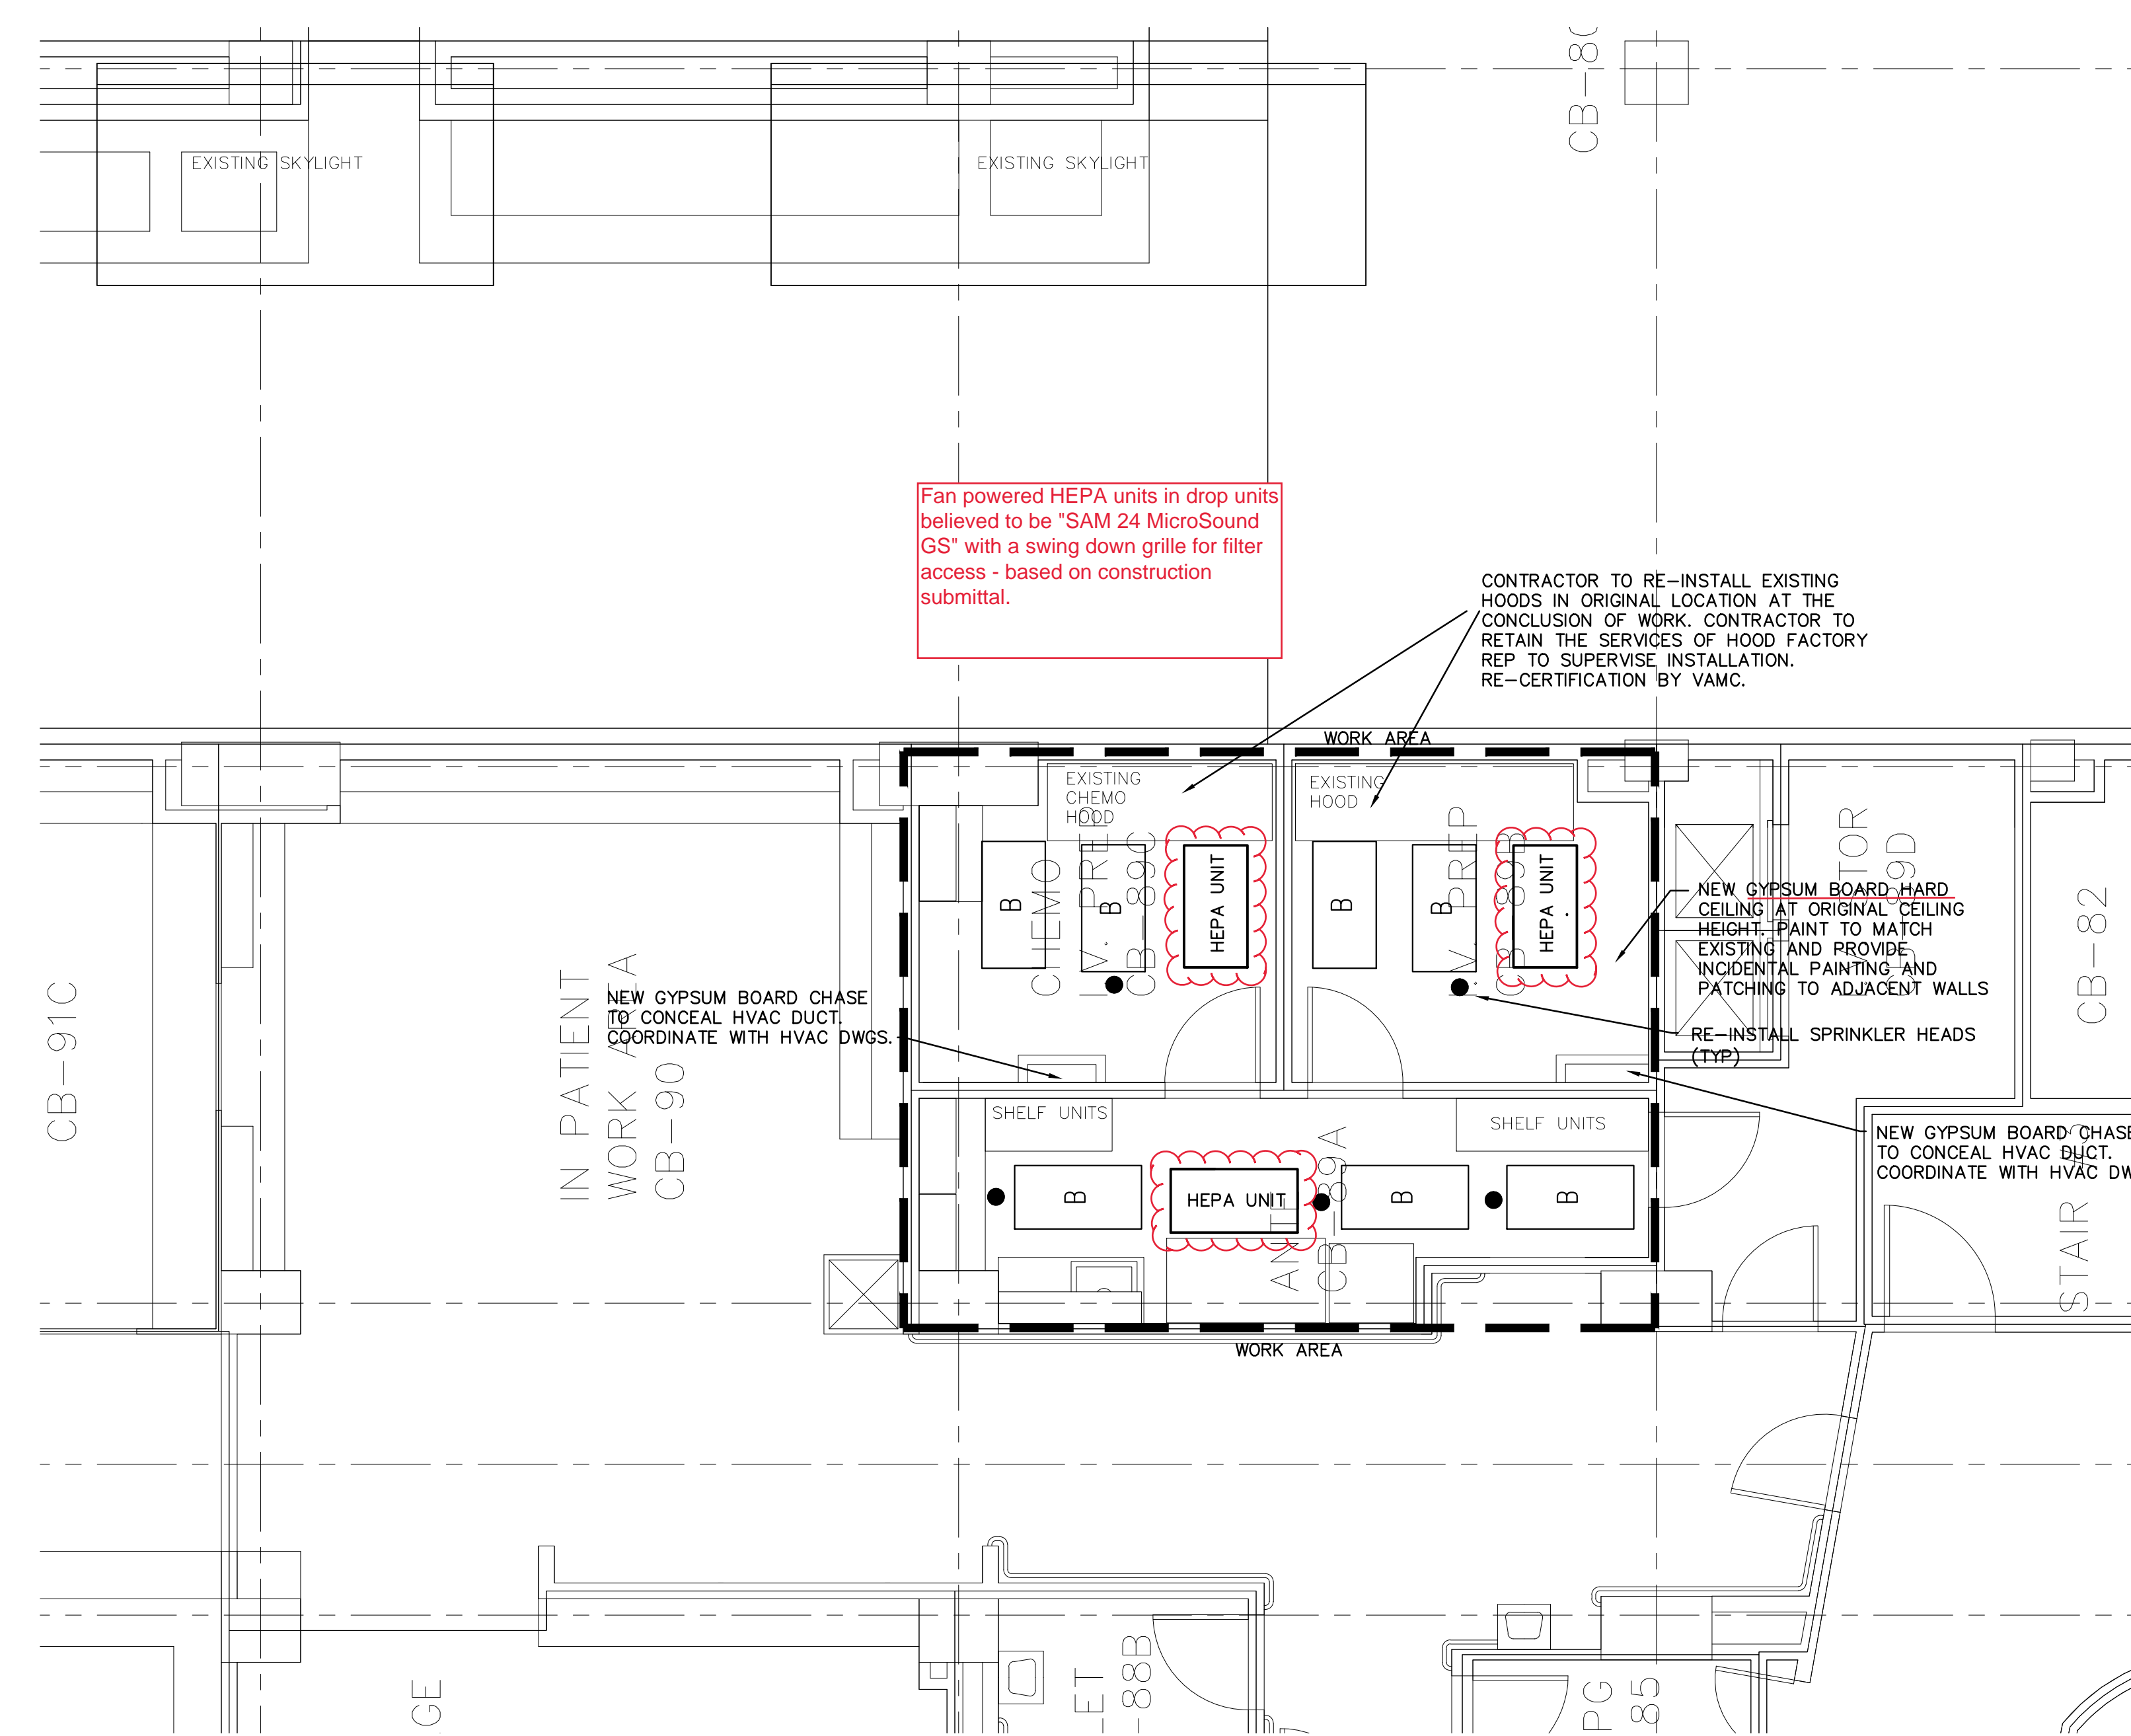

4 PARTIAL PHARMACY NEW WORK PLAN  
1-A1 SCALE: 1/4" = 1'-0"

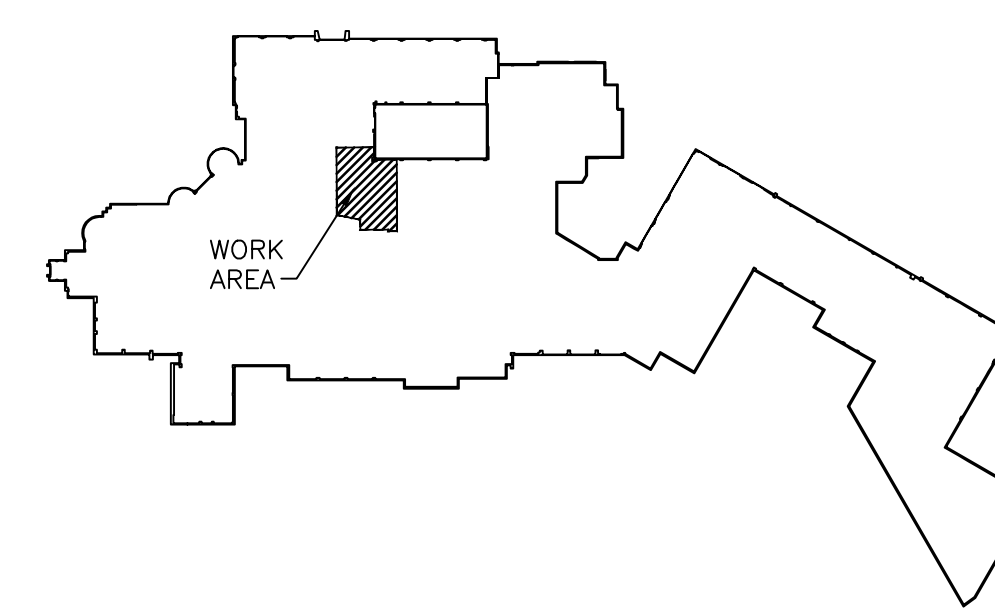

Basement Floor Key Plan 

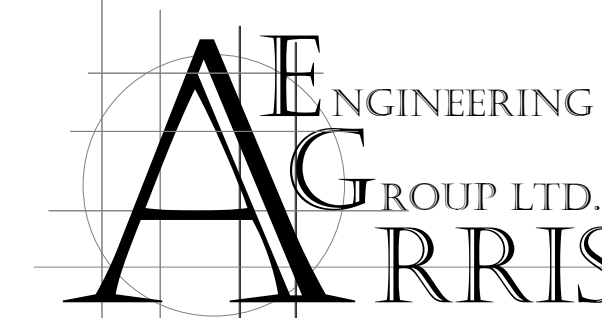[illegible]

67 PUBLIC SQUARE  
SUITE 722  
WILKES-BARRE, PA 18701  
PHONE: 570/825-7760  
FAX: 570/825-9001  
WEB SITE: [WWW.ARRISENG.COM](http://WWW.ARRISENG.COM)

Drawing Title	PHARMACY DEMOLITION AND NEW WORK PLAN
Facility Project Name	1ST FLOOR NORTH – PHARMACY USP IMPROVEMENTS

N	Project Title VAMC BUILDING 1 HVAC REPLACEMENT PHASE 1		
	Building Number 1	Checked LJM	Drawn JM
Location WILKES-BARRE, PENNSYLVANIA			

Date	05/14/10
Project No.	693-07-136
DRAWING NO. DRAWING A-1 DWG. 19 OF 48	

Veterans Affairs

DRAWING NO.  
DRAWING  
A-1  
DWG. 19 OF 48