


EXISTING BUILDING ISOMETRIC

**GENERAL NOTES**


1. REFER TO SPECIFICATIONS DIVISION 01 GENERAL REQUIREMENTS.
2. REFER TO DRAWING G-004 FOR PROJECT CONSTRUCTION PHASING NOTES.
3. REFER TO STRUCTURAL DRAWING S-100 FOR FOUNDATION LEVEL PLAN AND RELATED SCOPE OF WORK ITEMS.
4. REFER TO DRAWINGS FP-1-1 THROUGH FP-105 FOR FIRE PROTECTION SYSTEMS AND RELATED SCOPE OF WORK ITEMS.
5. REFER TO DRAWINGS P-101 THROUGH P-105 FOR PLUMBING SYSTEMS AND RELATED SCOPE OF WORK ITEMS.
6. REFER TO ELECTRICAL DRAWINGS E-101 THROUGH E-105 AND EC-101 THROUGH EC-105 FOR ELECTRICAL SYSTEMS AND RELATED SCOPE OF WORK ITEMS.
7. REFER TO AD-103 FOR TEMPORARY CONSTRUCTION BARRIERS.

**DEMOLITION PLAN NOTES**

1. PROVIDE TEMPORARY DUST PROOF BARRIERS PRIOR TO OBLITERATION OF SPECIFIED EXISTING PAVEMENT MARKINGS.
2. EXISTING STAIR UNIT WILL REMAIN ACTIVE AT ALL TIMES.
3. EXISTING FLOOR DRAINS TO REMAIN. PROTECT DURING CONSTRUCTION ACTIVITIES. DO NOT UTILIZE FLOOR DRAINS FOR WASHDOWN ACTIVITIES.
4. EXISTING WATER PIPING AND FROST PROOF HOSE BIBBS TO REMAIN.
5. REFER TO DRAWING AD-101 AND S-520 FOR AREAS AND LOCATION OF EXISTING CONCRETE DECK AND CONCRETE WASH/TOPPING THAT IS SCHEDULED TO BE REMOVED.
6. PROTECT EXISTING ALUMINUM RAILING SYSTEM AT EXTERIOR WALL LINE DURING OBLITERATION ACTIVITIES. CONTRACTOR SHALL CLEAN EXISTING ALUMINUM RAILING SYSTEM AT PROJECT COMPLETION PHASE.
7. CONTRACTOR WILL REMOVE EXISTING PAVEMENT MARKINGS AND TRAFFIC STRIPES/MARKINGS INDICATED ON FLOOR PLANS. REMOVE PAINTED MARKINGS BY HYDROBLASTING, SANDBLASTING OR OTHER METHODS APPROVED BY VA. ANY DAMAGE TO EXISTING CONCRETE DECK SURFACE AS A RESULT OF THE CONTRACTOR OPERATIONS WILL BE REPAIRED BY THE CONTRACTOR.
8. REFER TO DRAWING A-101 THROUGH A-105 FOR PAVEMENT MARKING LAYOUT AND DETAIL DRAWING AP-101.
9. REMOVE EXISTING SIGNAGE AND SUPPORT SYSTEM.

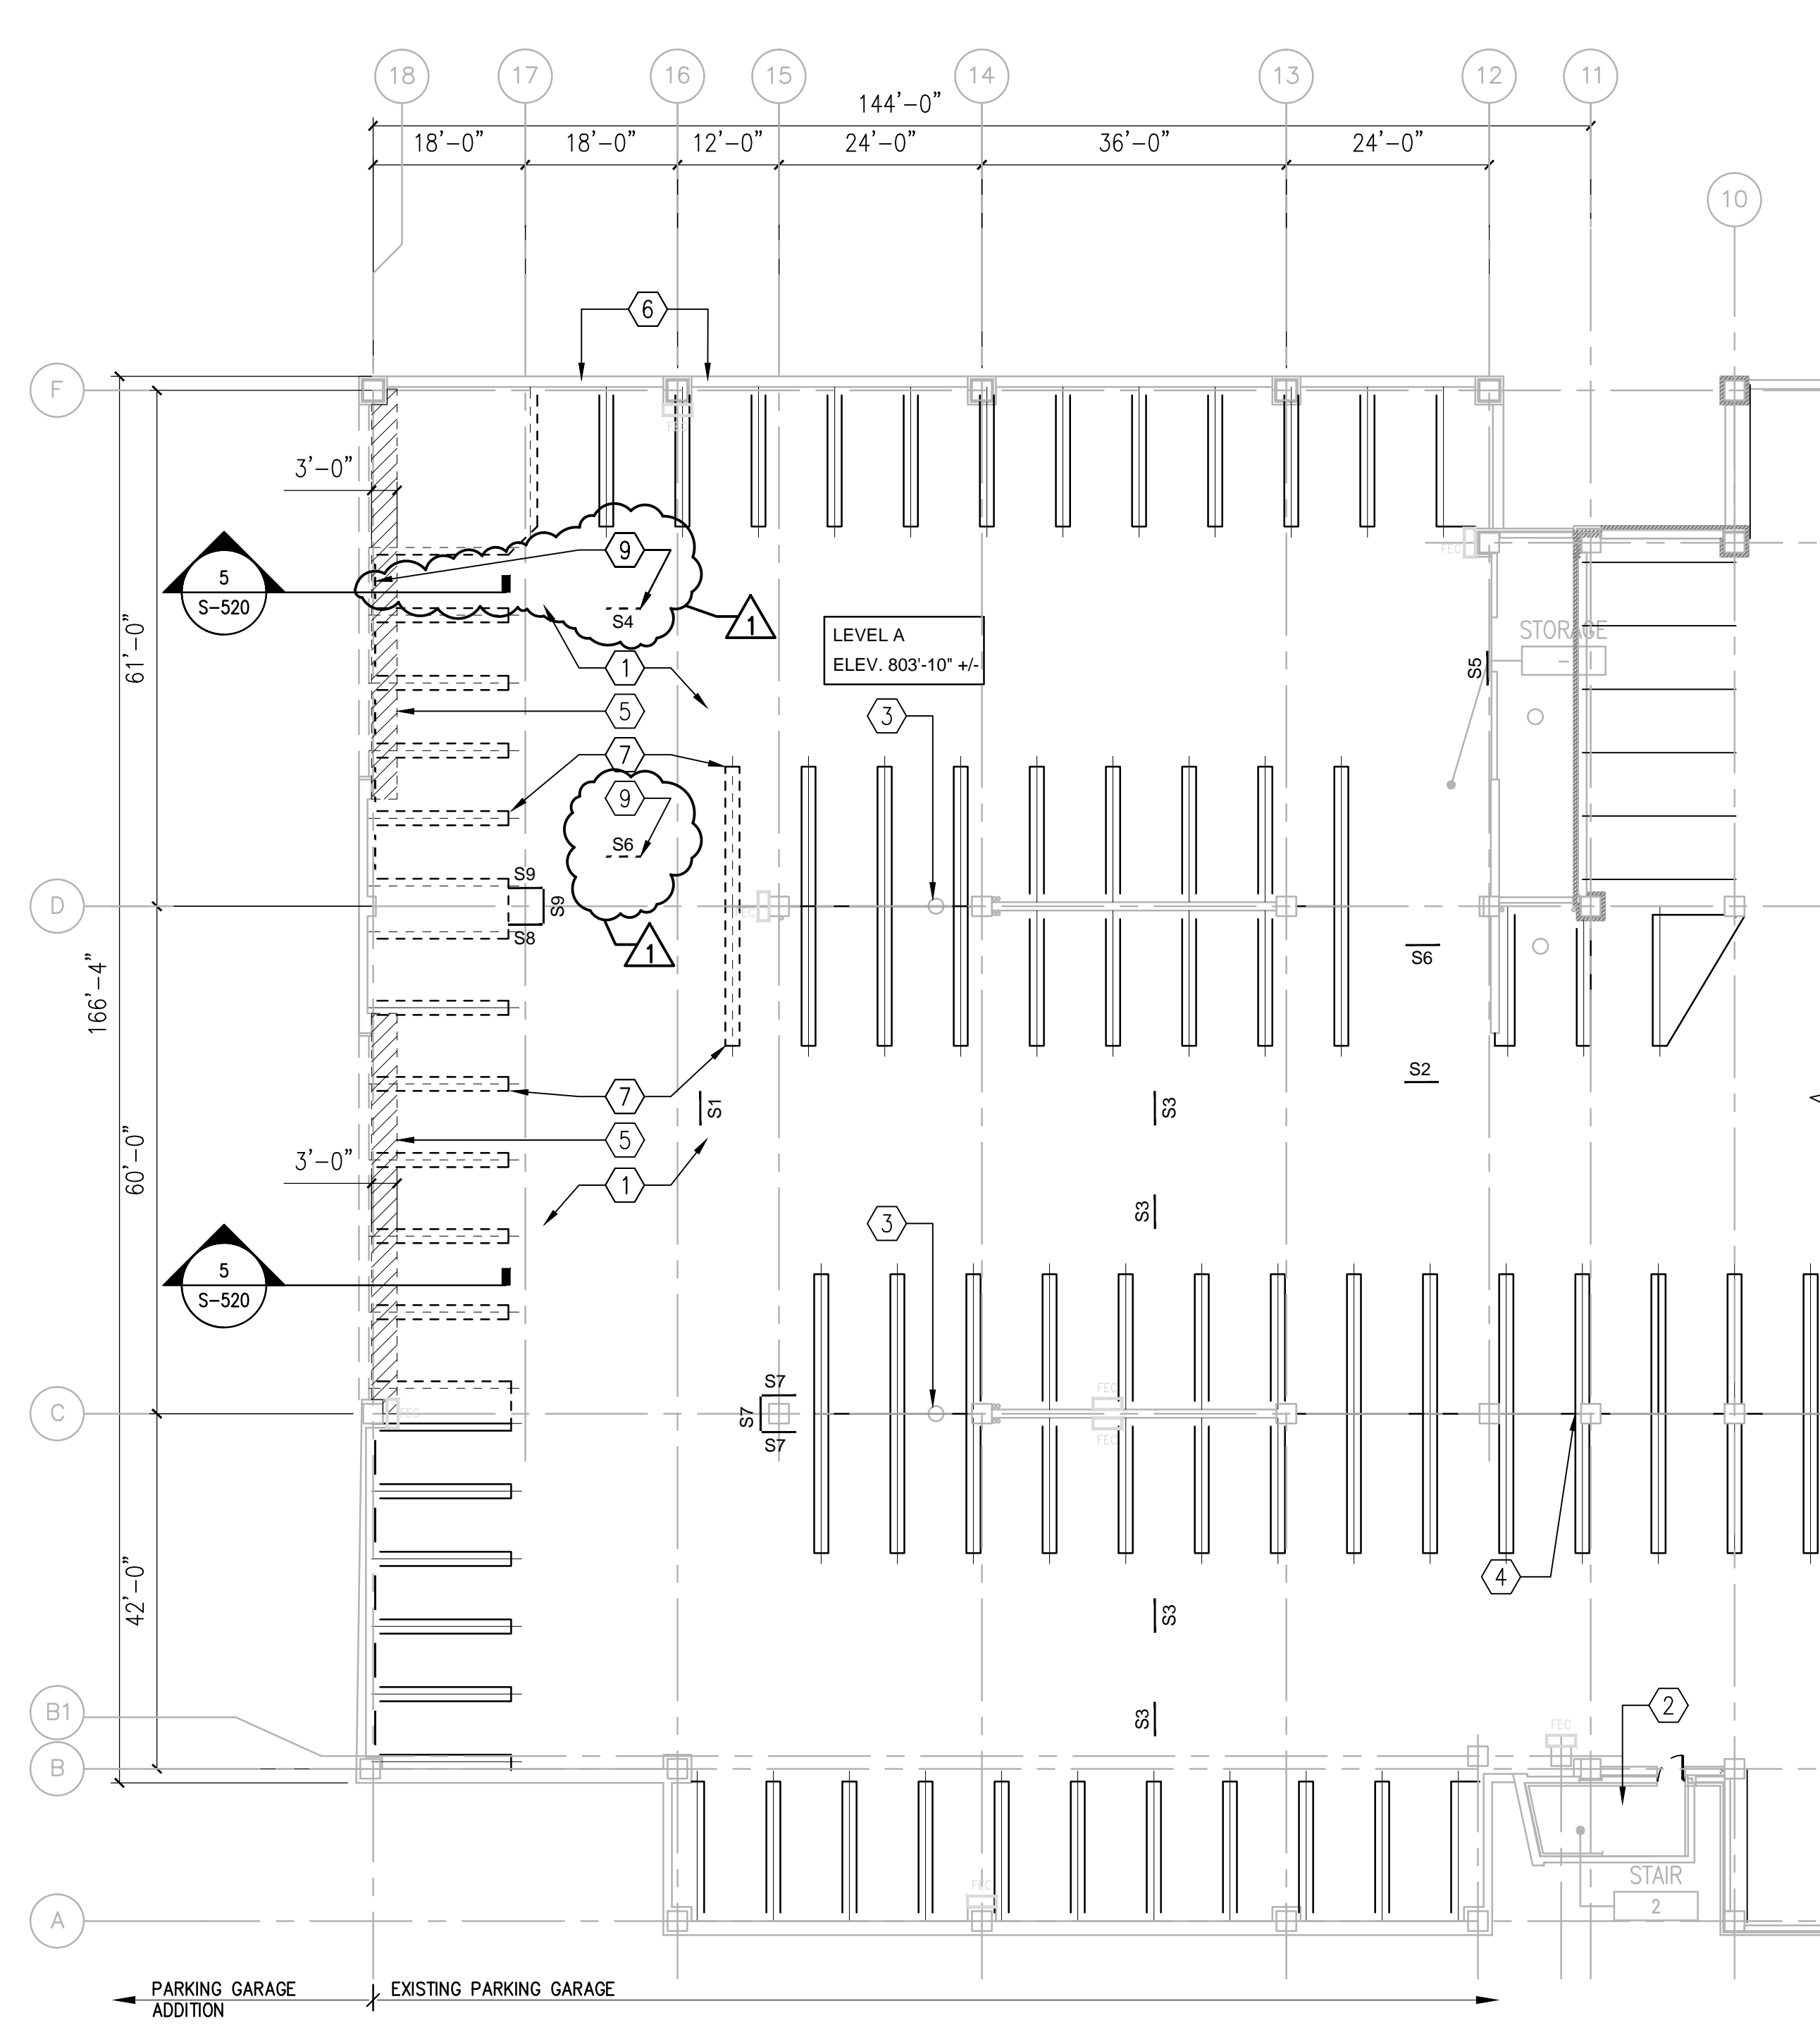

**1 LEVEL A - EXISTING PAVEMENT MARKINGS - DEMOLITION PLAN**  
1/16"=1'-0"  
PLAN NORTH

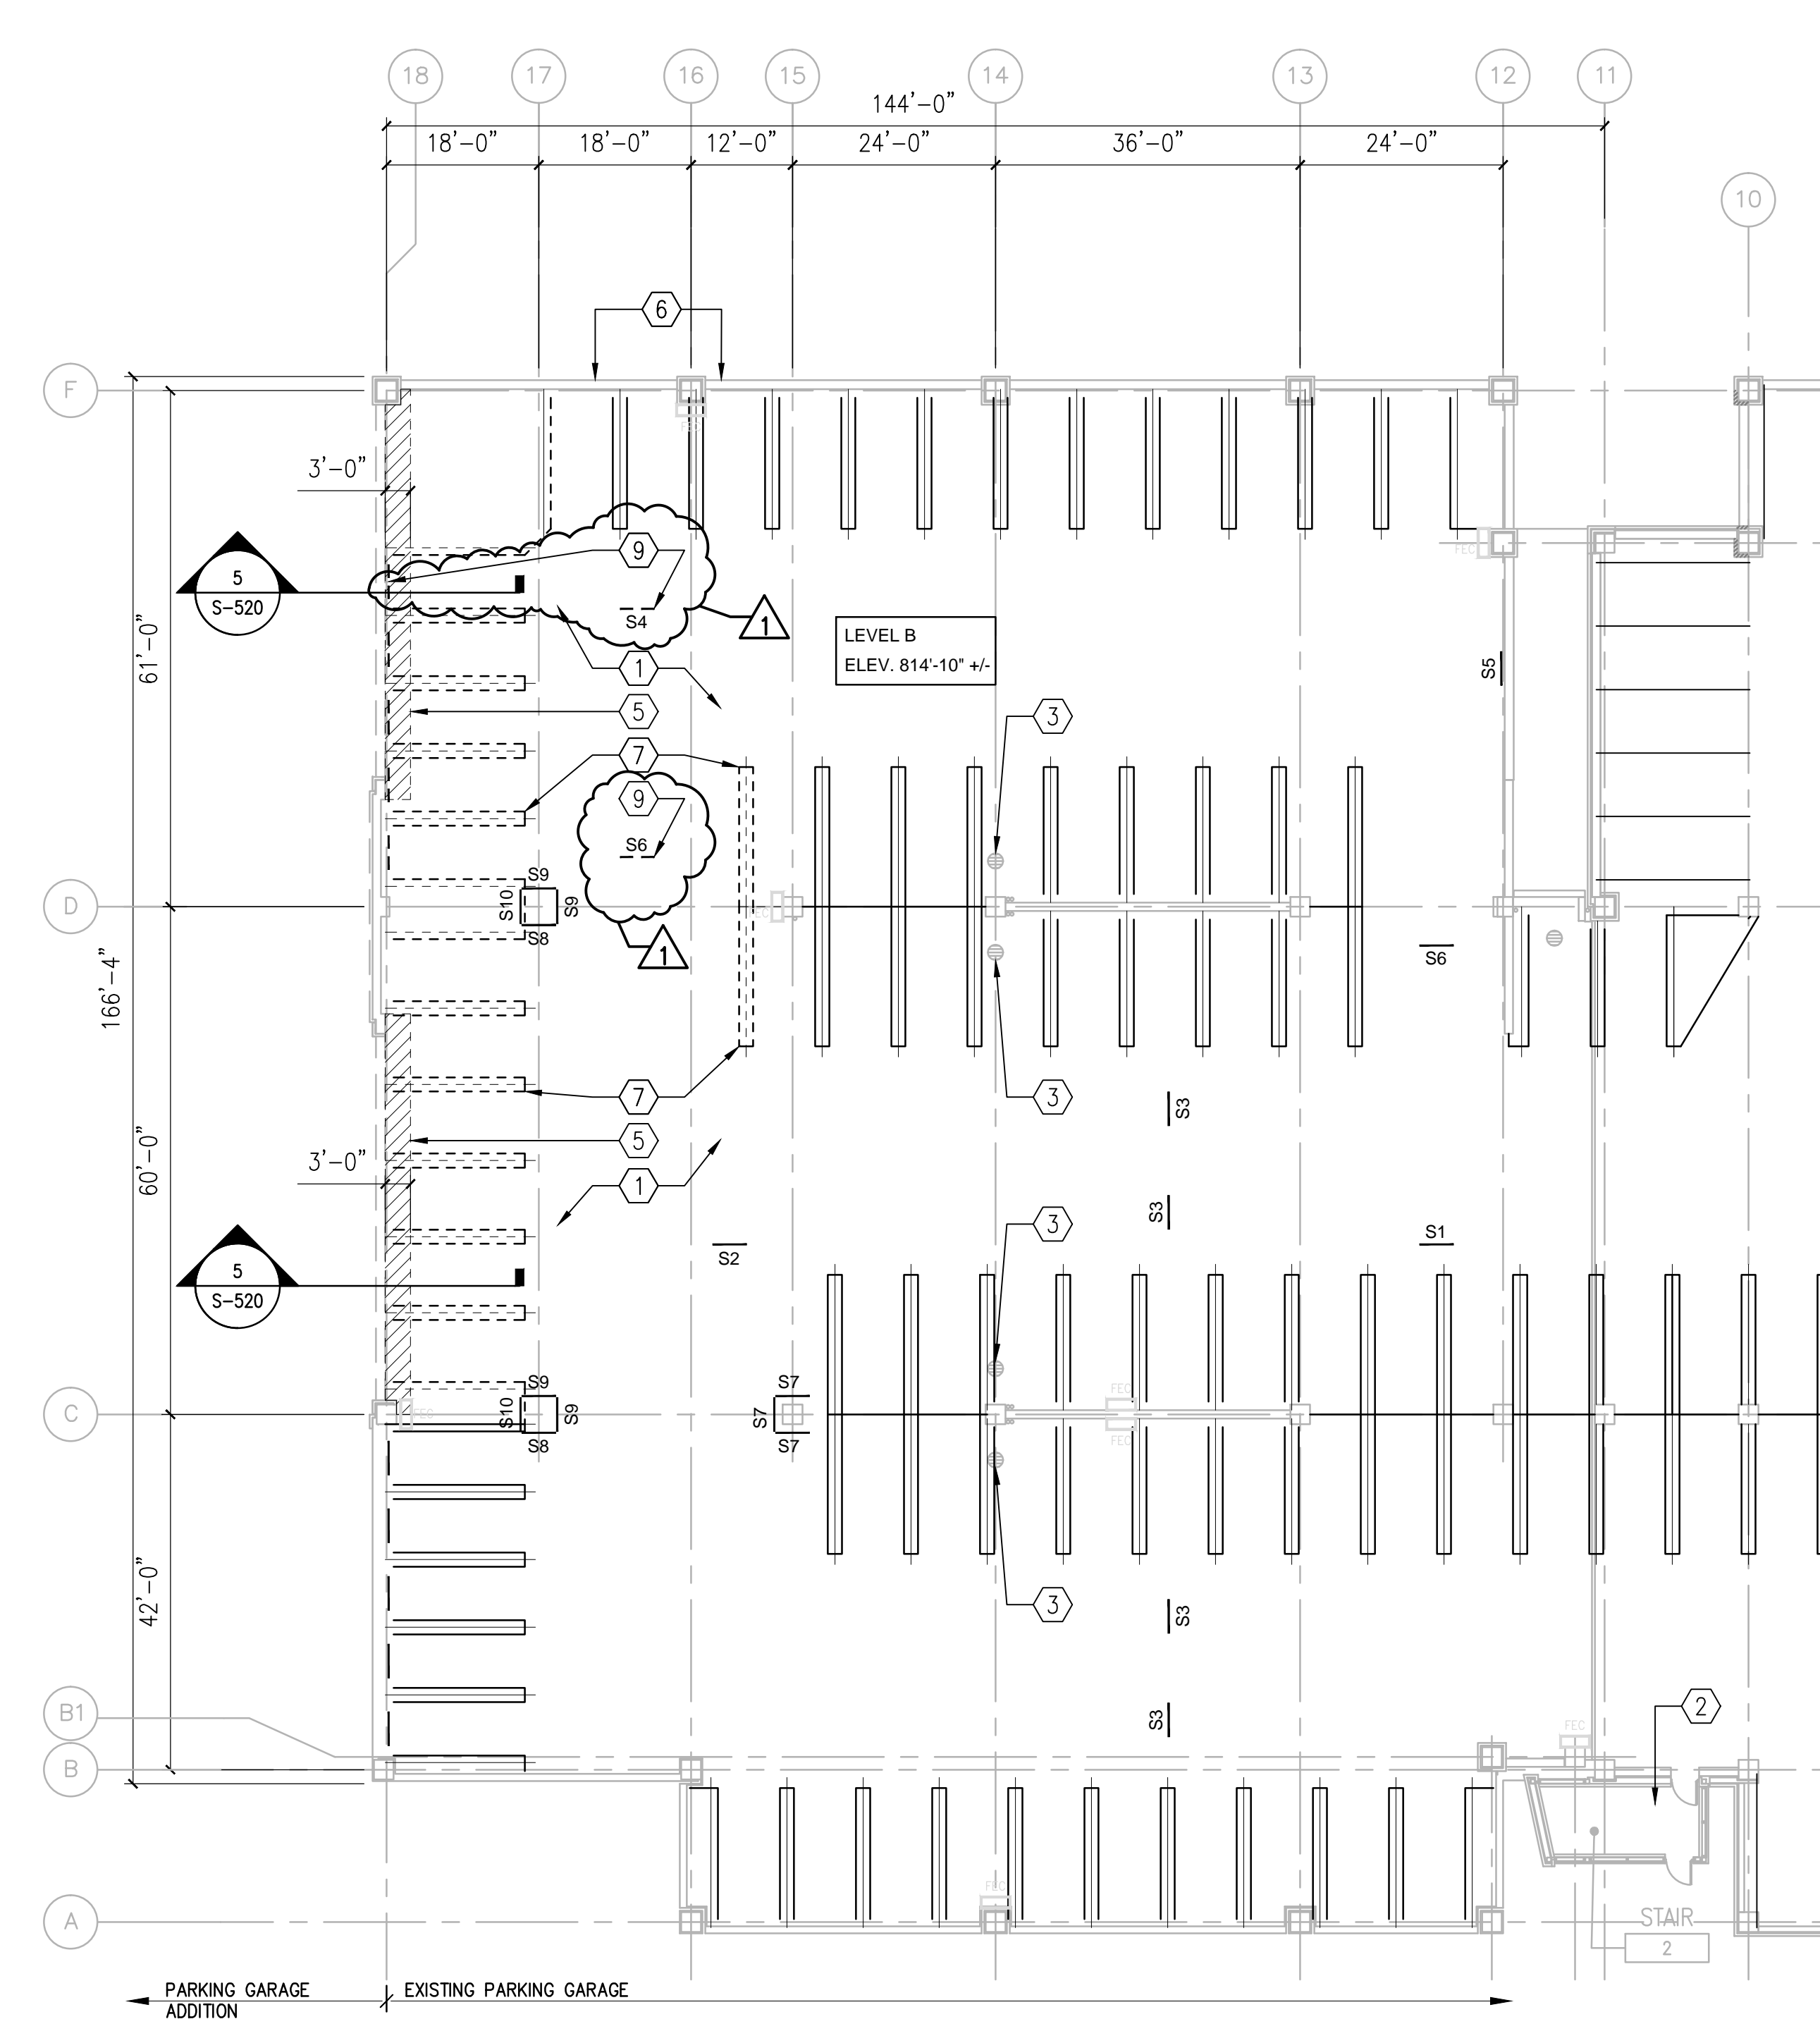

**2 LEVEL B - EXISTING PAVEMENT MARKINGS - DEMOLITION PLAN**  
1/16"=1'-0"  
PLAN NORTH


K:\CCC-PROJECTS\2016\16-12 - VA25116R0030 - Ann Arbor Parking Garage 506-331.dwg - Design Documents\02 - Drawings\WORKINGS\506-331\APD101.dwg 2-06-18 11:46:45 AM ACG/rich

**CONSULTANTS:**

**WALKER PARKING CONSULTANTS**  
225 Ann Arbor, Suite 11  
Ann Arbor, MI 48108

**MIDWESTERN CONSULTING**  
3815 Plaza Drive Ann Arbor, Michigan 48108  
(734) 995-0200 • www.midwesternconsulting.com  
Land Development • Land Survey • Institutional • Municipal  
Wireless Communications • Transportation • Landfill Services

**KEYPLAN**

**ARCHITECT + ENGINEERS:**

**Bancroft**  
BANCROFT ARCHITECTS + ENGINEERS  
700 Nicholas Blvd., Suite 300  
Ek Grove Village, IL 60007  
Telephone : 847.952.9342  
www.bancroft-ae.com  
Bancroft-AE Project No. 16-121  
VA CONTRACT NO. VA250-17-C-0008

**Drawing Title**  
LEVELS A AND B  
EXISTING PAVEMENT MARKINGS  
DEMOLITION PLANS

**Approved Project Director**

**Project Title**  
CONSTRUCT NORTH  
PARKING STRUCTURE

**Location**  
ANN ARBOR, MICHIGAN

**Date**  
02-06-2018

**Checked**  
EM

**Drawn**  
AG

**Project Number**  
506-331

**Building Number**  
29

**Drawing Number**  
APD-101

**Office of Construction and Facilities Management**

**Department of Veterans Affairs**