


EXISTING BUILDING ISOMETRIC

GENERAL NOTES


1. REFER TO SPECIFICATIONS DIVISION 01 GENERAL REQUIREMENTS.
2. REFER TO DRAWING G-004 FOR PROJECT CONSTRUCTION PHASING NOTES.
3. REFER TO STRUCTURAL DRAWING S-100 FOR FOUNDATION LEVEL PLAN AND RELATED SCOPE OF WORK ITEMS.
4. REFER TO DRAWINGS FP-1-1 THROUGH FP-105 FOR FIRE PROTECTION SYSTEMS AND RELATED SCOPE OF WORK ITEMS.
5. REFER TO DRAWINGS P-101 THROUGH P-105 FOR PLUMBING SYSTEMS AND RELATED SCOPE OF WORK ITEMS.
6. REFER TO ELECTRICAL DRAWINGS E-101 THROUGH E-105 AND EC-101 THROUGH EC-105 FOR ELECTRICAL SYSTEMS AND RELATED SCOPE OF WORK ITEMS.
7. REFER TO AD-103 FOR TEMPORARY CONSTRUCTION BARRIERS.

DEMOLITION PLAN NOTES

1. PROVIDE TEMPORARY DUST PROOF BARRIERS PRIOR TO OBLITERATION OF SPECIFIED EXISTING PAVEMENT MARKINGS.
2. EXISTING STAIR UNIT WILL REMAIN ACTIVE AT ALL TIMES.
3. EXISTING FLOOR DRAINS TO REMAIN. PROTECT DURING CONSTRUCTION ACTIVITIES. DO NOT UTILIZE FLOOR DRAINS FOR WASHDOWN ACTIVITIES.
4. EXISTING WATER PIPING AND FROST PROOF HOSE BIBBS TO REMAIN.
5. REFER TO DRAWING AD-101 AND S-520 FOR AREAS AND LOCATION OF EXISTING CONCRETE DECK AND CONCRETE WASH/TOPPING THAT IS SCHEDULED TO BE REMOVED.
6. PROTECT EXISTING ALUMINUM RAILING SYSTEM AT EXTERIOR WALL LINE DURING OBLITERATION ACTIVITIES. CONTRACTOR SHALL CLEAN EXISTING ALUMINUM RAILING SYSTEM AT PROJECT COMPLETION PHASE.
7. CONTRACTOR WILL REMOVE EXISTING PAVEMENT MARKINGS AND TRAFFIC STRIPES/MARKINGS INDICATED ON FLOOR PLANS. REMOVE PAINTED MARKINGS BY HYDROBLASTING, SANDBLASTING OR OTHER METHODS APPROVED BY VA. ANY DAMAGE TO EXISTING CONCRETE DECK SURFACE AS A RESULT OF THE CONTRACTOR OPERATIONS WILL BE REPAIRED BY THE CONTRACTOR.
8. REFER TO DRAWING A-101 THROUGH A-105 FOR PAVEMENT MARKING LAYOUT AND DETAIL DRAWING AP-101.
9. REMOVE EXISTING SIGNAGE AND SUPPORT SYSTEM.

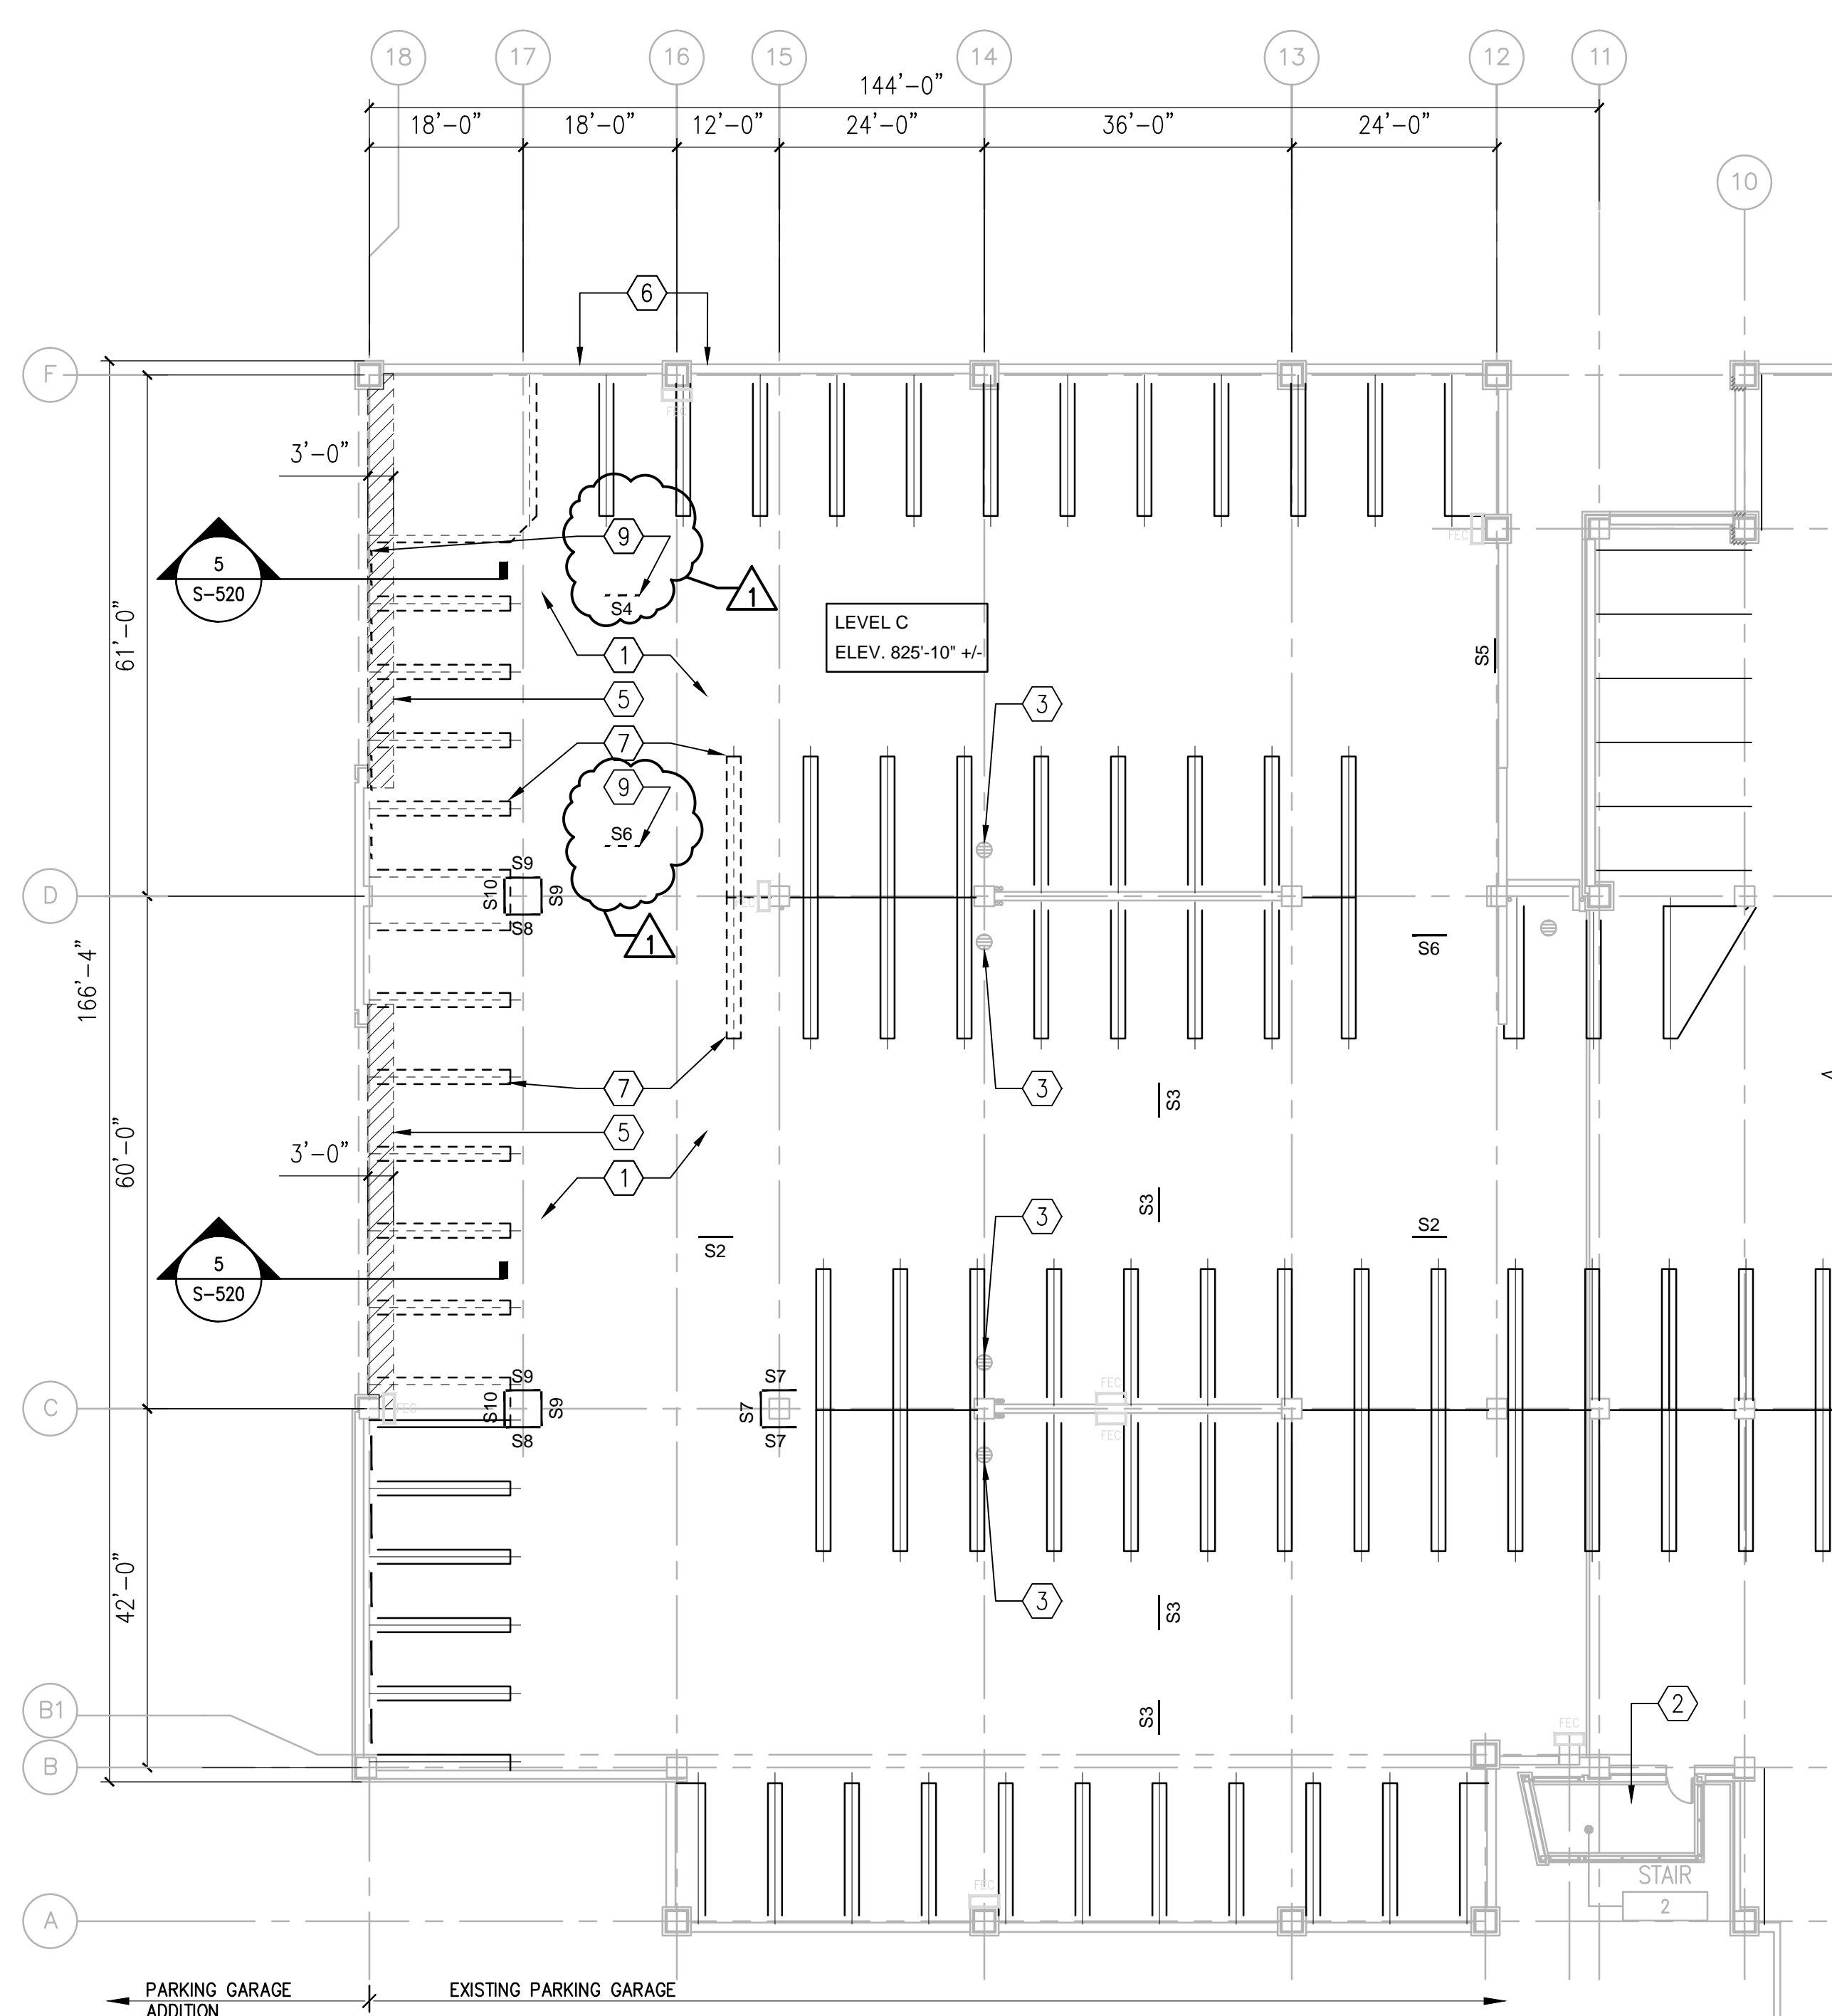

1 LEVEL C - EXISTING PAVEMENT MARKINGS - DEMOLITION PLAN
1/16"=1'-0"

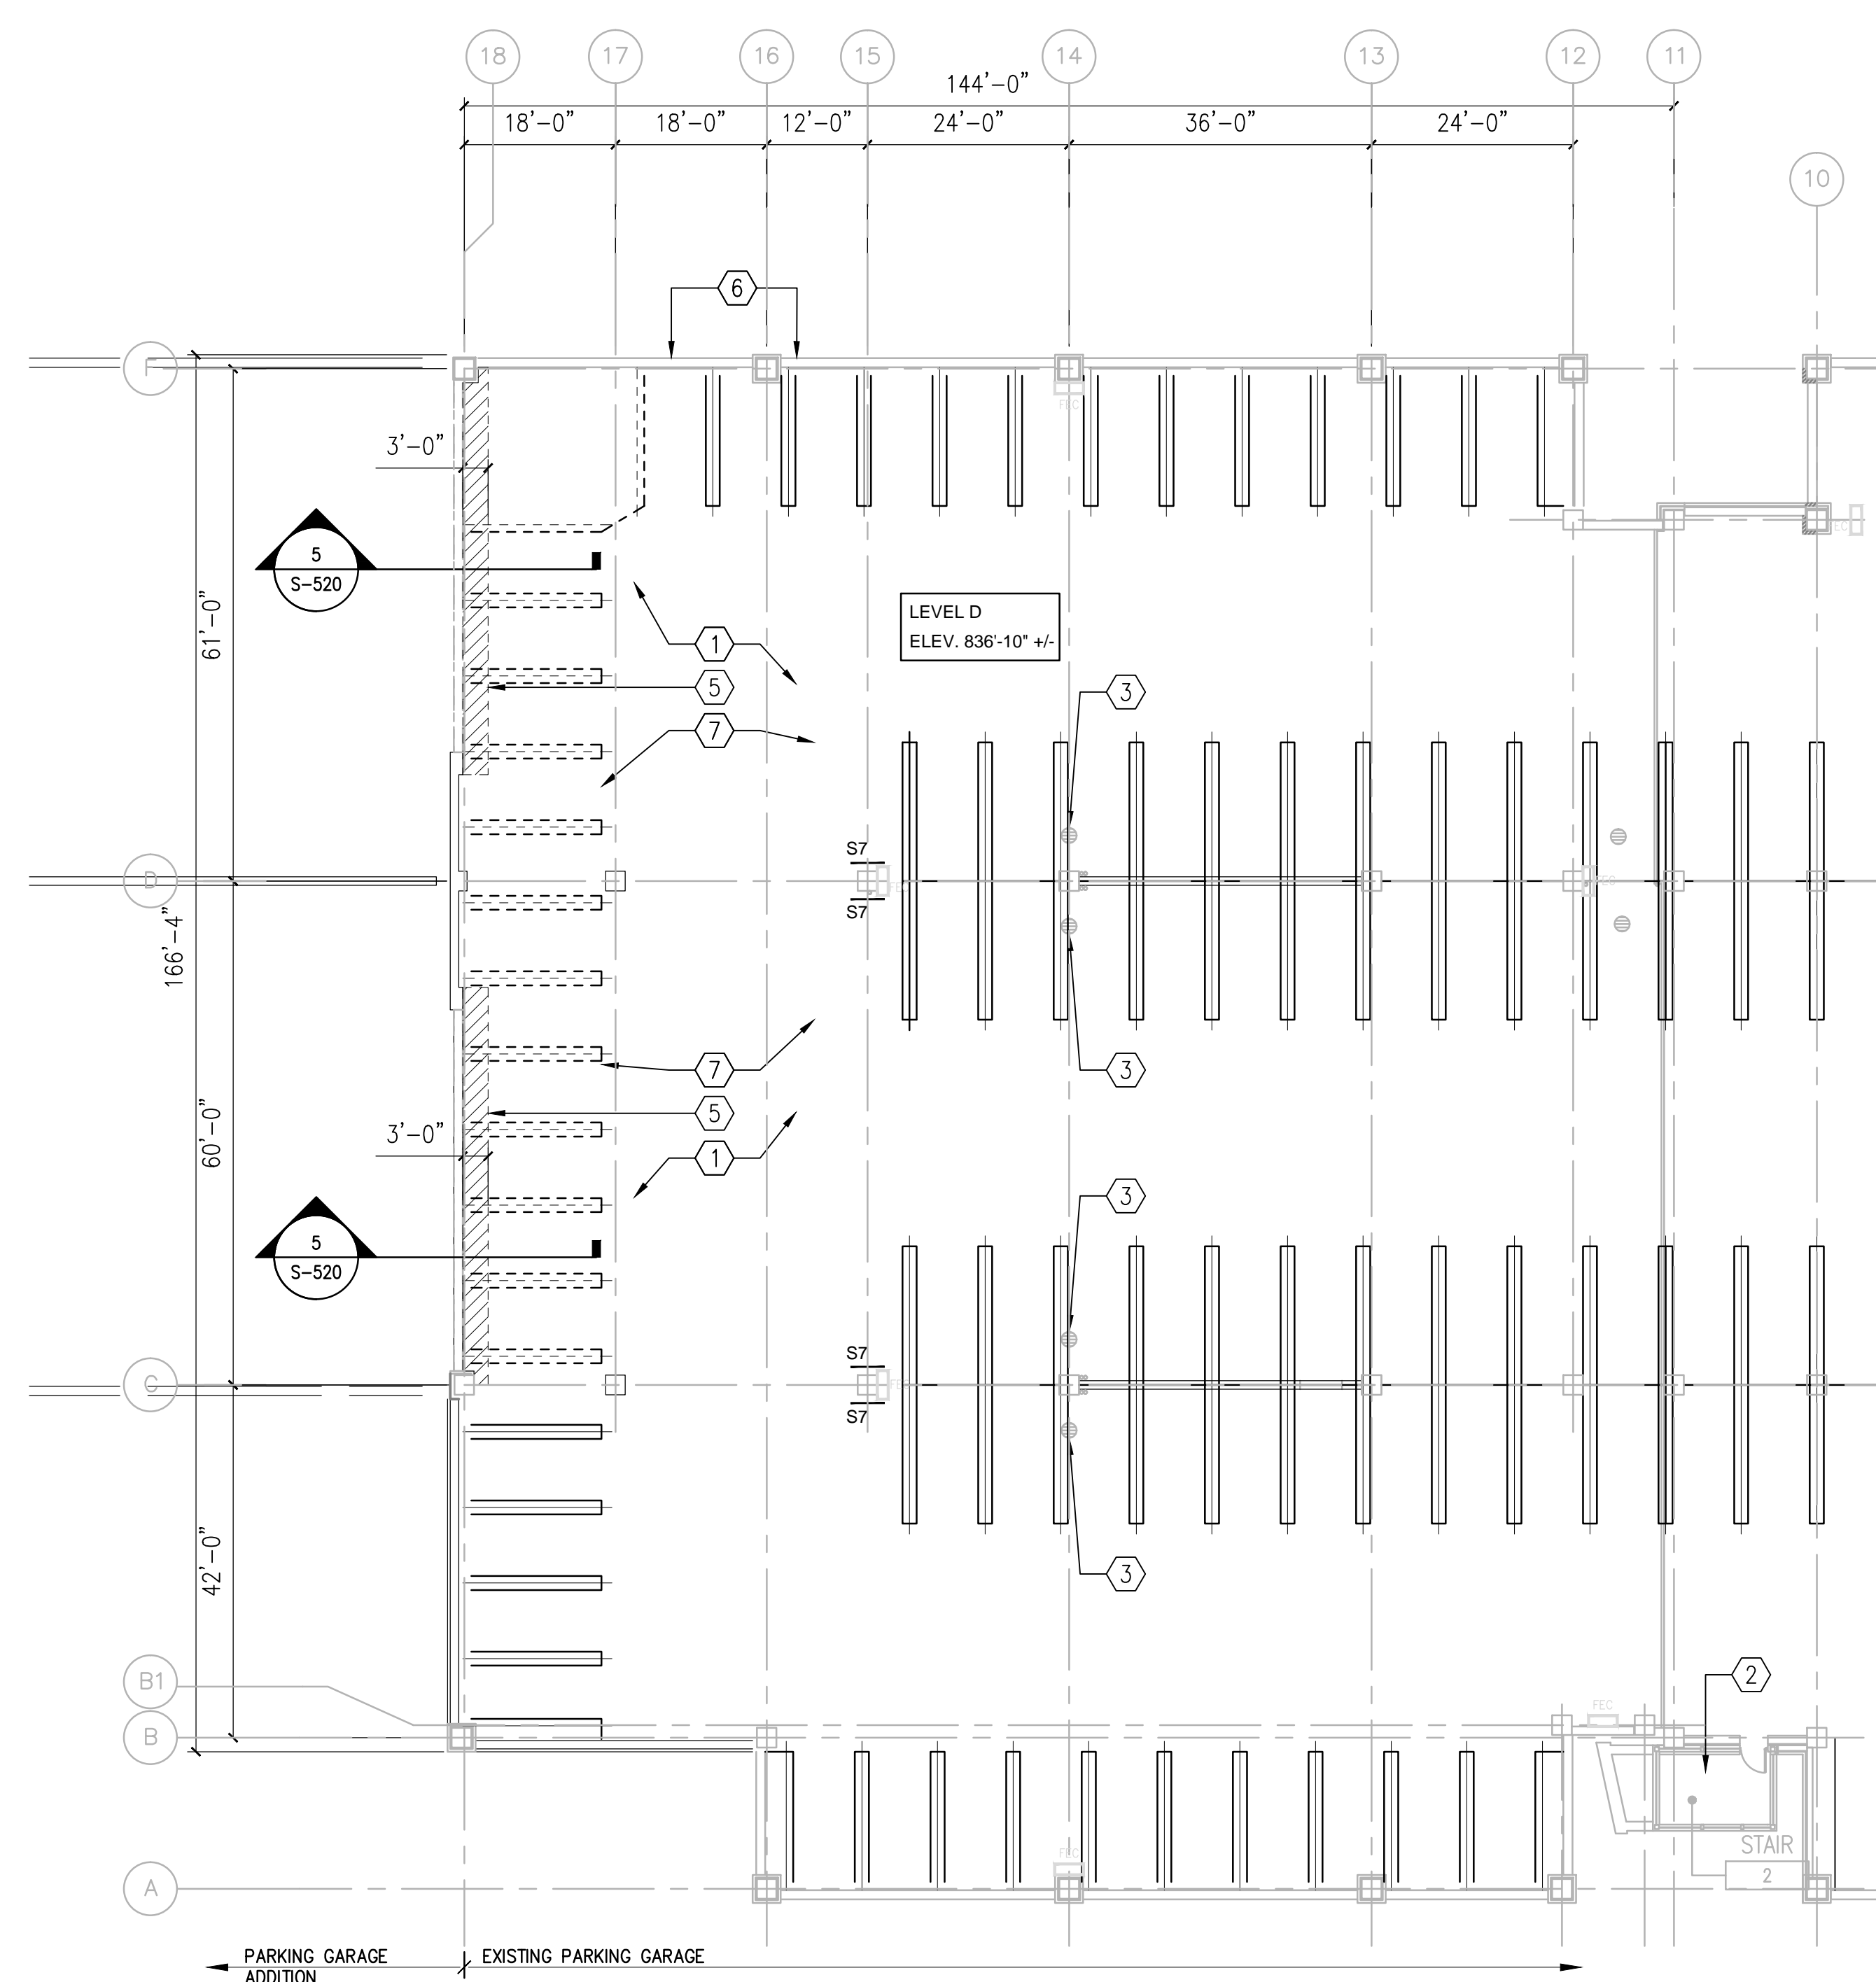

2 LEVEL D - EXISTING PAVEMENT MARKINGS - DEMOLITION PLAN
1/16"=1'-0"



FFI 005 SIGNAGE	02-06-2018
100% FINAL BID DOCUMENTS	08-16-2017
100% CONSTRUCTION DOCUMENTS SUBMISSION	07-24-2017
95% CONSTRUCTION DOCUMENTS SUBMISSION	06-15-2017
65% DESIGN DEVELOPMENT SUBMISSION	04-19-2017
35% SCHEMATIC DESIGN SUBMISSION	03-06-2017
Revisions	Date

CONSULTANTS:

WALKER PARKING CONSULTANTS
225 Ann Arbor, Suite 11
Ann Arbor, MI 48108

MIDWESTERN CONSULTING
3815 Plaza Drive Ann Arbor, Michigan 48108
(734) 995-0200 • www.midwesternconsulting.com
Land Development • Land Survey • Institutional • Municipal
Wireless Communications • Transportation • Landfill Services

KEYPLAN

ARCHITECT + ENGINEERS:

Bancroft
BANCROFT ARCHITECTS + ENGINEERS
700 Nicholas Blvd., Suite 300
Ely Grove Village, IL 60007
Telephone : 847.952.9342
www.bancroft-ae.com
Bancroft-AE Project No. 14-121
VA CONTRACT NO. VA250-17-C-0008

Drawing Title	LEVELS C AND D EXISTING PAVEMENT MARKINGS DEMOLITION PLANS
Approved Project Director	

Project Title	CONSTRUCT NORTH PARKING STRUCTURE
Project Number	506-331
Building Number	29
Drawing Number	APD-102
Location	ANN ARBOR, MICHIGAN
Date	02-06-2018
Checked	EM
Drawn	AG

Office of
Construction
and Facilities
Management

Department of
Veterans Affairs