


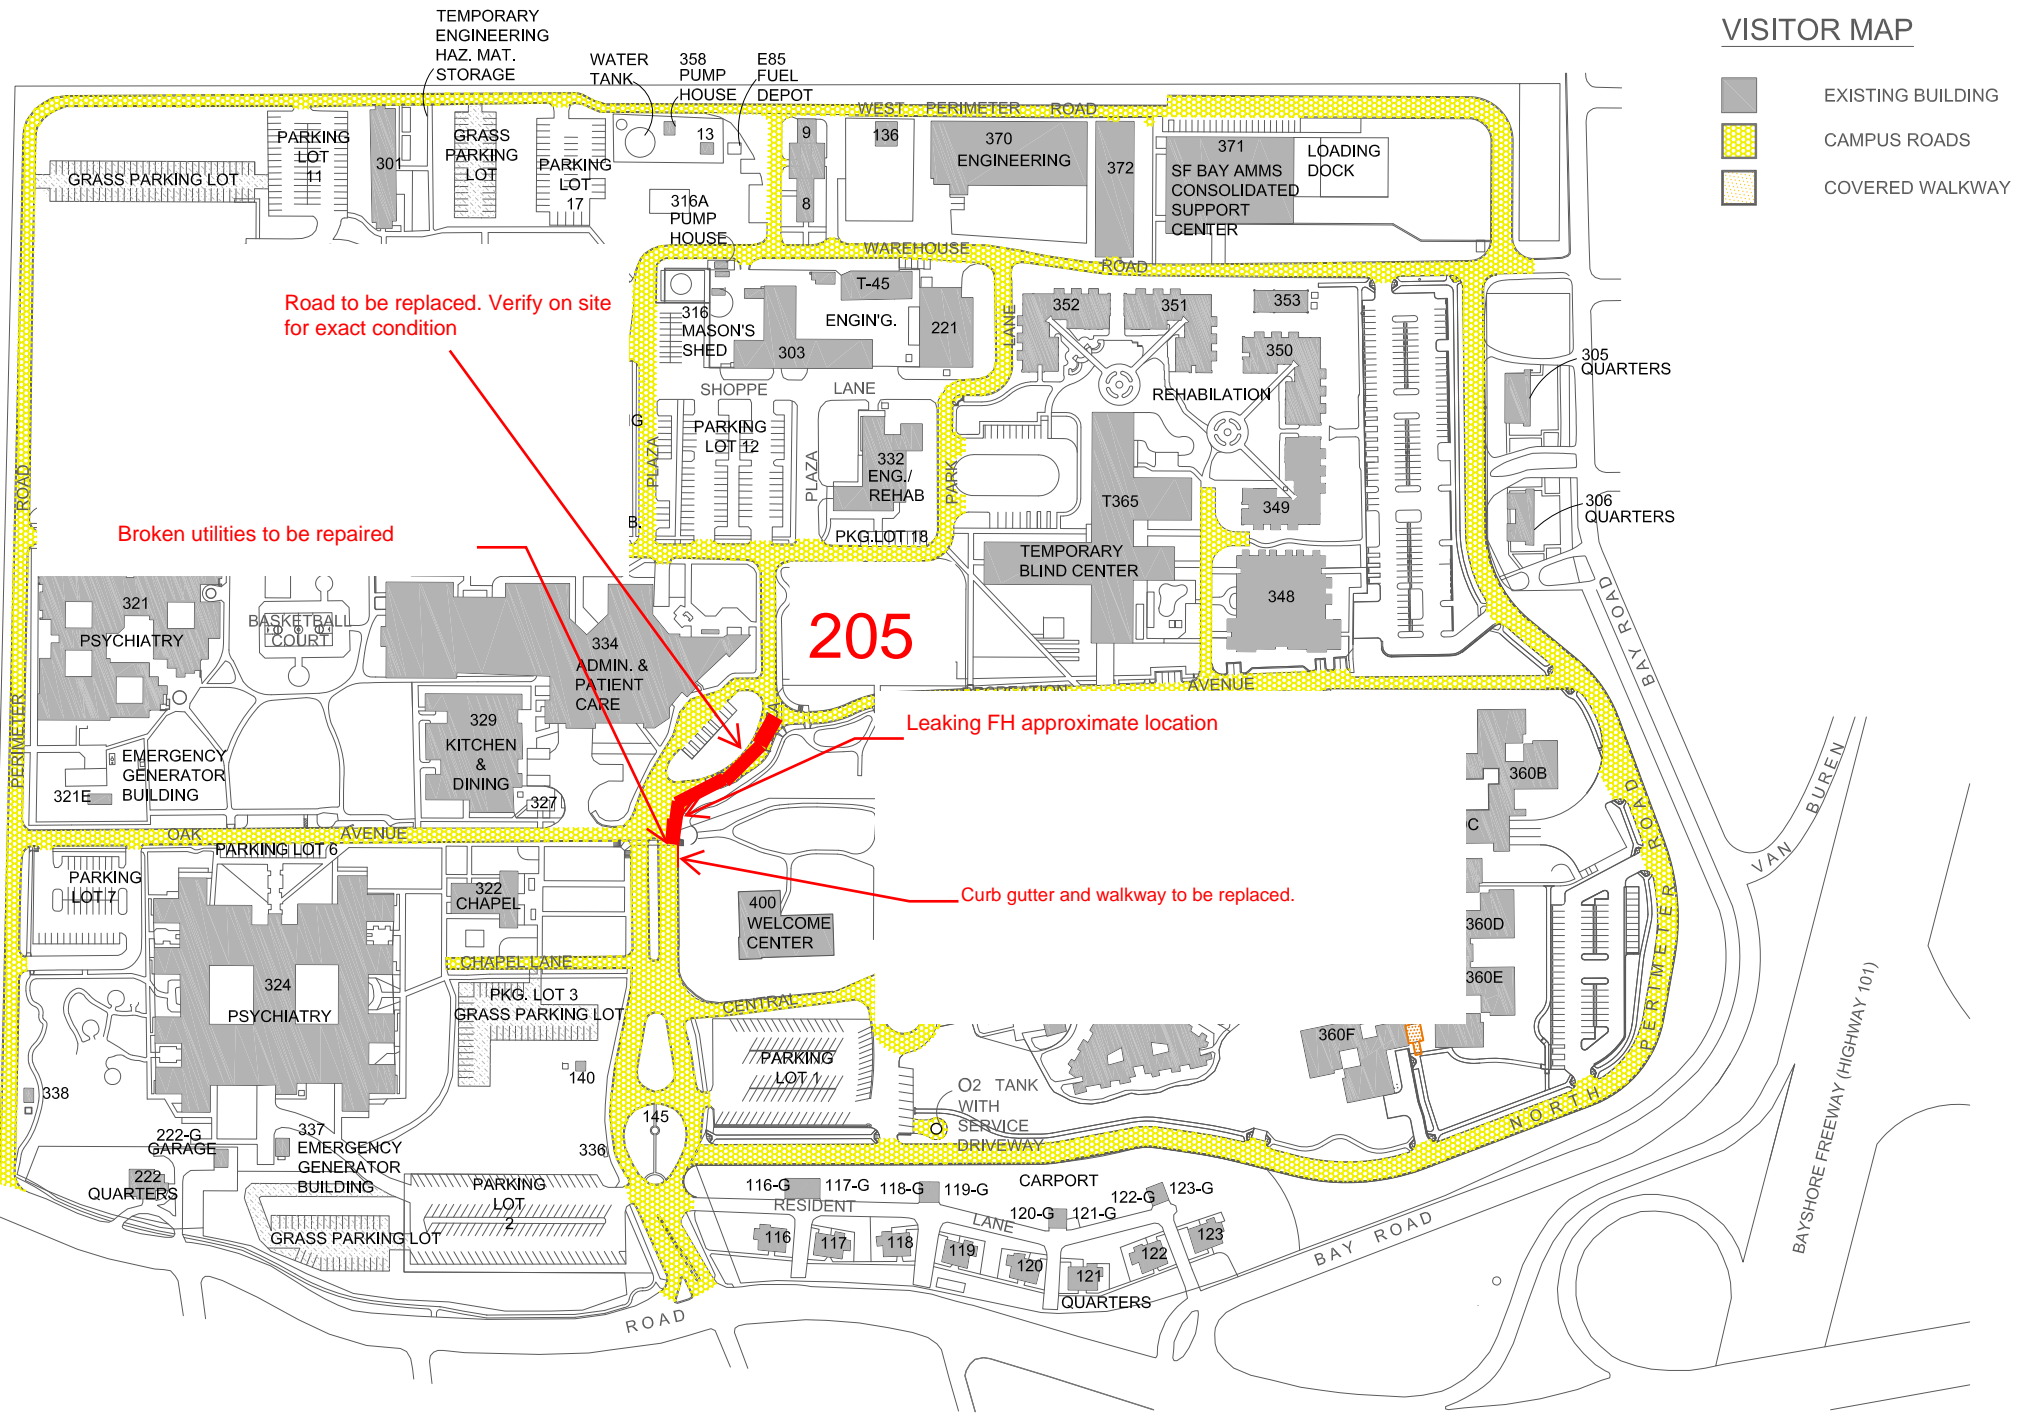


VA MENLO PARK DIVISION

795 Willow Road, Menlo Park, California 94025

VISITOR MAP

-  EXISTING BUILDING
-  CAMPUS ROADS
-  COVERED WALKWAY



Road to be replaced. Verify on site for exact condition

Broken utilities to be repaired

205

Leaking FH approximate location

Curb gutter and walkway to be replaced.

BAYSHORE FREEWAY (HIGHWAY 101)