


**1 WEST ELEVATION**  
1/8"=1'-0"

**GENERAL NOTES**

- REFER TO SPECIFICATIONS DIVISION 01 GENERAL REQUIREMENTS.
- REFER TO DRAWING G-004 FOR PROJECT CONSTRUCTION PHASING NOTES.
- REFER TO DRAWING S-100 THROUGH S-105 FOR STRUCTURAL FRAMING PLANS AND RELATED SCOPE OF WORK ITEMS.
- CONTRACTOR SHALL NOTE THAT THERE IS ATTIC STOCK FACE BRICK THAT WILL BE UTILIZED UNDER THIS CONTRACT. THERE ARE APPROXIMATELY 13 CUBES OF FACE BRICK IN ATTIC STOCK, +/- 6,500 FACE BRICK UNITS. THE FACE BRICK IS CURRENTLY STORED AT THE EXTERIOR OF THE EXISTING PARKING GARAGE BETWEEN COLUMN LINES 11-12 AT F. CONTRACTOR WILL VERIFY TOTAL FACE BRICK UNITS AVAILABLE PRIOR TO BIDDING.

**ELEVATION NOTES**

- PROPOSED EXTERIOR FINISH GRADE ELEVATIONS.
- CAST IN PLACE CONCRETE FOUNDATION WALL SYSTEM. REFER TO DRAWING S-100.
- NOMINAL 4" FACE BRICK VENEER SYSTEM. REFER TO DRAWING A-302 AND A-303.
- PRECAST CONCRETE SPANDREL PANEL SYSTEM. REFER TO DRAWING A-302 AND A-303.
- ALUMINUM RAILING SYSTEM. REFER TO DRAWING A-305.
- PRECAST CONCRETE BANDING/COURSE. REFER TO DRAWING A-302 AND A-303.
- ALUMINUM STORE FRONT DOOR AND SIDE LIGHT. REFER TO DRAWING A-801.
- PRECAST CONCRETE COPING/CAP. REFER TO DRAWING A-302 AND A-303.
- TYPICAL EXTERIOR WALL OPENINGS AT PARKING GARAGE.
- PRECAST CONCRETE STAIR UNITS. REFER TO DRAWINGS A-401 AND A-504.
- FIRE DEPARTMENT CONNECTION. REFER TO DRAWING FP-102.
- LIGHT POLES AND FIXTURES. REFER TO DRAWING E-105.
- EXISTING FACE BRICK VENEER AND CONCRETE MASONRY UNIT EXTERIOR WALL.
- EXISTING ALUMINUM RAILING SYSTEM.
- EXISTING PRECAST CONCRETE SPANDREL PANELS.
- PARKING GARAGE LEVEL E ADDITION ABOVE EXISTING PARKING GARAGE EXPANSION UNDER CONSTRUCTION.
- EXISTING GRADE ELEVATION.
- PRECAST CONCRETE SHEARWALL.

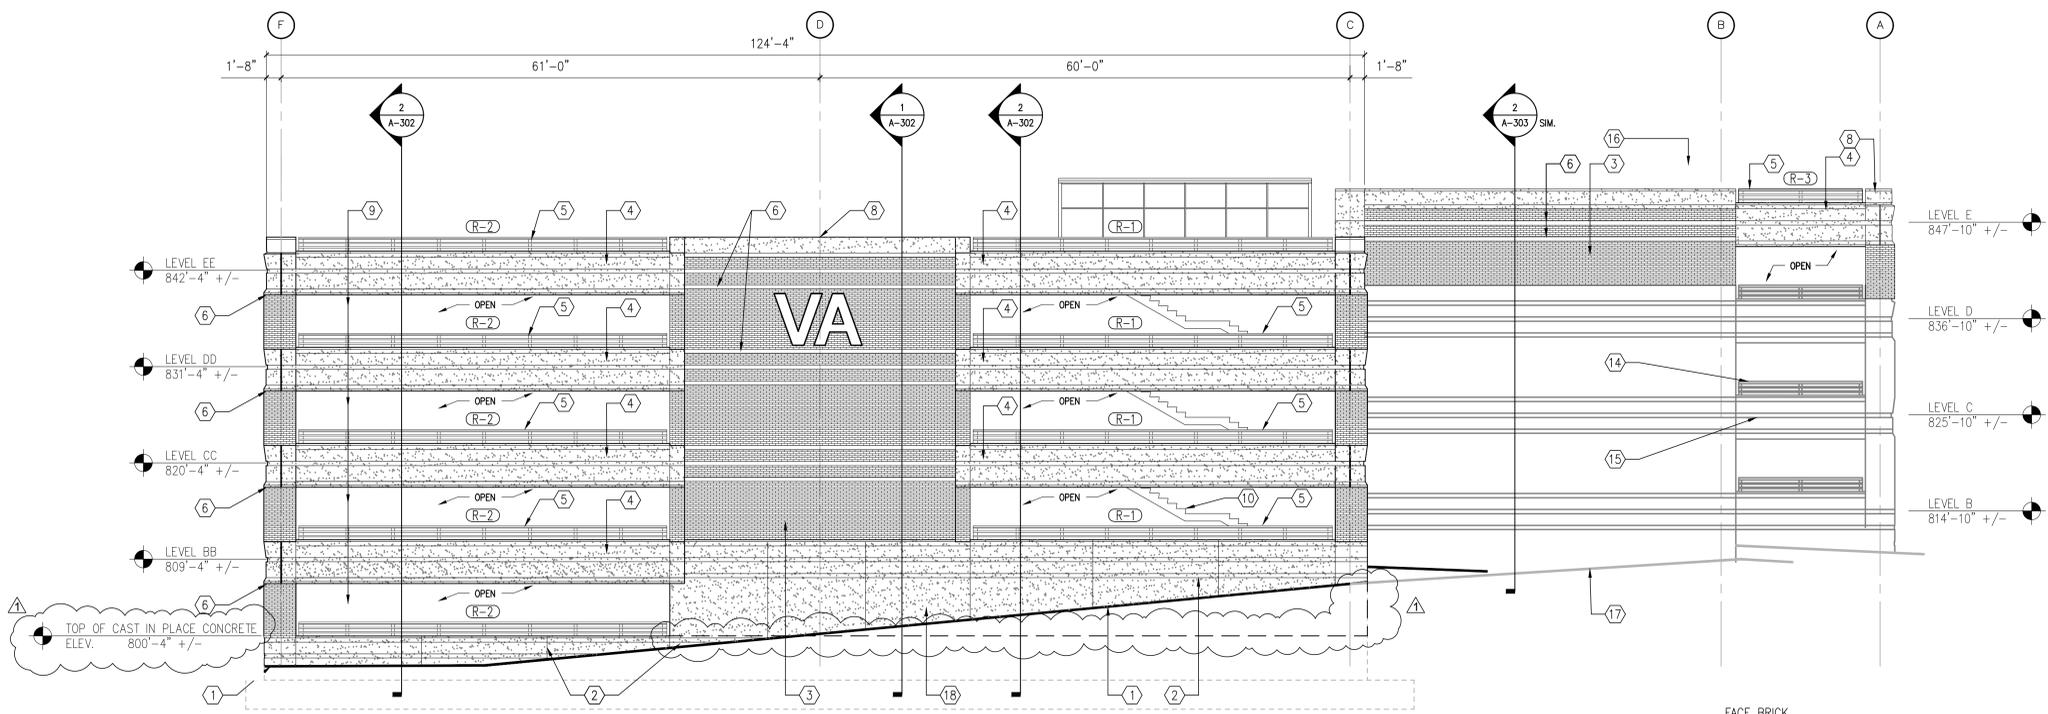

**2 NORTH ELEVATION**  
1/8"=1'-0"

FACE BRICK  
YANKEE HILL BRICK COMPANY  
3705 SOUTH CODDINGTON AVENUE LINCOLN, NEBRASKA 68522  
TELEPHONE 402-477-6663  
WWW.YANKEEHILLBRICK.COM

- YANKEE HILL LIGHT, MEDIUM AND DARK RED SMOOTH VASPCI (3 5/8" X 2 3/8" X 7 5/8") BRICKS
- BRICKS TO MEET AND EXCEED ALL REQUIREMENTS AS SET FORTH IN ASTM C216 FOR CLASS SW, TYPE FBS

REVISION NO. 1	02-12-2018
100% FINAL BID DOCUMENTS	08-18-2017
100% BID DOCUMENTS-NOT FOR CONSTRUCTION	07-24-2017
95% CONSTRUCTION DOCUMENTS SUBMISSION	06-15-2017
65% DESIGN DEVELOPMENT SUBMISSION	04-19-2017
35% SCHEMATIC DESIGN SUBMISSION	03-06-2017
Revisions:	Date

**CONSULTANTS:**

**WALKER PARKING CONSULTANTS**

**MIDWESTERN CONSULTING**  
3815 Plaza Drive • Ann Arbor, Michigan 48108  
(734) 995-0200 • www.midwesternconsulting.com  
Land Development • Land Survey • Institutional • Municipal  
Wireless Communications • Transportation • Landfill Services

**KEYPLAN**

**ARCHITECT + ENGINEERS:**

**Bancroft**  
BANCROFT ARCHITECTS + ENGINEERS  
700 Nicholas Blvd., Suite 300  
Eli Grove Village, IL 60007  
Telephone : 847.932.9362  
www.bancroft-ae.com  
Bancroft-AE Project No. 16-121  
VA CONTRACT NO. VA250-17-C-0008

**Drawing Title**  
BUILDING ELEVATIONS

**Approved Project Director**

**Project Title**  
CONSTRUCT NORTH PARKING STRUCTURE

**Location**  
ANN ARBOR, MICHIGAN

**Date**  
08-18-2017

**Checked**  
EM

**Drawn**  
AG

**Project Number**  
506-331

**Building Number**  
29

**Drawing Number**  
A-201

**Office of Construction and Facilities Management**

Department of Veterans Affairs