


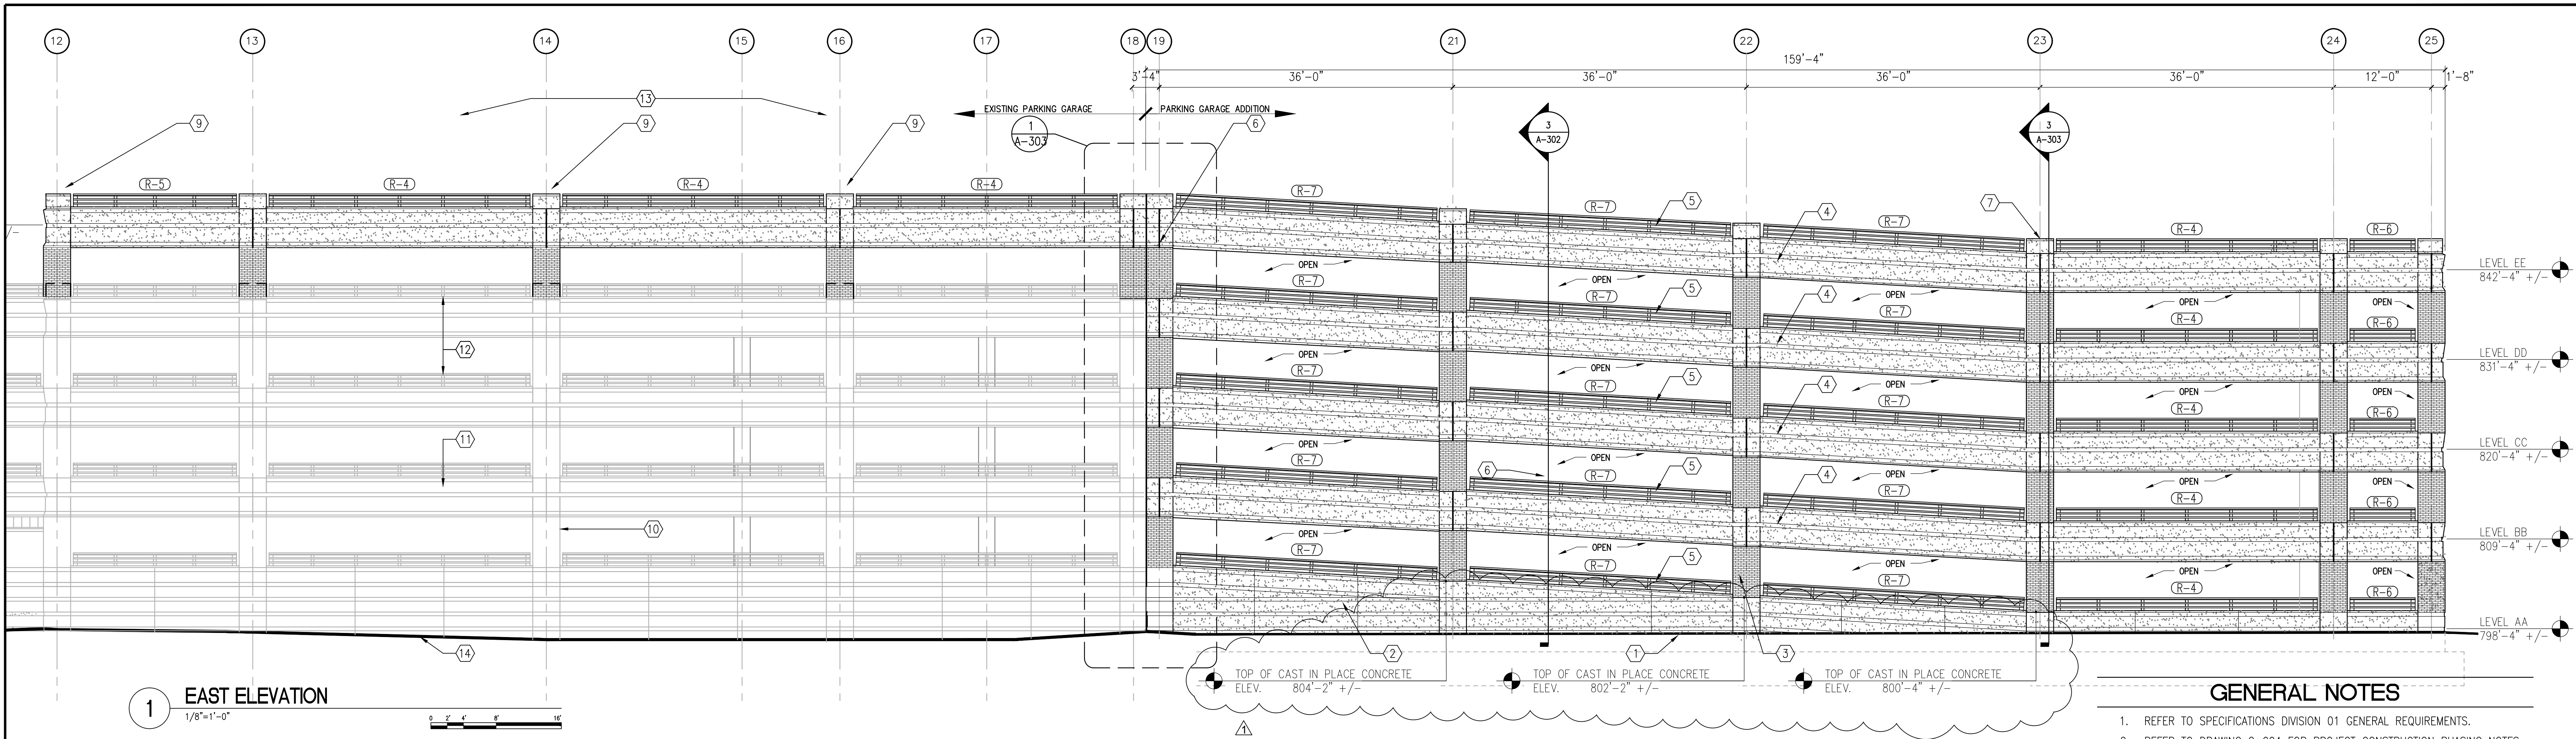


GENERAL NOTES


- REFER TO SPECIFICATIONS DIVISION 01 GENERAL REQUIREMENTS.
- REFER TO DRAWING G-004 FOR PROJECT CONSTRUCTION PHASING NOTES.
- REFER TO DRAWING S-100 THROUGH S-105 FOR STRUCTURAL FRAMING PLANS AND RELATED SCOPE OF WORK ITEMS.
- CONTRACTOR SHALL NOTE THAT THERE IS ATTIC STOCK FACE BRICK THAT WILL BE UTILIZED UNDER THIS CONTRACT. THERE ARE APPROXIMATELY 13 CUBES OF FACE BRICK IN ATTIC STOCK, +/- 6,500 FACE BRICK UNITS. THE FACE BRICK IS CURRENTLY STORED AT THE EXTERIOR OF THE EXISTING PARKING GARAGE BETWEEN COLUMN LINES 11-12 AT F. CONTRACTOR WILL VERIFY TOTAL FACE BRICK UNITS AVAILABLE PRIOR TO BIDDING.

ELEVATION NOTES

- PROPOSED EXTERIOR FINISH GRADE ELEVATIONS.
- CAST IN PLACE CONCRETE FOUNDATION WALL SYSTEM. REFER TO DRAWING S-100.
- NOMINAL 4" FACE BRICK VENEER SYSTEM. REFER TO DRAWING A-302 AND A-303.
- PRECAST CONCRETE SPANDREL PANEL SYSTEM. REFER TO DRAWING A-302 AND A-303.
- ALUMINUM RAILING SYSTEM. REFER TO DRAWING A-305.
- PRECAST CONCRETE BANDING/COURSE. REFER TO DRAWING A-302 AND A-303.
- PRECAST CONCRETE COPING/CAP. REFER TO DRAWING A-302 AND A-303.
- TYPICAL EXTERIOR WALL OPENINGS AT PARKING GARAGE.
- LIGHT POLES AND FIXTURES. REFER TO DRAWING E-105.
- EXISTING FACE BRICK VENEER AT EXISTING PRECAST CONCRETE COLUMNS.
- EXISTING PRECAST CONCRETE SPANDREL PANELS.
- EXISTING ALUMINUM RAILING SYSTEM.
- PARKING GARAGE LEVEL E ADDITION ABOVE EXISTING PARKING GARAGE EXPANSION UNDER CONSTRUCTION.
- EXISTING GRADE ELEVATION.

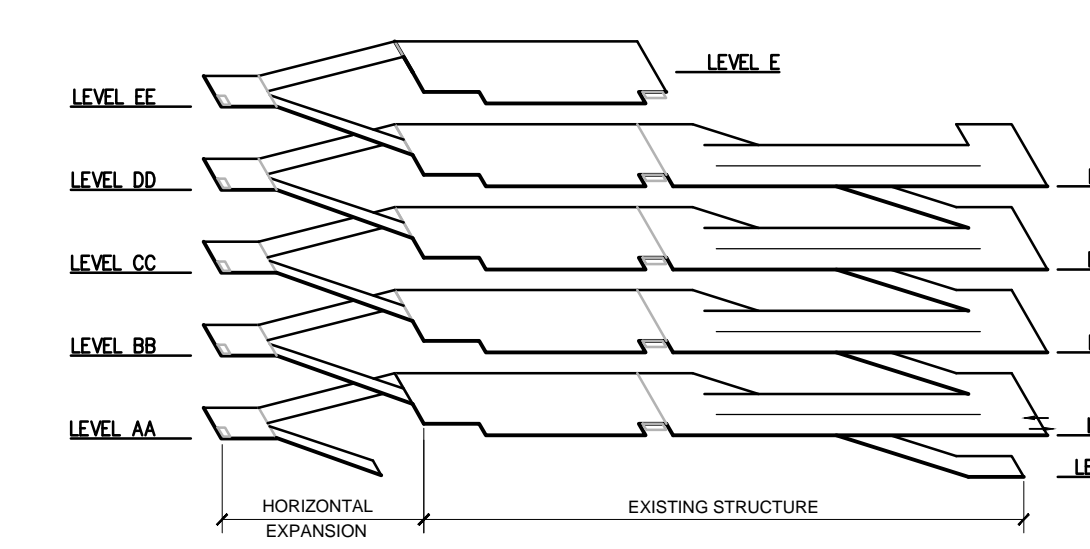

BUILDING ISOMETRIC

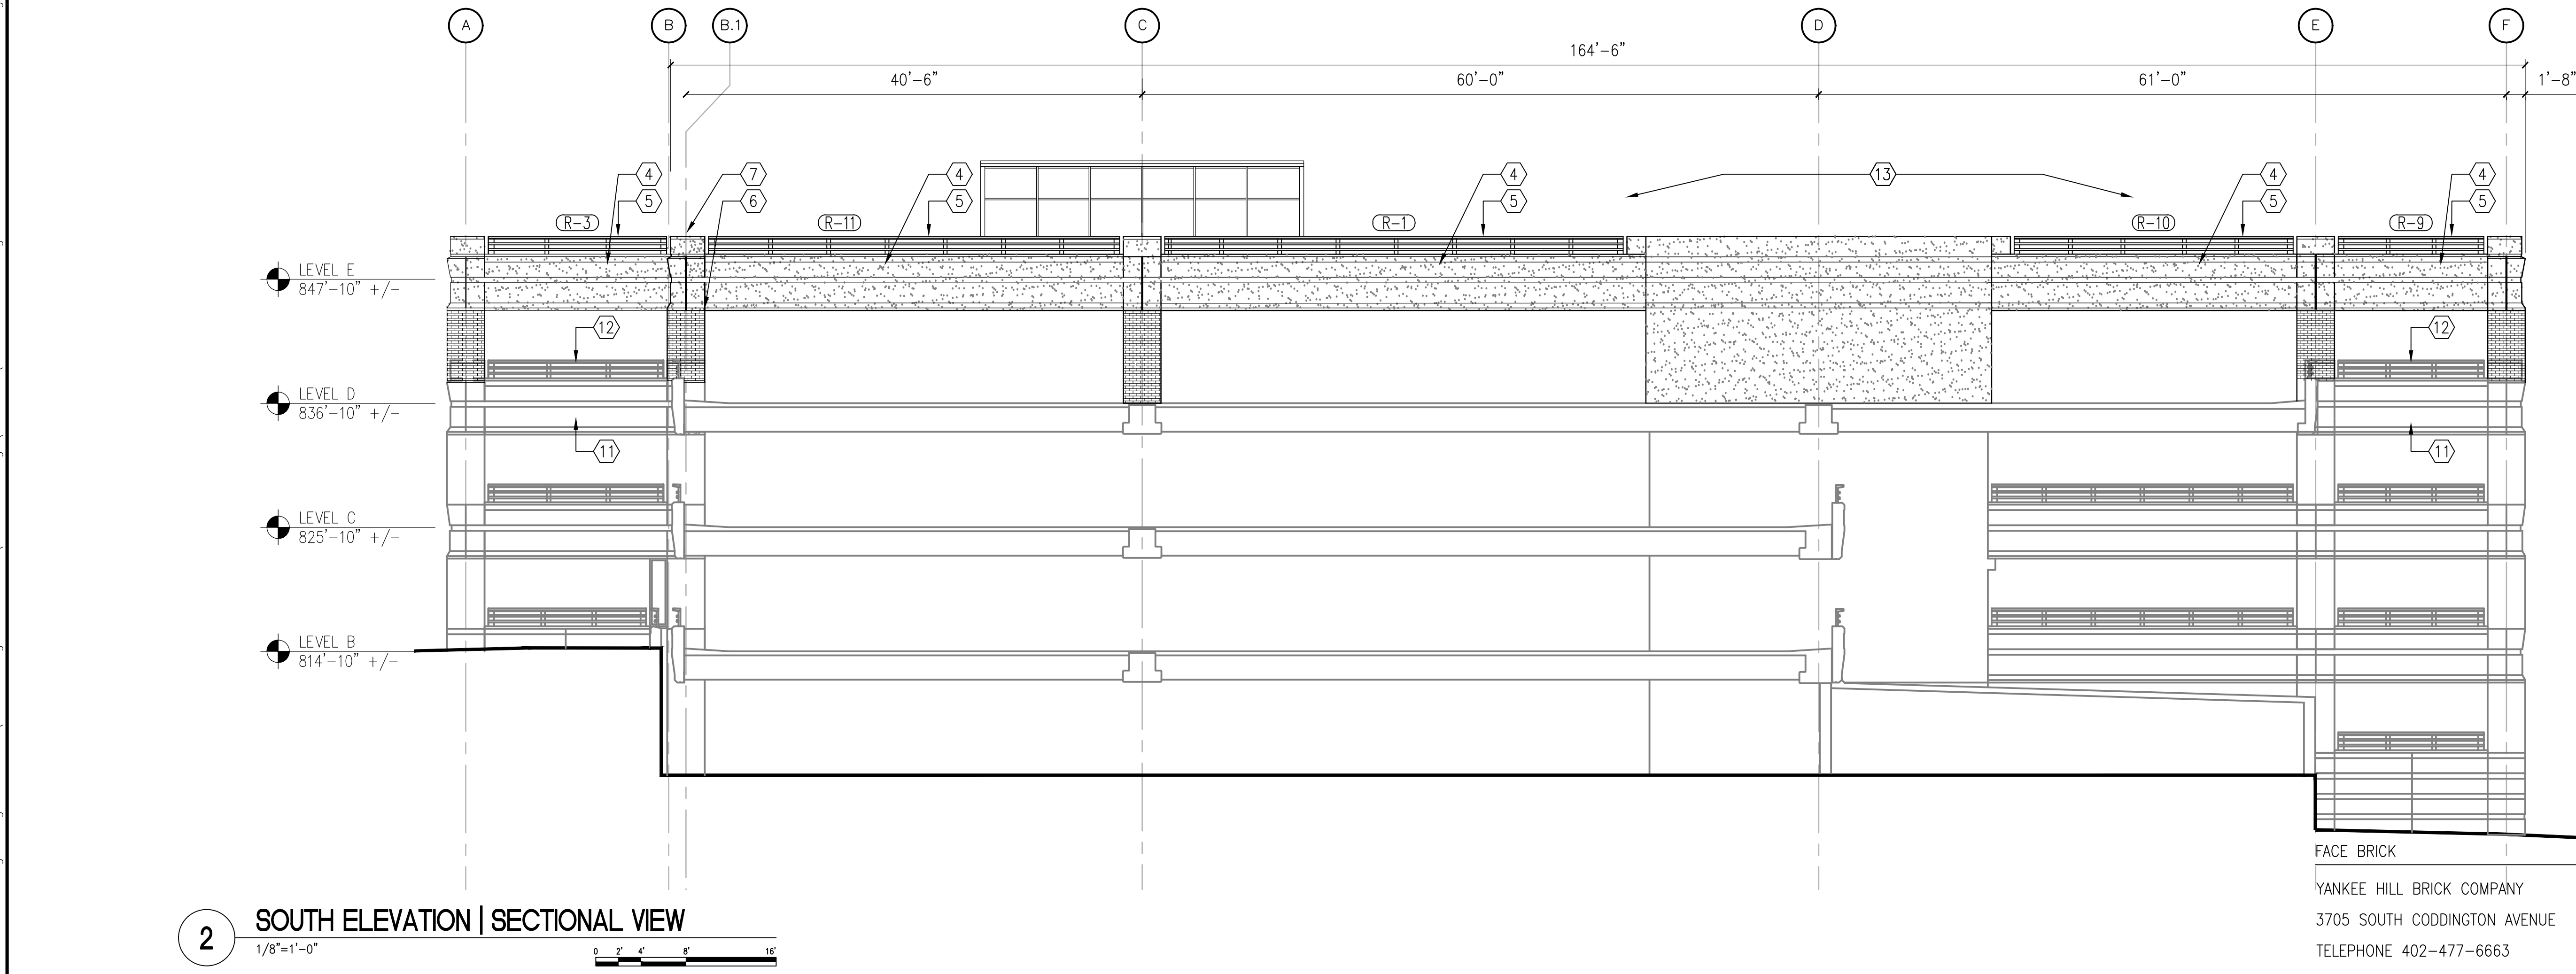

REVISION NO. 1 100% FINAL BID DOCUMENTS 100% BID DOCUMENTS-NOT FOR CONSTRUCTION 95% CONSTRUCTION DOCUMENTS SUBMISSION 65% DESIGN DEVELOPMENT SUBMISSION 35% SCHEMATIC DESIGN SUBMISSION Revisions: 02-12-2018 08-18-2017 07-24-2017 06-15-2017 04-19-2017 03-06-2017 Date	CONSULTANTS: WALKER PARKING CONSULTANTS 3815 Plaza Drive • Ann Arbor, Michigan 48108 (734) 995-0200 • www.midwesternconsulting.com Land Development • Land Survey • Institutional • Municipal Wireless Communications • Transportation • Landfill Services	KEYPLAN	ARCHITECT + ENGINEERS: BANCROFT ARCHITECTS + ENGINEERS 700 Nicholas Blvd., Suite 300 Elk Grove Village, IL 60007 Telephone : 847.952.9362 www.bancroft-ae.com Bancroft-AE Project No. 16-121 VA CONTRACT NO. VA250-17-C-0008	Drawing Title BUILDING ELEVATIONS Approved Project Director	Project Title CONSTRUCT NORTH PARKING STRUCTURE Location ANN ARBOR, MICHIGAN Date 08-18-2017 Checked EM Drawn AG	Project Number 506-331 Building Number 29 Drawing Number A-202	Office of Construction and Facilities Management Department of Veterans Affairs
---	--	----------------	---	--	---	---	---