


three inches = one foot  
one and one half inches = one foot  
one inch = one foot  
one half inch = one foot  
three quarters inch = one foot  
one half inch = one foot  
one quarter inch = one foot  
one eighth inch = one foot  
one sixteenth inch = one foot

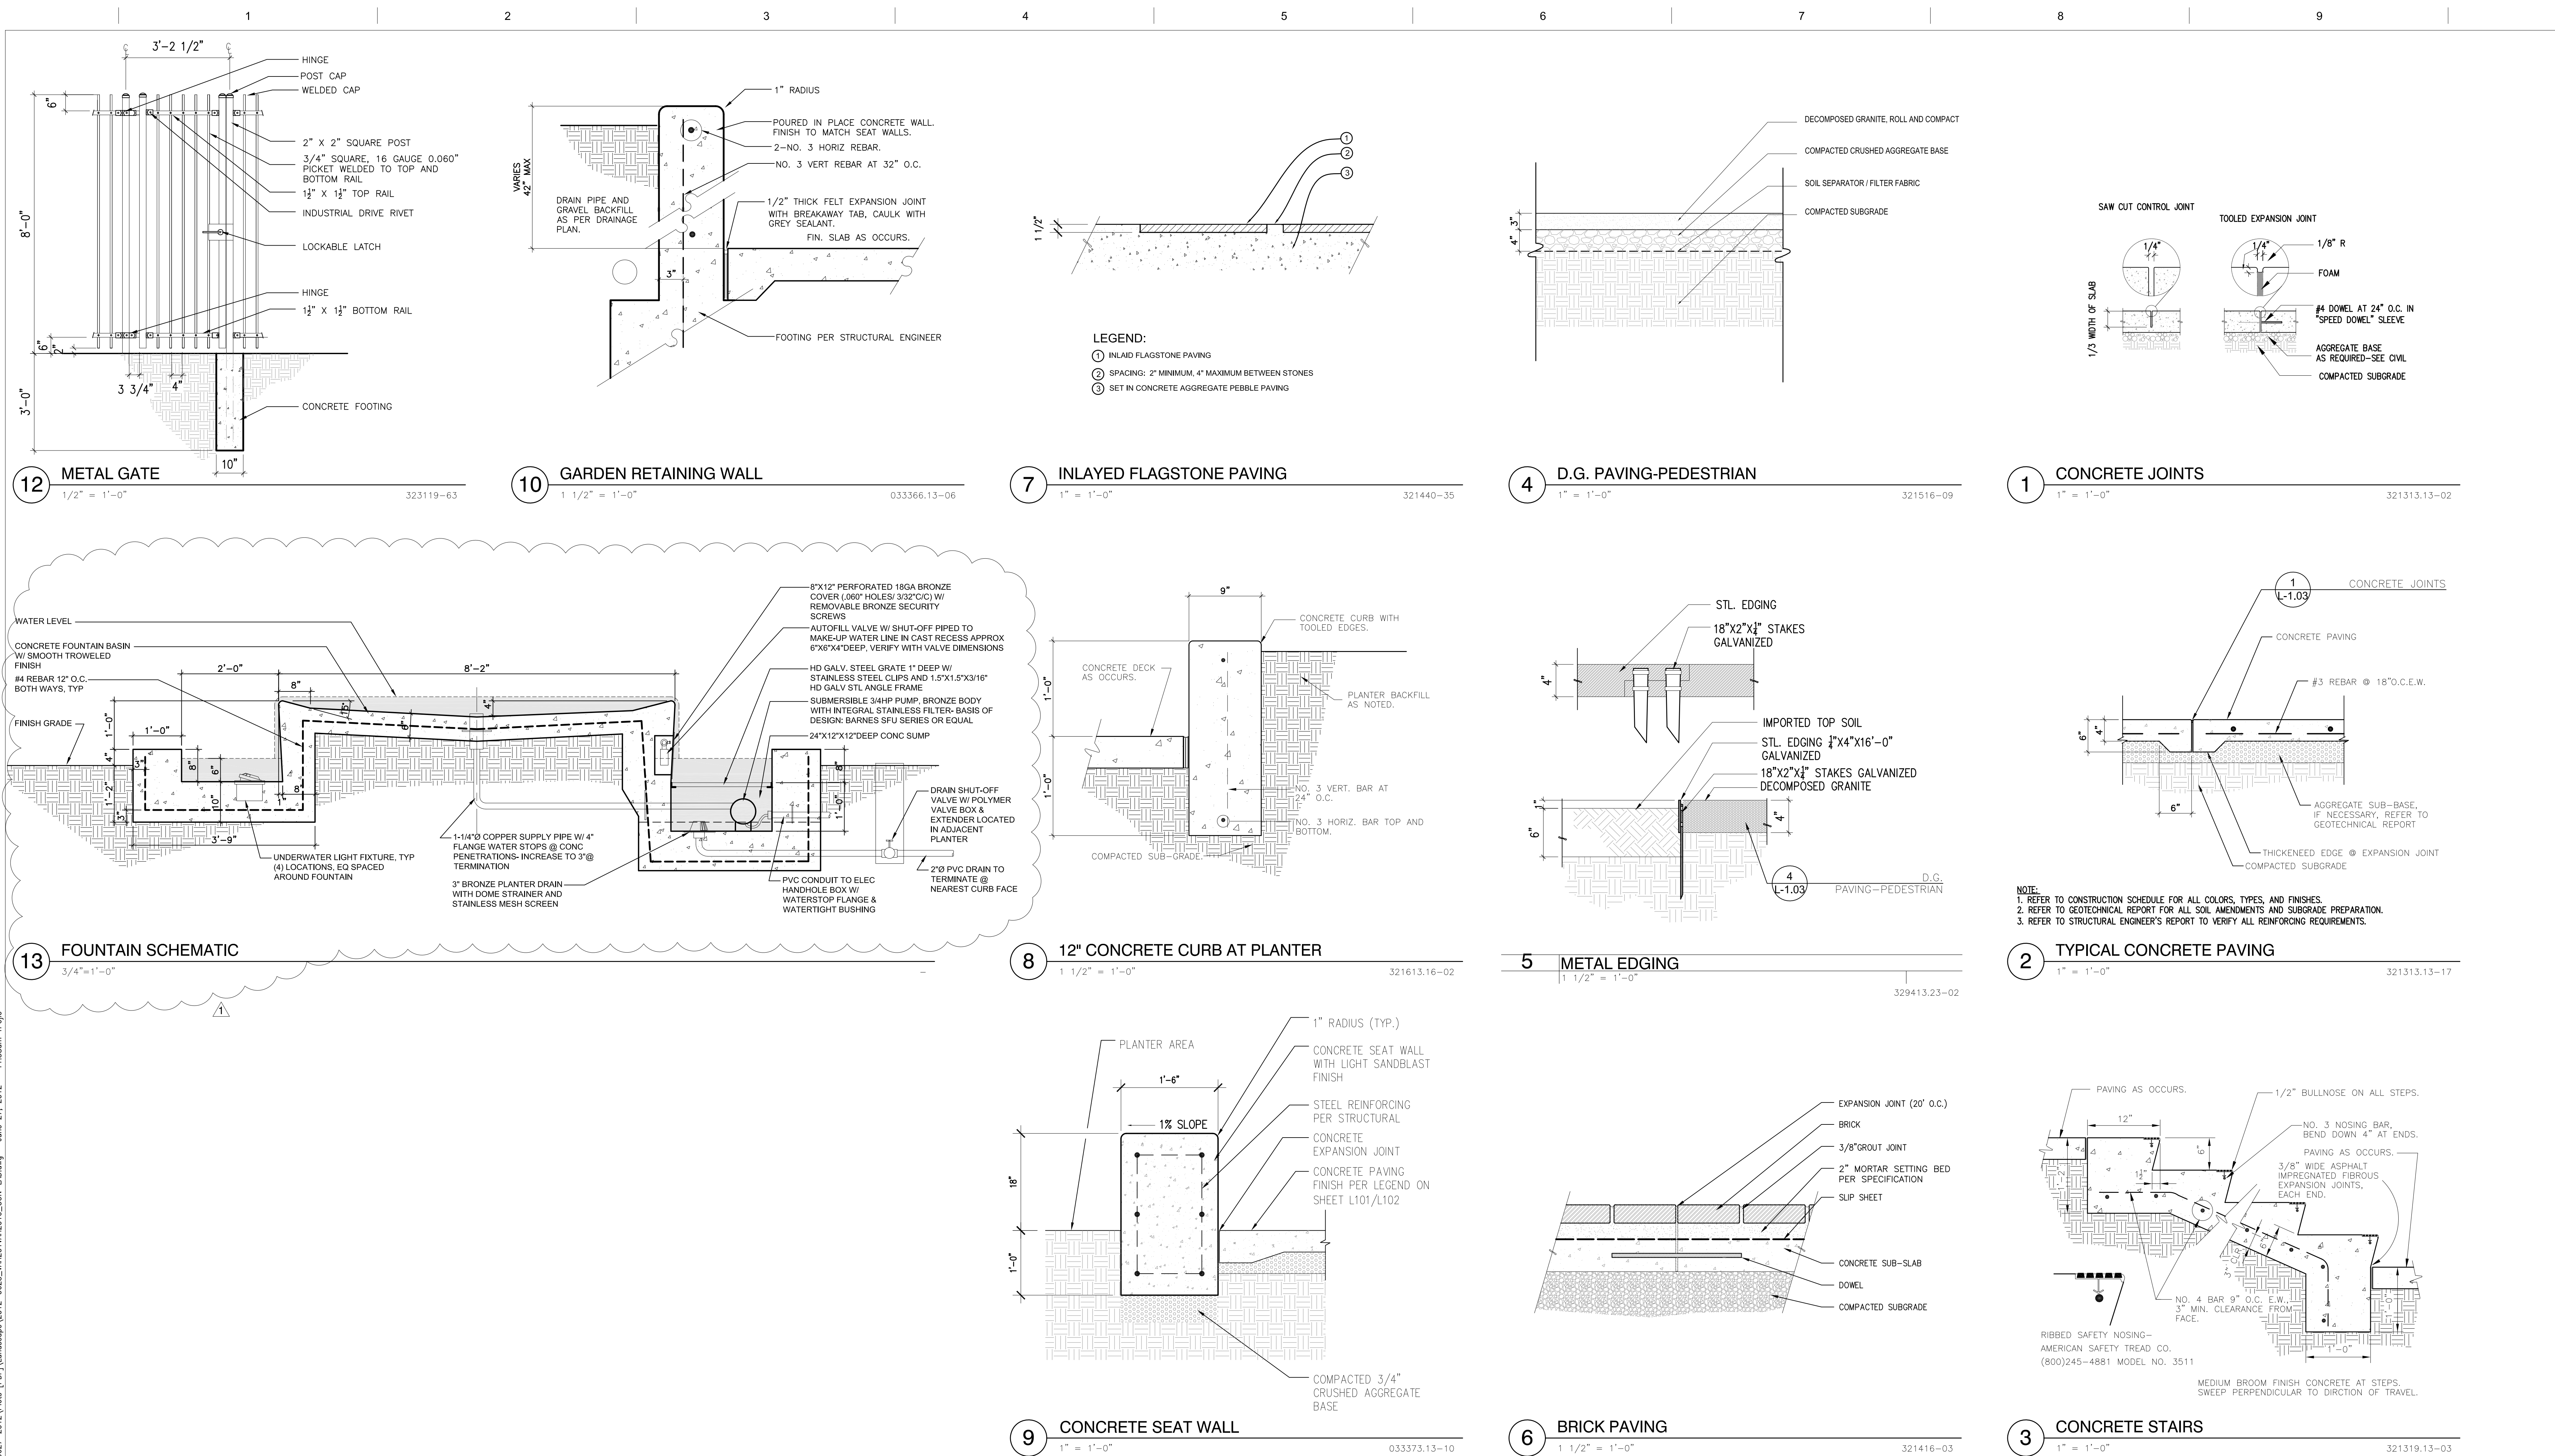

CONSULTANTS: <b>MIA LEHRER</b> + associates landscape architecture 3780 Wilshire Boulevard suite 250 Los Angeles, California 90010 tel 213/384-3844 fax 213/384-3833 e-mail office@mlagreen.com		ARCHITECT/ENGINEERS: <b>LEO A DAILY</b> 27th Floor, 550 South Hope Street Los Angeles, CA 90071 USA Tel 213-629-0100 Fax 213-629-0070		Drawing Title <b>CONSTRUCTION DETAILS</b> -	Project Title <b>VA GLA HEALTHCARE SYSTEM WEST LA MEDICAL CENTER SEISMIC CORRECTIONS</b>	Project Number <b>691-406</b>	Office of Construction and Facilities Management	
ADDENDUM NO. 1 FOR CONSTRUCTION Revisions: 07/23/12 05/04/12 Date		Approved: Project Director		Location <b>LOS ANGELES, CA 90073</b>	Building Number <b>209</b>	Drawing Number <b>L-1.03</b> Dwg. -- of SHTS		
VA FORM 08-6231		Date		Date 05/04/12	Checked JH	Drawn TP	Department of Veterans Affairs	

FULLY SPRINKLERED