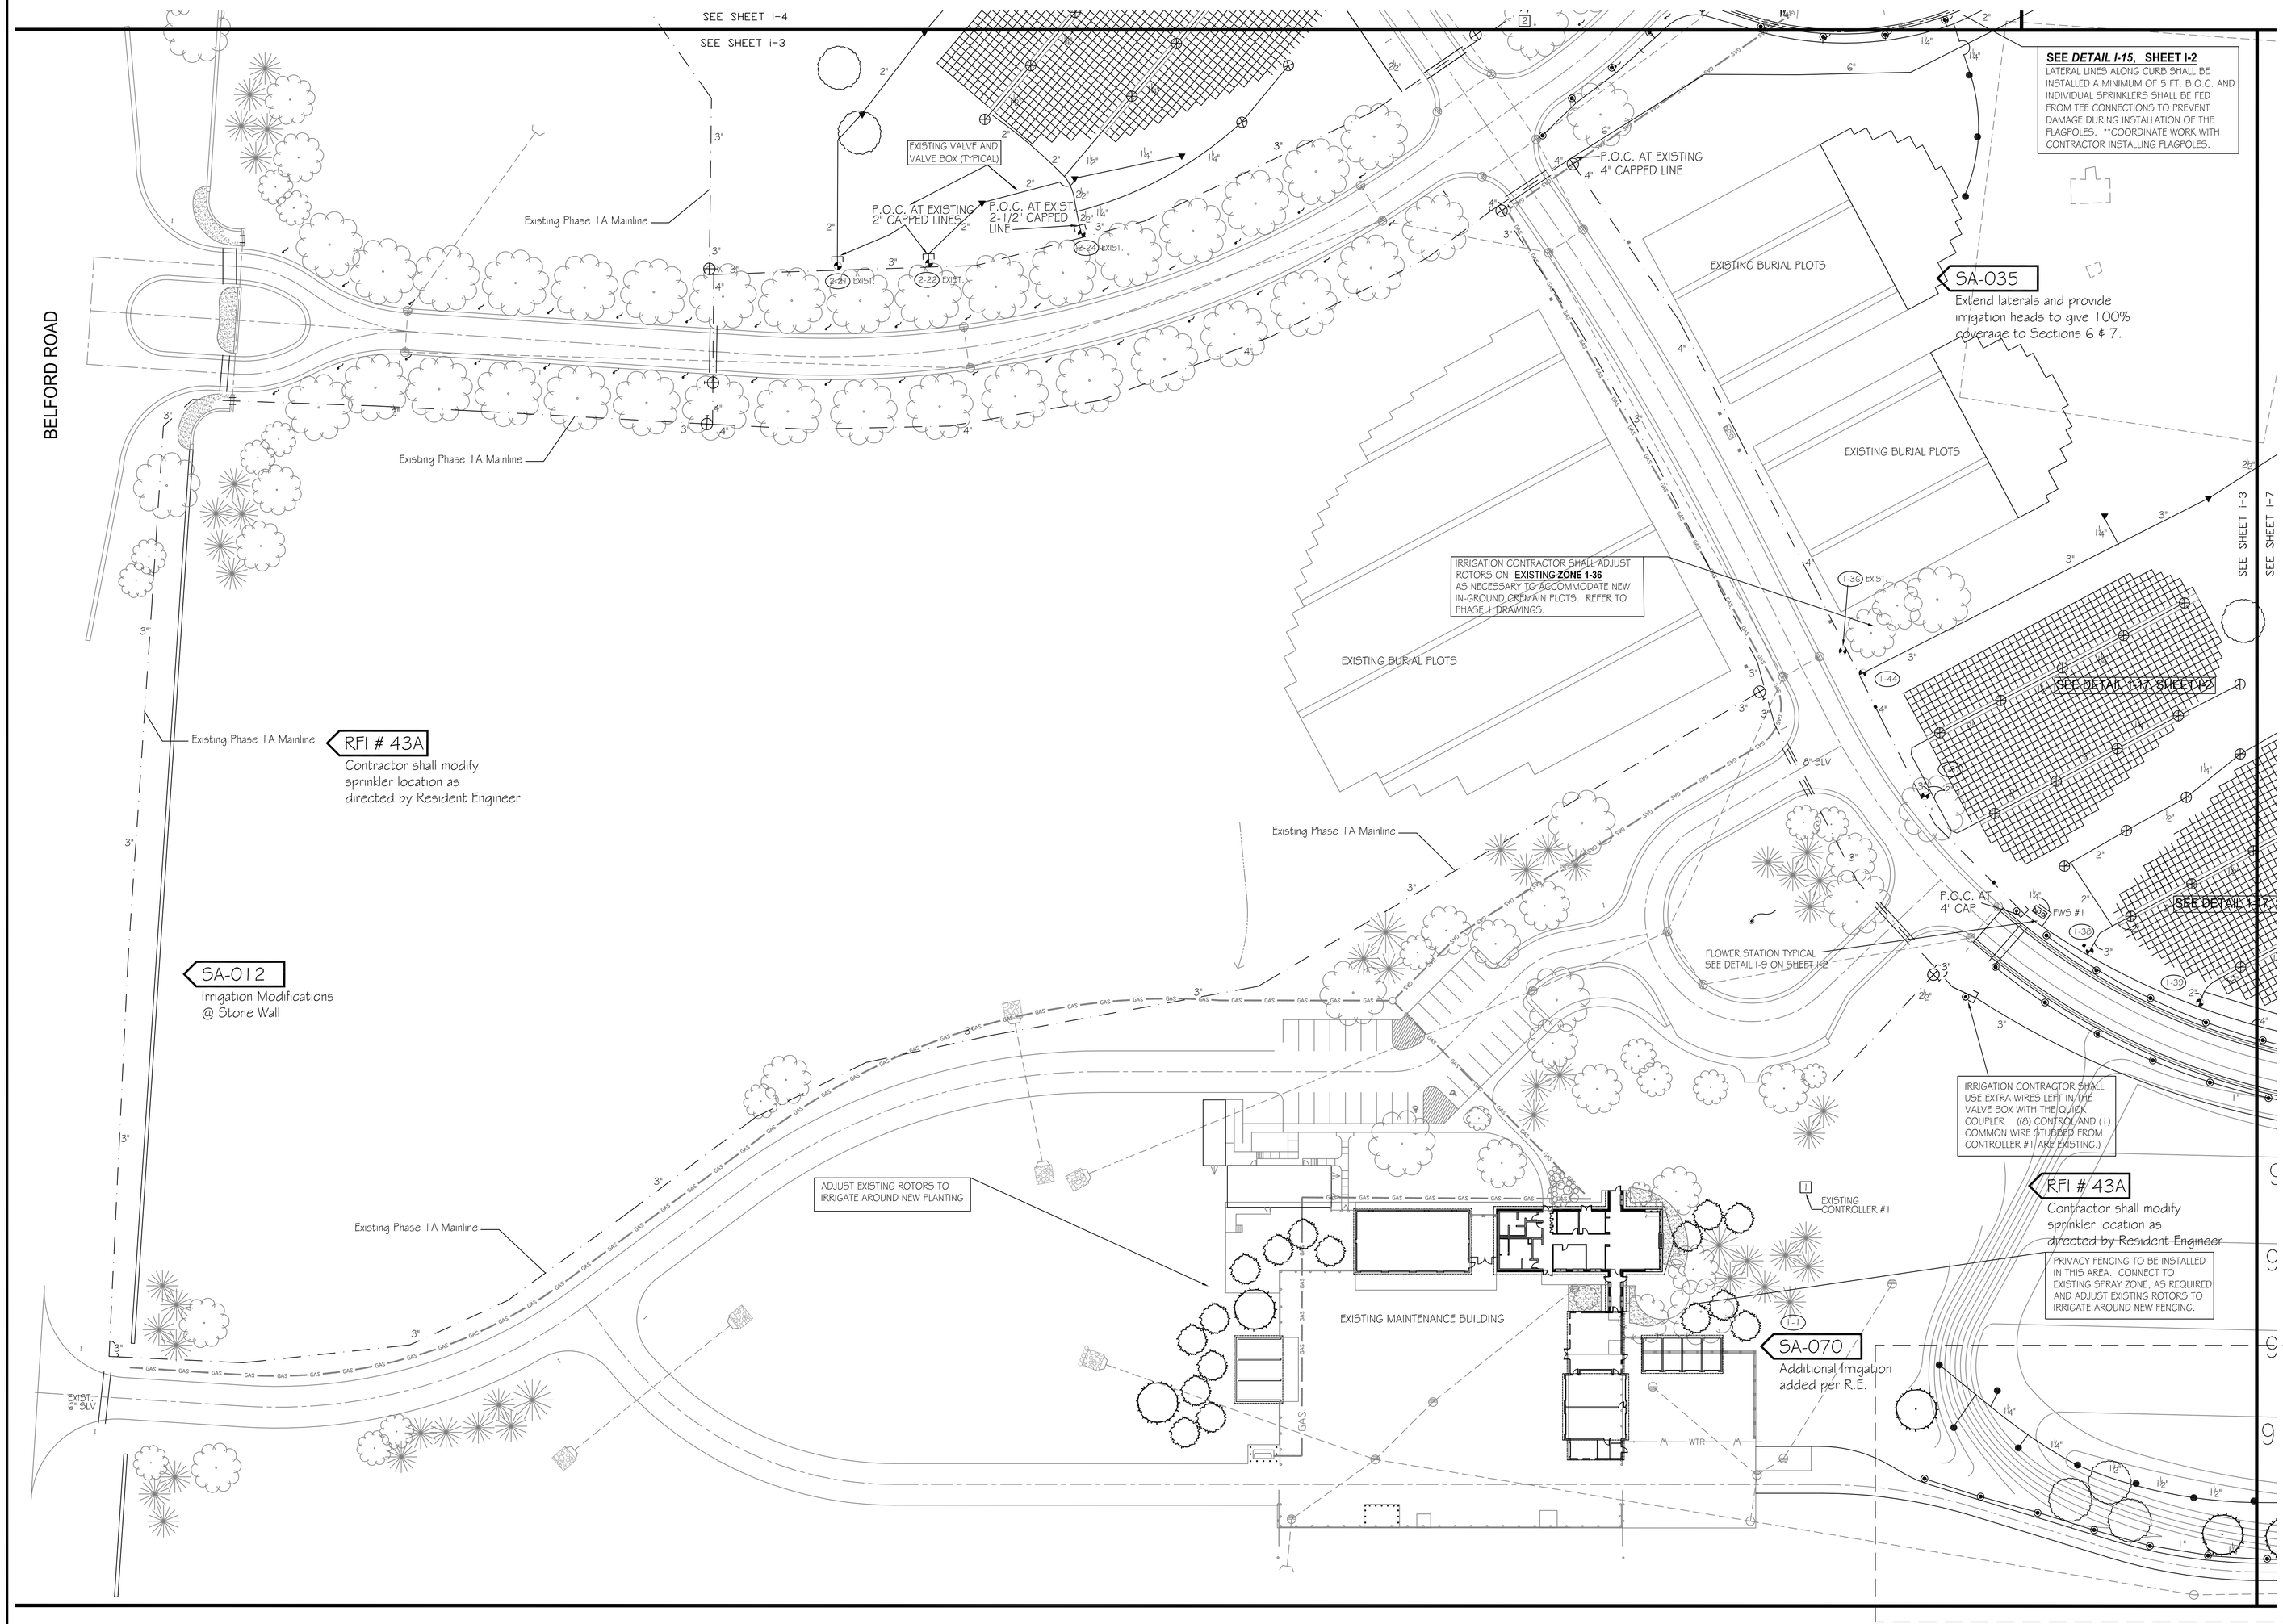

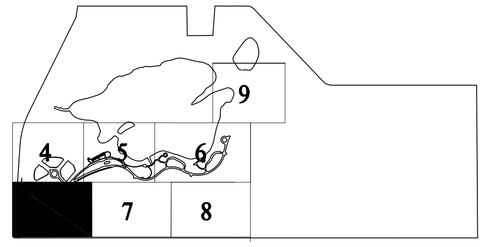

KEY MAP
(NOT TO SCALE)

NORTH

GRAPHIC SCALE
40' 0' 20' 40'

ALSO SEE CONTRACTOR PROVIDED AS-BUILT DRAWINGS

RECORD DRAWINGS	07/08/2011
Revisions:	Date

AS-BUILT NOTE:
THE INFORMATION REPRESENTED ON THIS PLAN/DETAIL SHEET IS FROM CONTRACTOR'S, RESIDENT ENGINEER'S AS-BUILT PROVIDED INFORMATION ALONG WITH COMPILED INFORMATION FROM A/E SITE VISIT REPORTS, PHOTOGRAPHS AND INFORMATION AND IS IS NOT DEEMED TO BE ACCURATE NOR COMPLETE BUT AN ASSUMED CONSTRUCTED CONDITION AT THE SITE. SEE CONTRACTOR PROVIDED AS-BUILT DRAWINGS FOR ADDITIONAL INFORMATION.

CONSULTANTS:

the LA group
Landscape Architecture and Engineering, P.C.
40 Long Alley
Saratoga Springs, NY 12866
518/587-8100
Telefax 518/587-0180

ARCHITECT/ENGINEERS:

URS
SOUTHFIELD, MI. 48034
27777 FRANKLIN RD. SUITE 2000
PH. 248-204-5900
TELEFAX 248-204-5901

Drawing Title: IRRIGATION PLAN AREA - 3

Approved: David C. Starkie, Acting NCA Team Leader

Contracted By: Kevin W. Dix, NCA Project Manager

Project Title: GREAT LAKES NATIONAL CEMETERY PHASE 1B EXPANSION

Location: HOLLY, MICHIGAN

Date: FEB. 29, 2008 | Checked: GMB | Drawn: LRC

Project Number: 923CM2003

Building Number:

Drawing Number: I-3

Dwg. 85 of 173

Office of Construction and Facilities Management

Department of Veterans Affairs

RECORD DRAWINGS

VA FORM 08-6231, OCT 1978