

The SOT coverage area is highlighted in yellow.
 The SOT data sheets are highlighted in pink.

SOT Prep

Room # 26100
 Data sheet # 7-2-1

SOT
 Courtyard

Room # 26100
 Data sheet # 7-2-2

SOT Hospitals

SOT
 Training
 Apartment

Room # 26100
 Data sheet # 7-2-3

SOT
 Outpatient
 Pharmacy


SOT Outpatient
 Clinic

OVERALL SECOND FLOOR PLAN
 Scale: 1/8" = 1'-0"

SOT 2nd Floor



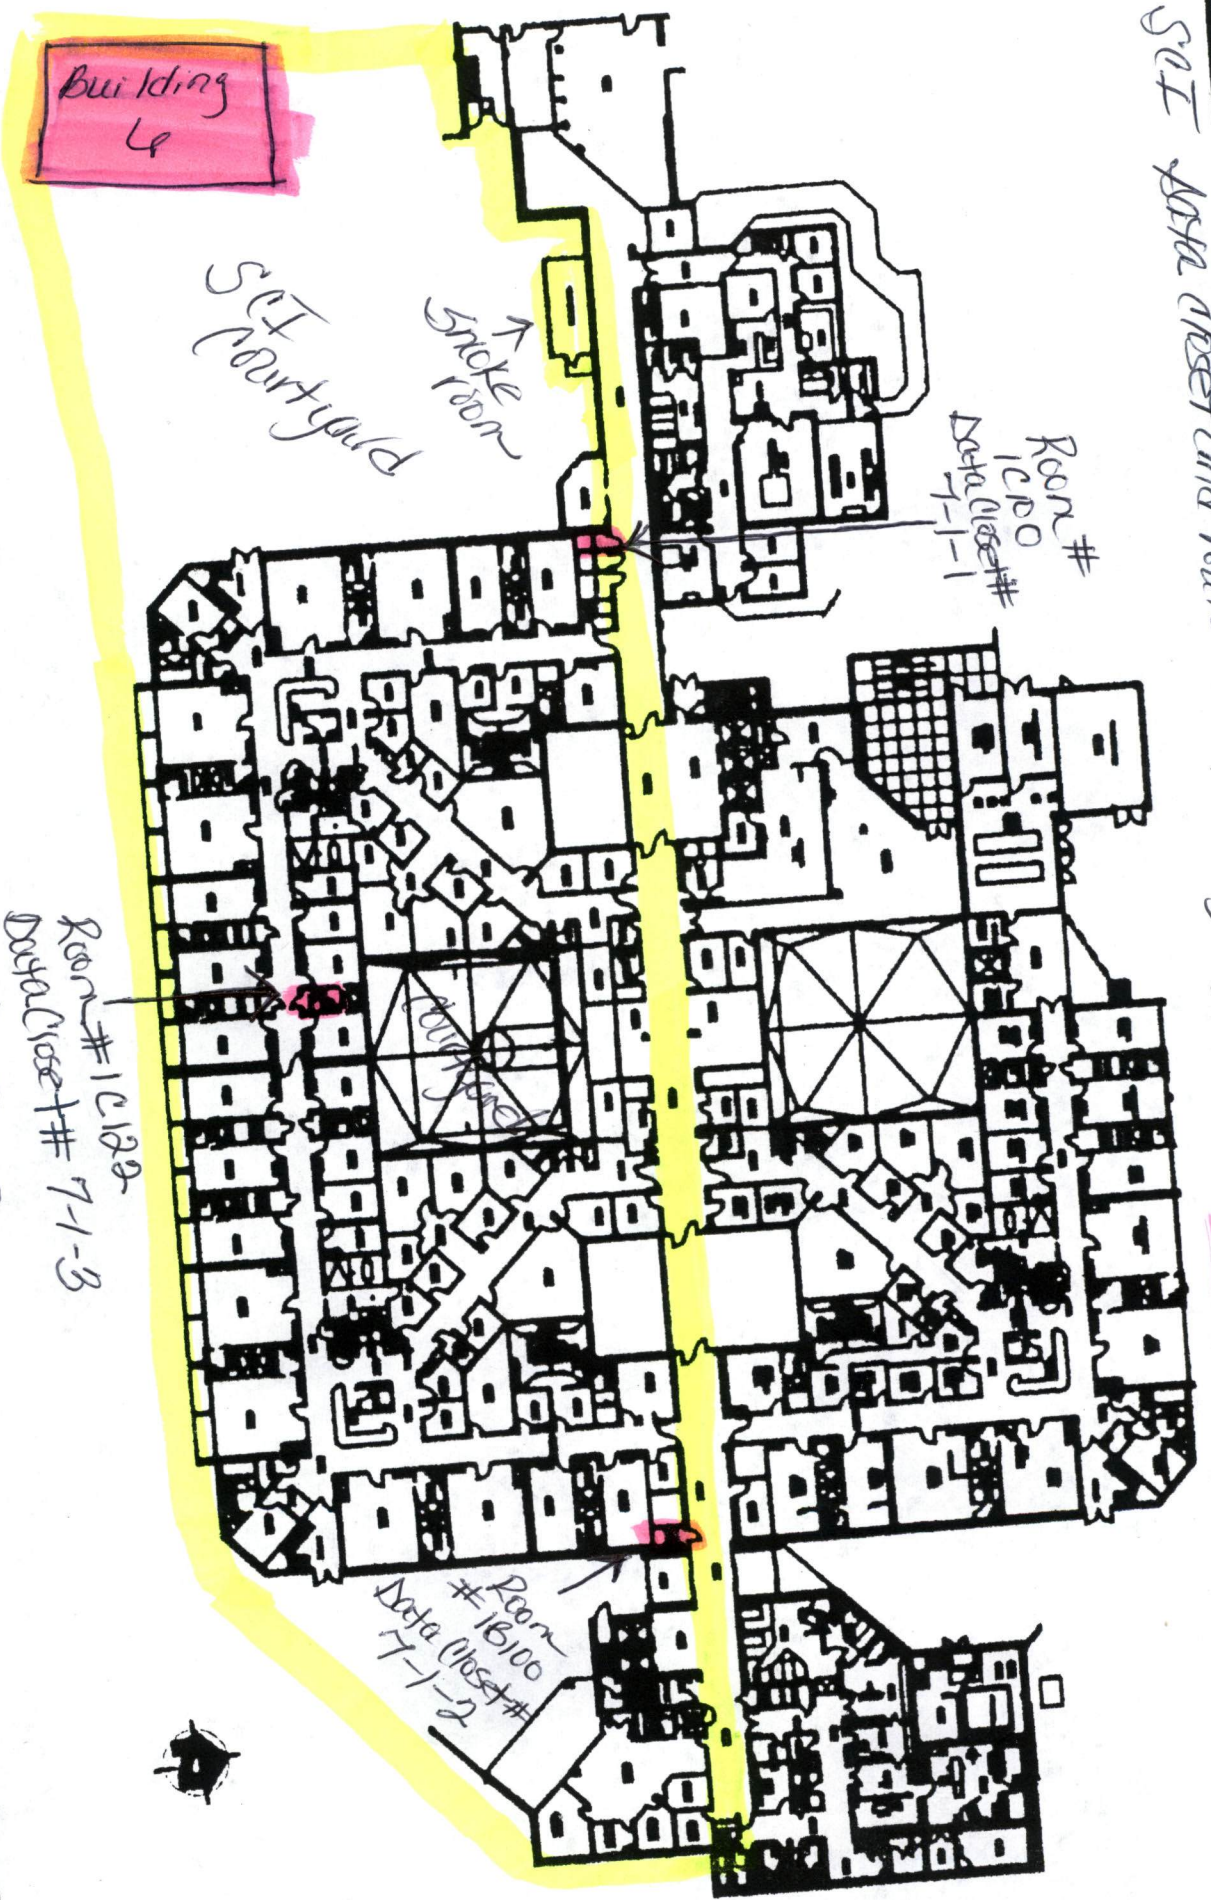

GENERAL NOTE: ROOM FLOOR PLAN

SAI 1st Floor


