
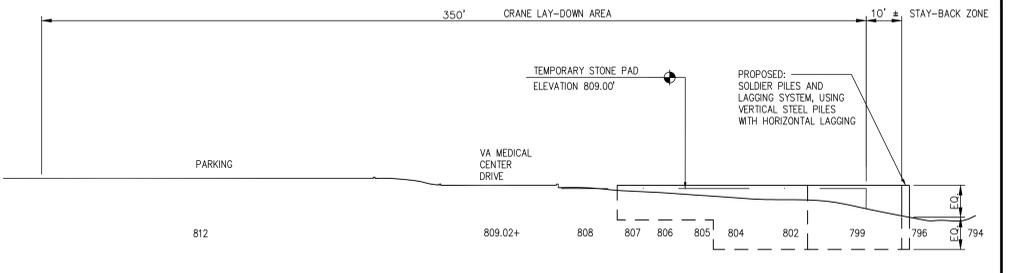


three inches = one foot
 one and one half inches = one foot
 one inch = one foot
 three quarters inch = one foot
 one half inch = one foot
 three eighths inch = one foot
 one quarter inch = one foot
 one eighth inch = one foot

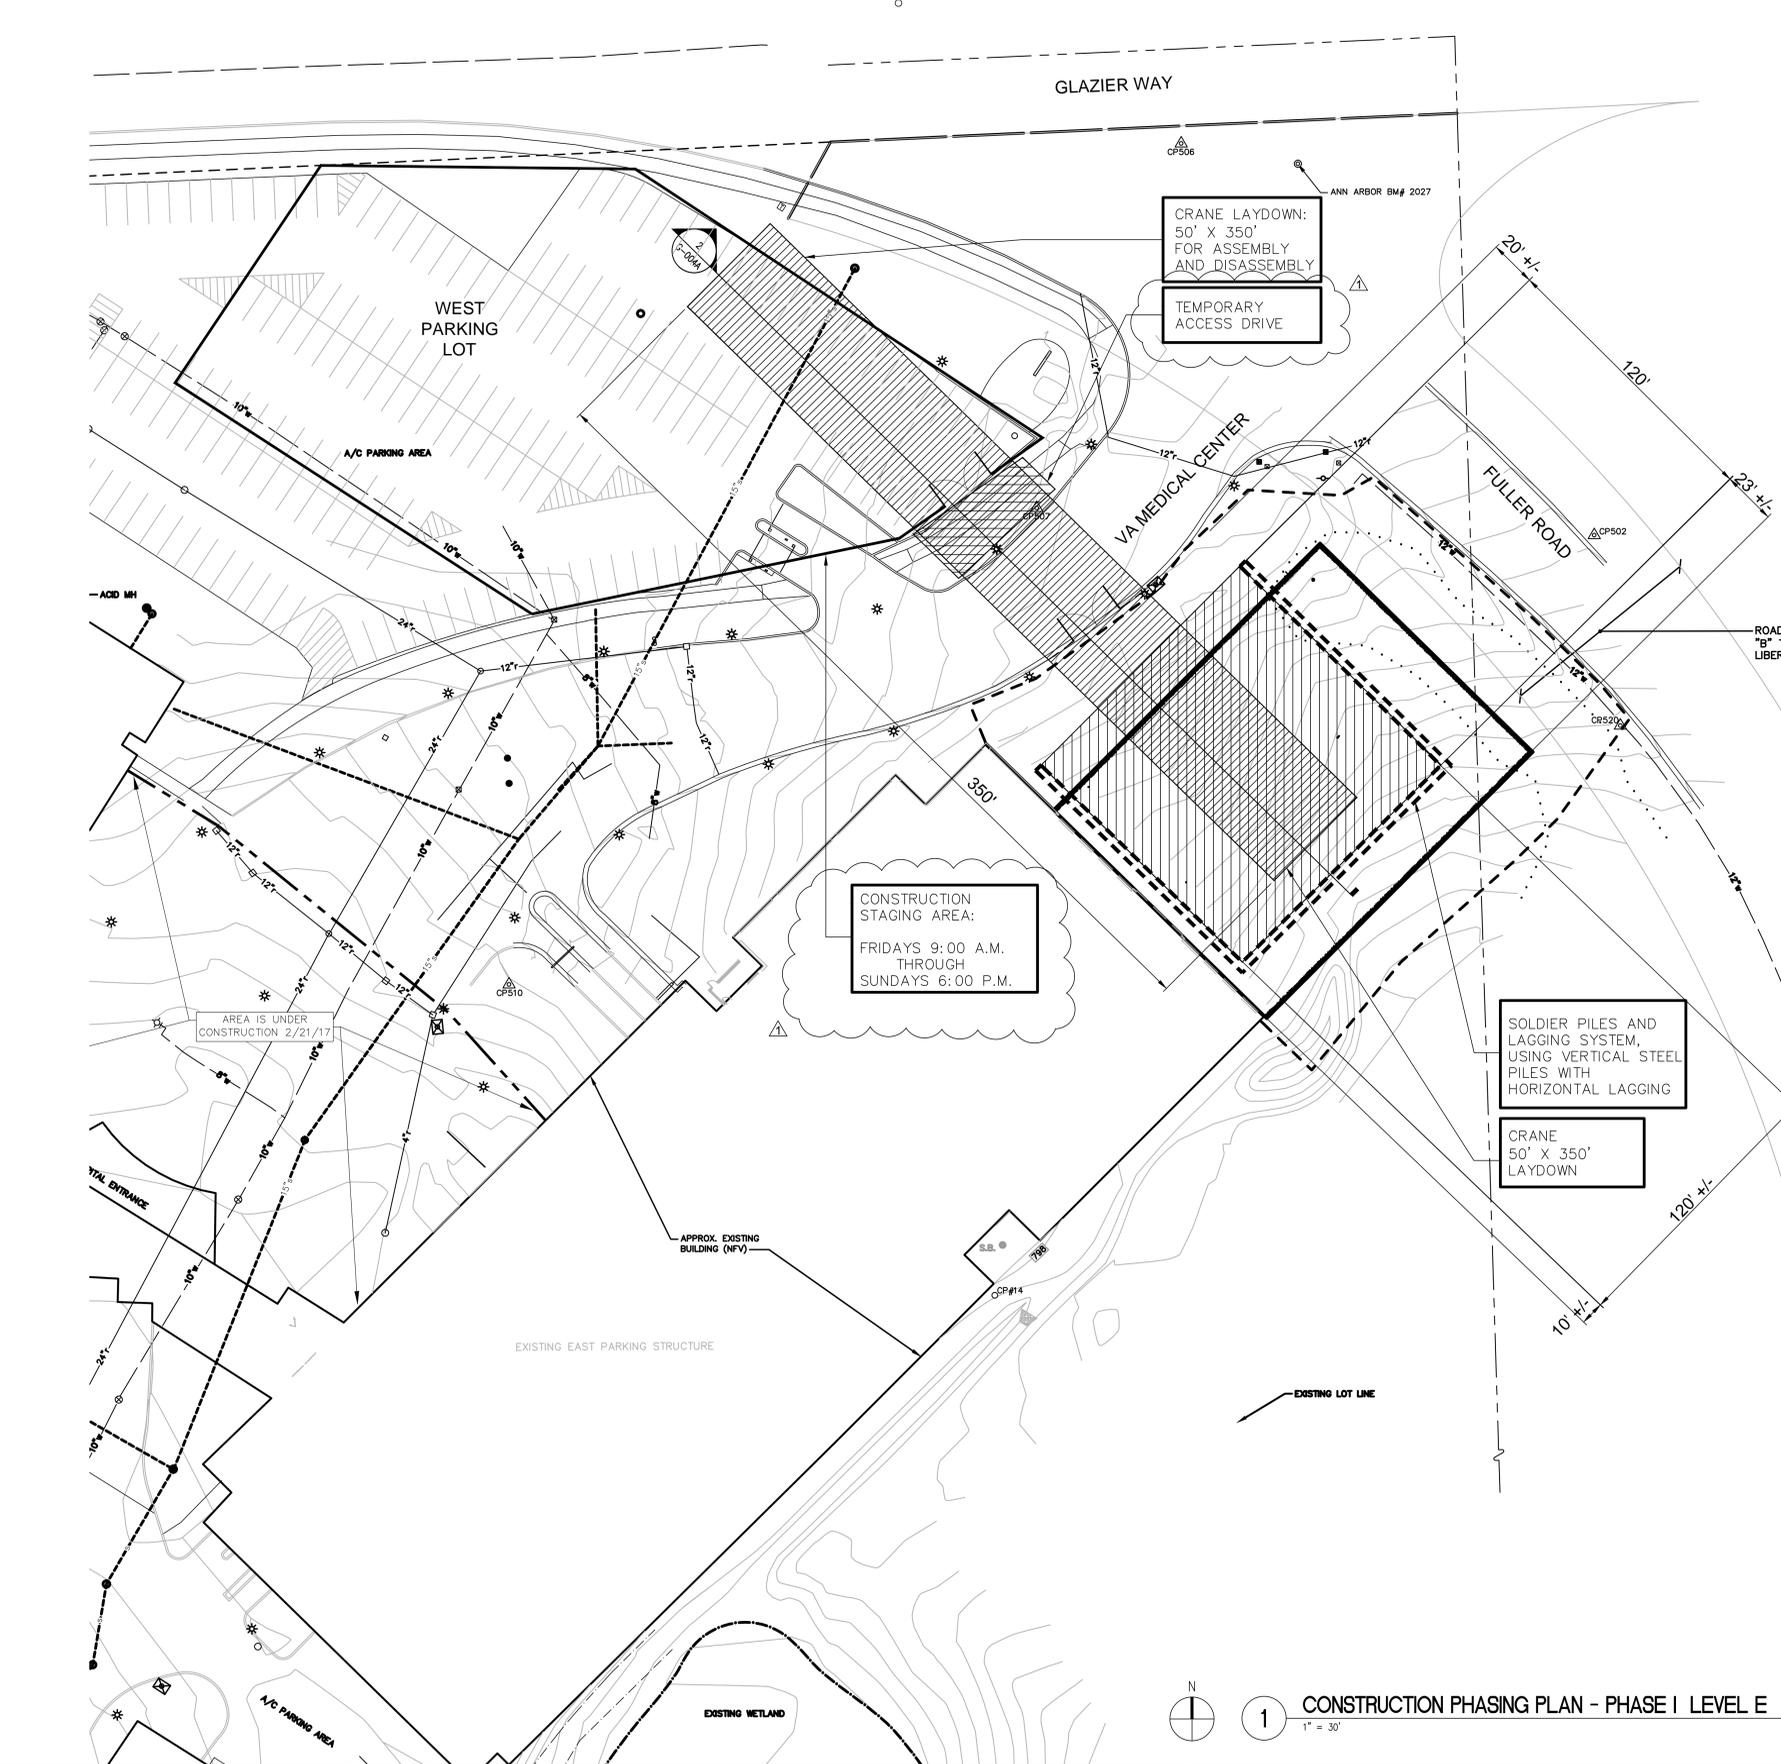

2 SECTIONAL VIEW THROUGH CRANE
 1" = 30'

- ### SITE STAGING NOTES
- CONTRACTOR WILL PROVIDE TEMPORARY ACCESS DRIVE AT AREA INDICATED. EXCAVATE AND REMOVE TOP SOIL AND EXISTING CONCRETE WALK. TEMPORARY ACCESS DRIVE WILL BE A MINIMUM OF 18-INCHES COMPACTED GRANULAR FILL.
 - CONTRACTOR WILL SCHEDULE TRANSPORTATION OF OVERSIZED PRECAST CONCRETE COMPONENTS FOR FRIDAY DELIVERY.
 - EXISTING WEST PARKING LOT WILL BE AVAILABLE FROM FRIDAY 10:00 AM THROUGH SUNDAY 6:00 PM.
 - TRAILERS WITH OVERSIZED LOADS WILL BE STAGED WITHIN THE LIMITS OF TEMPORARY CONSTRUCTION STAGING AREA AT THE EXISTING WEST PARKING LOT.
 - CONTRACTOR WILL PROVIDE TEMPORARY BARRIER FOR THIS CONSTRUCTION STAGING AREA FROM FRIDAY 9:00 AM THROUGH SUNDAY 6:00 PM.
 - TEMPORARY BARRIER AROUND STAGING AREA LOCATED IN EXISTING WEST PARKING LOT WILL BE FREE STANDING 48-INCH HIGH PORTABLE BOLLARDS FILLED WITH SAND. SPACING OF PORTABLE BOLLARDS WILL BE APPROXIMATELY 15 FEET ON CENTER. PROVIDE YELLOW CAUTION TAPE ATTACHED TO EACH POST.
 - ALL TEMPORARY BARRIERS WILL BE REMOVED BY SUNDAY 6:00 PM.

- ### GENERAL NOTES
- PHASE 1 CONSTRUCTION ACTIVITIES ARE FOR PARKING GARAGE STRUCTURE LEVEL E.
 - VA MEDICAL CENTER MAIN DRIVE WILL REMAIN OPEN FOR PUBLIC ACCESS FROM MONDAY 12:01 AM THROUGH FRIDAY 11:59 PM.
 - VA MEDICAL CENTER MAIN DRIVE WILL BE AVAILABLE FOR CONSTRUCTION ACTIVITIES FROM SATURDAY 6:00 AM THROUGH SUNDAY 11:59 PM.
 - CONTRACTOR WILL PROVIDE WRITTEN NOTIFICATION TO THE VA FOR WEEKEND WORK TWO WEEKS PRIOR TO START DATE.
 - CONTRACTOR WILL CLEAN VA MEDICAL CENTER MAIN DRIVE OF ALL CONSTRUCTION DEBRIS AT COMPLETION OF EVERY WEEKEND WORK PHASE.
 - LEVEL E CONSTRUCTION ACTIVITIES WILL BE COMPLETED DURING WEEKEND HOURS OF OPERATIONS. NO WORK AT LEVEL E WILL BE PERMITTED DURING NORMAL BUSINESS HOURS. NORMAL BUSINESS HOURS ARE MONDAY 12:01 AM THROUGH FRIDAY 11:59 PM.
 - ACTIVITIES RELATED TO VERIFICATION OF EXISTING CONSTRUCTION ELEMENTS WILL BE COMPLETED DURING THE WEEKEND HOURS OF OPERATIONS LISTED ABOVE.

- ### PHASING PLAN NOTES
- PHASE I CONSTRUCTION IS ASSOCIATED WITH THE CONSTRUCTION OF THE PARKING GARAGE STRUCTURE ABOVE EXISTING LEVEL D. REFER TO ALL DRAWINGS AND SPECIFICATIONS FOR ADDITIONAL INFORMATION.
 - REFER TO CIVIL DRAWINGS FOR EXISTING GRADE ELEVATIONS.
 - REFER TO SPECIFICATIONS APPENDIX A FOR GEOTECHNICAL EVALUATION REPORT AND RELATED SOIL BORING LOG.
 - CONTRACTOR WILL BE RESPONSIBLE FOR ALL DEWATERING DURING CONSTRUCTION PHASING AND OPERATIONS.
 - CONTRACTOR WILL PROVIDE THE DESIGN, ENGINEERING AND INSTALLATION OF THE TEMPORARY CRANE PAD AND SOLDIER PILE AND LAGGER SYSTEM. REFER TO SPECIFICATION SECTION 31 66 16.53 SOLDIER PILE-LAGGER WALLS FOR ADDITIONAL INFORMATION.
 - CONTRACTOR WILL PROVIDE TEMPORARY SOLDIER PILE AND LAGGER WALL SYSTEM.
 - AT COMPLETION OF ERECTION ACTIVITIES OF PARKING DECK LEVEL E CONTRACTOR WILL REMOVE CRANE PAD AND TEMPORARY SOLDIER PILE AND LAGGER WALL SYSTEM.
 - CONTRACTOR WILL RESTORE EXISTING LANDSCAPING AT EXISTING WEST PARKING LOT. CONTRACTOR WILL REINSTALL STREET LIGHT POLE AND FIXTURES.

REVISION	DATE
100% FINAL BID DOCUMENTS	02-27-2018
100% BID DOCUMENTS-NOT FOR CONSTRUCTION	08-18-2017
95% CONSTRUCTION DOCUMENTS SUBMISSION	07-24-2017
65% DESIGN DEVELOPMENT SUBMISSION	06-15-2017
35% SCHEMATIC DESIGN SUBMISSION	04-19-2017
	03-06-2017

CONSULTANTS:

WALKER PARKING CONSULTANTS

MIDWESTERN CONSULTING
 3815 Plaza Drive Ann Arbor, Michigan 48108
 (734) 995-0200 • www.midwesternconsulting.com
 Land Development • Land Survey • Institutional • Municipal
 Wireless Communications • Transportation • Landfill Services

KEYPLAN

ARCHITECT + ENGINEERS:

Bancroft Architects + Engineers
 700 Nicholas Blvd., Suite 300
 Elk Grove Village, IL 60007
 Telephone: 847.952.9362
 www.bancroft-ae.com
 Bancroft-AE Project No. 16-121
 VA CONTRACT NO. VA250-17-C-0008

Drawing Title
 CONSTRUCTION PHASING PLAN - PHASE I LEVEL E

Approved Project Director

Project Title
 CONSTRUCT NORTH PARKING STRUCTURE

Project Number
 506-331
Building Number
 29

Location
 ANN ARBOR, MICHIGAN

Date
 08-18-2017

Checked
 EM

Drawn
 AG

Drawing Number
 G-004A

Office of Construction and Facilities Management

Department of Veterans Affairs