


Mechanical Room 2D, B1 F2 - Locations of Missing/Damaged Fireproofing Material

The shaded areas represent the locations of missing or damaged fireproofing material.

Dimensions of the entire mechanical room can be referenced from "Title Block B1 F2 Entire Room".

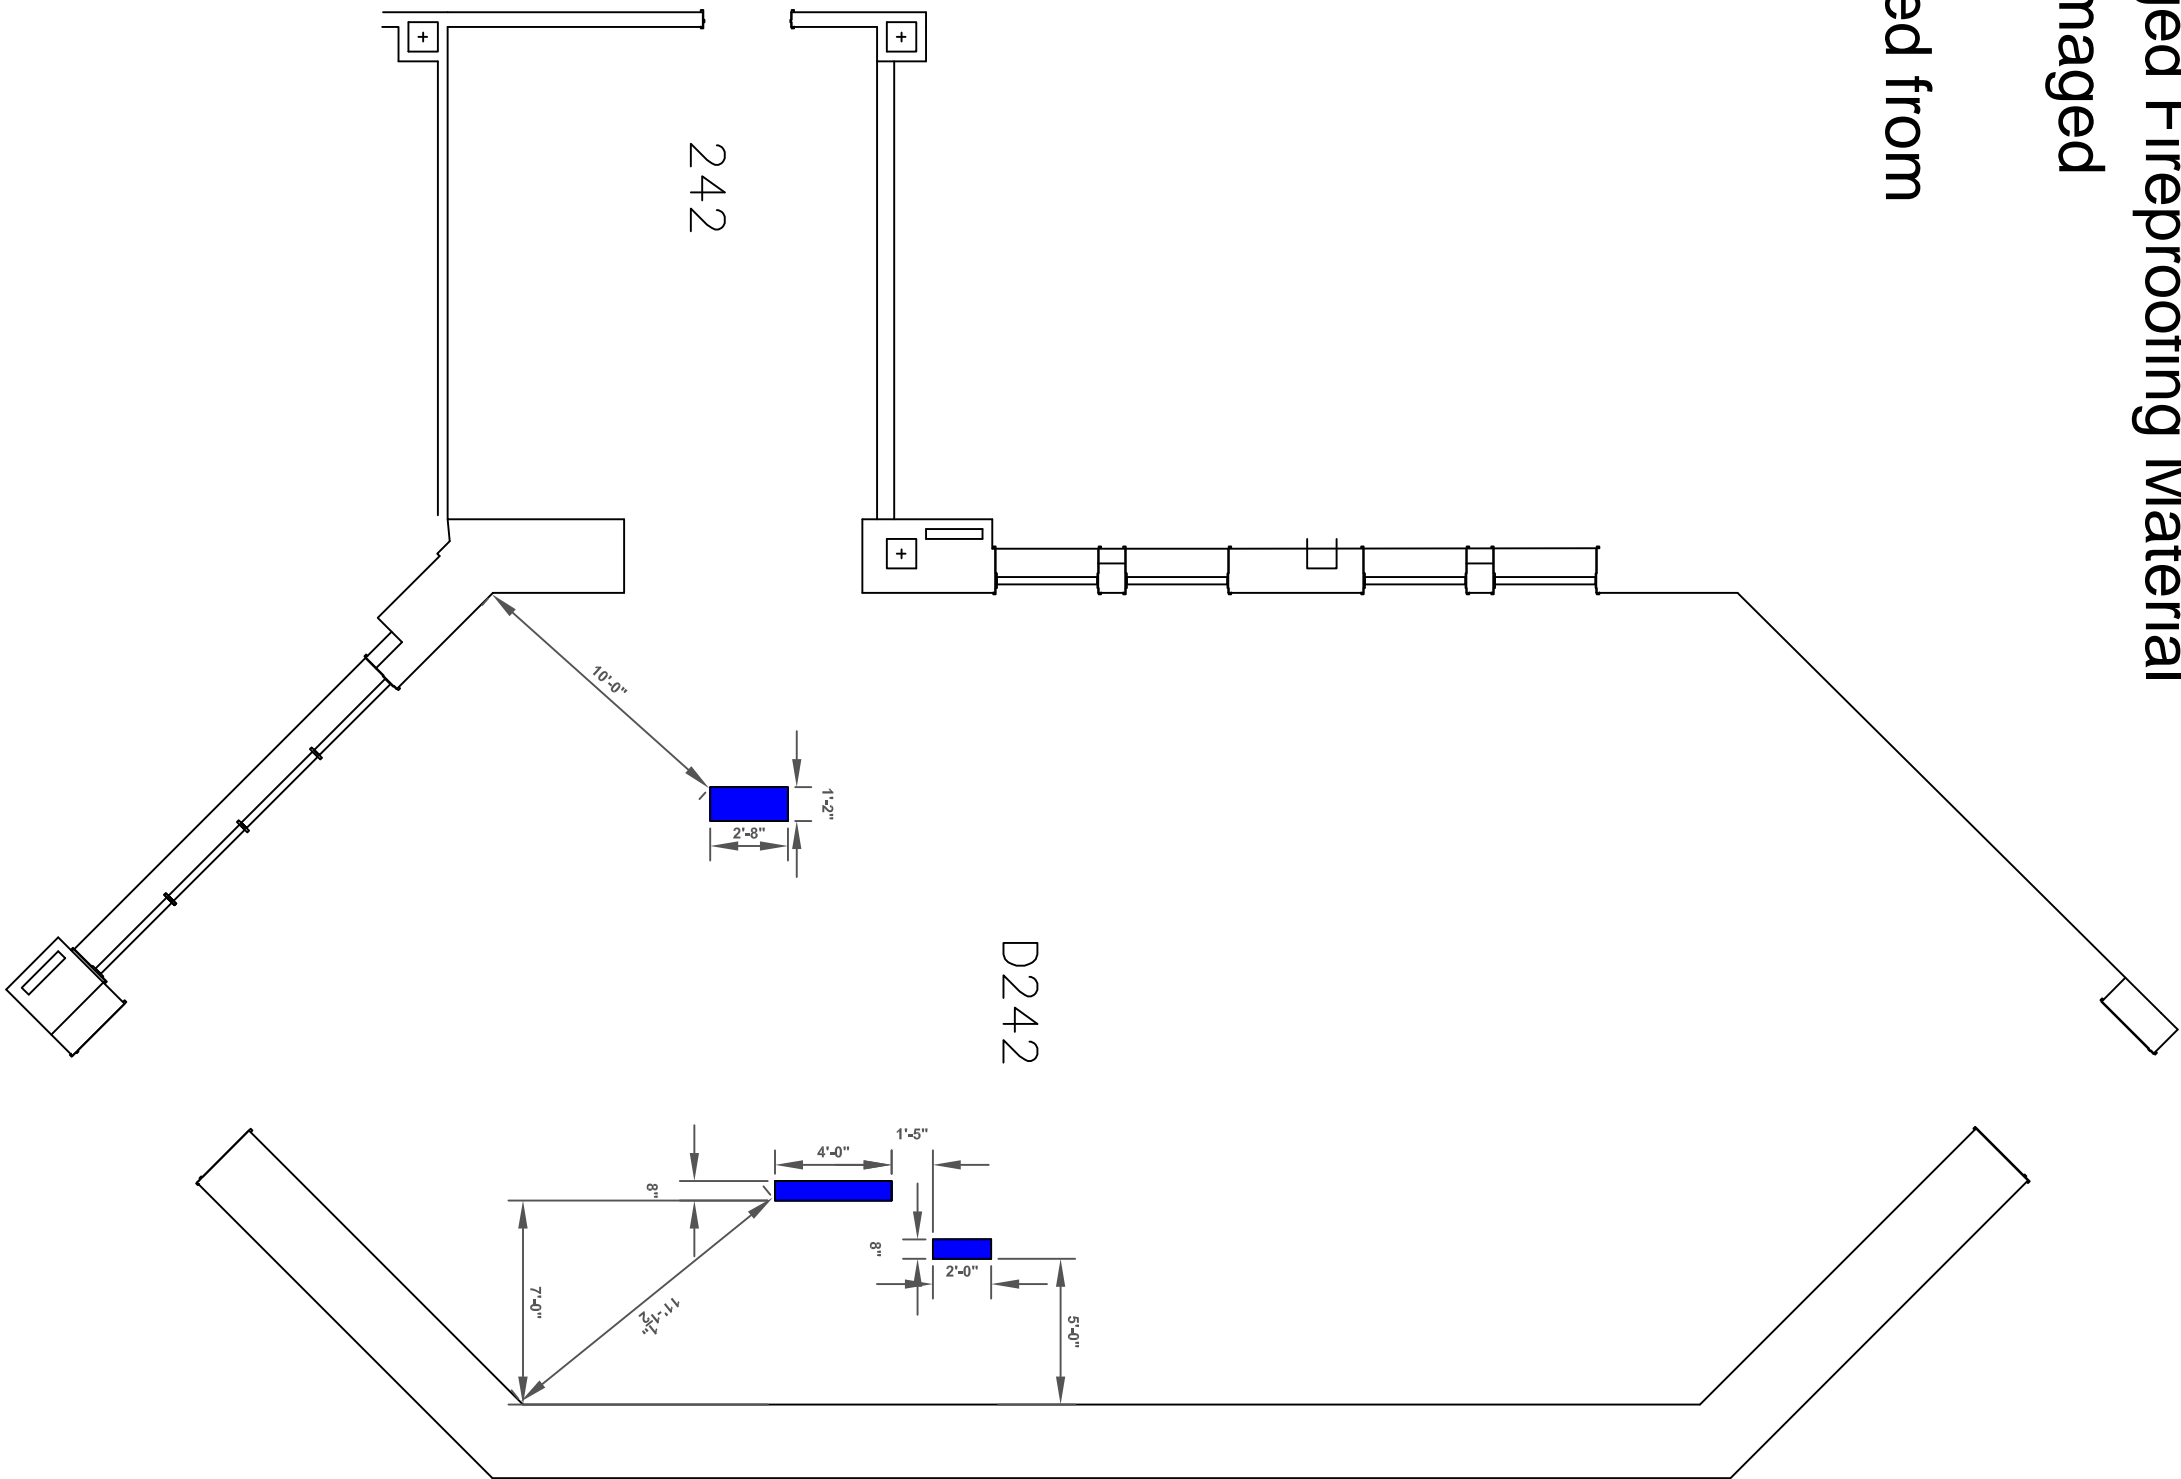

Revisions	Date

CONSULTANT

ARCHITECT/ENGINEERS:
ALBANY STRATTON VAMC
FMS DESIGN TEAM

STAMP

Office of
Construction
and Facilities
Management
VA U.S. Department
of Veterans Affairs

Drawing Title
2nd Floor Mechanical Room
ZOOMED IN
Approved: Project Director

Phase
DESIGN DEVELOPMENT


Project Title
Fireproofing Repairs
Location
242
Issue Date
10/0/2017
Checked
Drawn
S.LING

Project Number
528A8-18-807
Building Number
BLDG. 1
Drawing Number
A101-2

Mechanical Room 11A, B1 F11 - Dimensions

The shaded areas represent the locations of missing or damaged fireproofing material.

Dimensions for the shaded areas can be referenced from "Title Block B1 F11 Mech A Zoomed In".

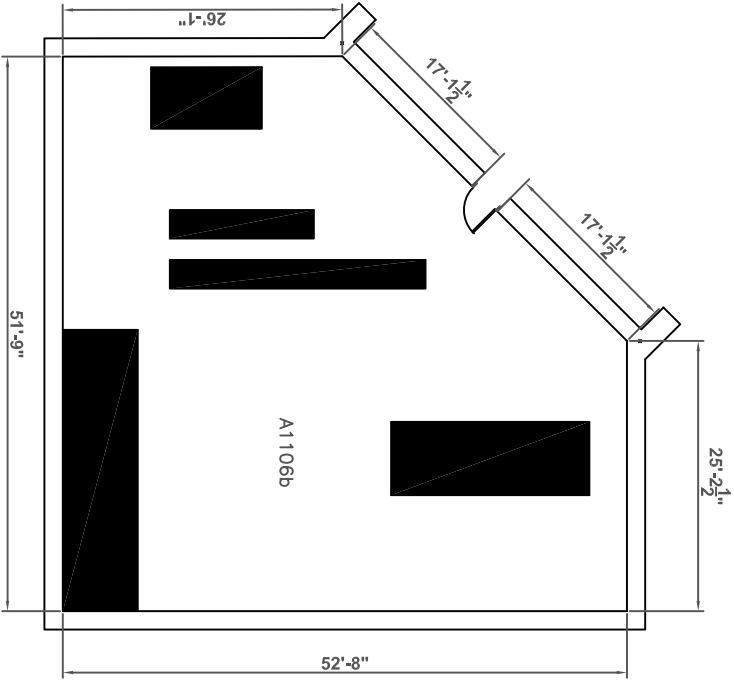

CONSULTANT		ARCHITECT/ENGINEERS:		STAMP		Office of Construction and Facilities Management		Drawing Title		Phase		Project Title		Project Number	
ALBANY STRATTON VAMC		ALBANY STRATTON VAMC				VA		MECHANICAL ROOM 11A		DESIGN DEVELOPMENT		Fireproofing Repairs		528A8-18-807	
FMS DESIGN TEAM		FMS DESIGN TEAM				U.S. Department of Veterans Affairs		ENTIRE ROOM				Location		Bldg. Number	
								Approved Project Director				11A		BLDG. 1	
												Issue Date		Drawing Number	
												10/02/2017		A102-1	
Revisions:		Revisions:													
Date:		Date:													


Mechanical Room 11A, B1 F11 - Locations of Missing/Damaged Fireproofing Material

The shaded areas represent the square footage of missing/damaged fireproofing material.

Two of the shaded areas (center of the drawing) have been measured from another shaded portion due to inaccessible locations.

Dimensions of the entire mechanical room can be referenced from

"Title Block B1 F11 Mech A Entire Room".

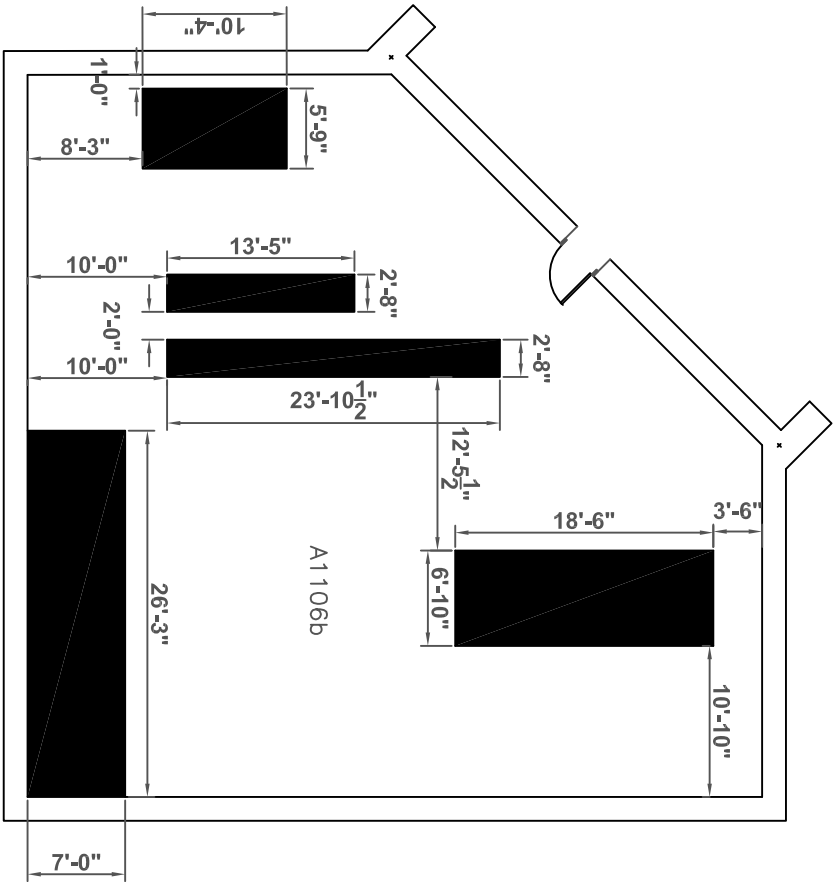

		CONSULTANT				ARCHITECT/ENGINEERS:		ALBANY STRATTON VAMC FMS DESIGN TEAM		STAMP		Office of Construction and Facilities Management		Drawing Title MECHANICAL ROOM 11A ZOOMED IN		Phase DESIGN DEVELOPMENT		Project Title Fireproofing Repair's		Project Number 628A8-18-807	
												U.S. Department of Veterans Affairs		Location 11B		Issue Date 10/10/2017		Checked S. LMG		Drawing Number A102-2	
Revisions:																					
Date:																					


Mechanical Room 11B, B1 F11 - Locations of Missing/Damaged Fireproofing Material

The shaded area represents the location of missing or damaged fireproofing material.

The shaded area has been measured from a single point of origin.


Dimensions for the entire room can be referenced from

"Title Block B1 F11 Mech B Entire Room".

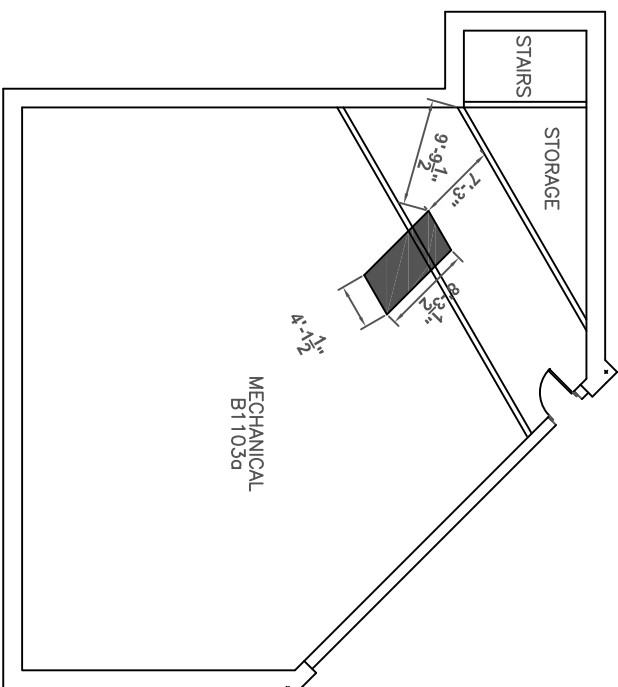

CONSULTANT		ARCHITECT/ENGINEERS:		STAFF		Project Title		Project Number	
		ALBANY STRATTON VAMC FMS DESIGN TEAM				Mechanical Room 11B Zoomed In		522A6-18-807	
						DESIGN DEVELOPMENT		Building Number	
						Ft reproofing Repairs		BLDg. 1	
						Location		Drawing Number	
						11B		A103-2	
						Issue Date		Checked	
						01/01/2007		e. luno	
Reviewed:									
Date:									


Mechanical Room 11C, B1 F11 - Locations of Missing/Damaged Fireproofing Material
The shaded areas represent the square footage of missing/damaged fireproofing material.
Dimensions of the entire mechanical room can be referenced from
"Title Block B1 F11 Mech C Entire Room".

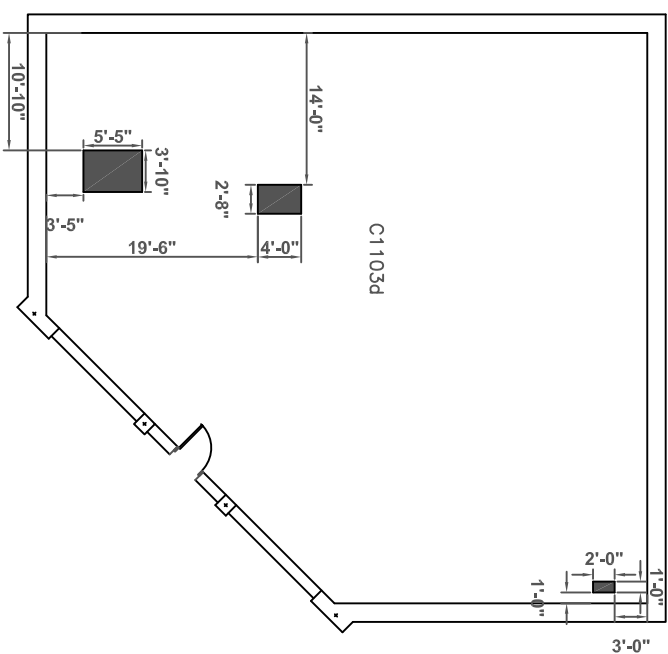[illegible]

Mechanical Room 11D, B1 F11 - Dimensions

The shaded areas represent the locations of missing or damaged fireproofing material.

Dimensions for the shaded areas can be referenced from "Title Block B1 F11 Mech D Zoomed In".

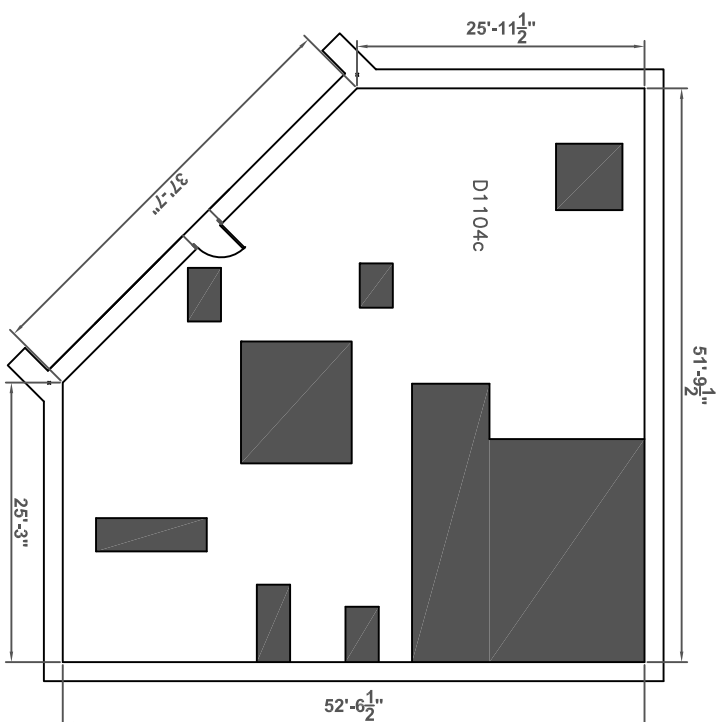
[illegible]

Mechanical Room 11D, B1 F11 - Locations of Missing/Damaged Fireproofing Material

The shaded areas represent the square footage of missing/damaged fireproofing material.

Two of the shaded areas (center of the drawing) have been measured from another shaded portion due to inaccessible locations.

Dimensions of the entire mechanical room can be referenced from "Title Block B1 F11 Mech D Entire Room".

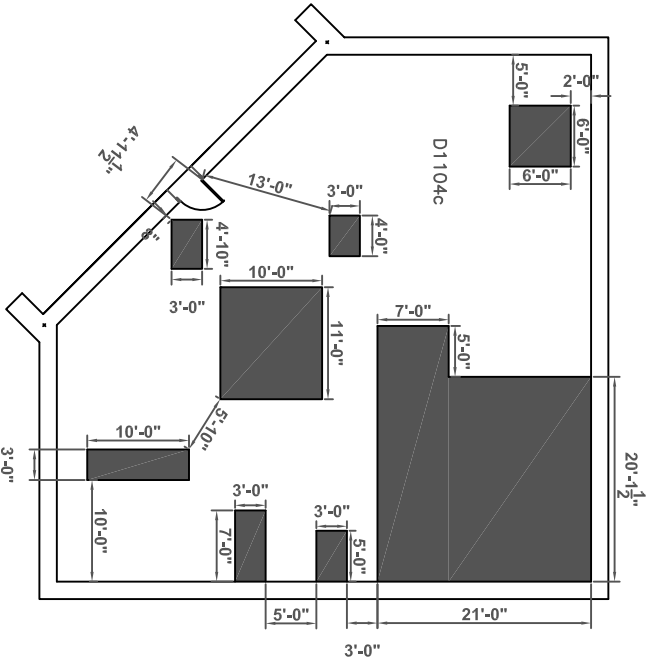

		CONSULTANT		ARCHITECT/ENGINEERS:		STAFF		Project Title		Revision		Project Number	
				ALBANY STRATTON VAMC				MECHANICAL ROOM 11D		DESIGN DEVELOPMENT		Fireproofing Repairs	
				FAB DESIGN TEAM				ZOOMED IN				BLDG. 1	
								Approved: Project Director				Location	
								VA				Issue Date	
								U.S. Department of Veterans Affairs				04/09/2017	
												Checked	
												Drawn	
												S. LUNA	
												Project Number	
												528A-16-007	
												BLDG. 1	
												Drawing Number	
												A105-2	