


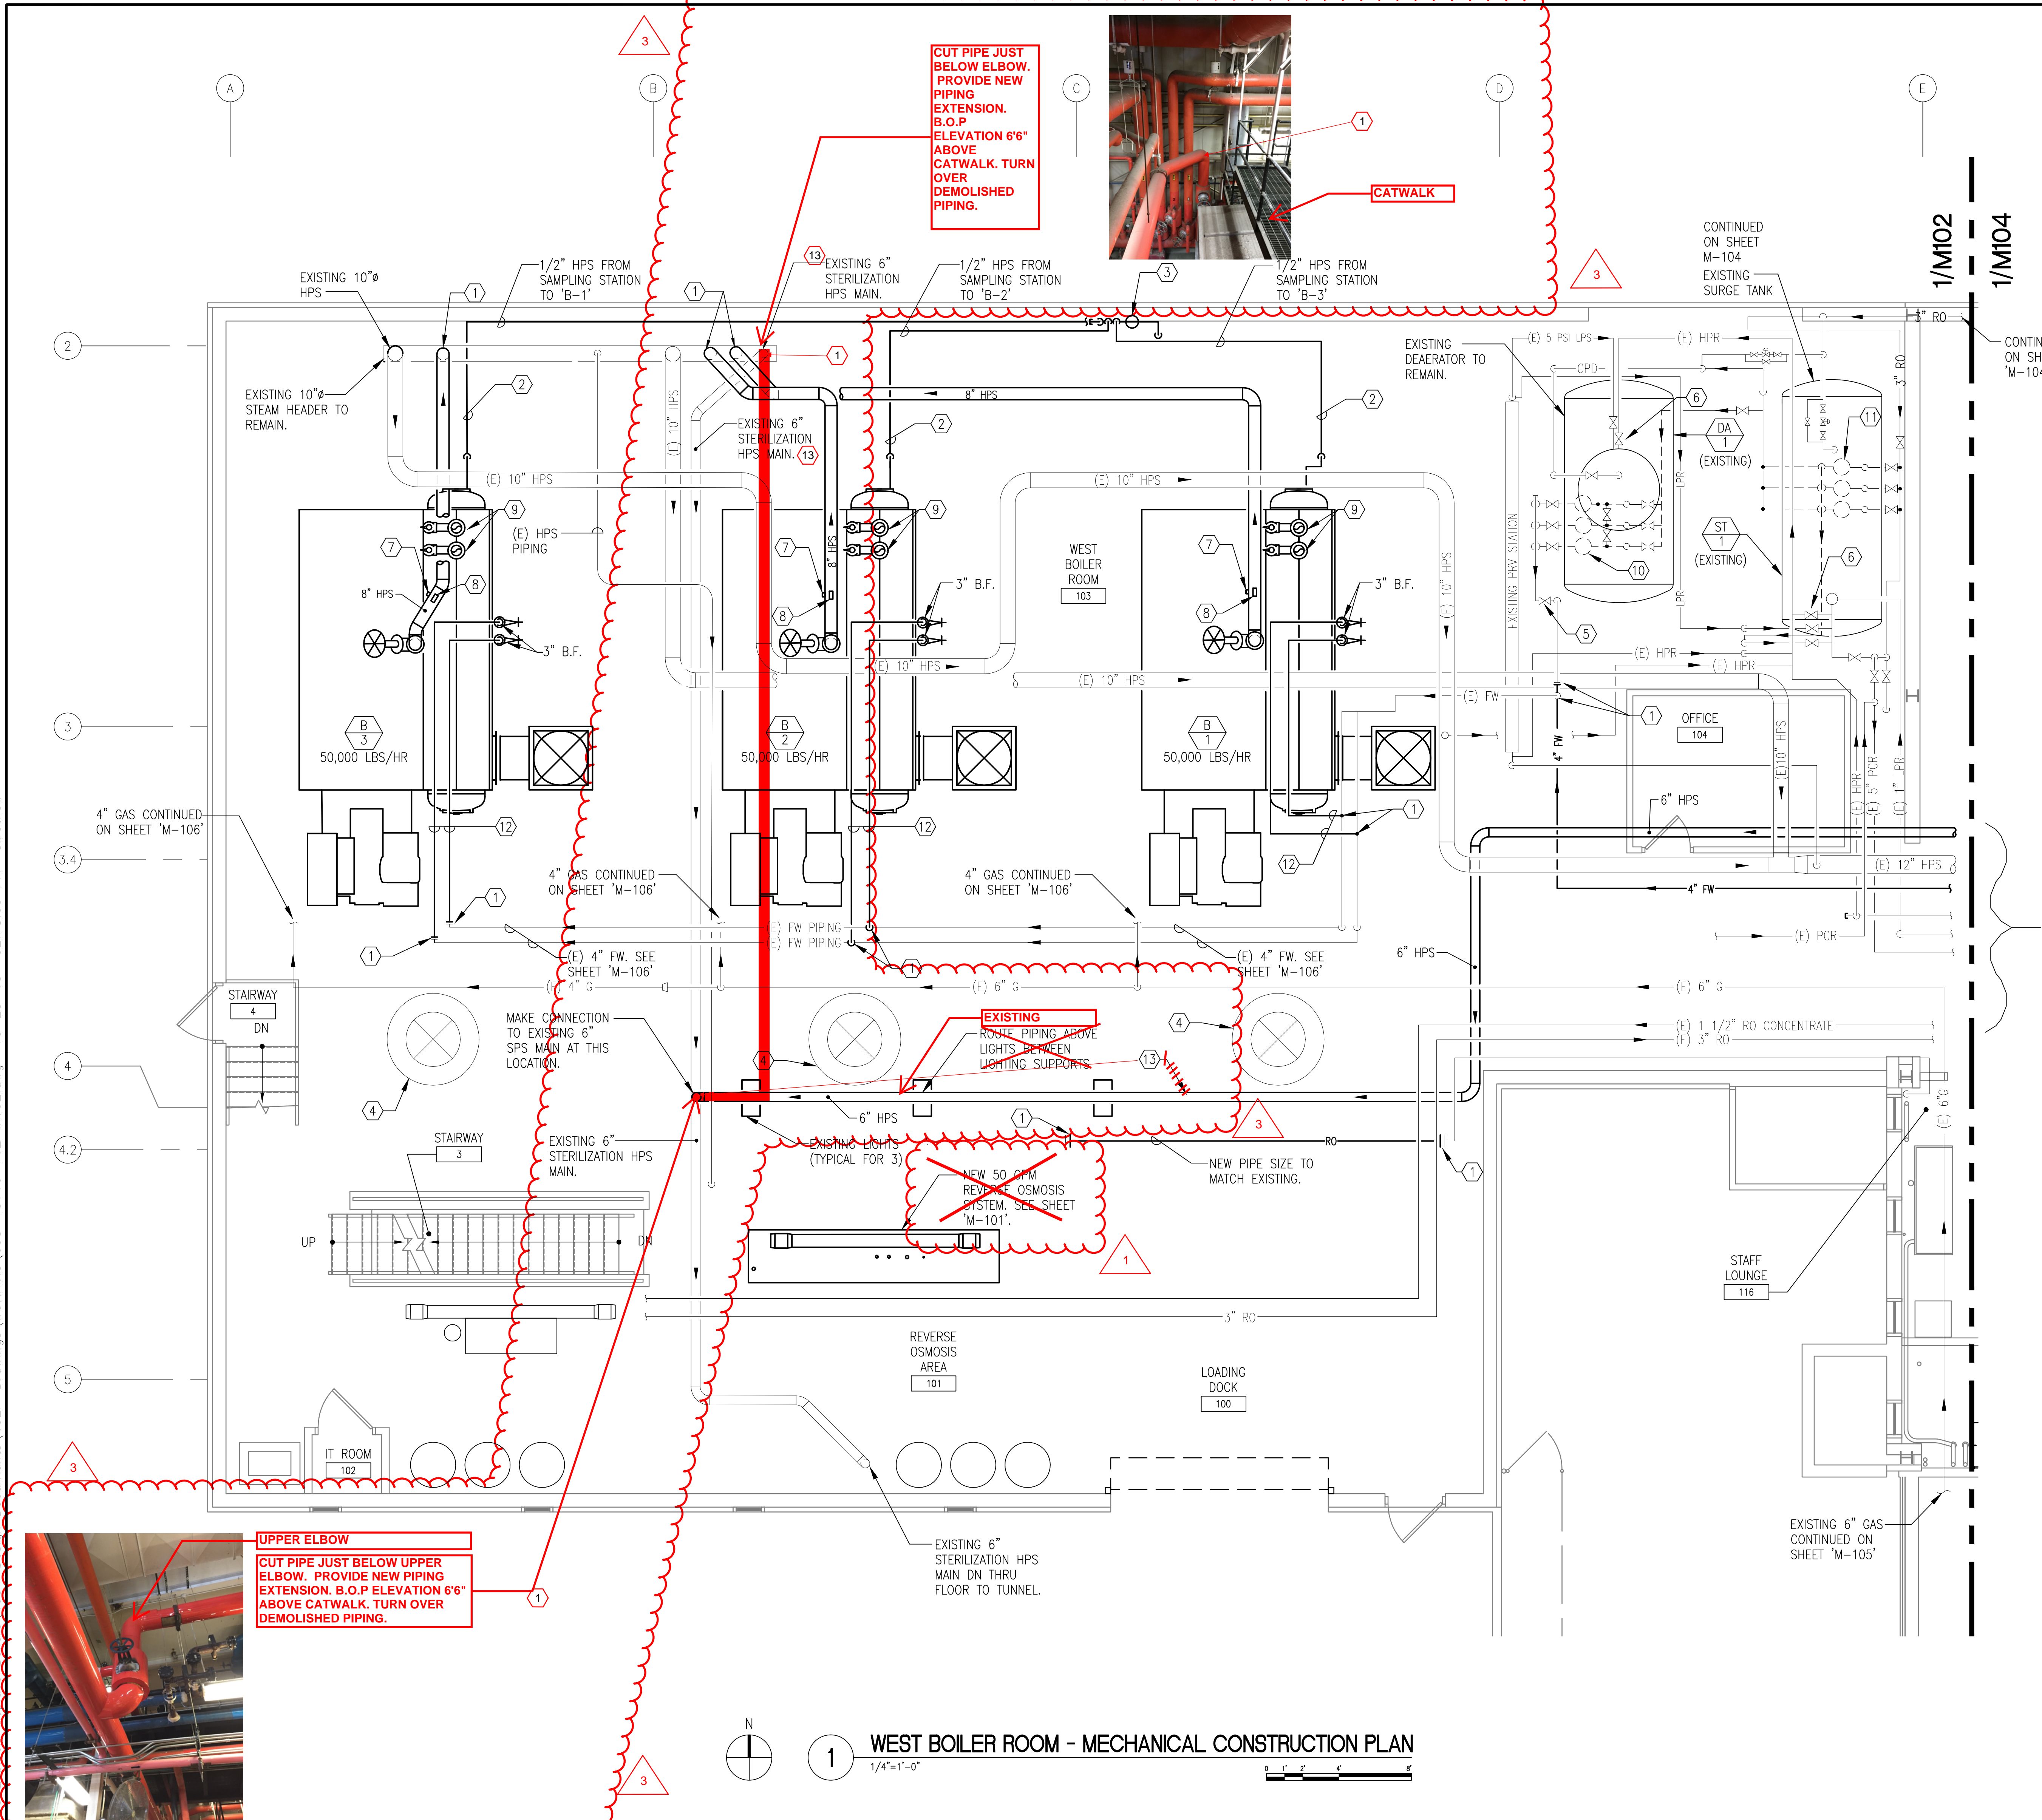

ABBREVIATIONS

B	BOILER
B.F.	BOILER FEED PUMPS
B.O.	BOILER BLOWOFF
CPD	CONDENSATE PUMP DISCHARGE
CTP	CONDENSATE TRANSFER PUMP
DA	DEARATOR
(E)	EXISTING
FOR	FUEL OIL RETURN
FOS	FUEL OIL SUPPLY
FW	FEEDWATER PIPING
GPM	GALLONS PER MINUTE
HPR	HIGH PRESSURE RETURN (STEAM CONDENSATE)
HPS	HIGH PRESSURE SUPPLY (STEAM)
LPR	LOW PRESSURE RETURN (STEAM CONDENSATE)
LPS	LOW PRESSURE STEAM
PCR	PUMPED CONDENSATE RETURN
RO	REVERSE OSMOSIS
SPS	STERILIZATION PROCESS SYSTEM
ST	SURGE TANK
TYP.	TYPICAL

MECHANICAL CONSTRUCTION PLAN NOTES



- MAKE CONNECTION TO EXISTING PIPE AT THIS LOCATION.
- 1/2" BOILER SAMPLE WATER PIPING
- EXISTING BOILER SAMPLING STATION. PROVIDE J.L. WINGERT CO. MODEL SC-1-B-316 STAINLESS STEEL (OR ZABLOCKI VA APPROVED EQUAL) SAMPLE COOLER AT SAME LOCATION AS FORMER UNIT. REFER TO "EXISTING FIELD CONDITIONS - PHOTO #3" ON SHEET "M-500".
- RE-INSTALL EXISTING SUPPLY DIFFUSERS AT SAME LOCATION AFTER THE NEW BOILERS ARE IN PLACE.
- EXISTING ISOLATION VALVE IN VERTICAL RISE OF FEED WATER PIPING. VALVE SHALL BE IN OPEN POSITION WHEN "BFP-1", "BFP-2", OR "BFP-3" ARE RUNNING AND SHALL BE CLOSED WHEN "BFP-4", "BFP-5" OR "BFP-6" ARE RUNNING.
- EXISTING VALVE. VALVE SHALL REMAIN CLOSED WHEN "DA-2"/"ST-2" ARE IN OPERATION AND OPEN WHEN "DA-1"/"ST-1" ARE IN OPERATION.
- 3/4" PLUGGED TEE FOR CALORIMETER CONNECTION (TYP.)
- PRESSURE GAUGE WITH SYPHON (TYP.)
- SAFETY VALVE VENTS UP THRU ROOF. ROUTE VENTS THRU EXISTING ROOF OPENINGS AND ENLARGE OPENINGS AS REQUIRED TO ACCOMMODATE NEW VENTS. SEE "STEAM SAFETY VALVE" DETAIL ELSEWHERE.
- EXISTING BOILER FEED PUMPS ("BFP-1", "BFP-2", "BFP-3") TO REMAIN.
- EXISTING CONDENSATE TRANSFER PUMPS ("CTP-1", "CTP-2", "CTP-3") TO REMAIN.
- SEE SHEET "M-106" FOR MORE DETAIL ON THE FEEDWATER PIPING.
- THE SPS (STERILIZATION PROCESS SYSTEM) BYPASS LINE MUST BE INSTALLED PRIOR TO SHUTTING DOWN THE STEAM SYSTEM. THE BYPASS PIPE MAY BE INSTALLED BY THE VA PRIOR TO BEGINNING THE NEW CONSTRUCTION. CONTRACTOR SHALL VERIFY WHETHER THE BYPASS HAS ALREADY BEEN INSTALLED PRIOR BEGINNING THE NEW WORK.

PIPING NOTES:

- SOME PIPING MAY BE SHOWN OFFSET FROM ITS ACTUAL LOCATION FOR CLARITY. FIELD VERIFY ALL PIPE SIZES AND LOCATIONS PRIOR TO PERFORMING ANY NEW WORK.
- ALL VALVES AND EQUIPMENT MUST BE INSTALLED SUCH THAT THEY ARE ACCESSIBLE FROM THE FLOOR OR CATWALKS. PROVIDE CHAIN WHEELS ON ALL VALVES AS NEEDED FOR ACCESSIBILITY.

EXISTING SPS STEAM LINE: DEMOLISH, REMOVE, AND PROVIDE NEW PIPING, INSULATION, AND FINISH MATCHING EXISTING TO RELOCATE STEAM LINE TO HEIGHT ALLOWING FOR EXISTING BOILER REMOVAL AND REPLACEMENT WITH NEW BOILERS. WORK TO BE COMPLETED OVER ONE WEEKEND.


PIPING CONTINUED ON SHEET "M-104"

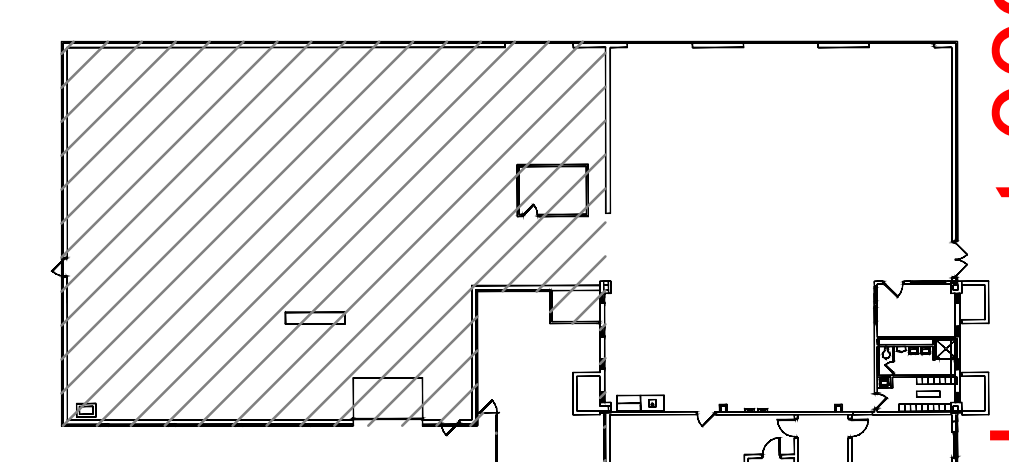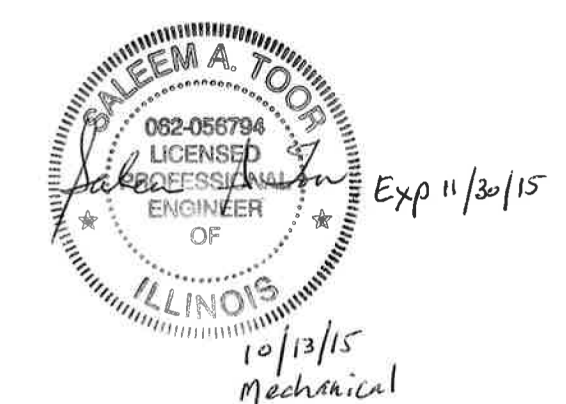

KEY PLAN
NTS

WEST BOILER ROOM - MECHANICAL CONSTRUCTION PLAN
1/4" = 1'-0"

AMENDMENT 3	03/07/2018
AMENDMENT 1	02/21/2018
BID DOCUMENTS	10/13/2015
95% CONSTRUCTION DOCUMENTS SUBMITTAL	09/15/2015
65% CONSTRUCTION DOCUMENTS SUBMITTAL	08/03/2015
35% SCHEMATIC DESIGN SUBMITTAL	05/20/2015
Revisions:	Date

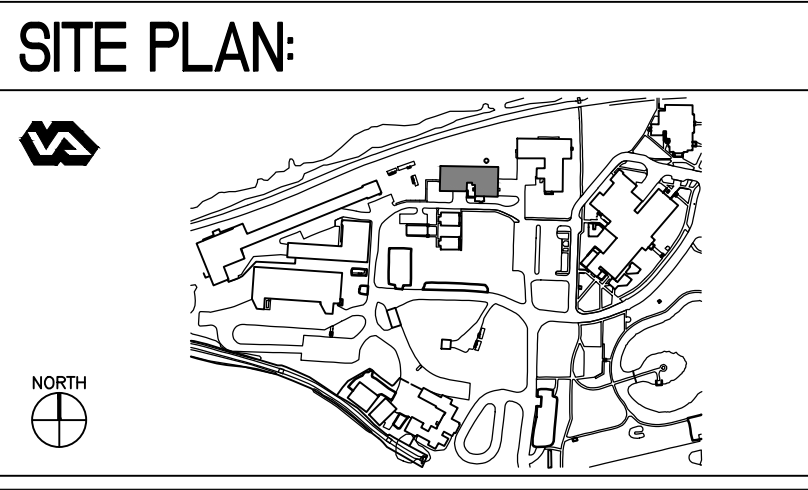

ENGINEERS + CONSULTANTS:

GEIGER + LARSON ENGINEERING
316 N Milwaukee St | Suite 202 | Milwaukee, WI 53202
T: 414-273-1432 | www.GeigerEng.com

JOHNSON WILBUR ADAMS, INC.
175 N Washington St
Wheaton, Illinois 60187
Telephone 630-653-9060
Fax 630-653-9059
www.jwa-inc.com

ARCHITECT + ENGINEERS:

Bancroft Architects + Engineers
700 Nicholas Blvd, Suite 403
Evanston, IL 60201
T: 847.952.9362 F: 847.952.9403
www.bancroft-ae.com
Bancroft-AE Project No. 14-101-06

Drawing Title:
WEST BOILER ROOM - MECHANICAL CONSTRUCTION PLAN

Approved Project Director

Project Title:
REPLACE (3) BOILERS BUILDING 112

Location:
MILWAUKEE, WISCONSIN

Date:
10/13/2015

Checked:
SAT

Drawn:
DGG

Project Number:
695-15-116

Building Number:
112

Drawing Number:
M-102

Office of Construction and Facilities Management

Department of Veterans Affairs

Amendment 003