


A three inches = one foot  
 B one and one-half inches = one foot  
 C one inch = one foot  
 D three-quarters inch = one foot  
 E one-half inch = one foot  
 F three-eighths inch = one foot  
 G one-quarter inch = one foot  
 H one-eighth inch = one foot

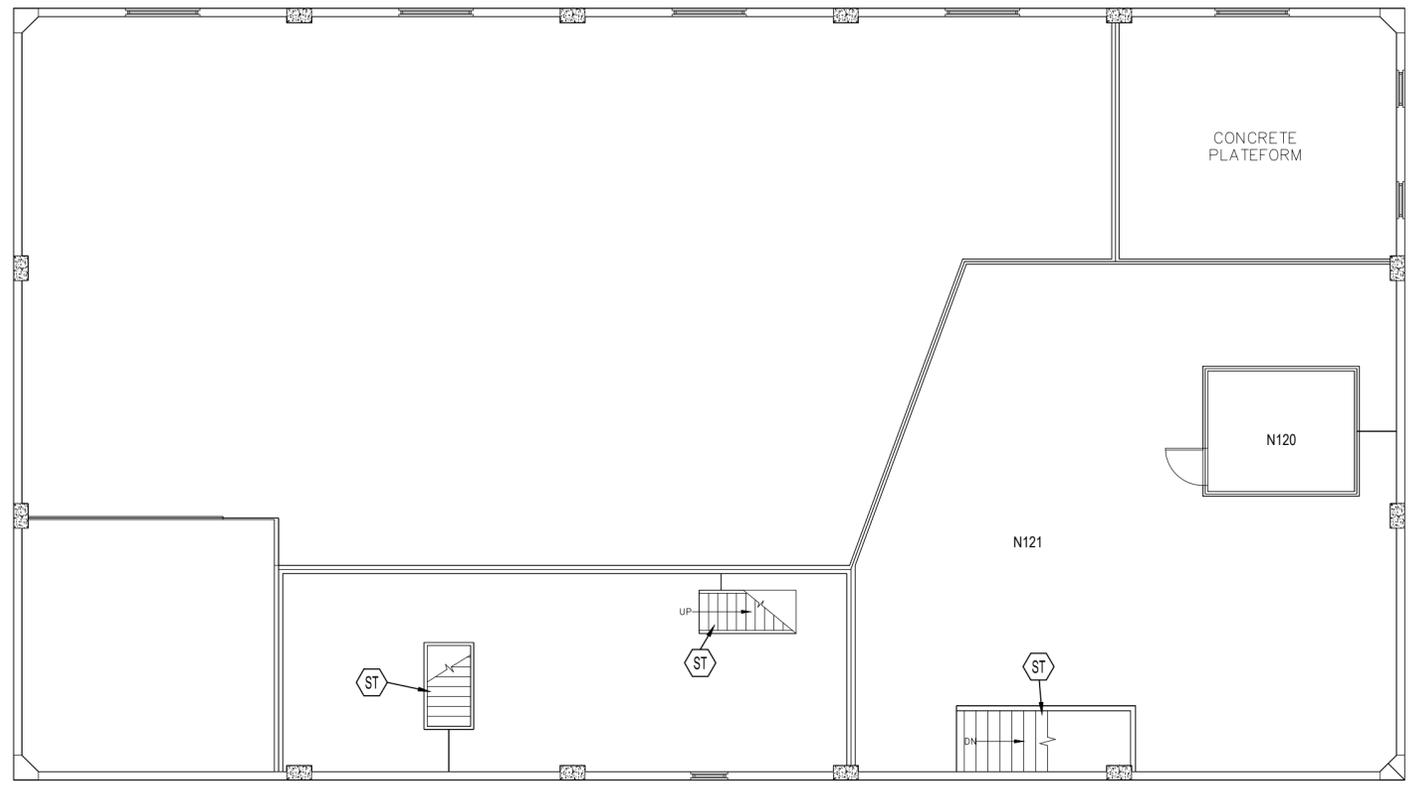

**BUILDING 8 LEAD-BASED PAINT NOTES:**

LEAD-BASED PAINT (LBP) = PAINTS OR COATINGS THAT CONTAIN >1.0 MG/CM<sup>2</sup> OF LEAD.

THE FOLLOWING COMPONENTS AT BUILDING 8 ARE FINISHED WITH COATINGS THAT CONTAIN RELATIVELY HIGH CONCENTRATIONS OF LEAD (I.E. > 1.0 MG/CM<sup>2</sup>). ALL OTHER TESTED BUILDING COMPONENT COATINGS CONTAINED RELATIVELY LOW CONCENTRATIONS OF LEAD RANGING FROM 0.00 MG/CM<sup>2</sup> TO 0.99 MG/CM<sup>2</sup>.

- Ⓢ LBP APPLIED TO METAL CHILLER PUMPS
- Ⓢ GLAZING ON CERAMIC TILE ON WALLS (BATHROOM ONLY)
- Ⓢ LBP APPLIED TO METAL COOLING TOWER PUMPS
- Ⓢ LBP APPLIED TO FUEL GAS PIPING
- Ⓢ LBP APPLIED TO INTERIOR METAL STAIR TREADS & STRINGERS


**BUILDING 8 GENERAL NOTES:**

1. OLD/FORMER ROOM NUMBER DEPICTED IN EACH ROOM WITHIN PARENTHESES, E.G. (G-101). NEW/CURRENT ROOM NUMBER DEPICTED IN EACH ROOM ABOVE OLD/FORMER ROOM NUMBER.
2. PLEASE NOTE THAT, IN ROOMS WITH NO NEW NUMBER, NONE WAS PROVIDED IN THE "ROOM NUMBER XWALK" DATABASE, DATED 29 JAN 2013.




IF THIS DRAWING IS LESS THAN 30" X 42"  
IT IS A REDUCED SIZE DRAWING

**BUILDING 8—MEZZANINE FLOOR PLAN**  
SCALE: 3/16" = 1'-0"

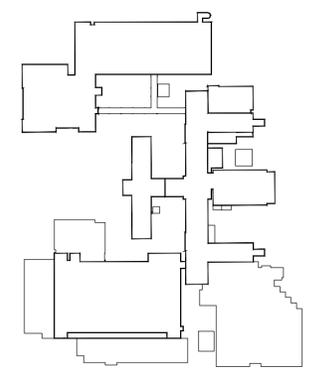

**KEY PLAN — VAMC RENO**  
NOT TO SCALE

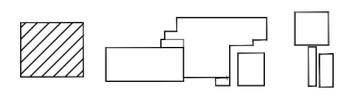

Revisions	Date

--	--


Professional Seal

Safety Environmental Laboratories  
 and Consulting, Inc.  
  
 989 Yeager Parkway  
 Pelham, AL 35124  
 phone (205) 823-6200 fax (205) 823-9066

Drawing Title BUILDING 8 — MEZZANINE FLOOR PLAN
Approved:
Approved:

Project Title LEAD-BASED PAINT SURVEY	
Building No 8	Checked NGR
Location DEPT. OF VETERANS AFFAIRS MEDICAL CENTER 1000 LOCUST ST., RENO, NEVADA	Drawn EH

Date 04-14-14
Project No. 2012-0853
Drawing No. L8.2

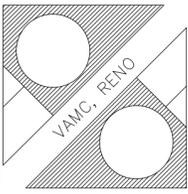

Department of  
Veterans Affairs