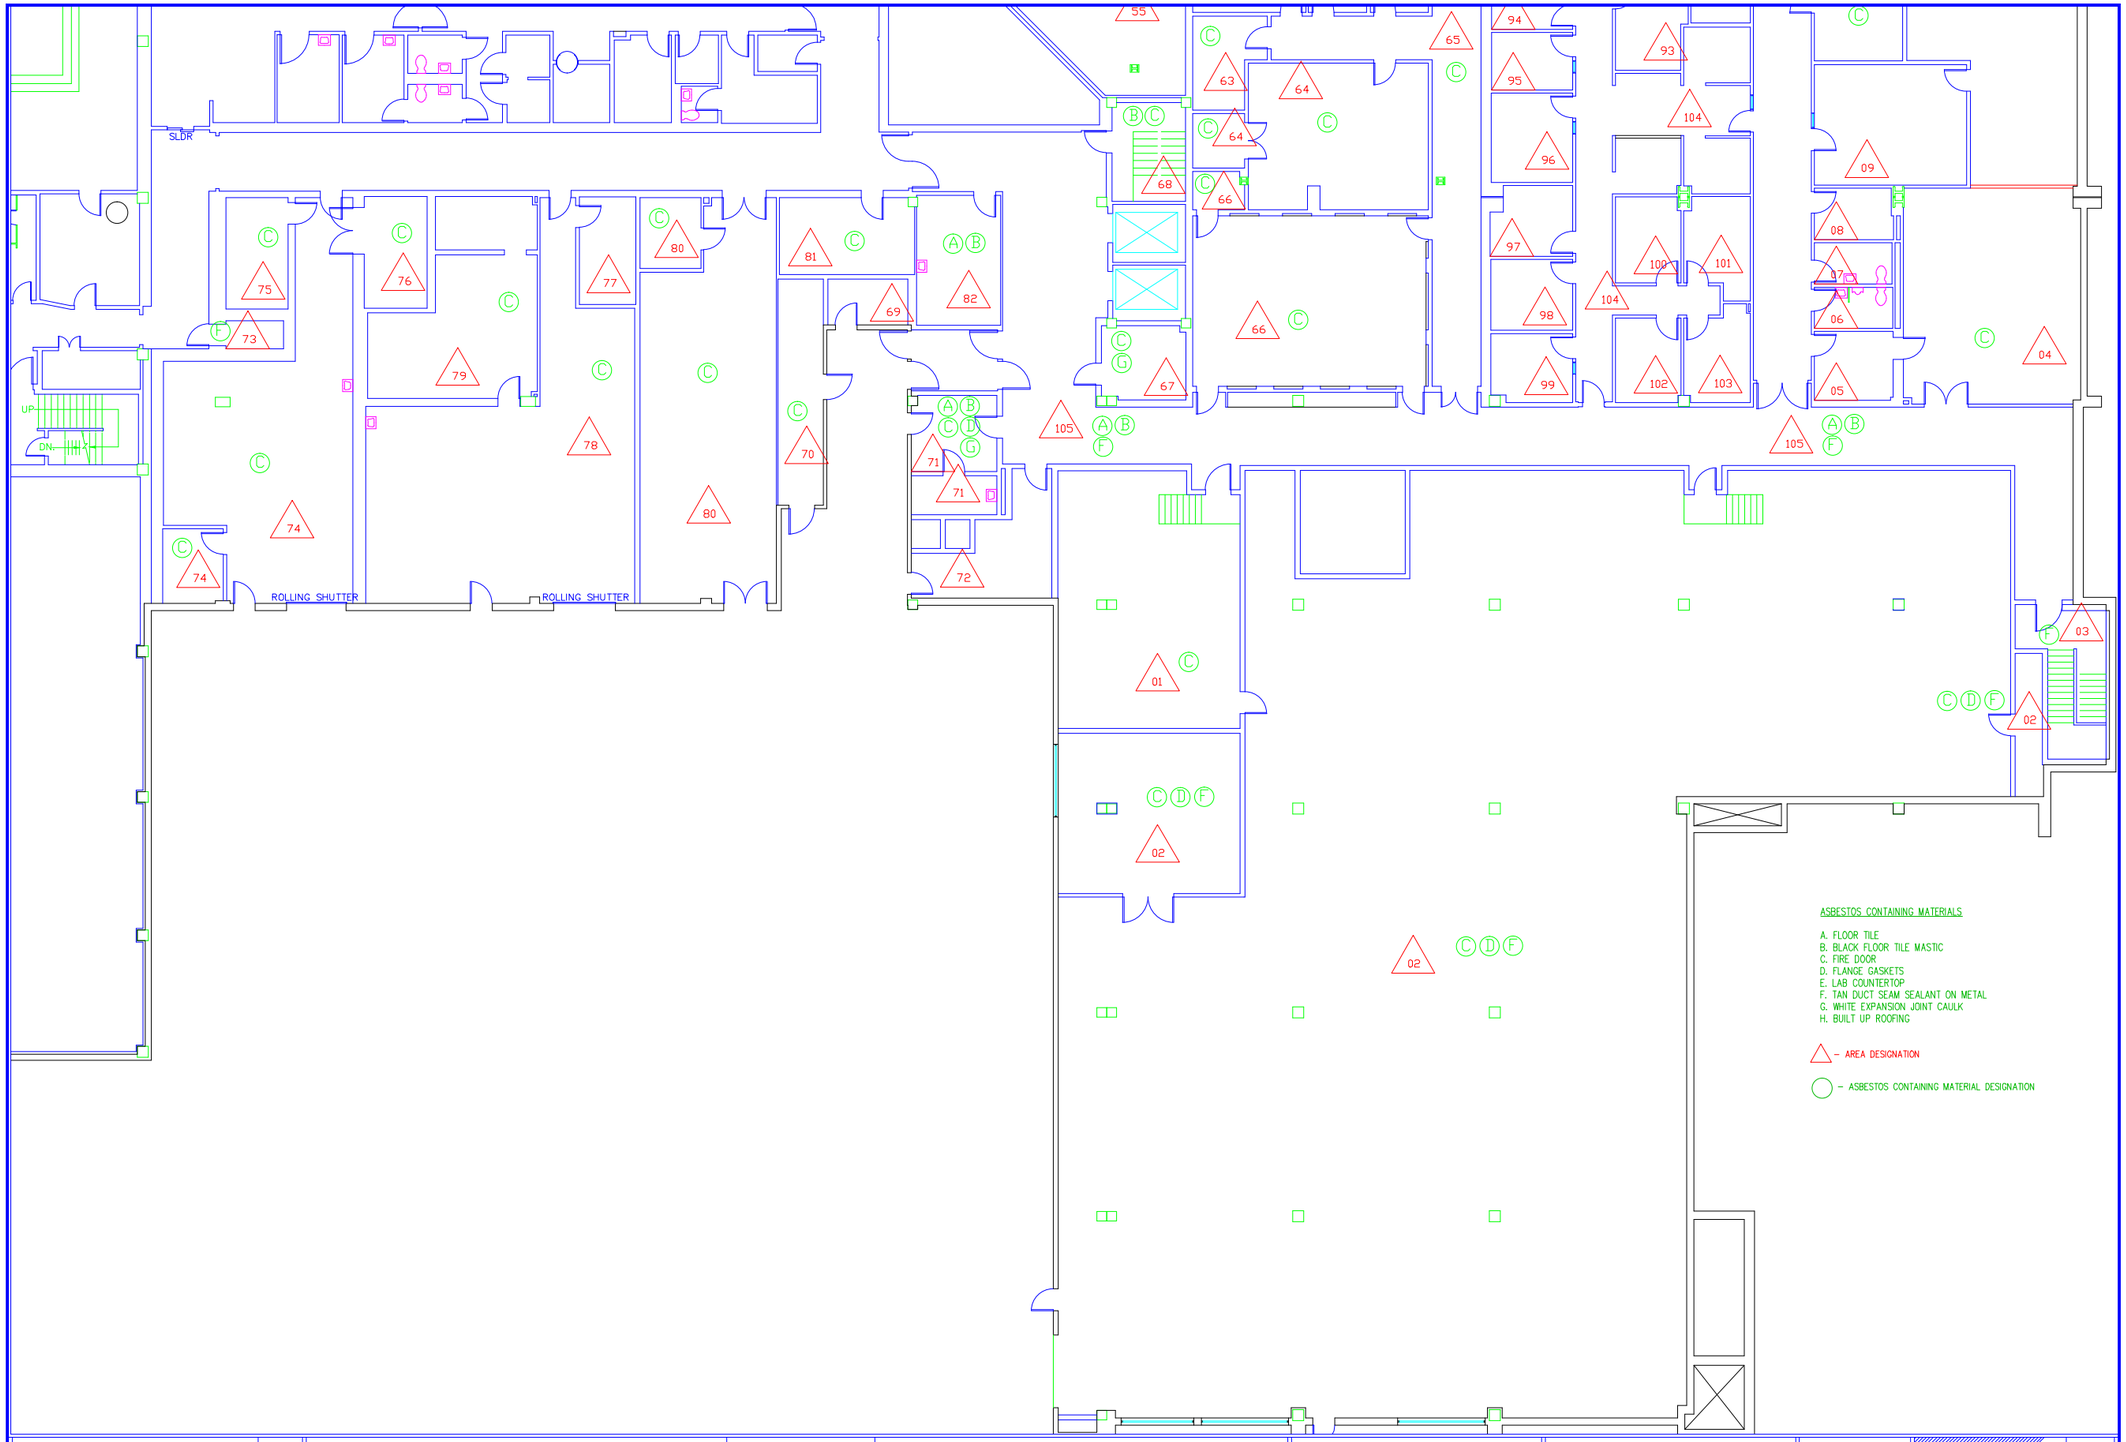


AEROSOL MONITORING & ANALYSIS, INC.
1331 ASHTON ROAD, P.O. BOX 646
HANOVER, MARYLAND 21076
WEBSITE: WWW.AMACONSULTING.COM
PHONE: 410-684-5327
FAX: 410-684-3384

Professional Seal

BASEMENT FLOOR PLAN
SOUTH ASBESTOS

Asbestos Drawings

11-17-11

Project No.

Approved:

Building Number 06

Checked

Drawn

Drawing No. H6-1

Approved:

Location VAMC WASHINGTON, DC

VAMC, Washington, D.C.

VA Department of Veterans Affairs

VA FORM 08-6231, OCT 1978

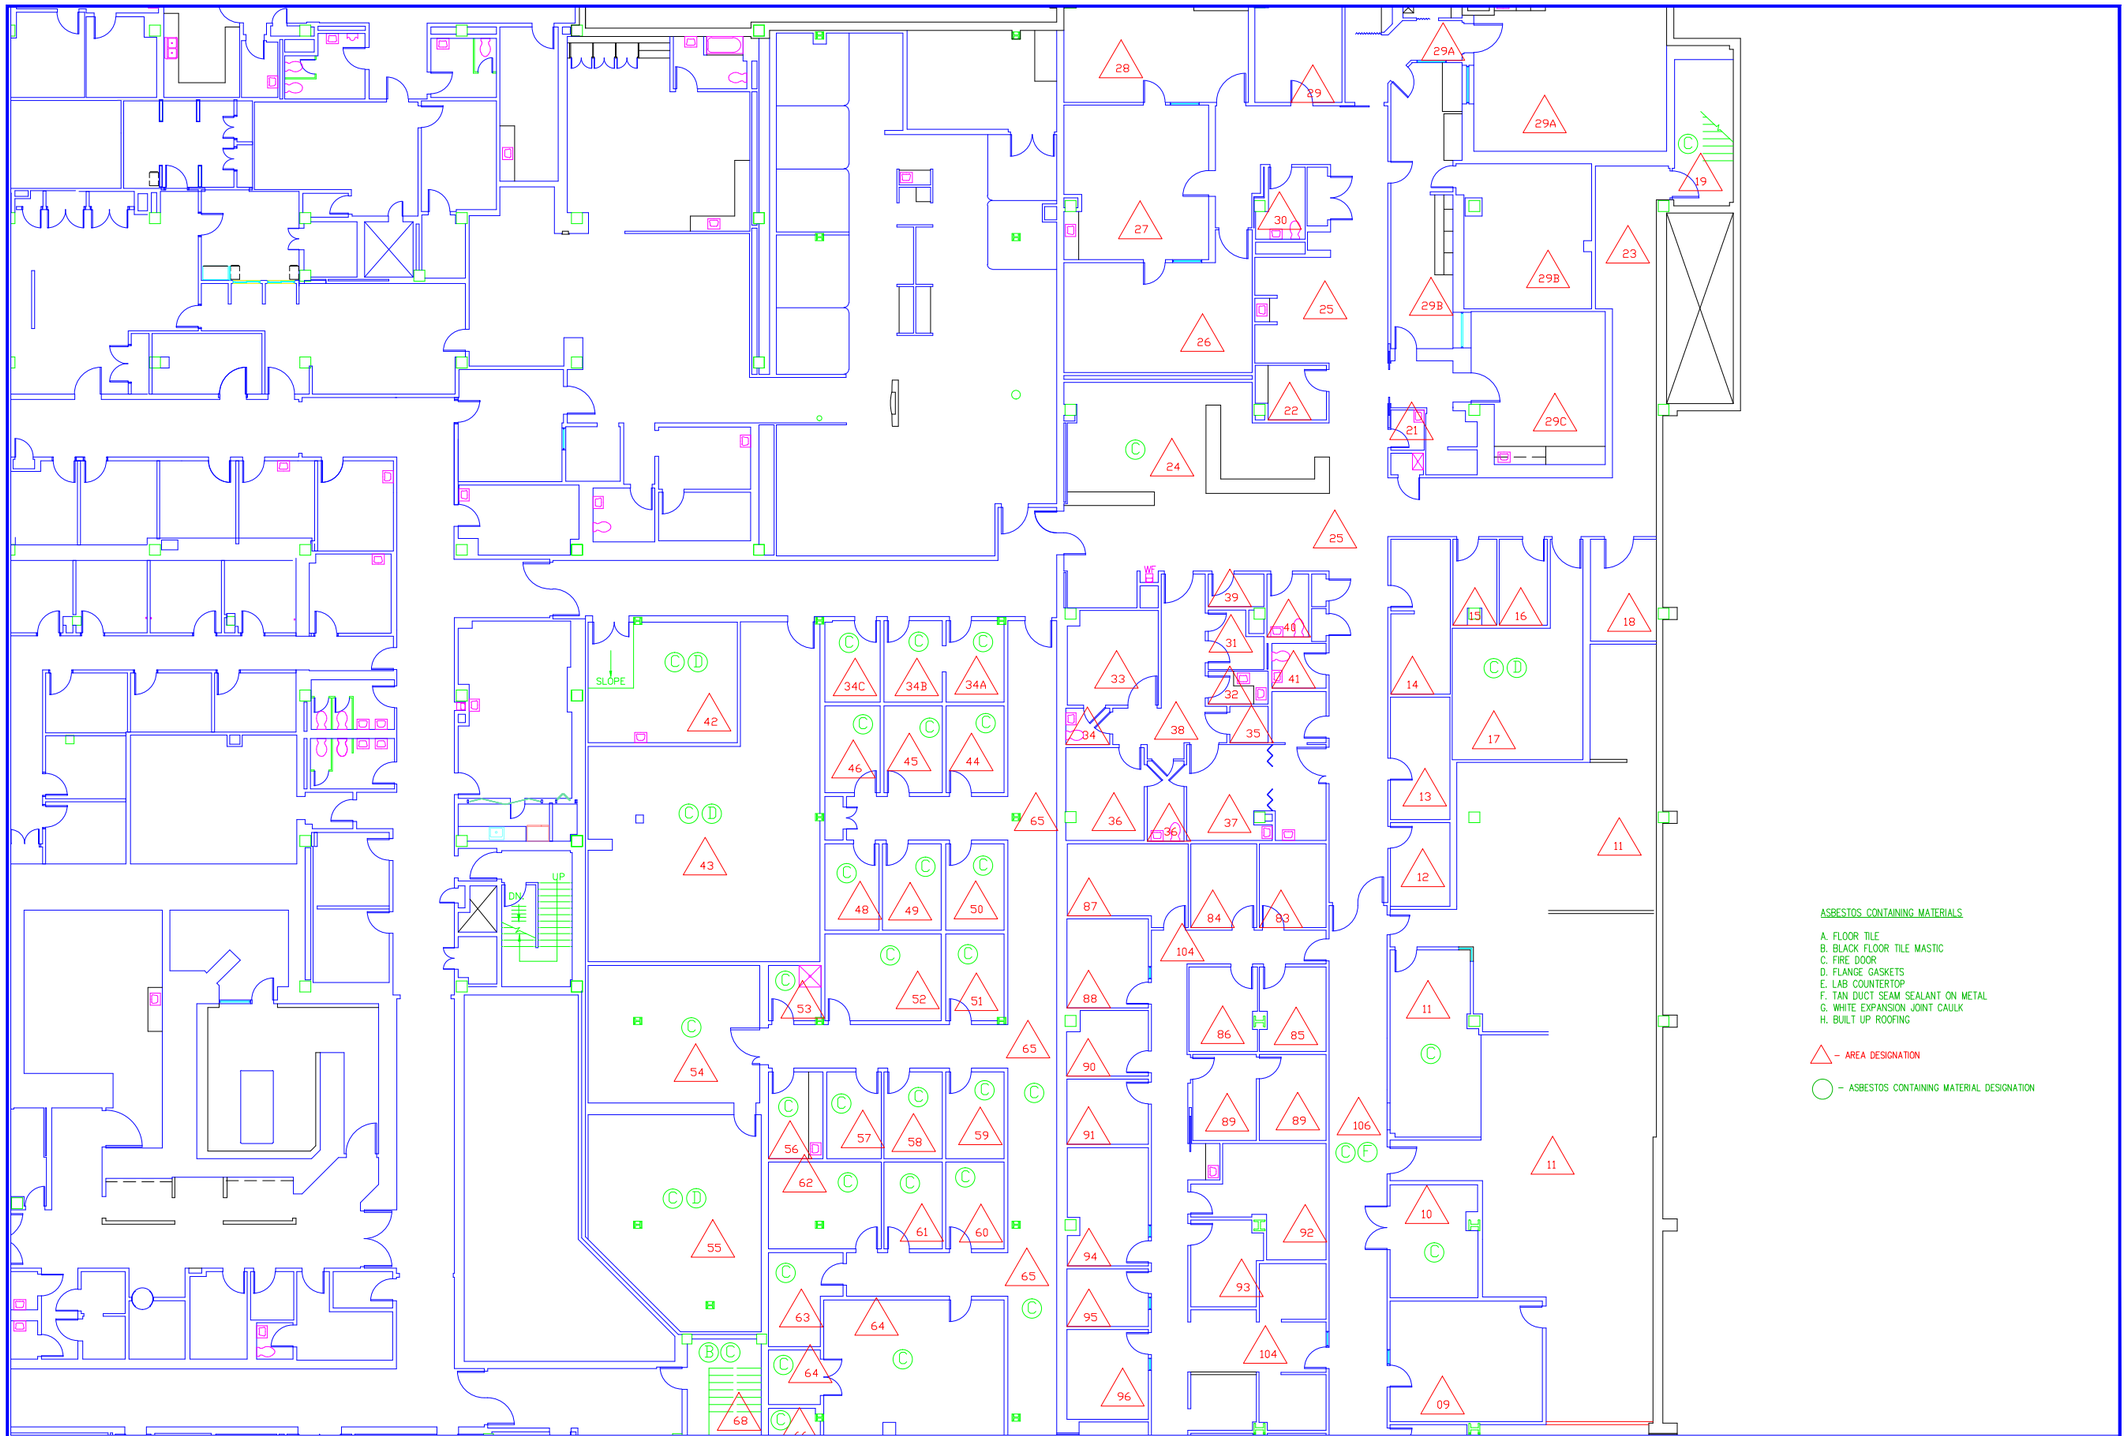


ASBESTOS CONTAINING MATERIALS

A. FLOOR TILE
B. BLACK FLOOR TILE MASTIC
C. FIRE DOOR
D. FLANGE GASKETS
E. LAB COUNTERTOP
F. TAN DUCT SEAM SEALANT ON METAL
G. WHITE EXPANSION JOINT CAULK
H. BUILT UP ROOFING

△ – AREA DESIGNATION

○ – ASBESTOS CONTAINING MATERIAL DESIGNATION

AEROSOL MONITORING & ANALYSIS, INC.
1331 ASHTON ROAD, P.O. BOX 848
HANOVER, MARYLAND 21076
WEBSITE: WWW.AMACONSULTING.COM
PHONE: 410-684-5327
FAX: 410-684-3384

Professional Seal

BASEMENT FLOOR PLAN
NORTH ASBESTOS

Asbestos Drawings

11-17-11

Project No.

Approved:

Building Number 06

Checked

Drawn

Drawing No. H6-2

Approved:

Location VAMC WASHINGTON, DC

VAMC, Washington, D.C.

VA Department of Veterans Affairs

VA FORM 08-6231, OCT 1978

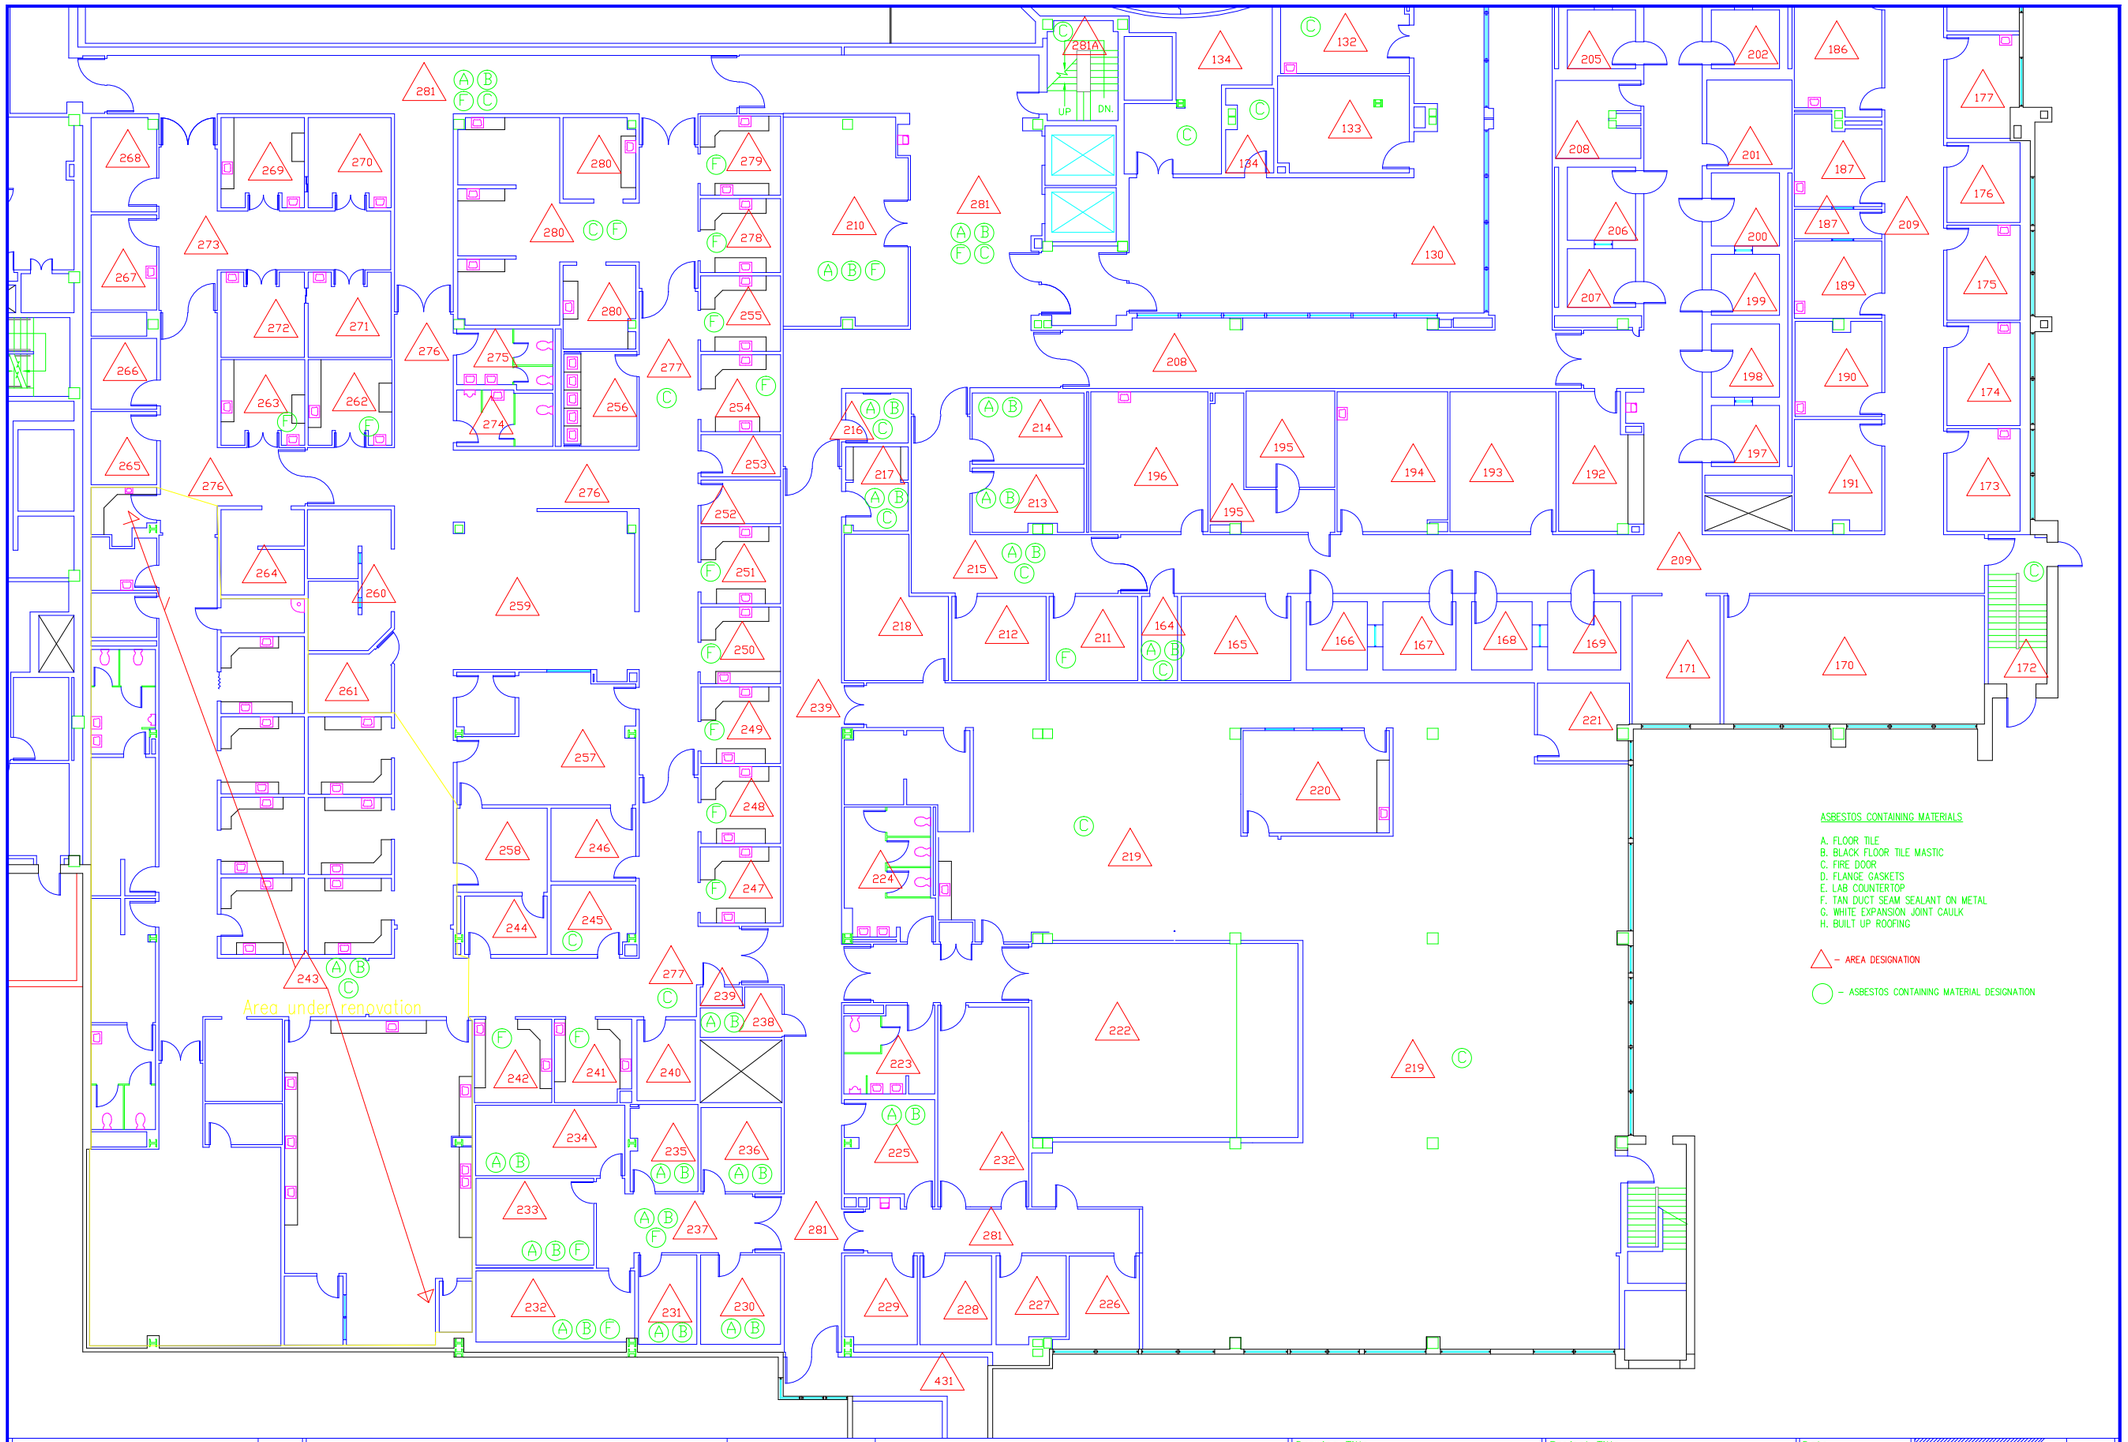


ASBESTOS CONTAINING MATERIALS

A. FLOOR TILE
B. BLACK FLOOR TILE MASTIC
C. FIRE DOOR
D. FLANGE GASKETS
E. LAB COUNTERTOP
F. TAN DUCT SEAM SEALANT ON METAL
G. WHITE EXPANSION JOINT CAULK
H. BUILT UP ROOFING

△ – AREA DESIGNATION

○ – ASBESTOS CONTAINING MATERIAL DESIGNATION

| Revisions | Date |
|---|---|
| | |

AEROSOL MONITORING & ANALYSIS, INC.
1331 ASHTON ROAD, P.O. BOX 546
HANOVER, MARYLAND 21076
WEBSITE: WWW.AMACONSULTING.COM
PHONE: 410-684-5227
FAX: 410-684-3384

Professional Seal

| | | | |
|---|---|---|---|
| Drawing Title: FIRST FLOOR PLAN SOUTH ASBESTOS | Project Title: Asbestos Drawings | | Date: 11-17-11 |
| | | | Project No. |
| Approved: | Building Number: 06 | Checked / Drawn | Drawing No. H6-3 |
| Approved: | Location: VAMC WASHINGTON, DC | | |

VAMC, WASHINGTON

VA Department of Veterans Affairs

VA FORM 08-6231, OCT 1978

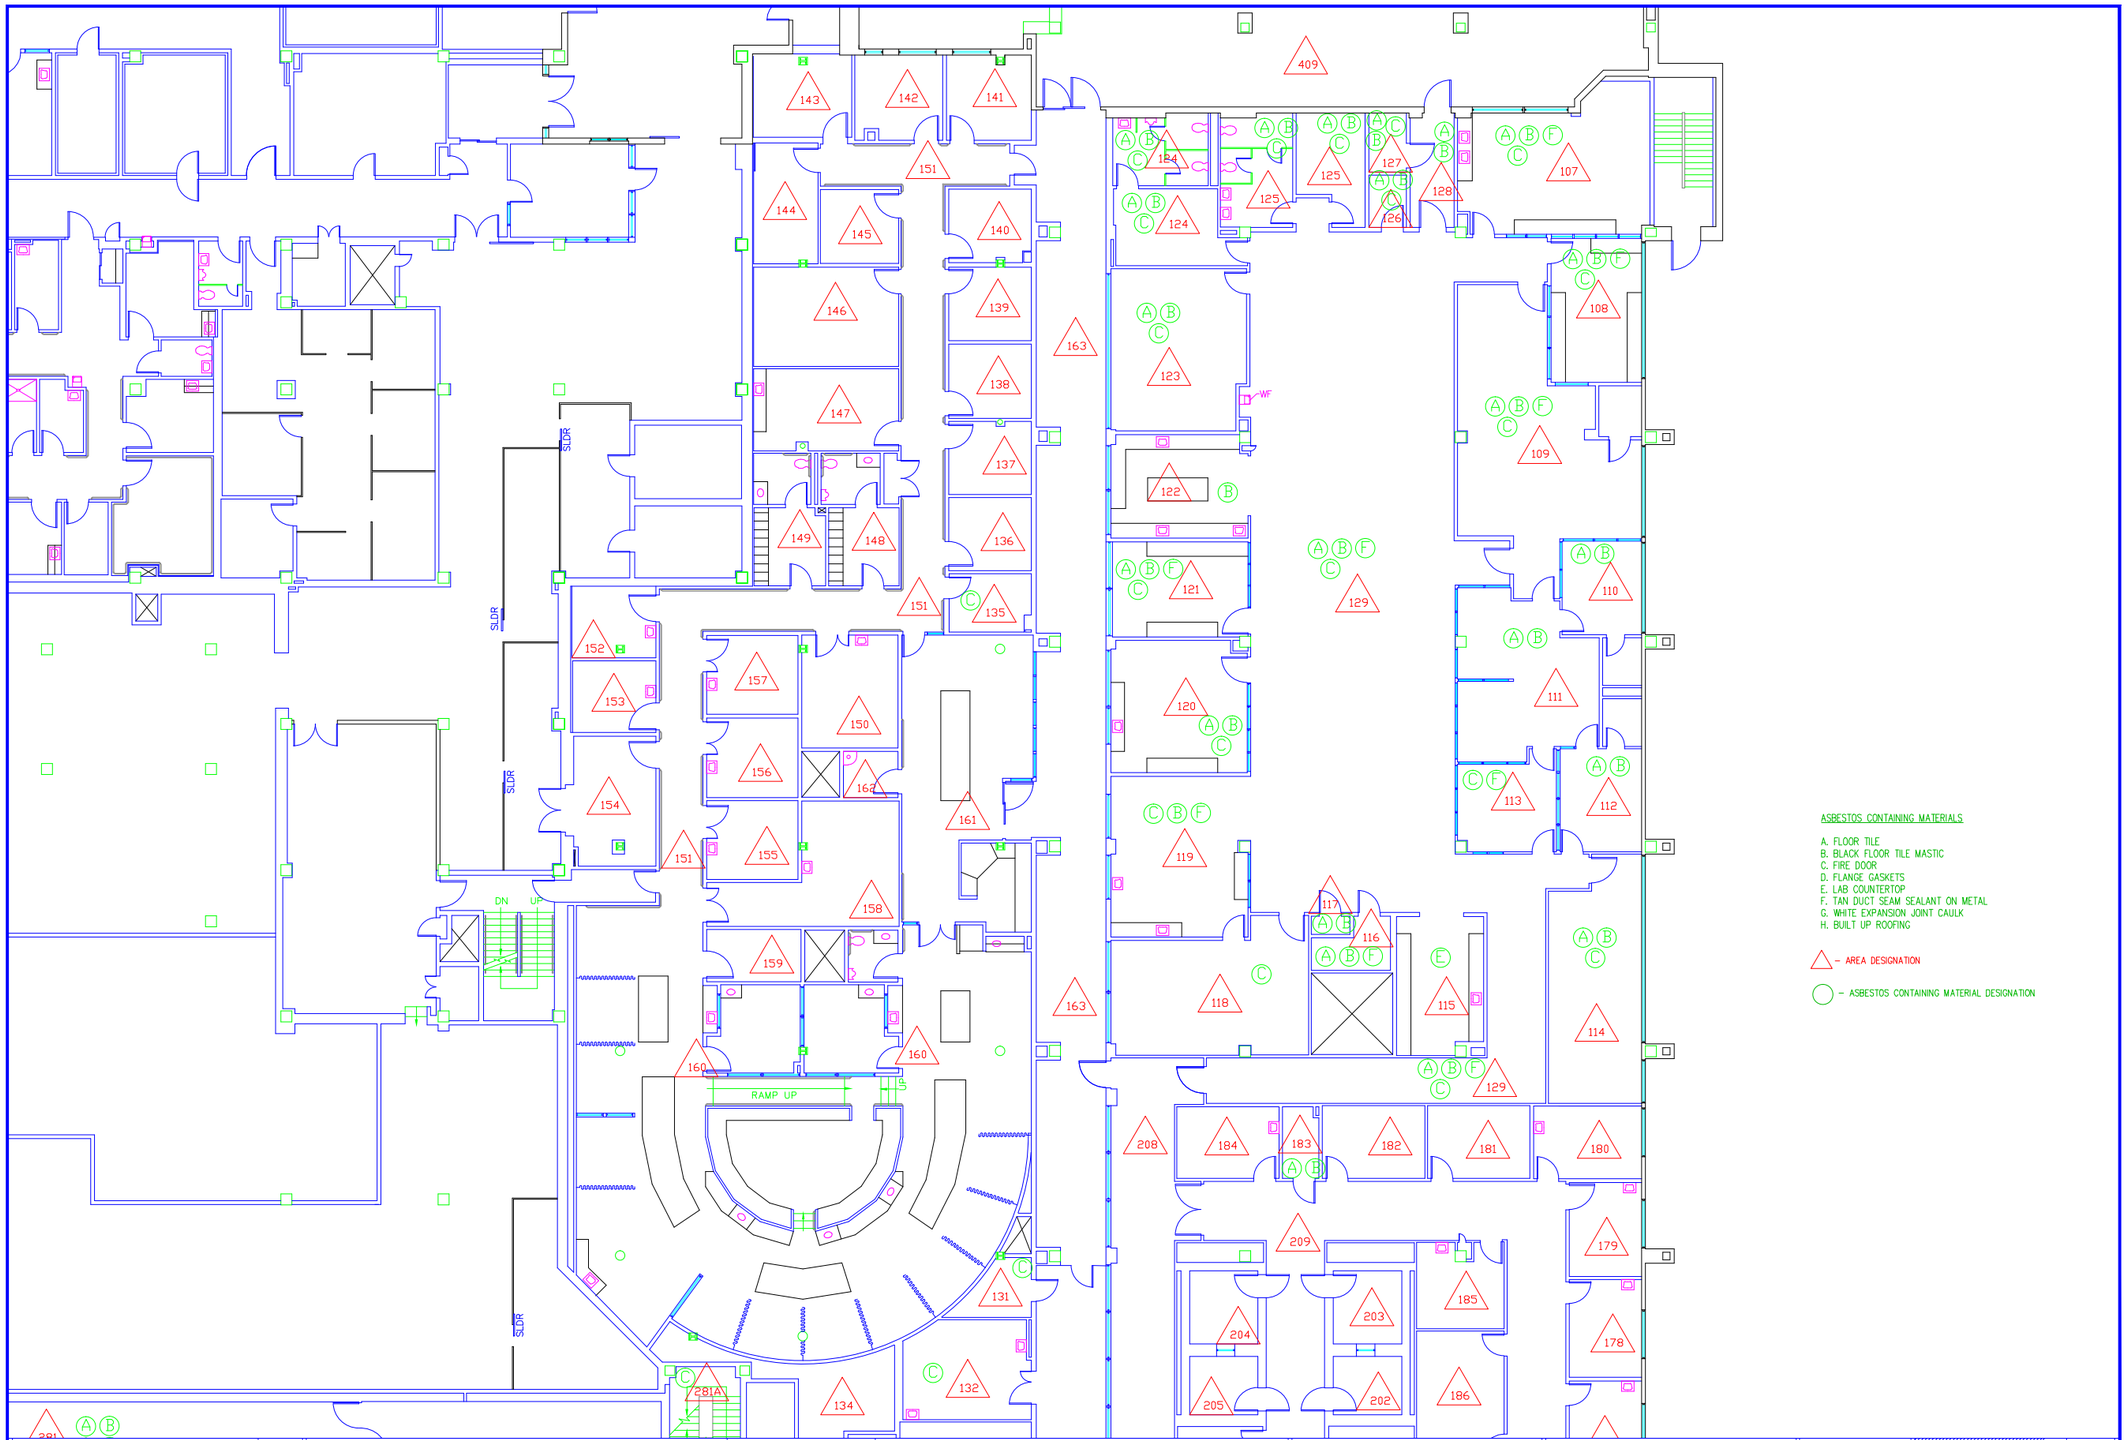


ASBESTOS CONTAINING MATERIALS

A. FLOOR TILE
B. BLACK FLOOR TILE MASTIC
C. FIRE DOOR
D. FLANGE GASKETS
E. LAB COUNTERTOP
F. TAN DUCT SEAM SEALANT ON METAL
G. WHITE EXPANSION JOINT CAULK
H. BUILT UP ROOFING

△ – AREA DESIGNATION

○ – ASBESTOS CONTAINING MATERIAL DESIGNATION

| Revisions | Date |
|---|---|
| | |

AEROSOL MONITORING & ANALYSIS, INC.
1331 ASHTON ROAD, P.O. BOX 646
HANOVER, MARYLAND 21076
WEBSITE: WWW.AMACONSULTING.COM
PHONE: 410-684-3327
FAX: 410-684-3384

Professional Seal

| | | | |
|---|---|---|---|
| Drawing Title: FIRST FLOOR PLAN NORTH ASBESTOS | Project Title: Asbestos Drawings | | Date: 11-17-11 |
| | | | Project No. |
| Approved: | Building Number: 06 | Checked | Drawn |
| Approved: | Location: VAMC WASHINGTON, DC | | Drawing No. H6-4 |

VAMC, Washington, D.C.

VA Department of Veterans Affairs

VA FORM 08-6231, OCT 1978

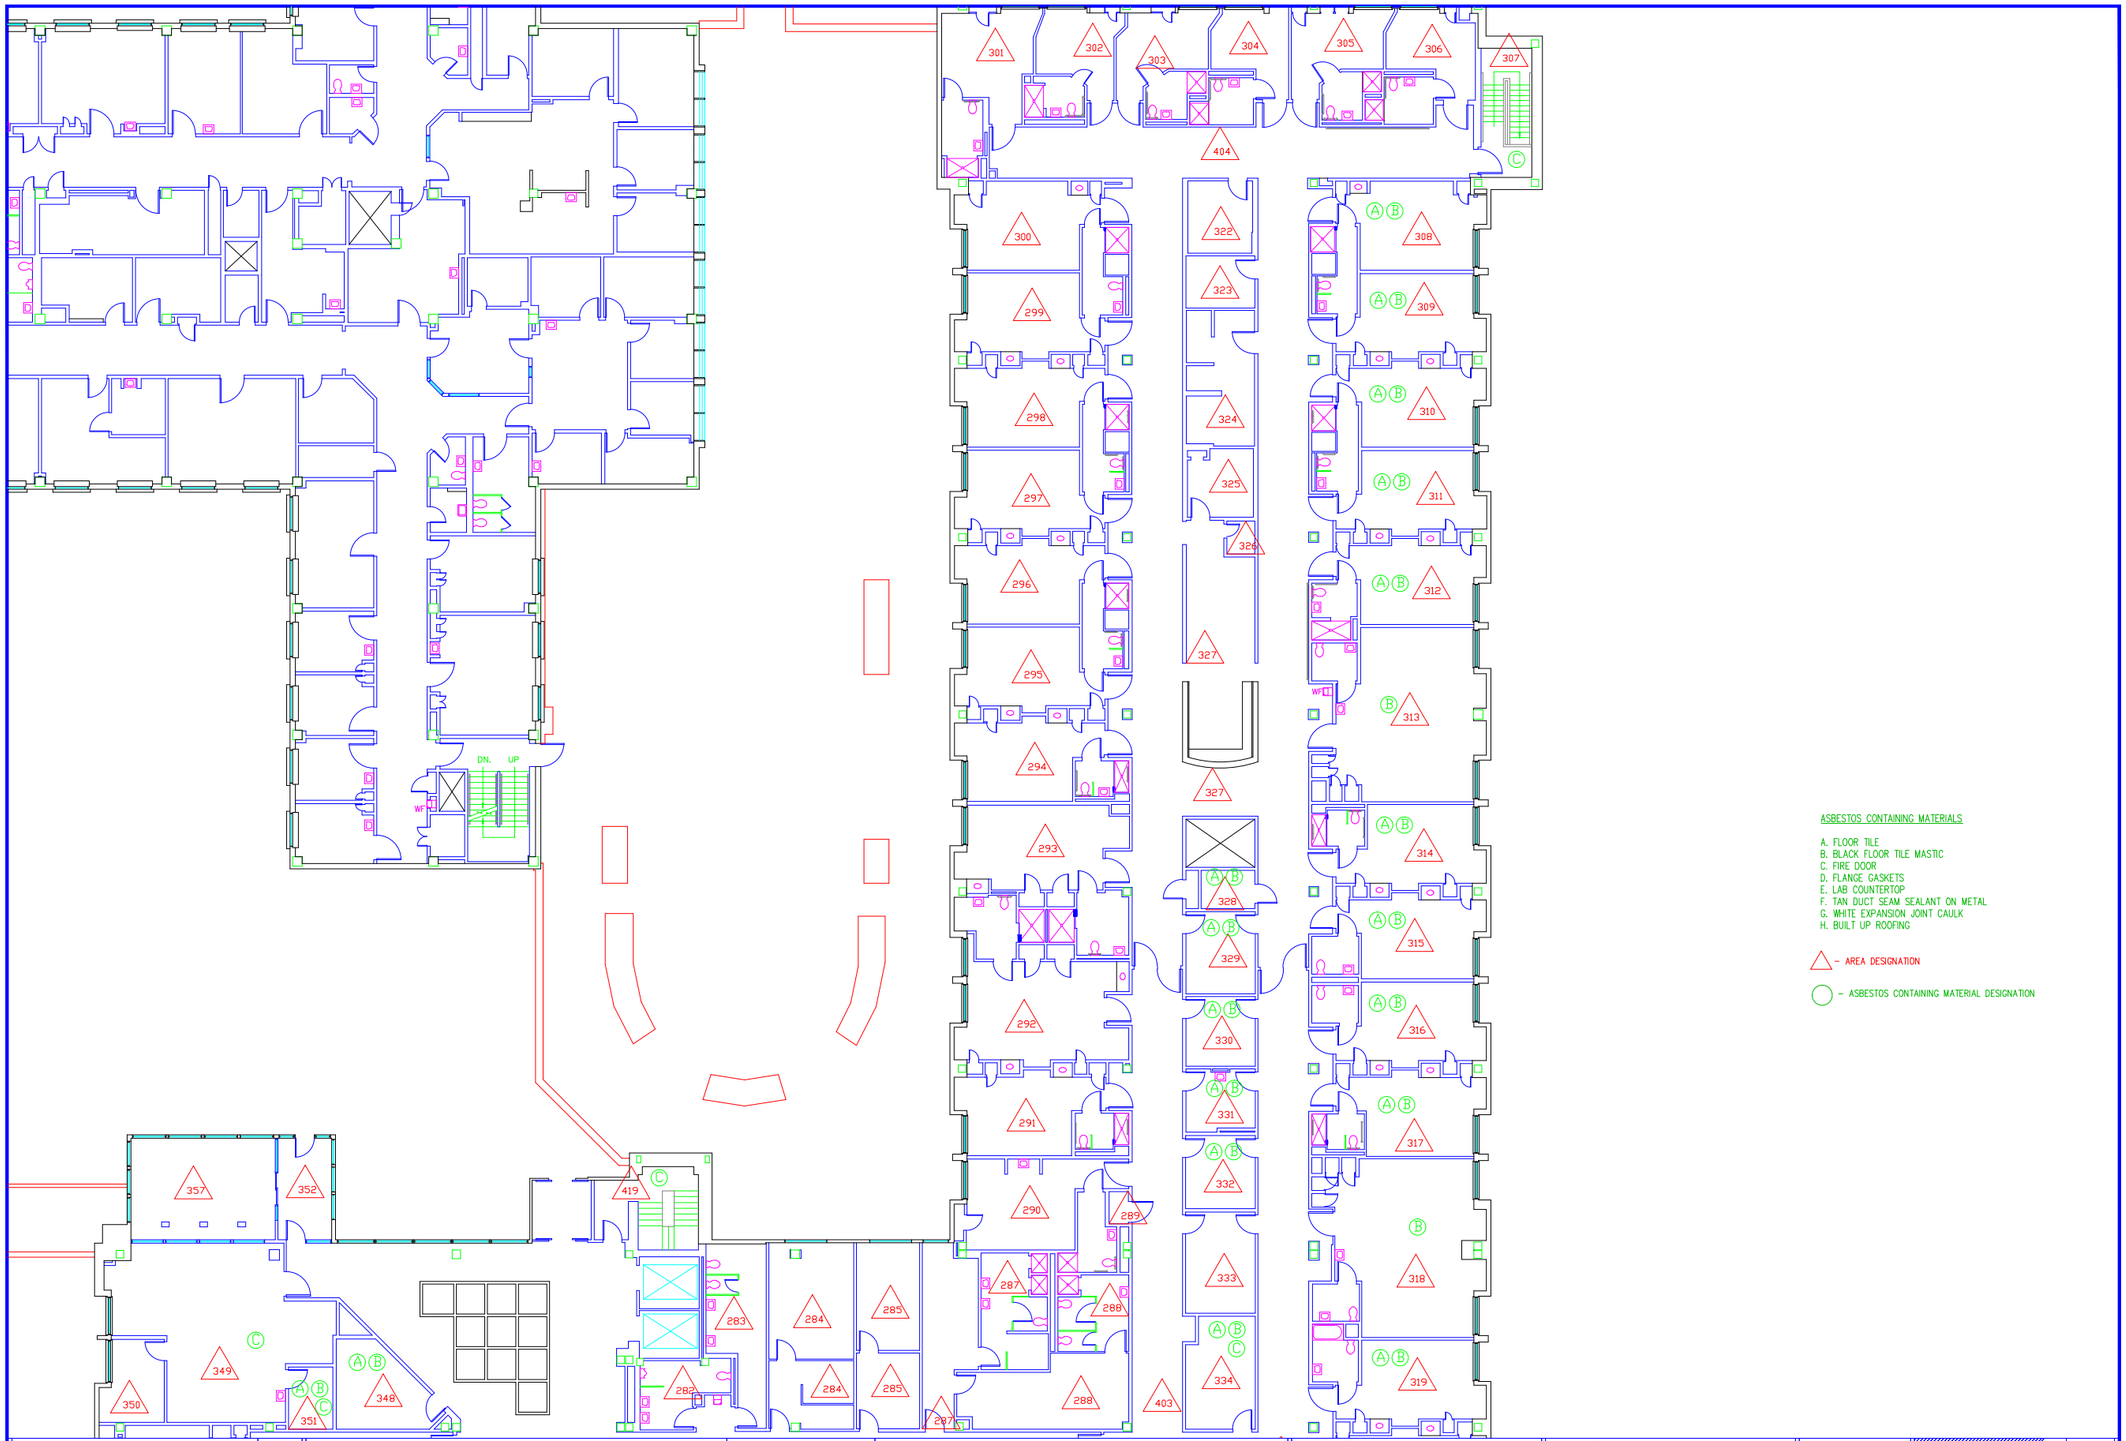


ASBESTOS CONTAINING MATERIALS

A. FLOOR TILE
B. BLACK FLOOR TILE MASTIC
C. FIRE DOOR
D. FLANGE GASKETS
E. LAB COUNTERTOP
F. TAN DUCT SEAM SEALANT ON METAL
G. WHITE EXPANSION JOINT CAULK
H. BUILT UP ROOFING

△ – AREA DESIGNATION

○ – ASBESTOS CONTAINING MATERIAL DESIGNATION

| Revisions | Date |
|---|---|
| | |

AEROSOL MONITORING & ANALYSIS, INC.
1351 ASHTON ROAD, P.O. BOX 646
HANOVER, MARYLAND 21076
WEBSITE: WWW.AMACONSULTING.COM
PHONE: 410-684-3327
FAX: 410-684-3384

Professional Seal

Drawing Title
SECOND FLOOR PLAN
NORTH ASBESTOS

Approved:

Approved:

Project Title
Asbestos Drawings

Building Number 06

Checked

Drawn

Location VAMC WASHINGTON, DC

Date 11-17-11

Project No.

Drawing No. H6-5

VAMC WASHINGTON, D.C.

VA Department of Veterans Affairs

VA FORM 08-6231, OCT 1978

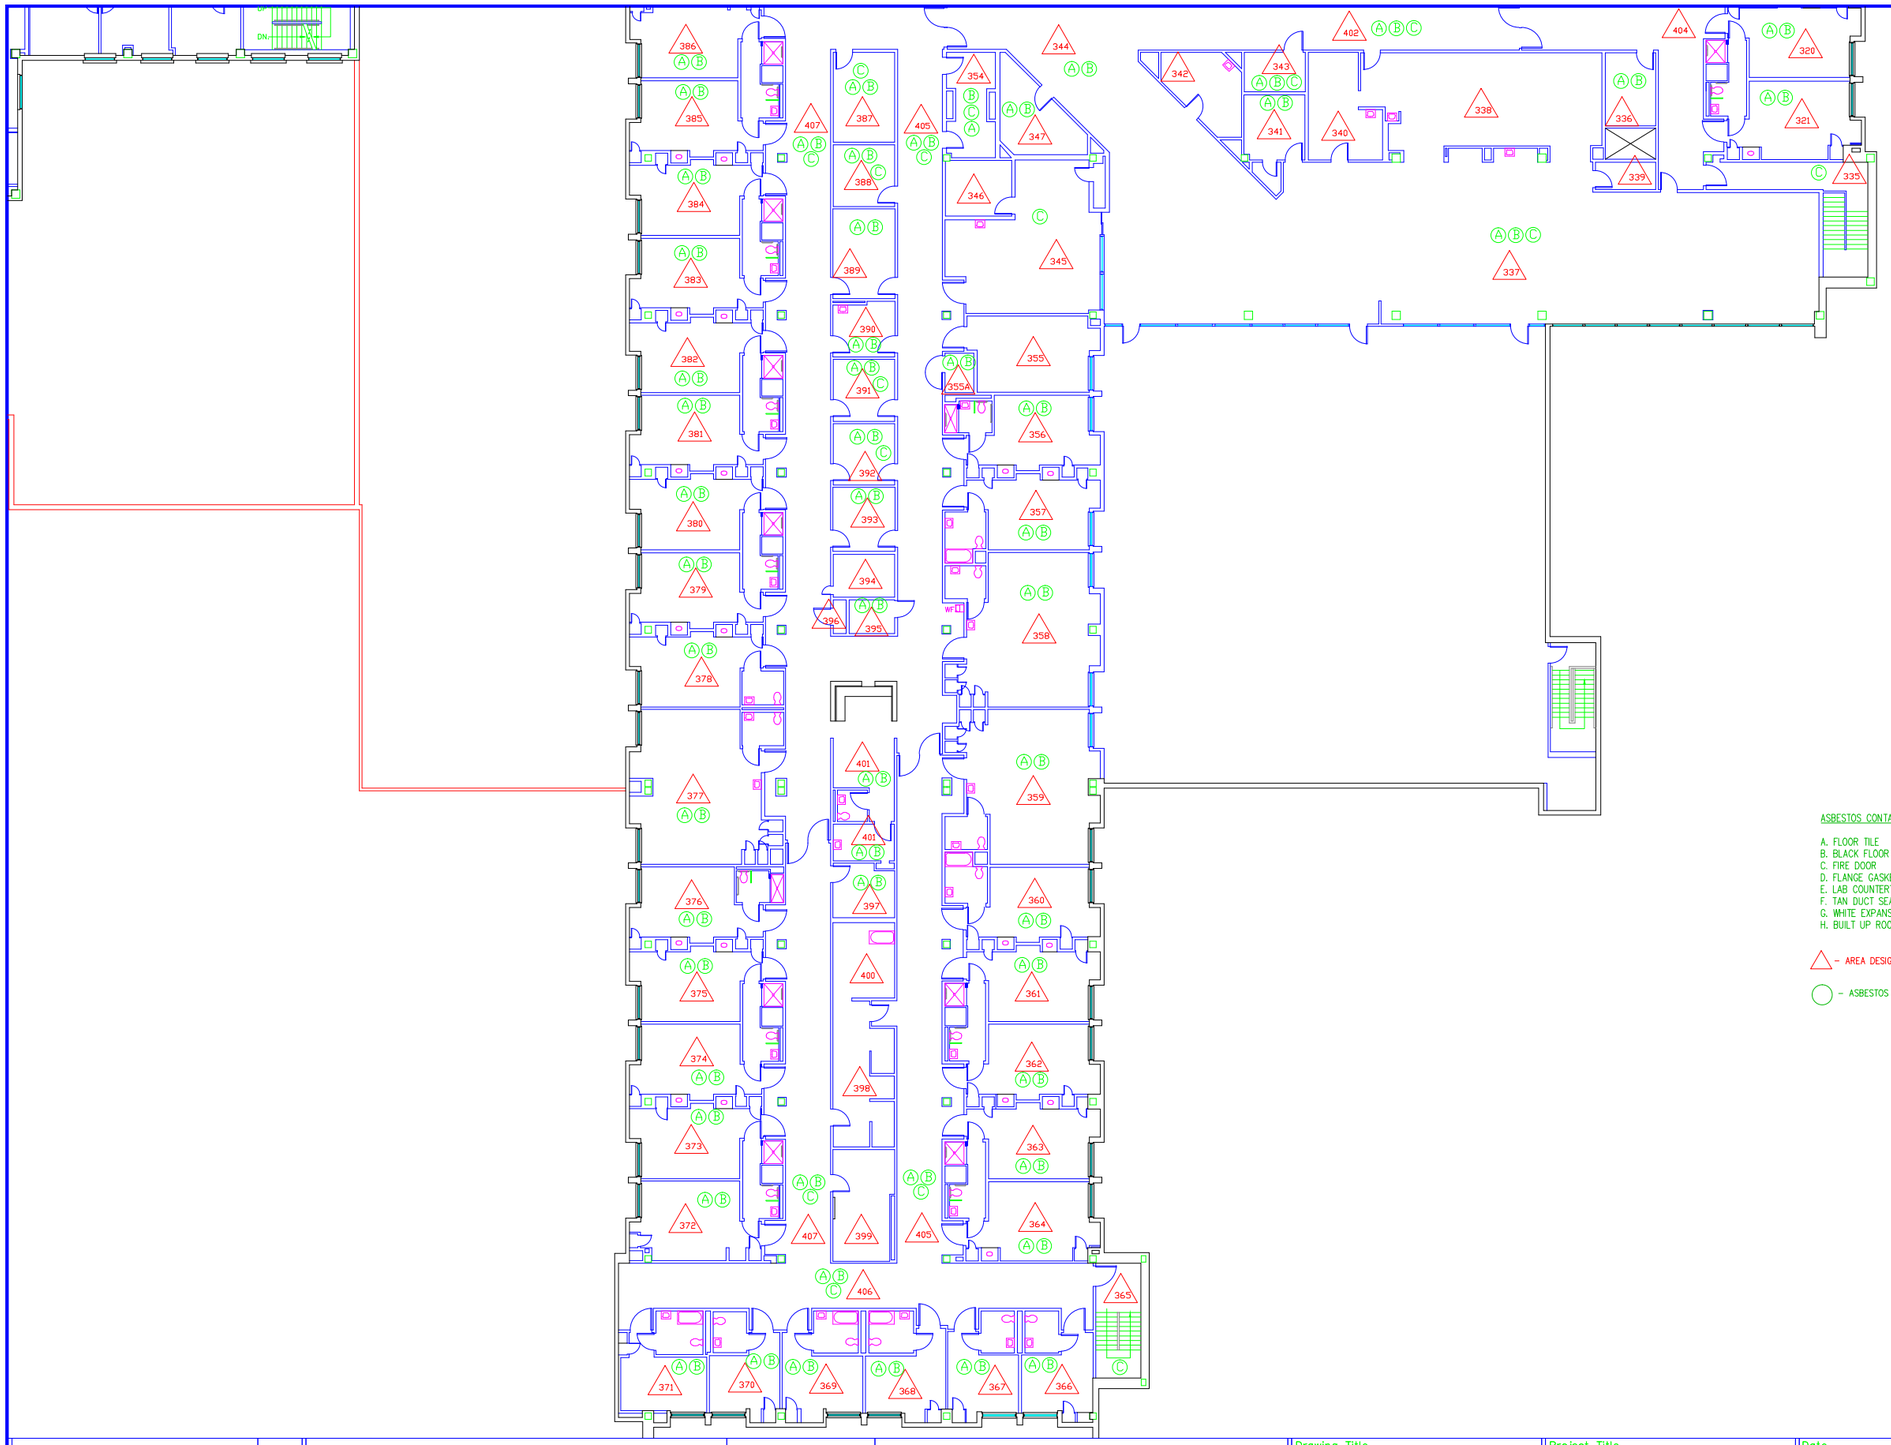

ASBESTOS CONTAINING MATERIALS

A. FLOOR TILE
B. BLACK FLOOR TILE MASTIC
C. FIRE DOOR
D. FLANGE GASKETS
E. LAB COUNTERTOP
F. TAN DUCT SEAM SEALANT ON METAL
G. WHITE EXPANSION JOINT CAULK
H. BUILT UP ROOFING

△ – AREA DESIGNATION

○ – ASBESTOS CONTAINING MATERIAL DESIGNATION

| Revisions | Date |
|---|---|
| | |

AEROSOL MONITORING & ANALYSIS, INC.
1331 ASHTON ROAD, P.O. BOX 646
HANOVER, MARYLAND 21076
WEBSITE: WWW.AMACONSULTING.COM
PHONE: 410-684-3327
FAX: 410-684-3384

Professional Seal

| | | | |
|---|---|---|---|
| Drawing Title: SECOND FLOOR PLAN SOUTH ASBESTOS | Project Title: Asbestos Drawings | | Date: 11-17-11 |
| | | | Project No. |
| Approved: | Building Number: 06 | Checked | Drawn |
| Approved: | Location: VAMC WASHINGTON, DC | | Drawing No.: H6-6 |

VA Department of Veterans Affairs

VA FORM 08-6231, OCT 1978

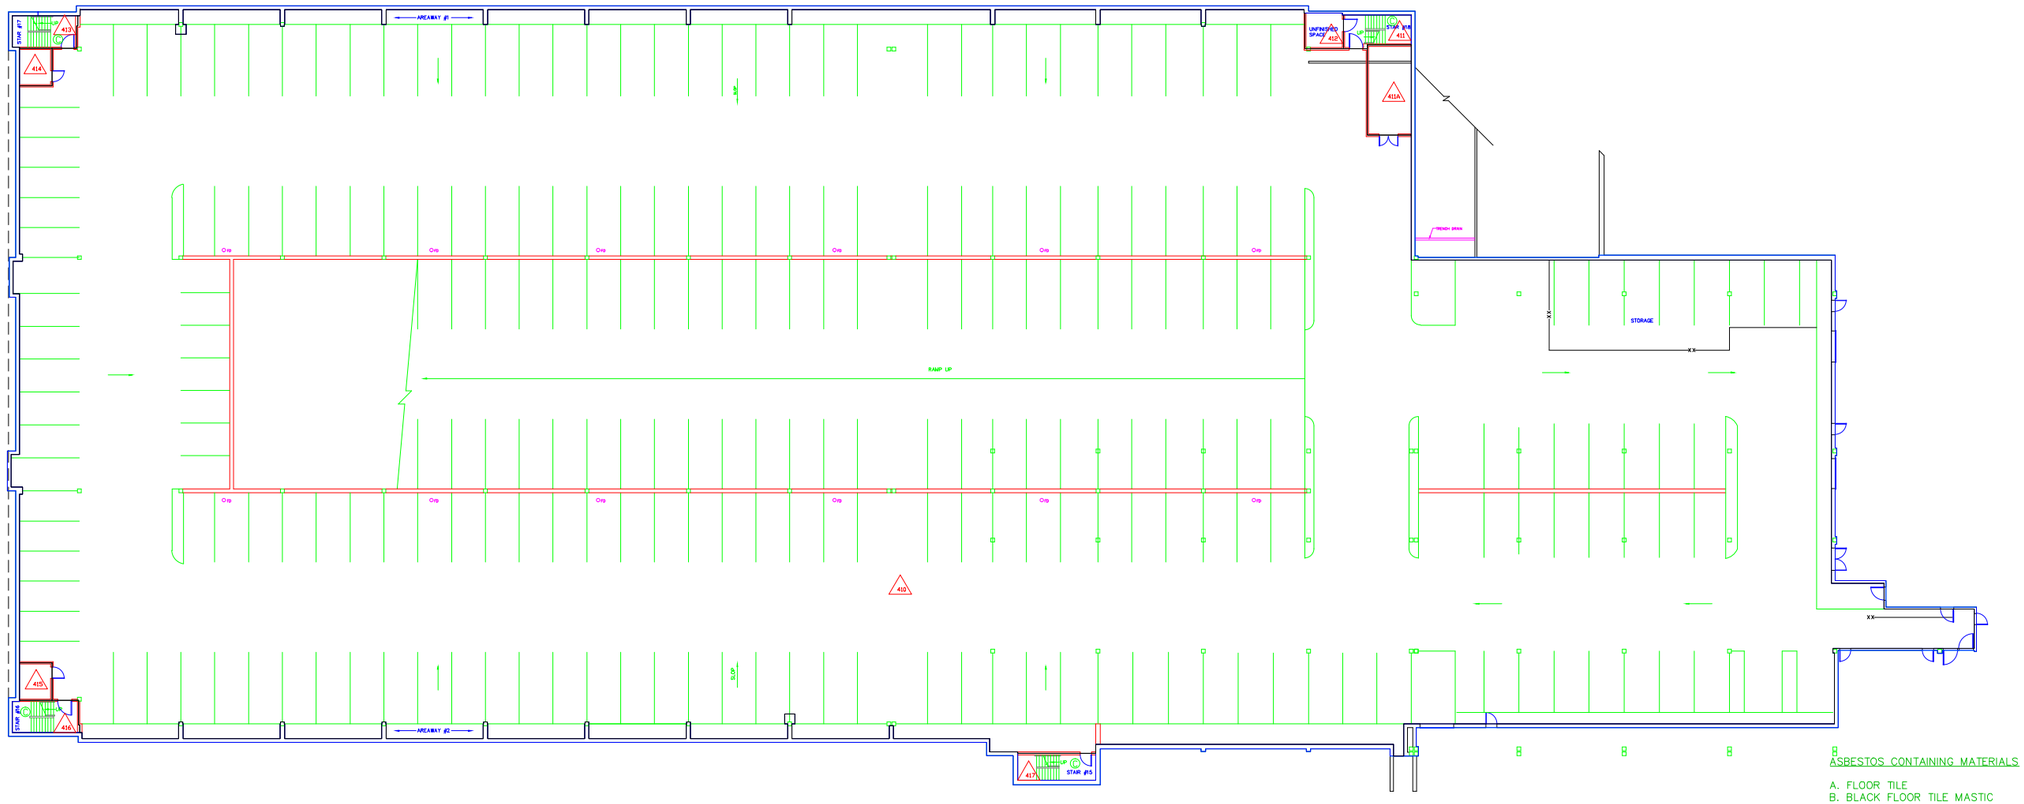


ASBESTOS CONTAINING MATERIALS

A. FLOOR TILE
B. BLACK FLOOR TILE MASTIC
C. FIRE DOOR
D. FLANGE GASKETS
E. LAB COUNTERTOP
F. TAN DUCT SEAM SEALANT ON METAL
G. WHITE EXPANSION JOINT CAULK
H. BUILT UP ROOFING

△ – AREA DESIGNATION

○ – ASBESTOS CONTAINING MATERIAL DESIGNATION

| Revisions | Date |
|---|---|
| | |

AEROSOL MONITORING & ANALYSIS, INC.
1331 ASHTON ROAD, P.O. BOX 648
HANOVER, MARYLAND 21076
WEBSITE: WWW.AMACORGLOBAL.COM
PHONE: 410-684-5327
FAX: 410-684-5384

Professional Seal

| Drawing Title | Project Title | Date |
|---|---|---|
| FIRST LEVEL PLAN GARAGE ASBESTOS | Asbestos Drawing | 11-17-11 |
| Approved: | Building Number 06-PG / Checked / Drawn | Project No. |
| Approved: | Location VAMC WASHINGTON, DC | Drawing No. H6-7 |

VAMC, Washington, D.C.

VA Department of Veterans Affairs

VA FORM 08-6231, OCT 1978

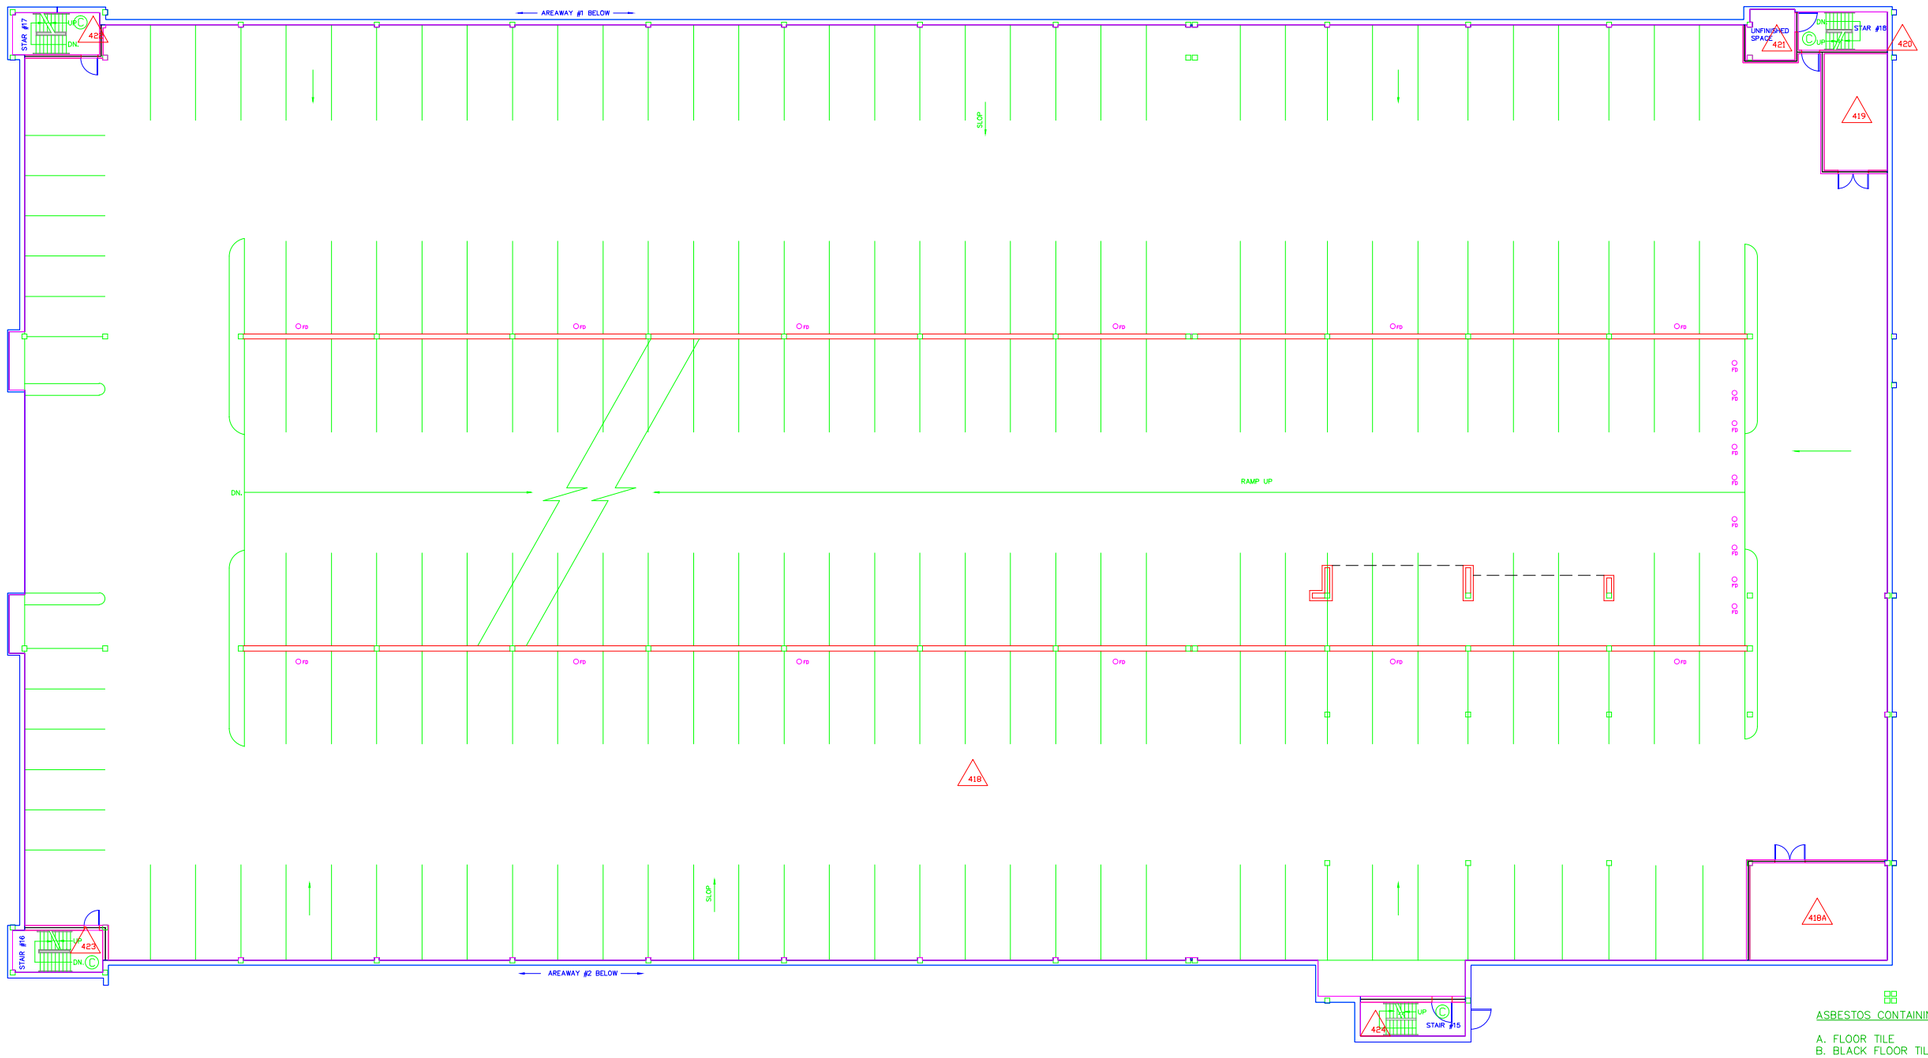


ASBESTOS CONTAINING MATERIALS

A. FLOOR TILE
B. BLACK FLOOR TILE MASTIC
C. FIRE DOOR
D. FLANGE GASKETS
E. LAB COUNTERTOP
F. TAN DUCT SEAM SEALANT ON METAL
G. WHITE EXPANSION JOINT CAULK
H. BUILT UP ROOFING

△ – AREA DESIGNATION

○ – ASBESTOS CONTAINING MATERIAL DESIGNATION

| Revisions | Date |
|---|---|
| | |

AEROSOL MONITORING & ANALYSIS, INC.
1551 ASHTON ROAD, P.O. BOX 548
HANOVER, MARYLAND 21076
WEBSITE: WWW.AMACONSULTING.COM
PHONE: 410-684-5327
FAX: 410-684-3384

Professional Seal

| | |
|---|---|
| Drawing Title | SECOND LEVEL PLAN GARAGE ASBESTOS |
| Approved: | |
| Approved: | |
| Project Title | Asbestos Drawings |
| Building Number | 06-PG |
| Checked | |
| Drawn | |
| Location | VAMC WASHINGTON, DC |
| Date | 11-17-11 |
| Project No. | |
| Drawing No. | H6-8 |

VAMC, Washington, D.C.

VA Department of Veterans Affairs

VA FORM 08-6231, OCT 1978

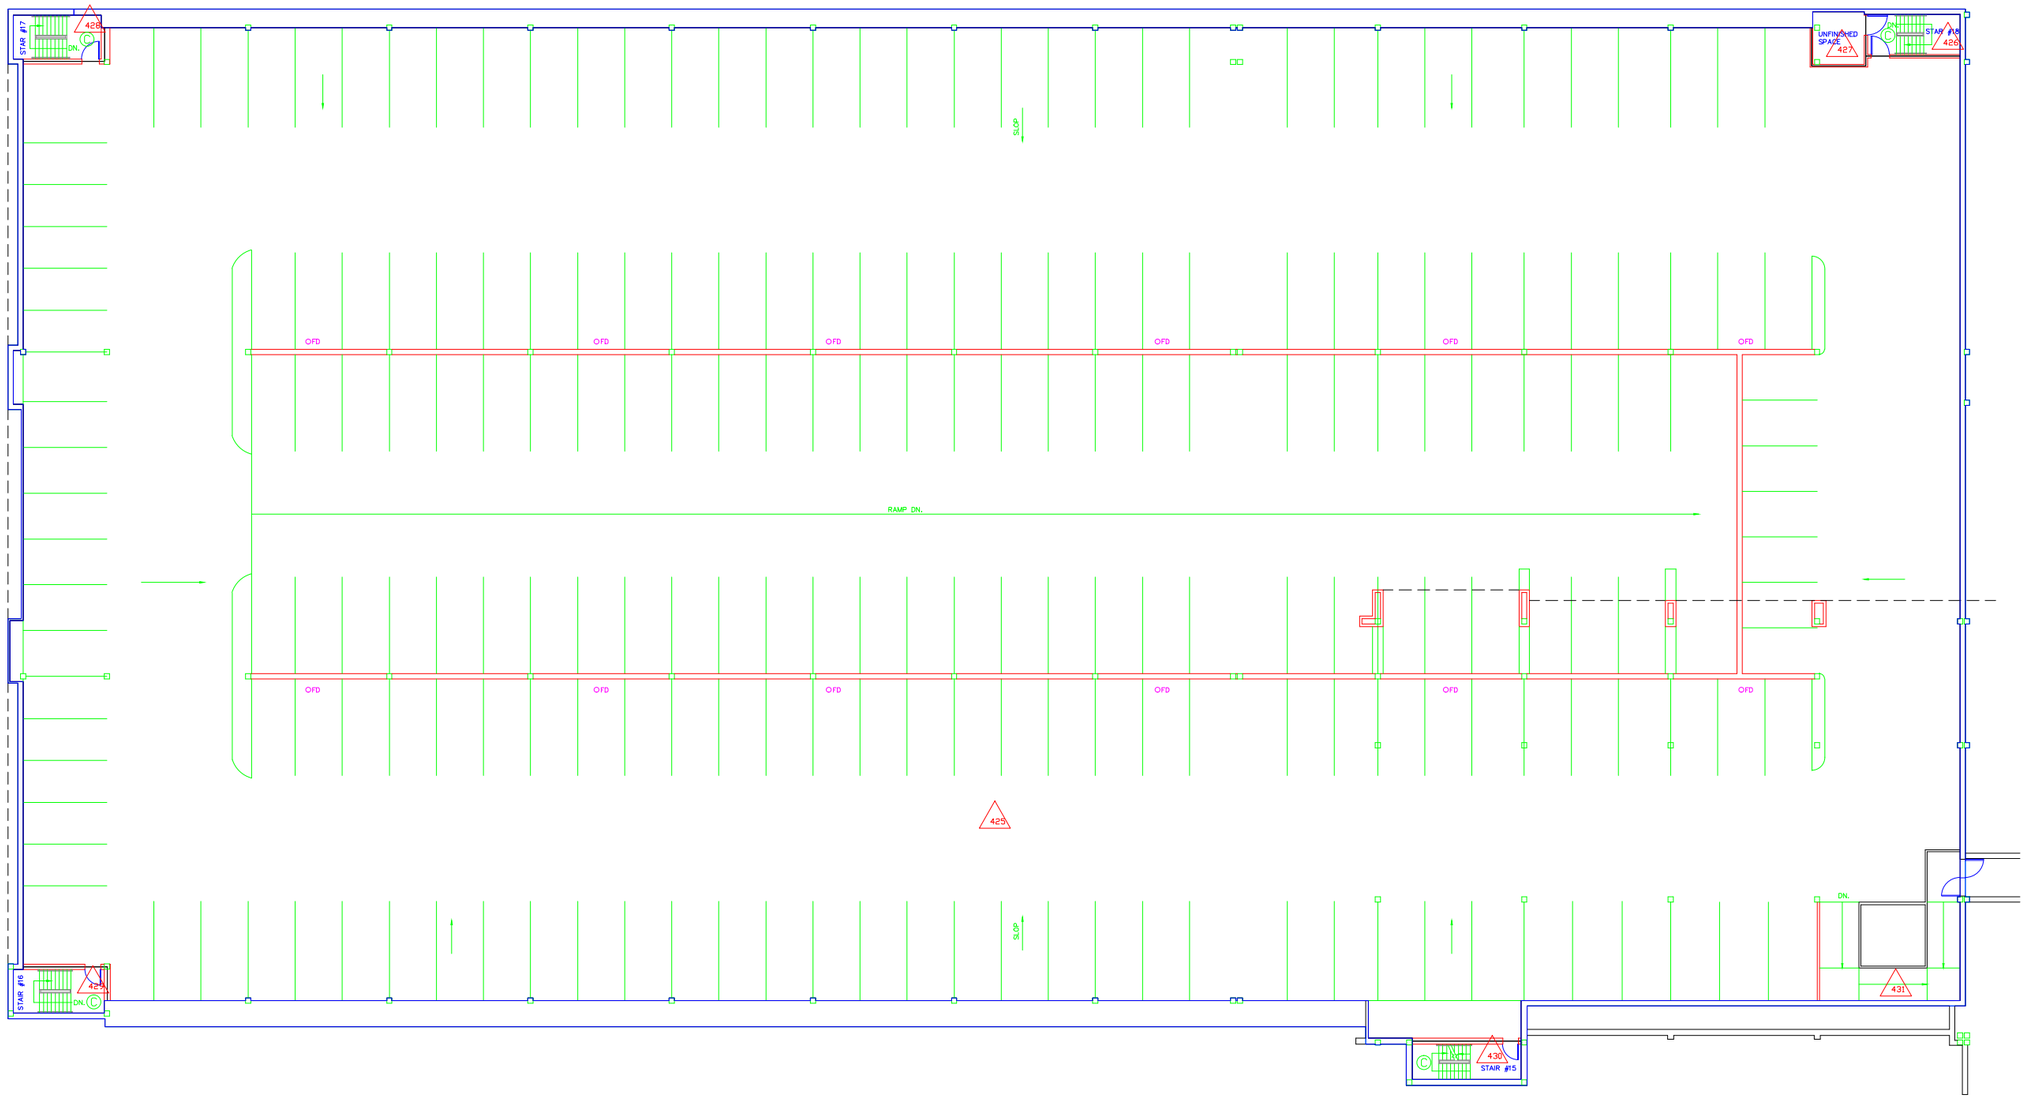


ASBESTOS CONTAINING MATERIALS

A. FLOOR TILE
B. BLACK FLOOR TILE MASTIC
C. FIRE DOOR
D. FLANGE GASKETS
E. LAB COUNTERTOP
F. TAN DUCT SEAM SEALANT ON METAL
G. WHITE EXPANSION JOINT CAULK
H. BUILT UP ROOFING

△ – AREA DESIGNATION

○ – ASBESTOS CONTAINING MATERIAL DESIGNATION

| Revisions | Date |
|---|---|
| | |

AEROSOL MONITORING & ANALYSIS, INC.
1331 ASHTON ROAD, P.O. BOX 646
HANOVER, MARYLAND 21076
WEBSITE: WWW.AMCINSULTING.COM
PHONE: 410-684-3327
FAX: 410-684-3584

Professional Seal

| Drawing Title | Project Title | Date |
|---|---|---|
| THIRD LEVEL PLAN GARAGE ASBESTOS | Asbestos Drawings | 11-17-11 |
| Approved: | Building Number 06-PG; Checked; Drawn | Project No. |
| Approved: | Location VAMC WASHINGTON, DC | Drawing No. H6-9 |

VAMC, Washington, D.C.

VA Department of Veterans Affairs

VA FORM 08-6231, OCT 1978