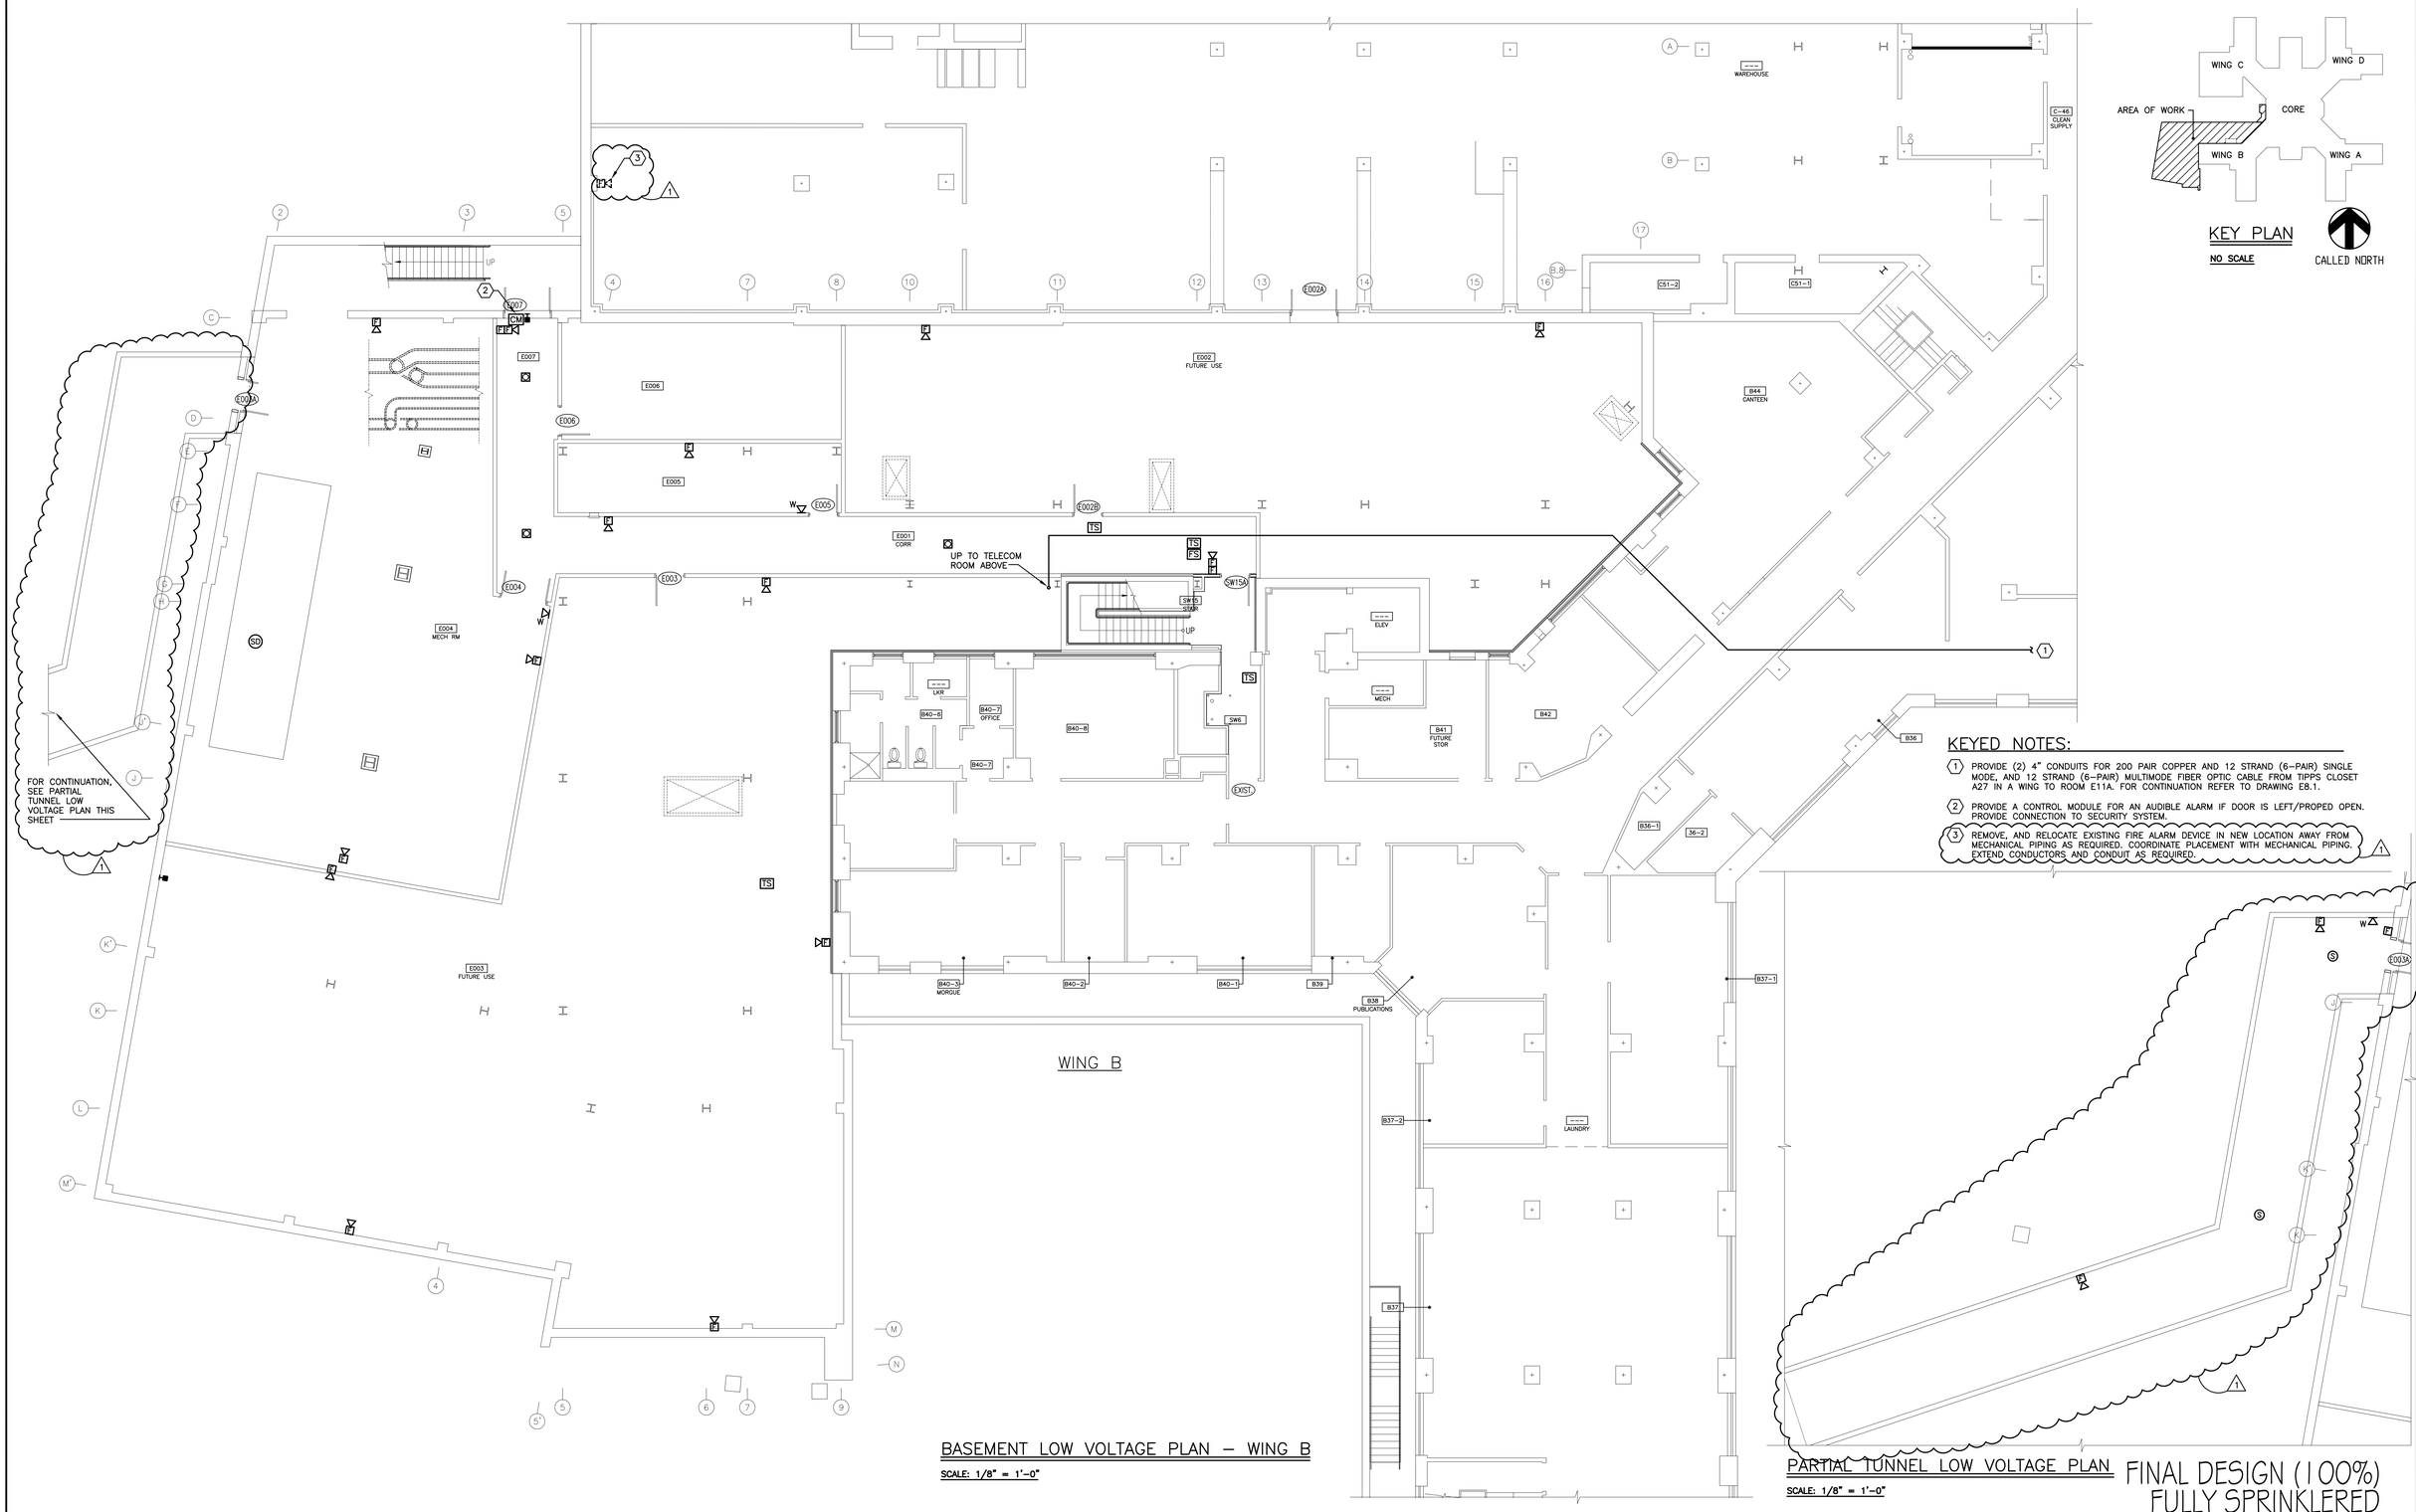

KEYED NOTES:

1. PROVIDE (2) 4" CONDUITS FOR 200 PAIR COPPER AND 12 STRAND (6-PAIR) SINGLE MODE, AND 12 STRAND (6-PAIR) MULTIMODE FIBER OPTIC CABLE FROM TIPPS CLOSET A27 IN A WING TO ROOM E11A. FOR CONTINUATION REFER TO DRAWING E8.1.
2. PROVIDE A CONTROL MODULE FOR AN AUDIBLE ALARM IF DOOR IS LEFT/PROPED OPEN. PROVIDE CONNECTION TO SECURITY SYSTEM.
3. REMOVE, AND RELOCATE EXISTING FIRE ALARM DEVICE IN NEW LOCATION AWAY FROM MECHANICAL PIPING AS REQUIRED. COORDINATE PLACEMENT WITH MECHANICAL PIPING. EXTEND CONDUCTORS AND CONDUIT AS REQUIRED.

BASEMENT LOW VOLTAGE PLAN – WING B

SCALE: 1/8" = 1'-0"

FINAL DESIGN (100%)
FULLY SPRINKLERED

FFA #7451

Revisions	Date
1 ADDENDUM #1	7/24/12

CONSULTANTS:

Quality Service Since 1944
FRIEDMAN FISHER ASSOCIATES, P.C.
CONSULTING ENGINEERS
22 Aviation Road, Albany, New York 12205
TEL (518) 458-7040 FAX (518) 458-7043
mail@friedmanfisher.com

RYAN-BIGGS ASSOCIATES, P.C.
291 River Street p 518 272.6266
Troy, NY 12180 f 518 272.4467
www.ryanbiggs.com

EBERLIN AND EBERLIN, P.C.
247 ROUTE 100 SUITE 1003 SOMERS NEW YORK 10589
CONSULTING ENGINEERS, PLANNERS, LANDSCAPE ARCHITECTS
914.232.9431 PHONE 914.232.6827 FAX

LICENSED PROFESSIONAL ENGINEER — 049383 — STATE OF NEW YORK

ARCHITECT/ENGINEERS:

Hyman Hayes
ASSOCIATES
6 WEMBLEY COURT, ALBANY, NEW YORK 12205
(518) 452-3470 (518) 452-3783 Fax
HHA Proj. 10046

Drawing Title: ELECTRICAL: BASEMENT LOW VOLTAGE PLAN-WING B
Approved: Project Director
Project Title: NEW EMERGENCY DEPARTMENT Stratton VA Medical Center
Location: Albany, New York
Date: JULY 24, 2012 | Checked: JLM | Drawn: MLS
Project Number: VA 528-809
Building Number: 95
Drawing Number: E7.1
Dwg. 107 of 115

Office of Construction and Facilities Management
Department of Veterans Affairs

VA FORM 08-6231