
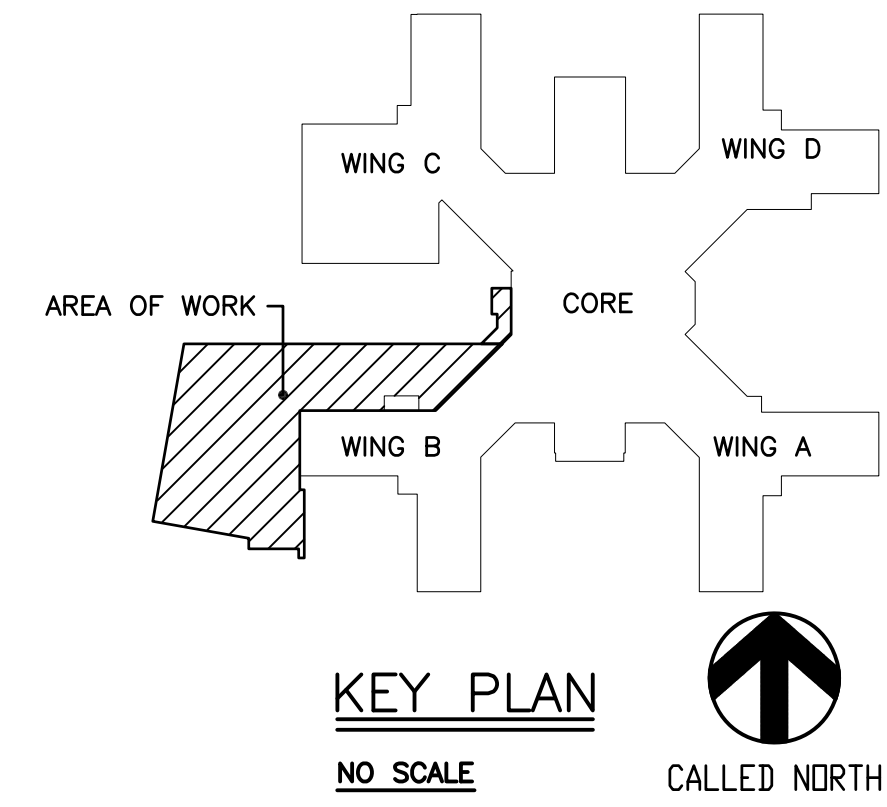


three inches = one foot
one and one half inches = one foot
one inch = one foot
three quarters inch = one foot
one half inch = one foot
three eighths inch = one foot
one quarter inch = one foot
one eighth inch = one foot

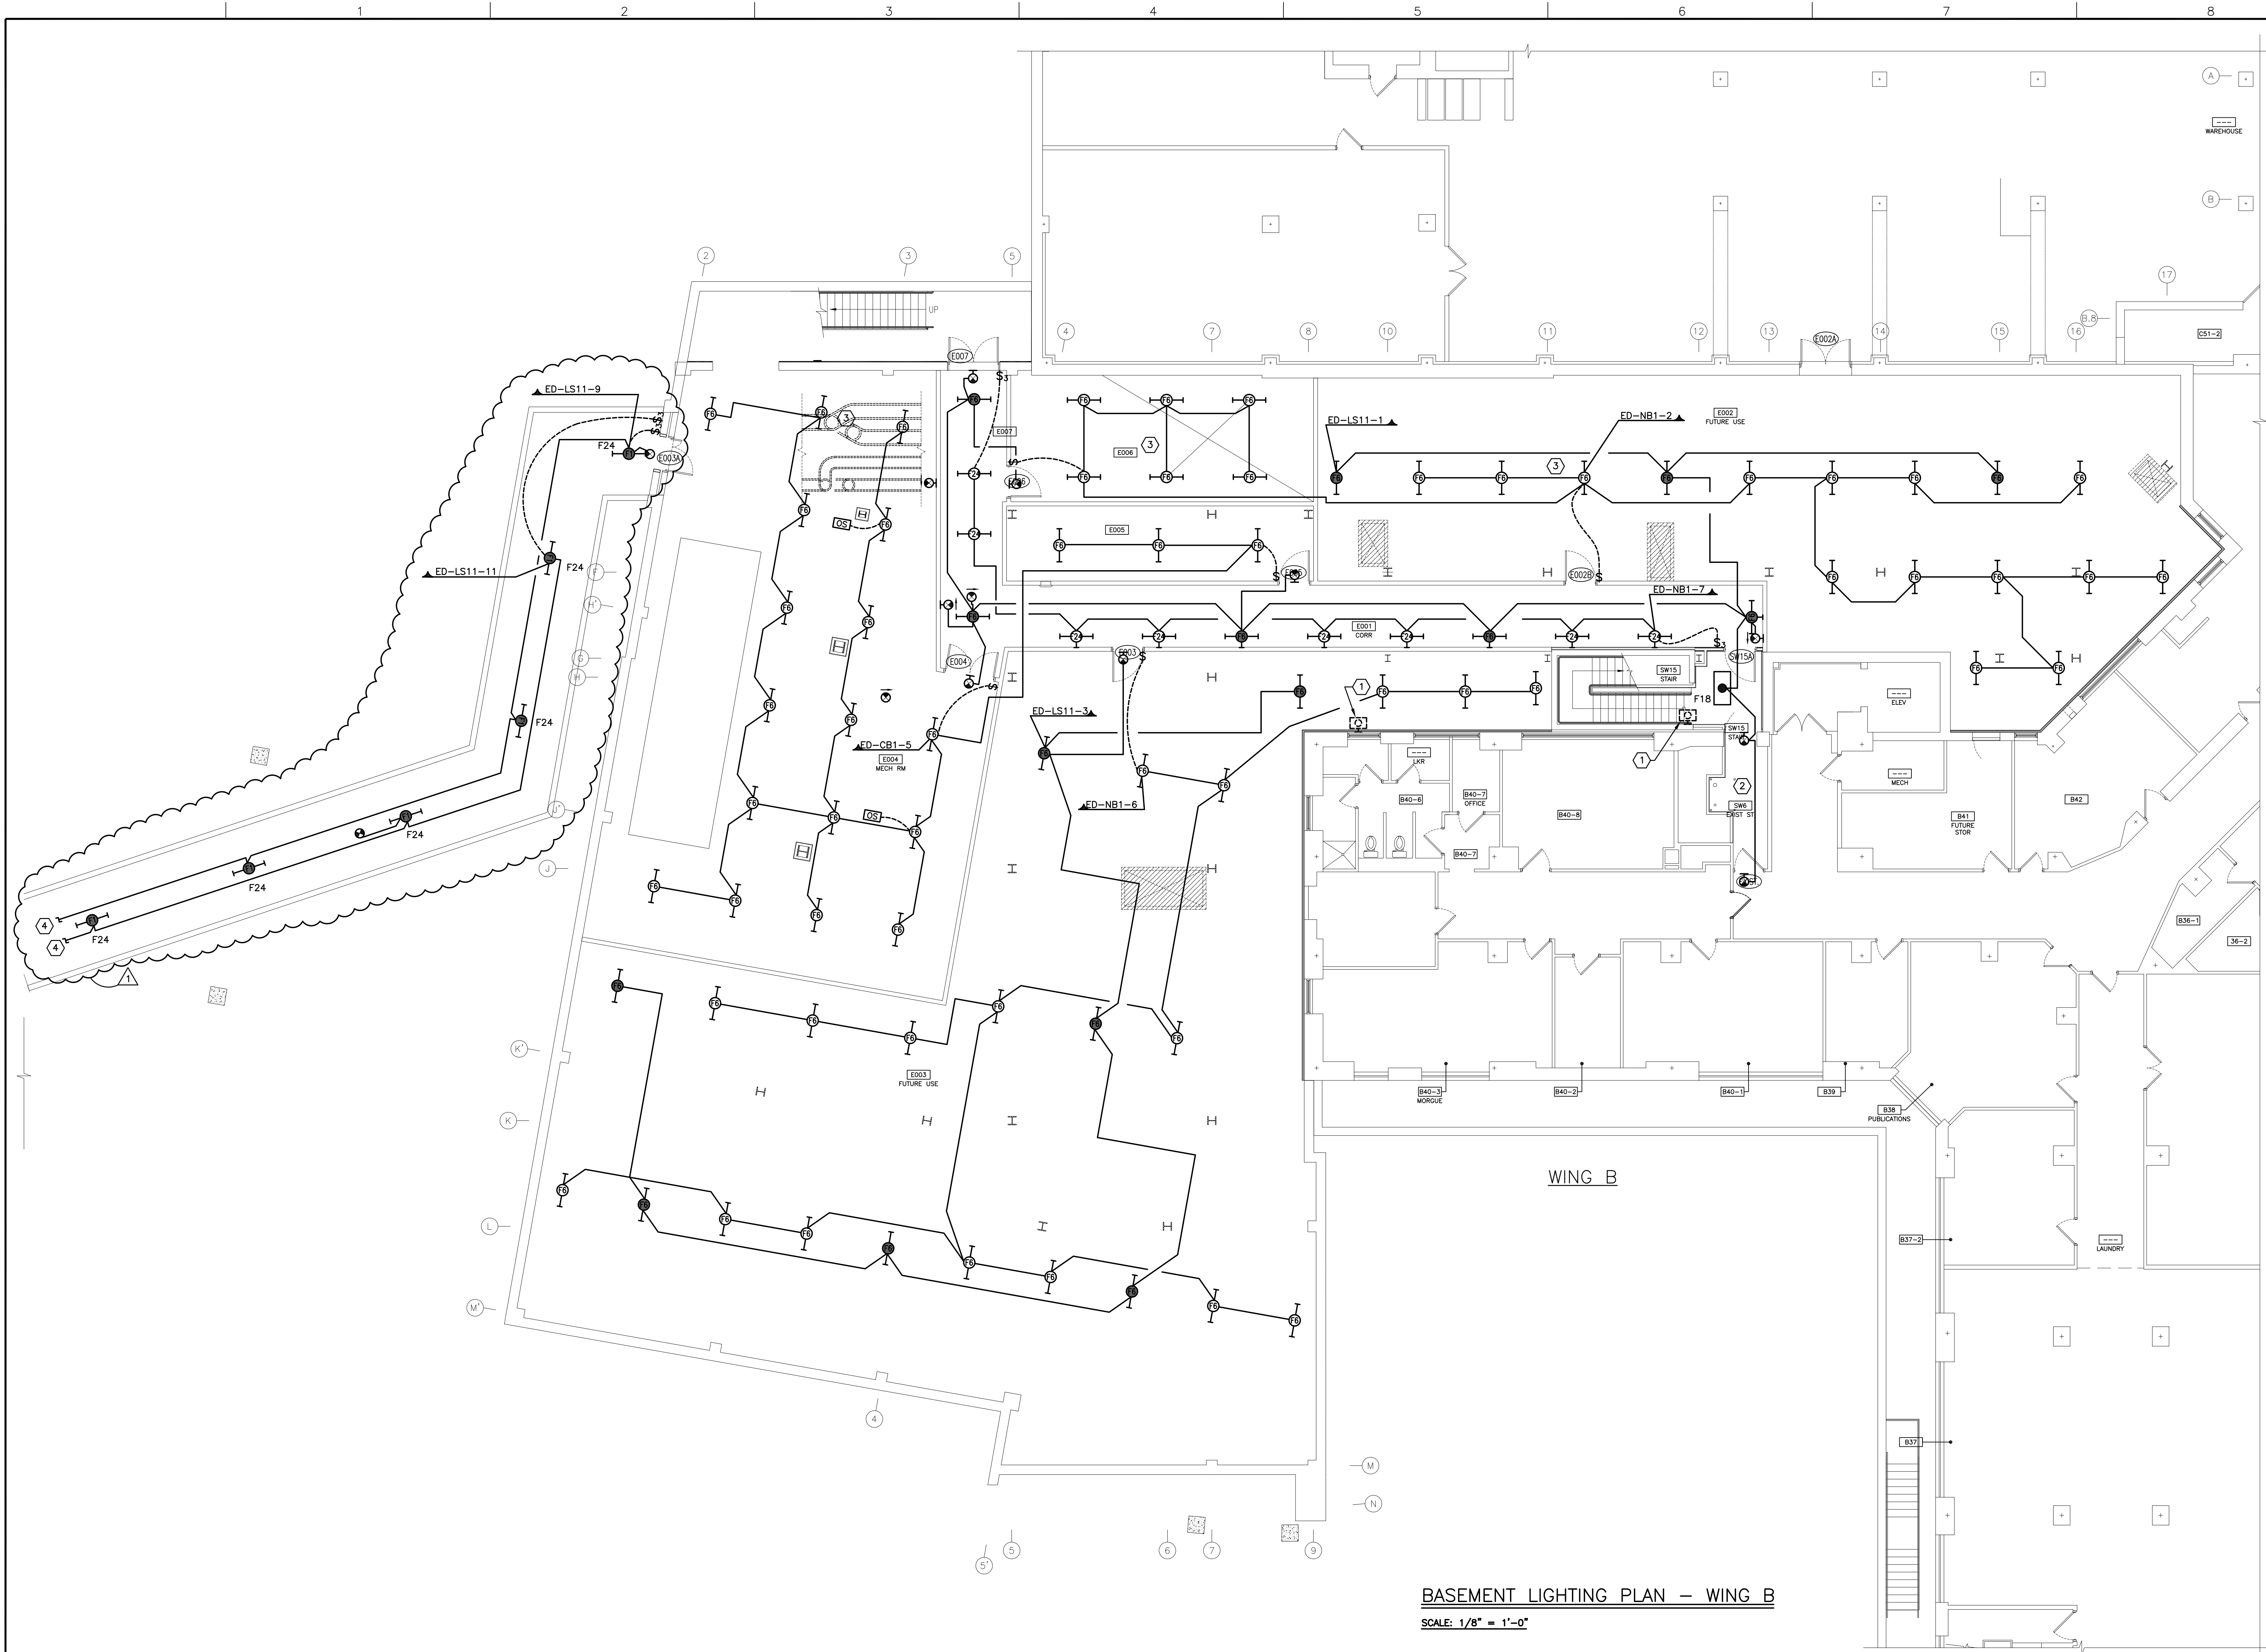

GENERAL NOTES:
1. REFER TO FIXTURE SCHEDULE ON DRAWING E1.1.

KEYED NOTES:
1. DISCONNECT AND REMOVE EXISTING WALL PACKS AND ASSOCIATED WIRING AND CONDUIT BACK TO SOURCE. TURN EXISTING FIXTURE OVER TO VA REPRESENTATIVE FOR THEIR USE.
2. EXISTING LIGHT FIXTURE IN THIS AREA SHALL REMAIN. REMOVE EXISTING EXIT LIGHT AND REPLACE WITH NEW. EXTEND EXISTING EMERGENCY CIRCUIT TO NEW EXIT LIGHTS AS REQUIRED.
3. IF DEDUCT ALTERNATE #10 IS NOT TAKEN MOUNT LIGHTING FIXTURES UNDER MECHANICAL PIPING. COORDINATE LOCATIONS WITH MECHANICAL PIPING. REFER TO MECHANICAL PLAN M11.1 FOR PIPING LOCATIONS.
4. FOR CONTINUATION OF CIRCUIT REFER TO VA REPAIR HOT WATER LINES PROJECT DRAWINGS.

BASEMENT LIGHTING PLAN - WING B
SCALE: 1/8" = 1'-0"

FINAL DESIGN (100%)
FULLY SPRINKLERED

FFA #7451

		CONSULTANTS:				ARCHITECT/ENGINEERS:		<div>Drawing Title ELECTRICAL: BASEMENT LIGHTING & DEMO PLAN- WING B</div> <div>Approved Project Director</div>		<div>Project Title NEW EMERGENCY DEPARTMENT Stratton VA Medical Center</div> <div>Location Albany, New York</div> <div>Date JULY 24, 2012</div>		<div>Project Number VA 528-809</div> <div>Building Number 95</div> <div>Drawing Number E2.1 Dwg. 102 of 115</div>		<div>Office of Construction and Facilities Management</div> <div> Department of Veterans Affairs</div>					
		<div>FRIEDMAN FISHER ASSOCIATES, P.C. CONSULTING ENGINEERS 22 AVENUE ROAD, ALBANY, NEW YORK 12205 TEL (518) 458-7040 FAX (518) 458-7043 mail@friedmanfisher.com</div> <div>EBERLIN AND EBERLIN, P.C. 247 ROUTE 100 SUITE 1003 SOMERS NEW YORK 10589 CONSULTING ENGINEERS, PLANNERS, LANDSCAPE ARCHITECTS 914.232.9431 PHONE 914.232.6827 FAX</div>		<div>RYAN-BIGGS ASSOCIATES, P.C. 291 River Street p 518 272.6266 Troy, NY 12180 f 518 272.4467 www.ryanbiggs.com</div>		<div></div>		<div>Hyman Hayes ASSOCIATES 6 WEMBLEY COURT, ALBANY, NEW YORK 12205 (518) 452-3470 (518) 452-3783 Fax HHA Proj. 10046</div>											
<div> ADDENDUM #1 Revisions:</div>		<div>Date 7/24/12</div>																	
VA FORM 08-6231		1		2		3		4		5		6		7		8		9	