



LIFE SAFETY SCHEDULE		
CODE	NFPA 101	ACTUAL / REMARKS (IF APPLICABLE)
CATEGORY	NEW HEALTH CARE CHAPTER 18	NYS: I-2 (TUNNEL = U)
OCCUPANCY	NEW HEALTH CARE CHAPTER 18	NYS: 1A (332)
CONSTRUCTION TYPE	I (332)	
MAX. TRAVEL DISTANCE	200' (BLDG. SPRINKLERED) 300' (TUNNEL)	COMPLIES, SEE LIFE SAFETY PLAN
MAXIMUM DEAD END CORRIDOR	20'	COMPLIES (8')
MINIMUM CORRIDOR WIDTH	8'-0" PATIENT AREAS 3'-8" STAFF AREAS	COMPLIES (8'-0" MIN. AT PATIENT STRETCHER AREAS, 4'-0" MIN. @ STAFF AREAS)
RATINGS- CORRIDORS	NO RATING REQUIRED LIMIT THE TRANSFER OF SMOKE	COMPLIES
RATINGS- FLOORS	2 HR. MINIMUM FLOOR ASSEMBLY RATING	COMPLIES (2-HOUR)
RATINGS- STAIRS	2 HR-4 STORIES & MORE 1 HR-3 STORIES & LESS	COMPLIES (2-HOUR)
RATINGS- SHAFTS	2 HR-4 STORIES & MORE 1 HR-3 STORIES & LESS BUT NOT LESS THAN FLOOR RATING	COMPLIES (2-HOUR)
MAXIMUM SMOKE COMPARTMENT AREA	22,500 GSF	COMPLIES (12,200 SF)
MAXIMUM SMOKE COMPARTMENT TRAVEL DISTANCE	200'	COMPLIES (195 SF)
RATING - SOILED	1-HR	COMPLIES
RATING- STORAGE >= 100 SF	1-HR	COMPLIES

NOTE:  
THIS DRAWING IS ISSUED FOR INFORMATION AND COORDINATION PURPOSES ONLY. ITEMS INDICATED ON THIS DRAWING ARE NOT INCLUDED IN THE CONTRACT UNLESS INDICATED ON OTHER DRAWINGS.

LEGEND:

- SMOKE PARTITION - NO RATING REQUIRED. LIMIT THE TRANSFER OF SMOKE.
- 1 HOUR FIRE BARRIER WALL (45 MINUTE DOOR)
- 2 HOUR FIRE BARRIER (1 1/2 HR DOOR AND FIRE DAMPERS)
- 3 HOUR FIRE BARRIER (1 1/2 HR DOOR AND FIRE DAMPERS)
- FEC FIRE EXTINGUISHER CABINET (SEE A2 FLOOR PLANS FOR SPECIFIC LOCATIONS)
- EXIT
- EXISTING BUILDING AREA TO REMAIN (NOT IN CONTRACT)
- EXIT SIGN
- 1-HOUR (MINIMUM) FIRE RATED SMOKE BARRIER

SEE SPECIFICATIONS FOR FIREPROOFING REQUIREMENTS.

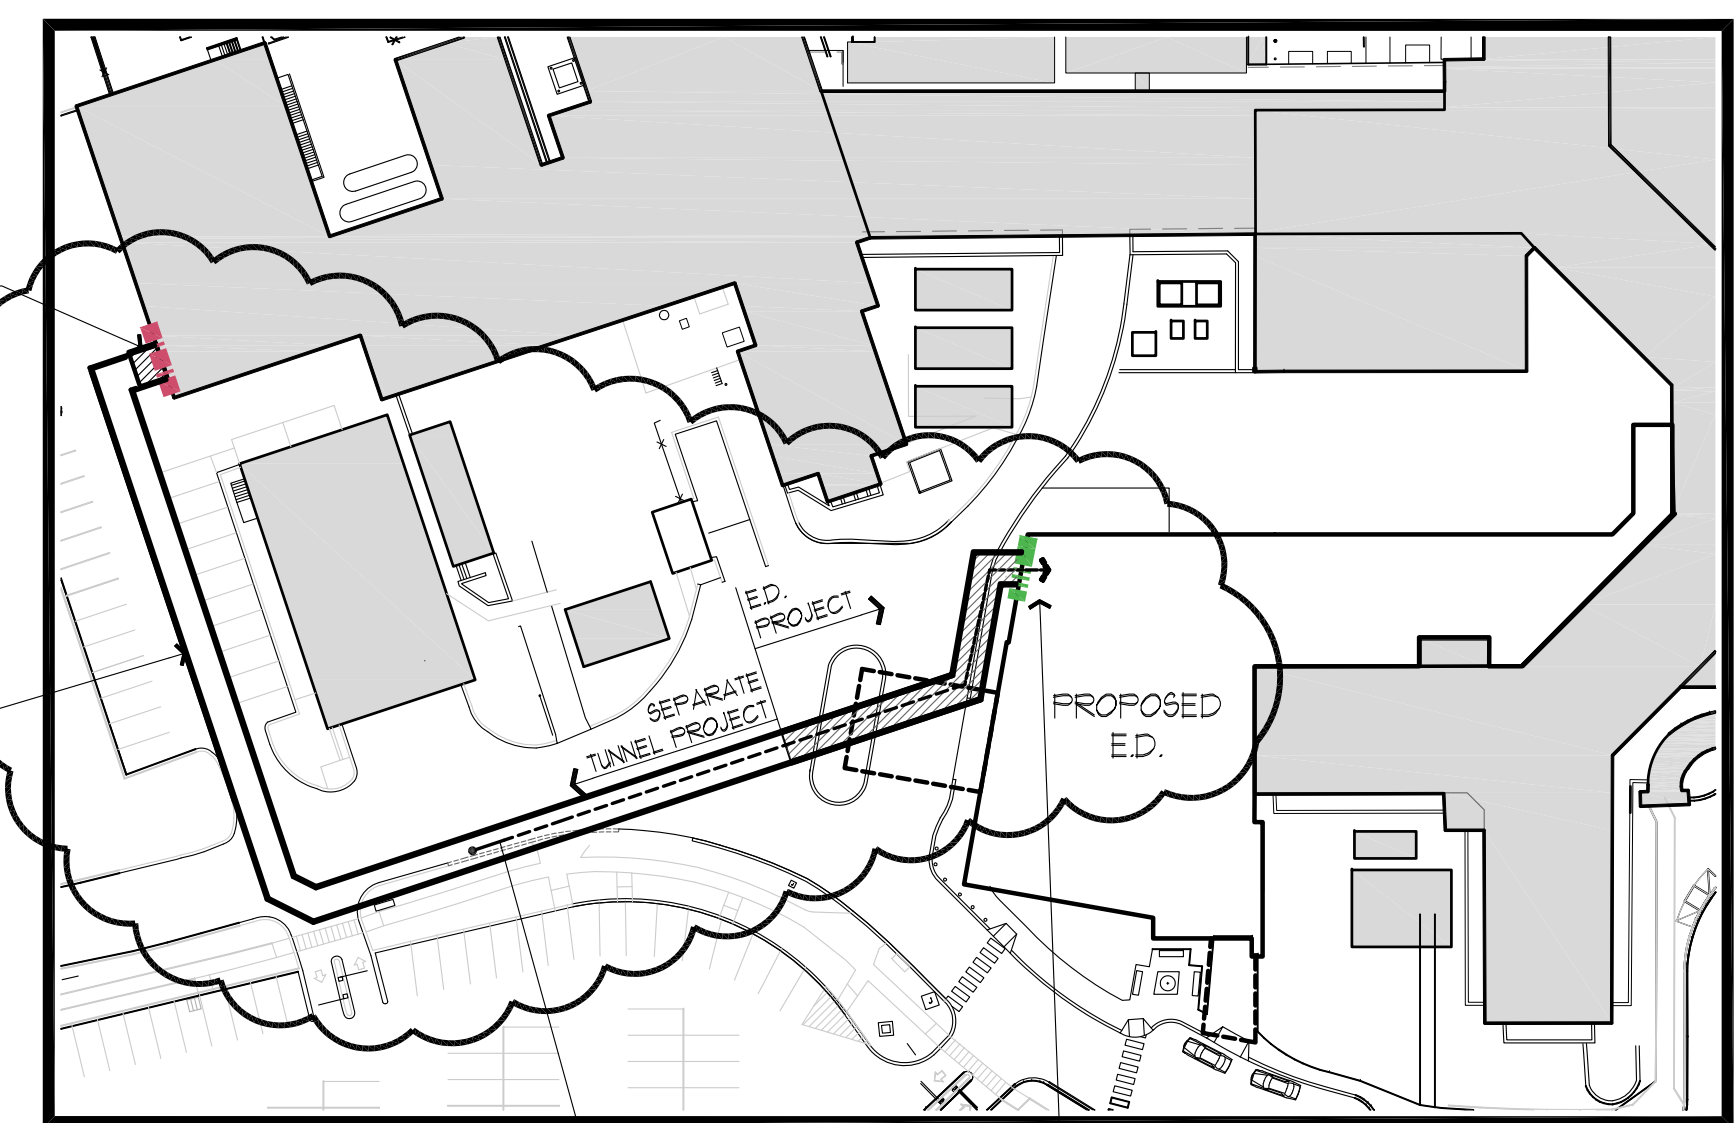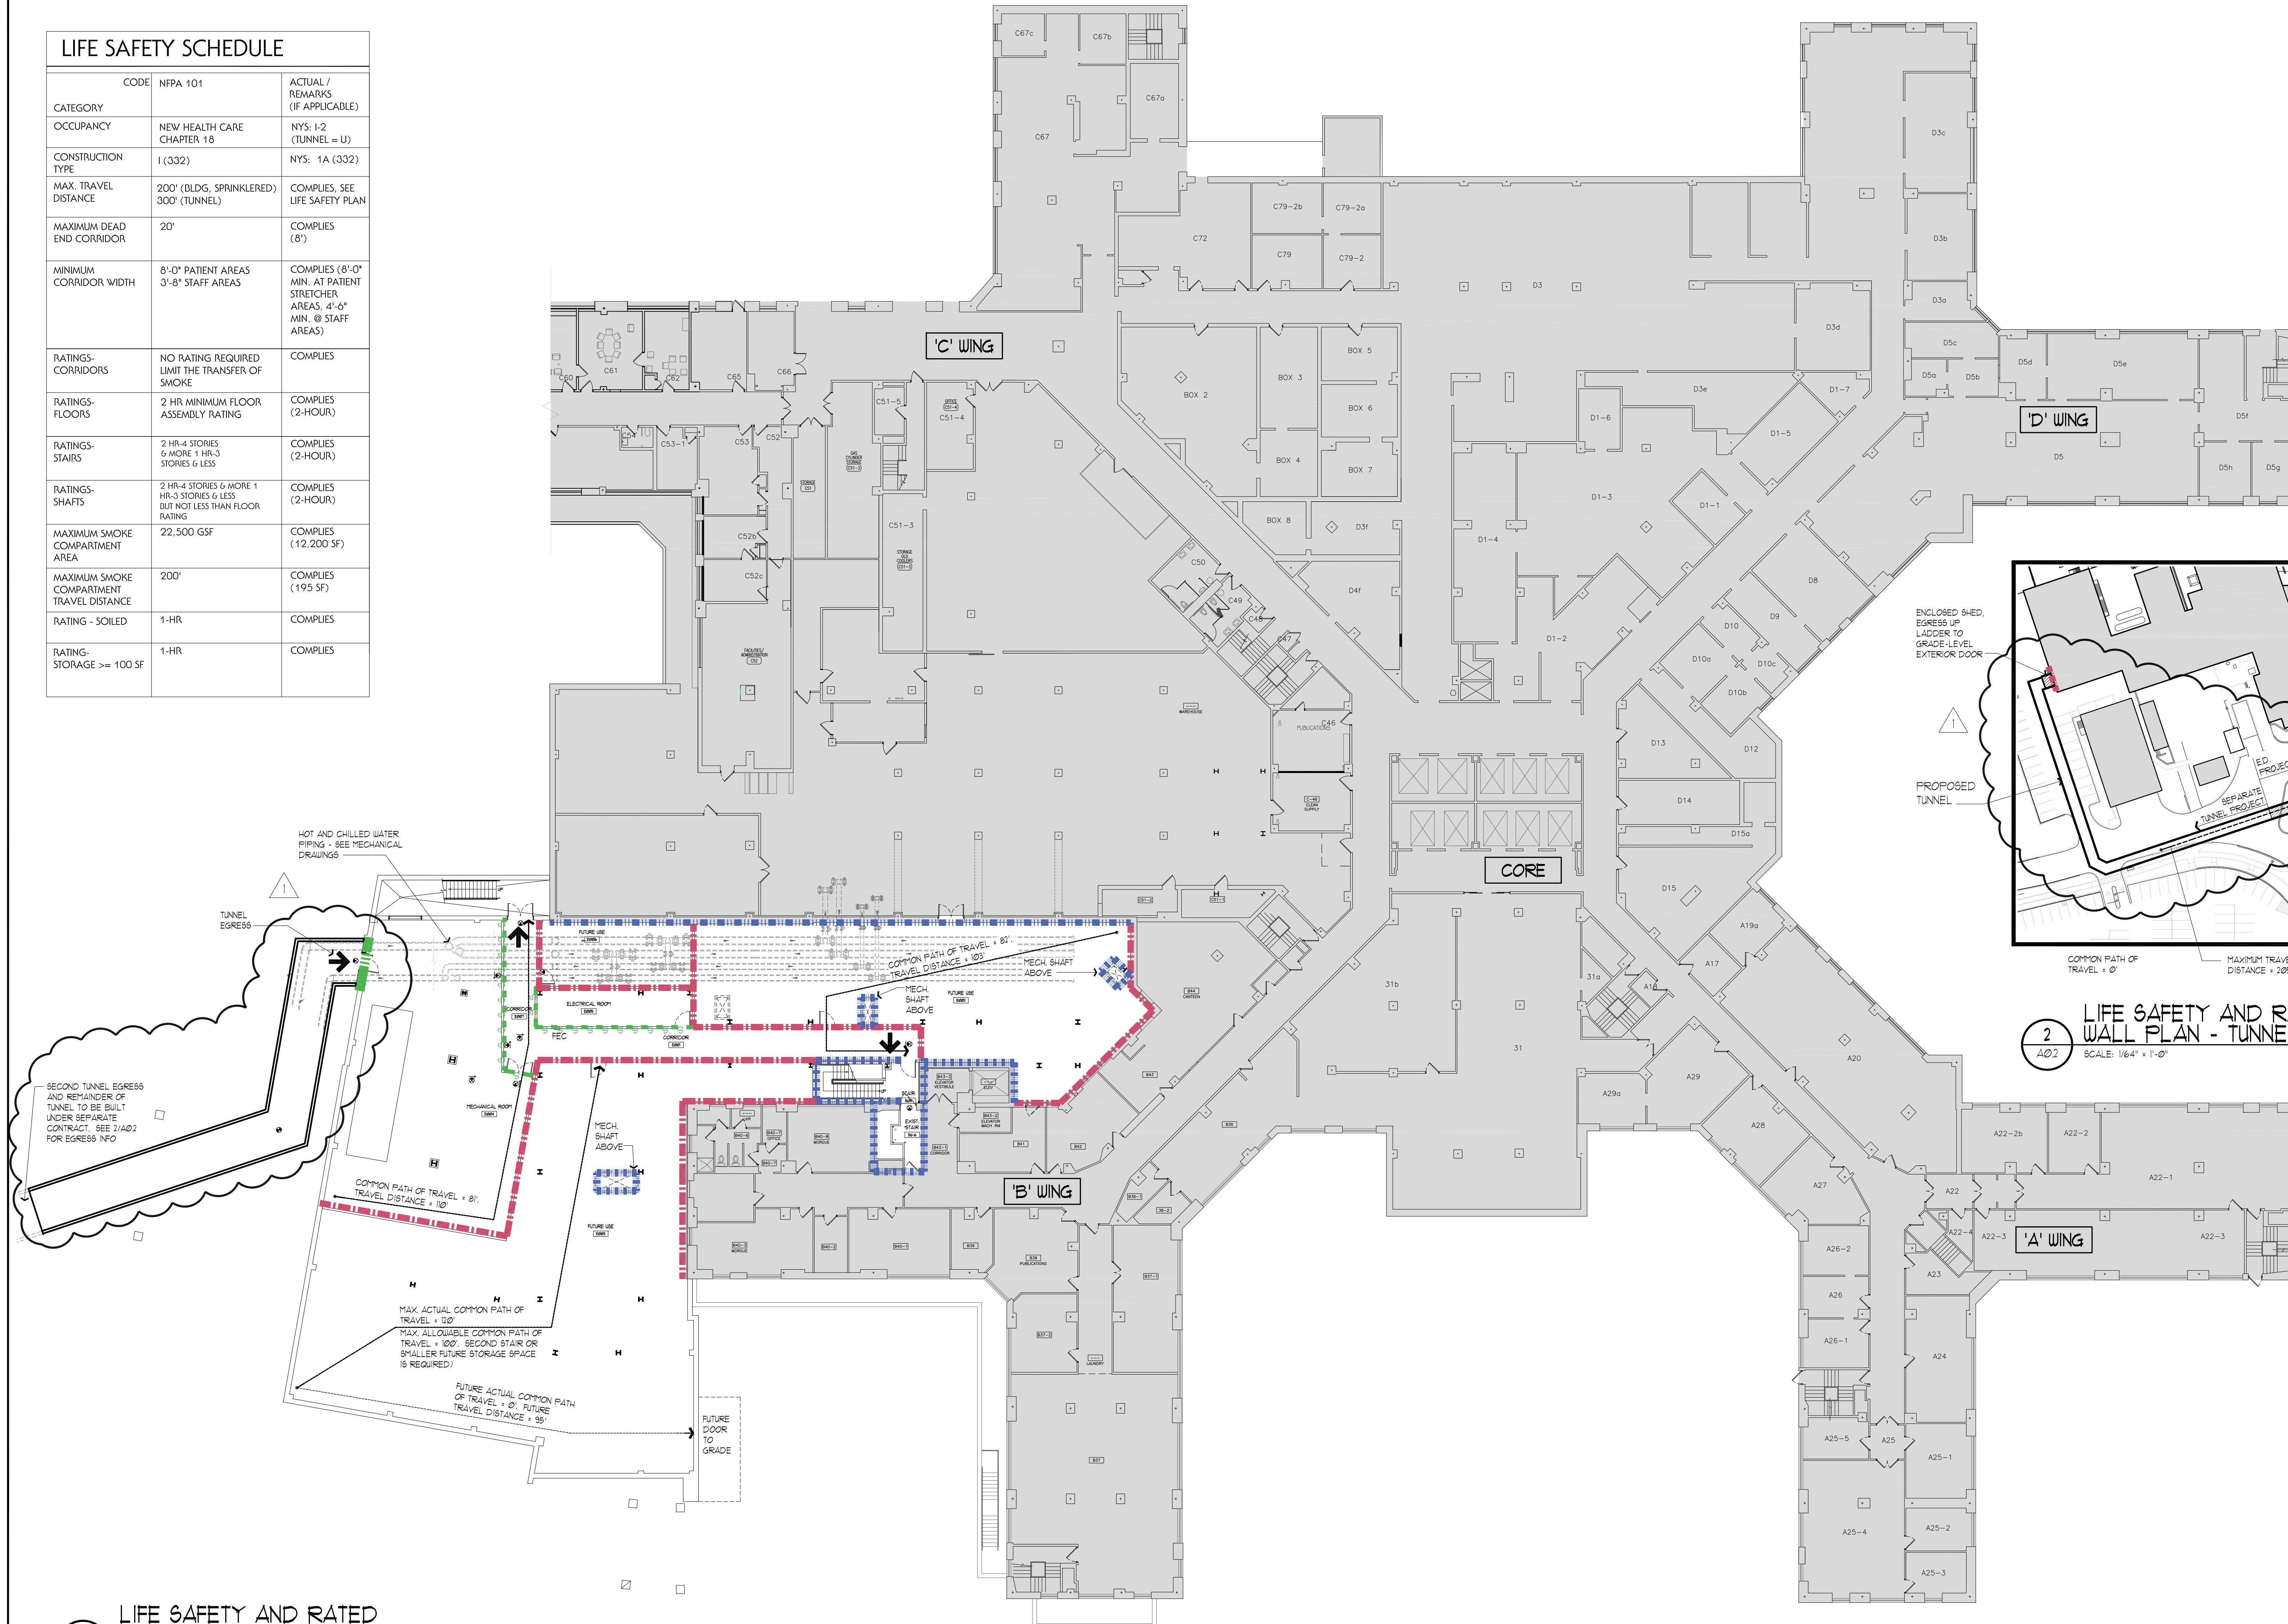

2 LIFE SAFETY AND RATED WALL PLAN - TUNNEL  
SCALE: 1/16" = 1'-0"

1 LIFE SAFETY AND RATED WALL PLAN - BASEMENT  
SCALE: 1/16" = 1'-0"

<b>CONSULTANTS:</b>  FRIEDMAN FISHER ASSOCIATES, P.C. CONSULTING ENGINEERS 22 AVENUE BOND, ALBANY, NEW YORK 12205 TEL (518) 458-7040 FAX (518) 458-7043 mailto:info@friedmanfisher.com		 RYAN-BIGGS ASSOCIATES, P.C. 207 USHERS ROAD CLIFTON PARK, NY 12015 TEL (518) 458-7040 FAX (518) 458-7043 www.ryanbiggs.com		 <b>ARCHITECT/ENGINEERS:</b> <b>Hyman Hayes</b> ASSOCIATES 6 WEMBLEY COURT, ALBANY, NEW YORK 12205 (518) 452-3470 (518) 452-3783 Fax HHA Proj. 10046		<b>Drawing Title</b> LIFE SAFETY AND RATED WALL PLAN - BASEMENT <b>Approved Project Director</b>		<b>Project Title</b> NEW EMERGENCY DEPARTMENT Stratton VA Medical Center <b>Location</b> Albany, New York <b>Date</b> JUNE 13, 2012 <b>Checked</b> MH <b>Drawn</b> MW		<b>Project Number</b> VA 528-809 <b>Building Number</b> 95 <b>Drawing Number</b> A0.2 Dwg. 27 of 115		<b>Office of Construction and Facilities Management</b> 	
--	--	--	--	--	--	--	--	---	--	--	--	---	--