

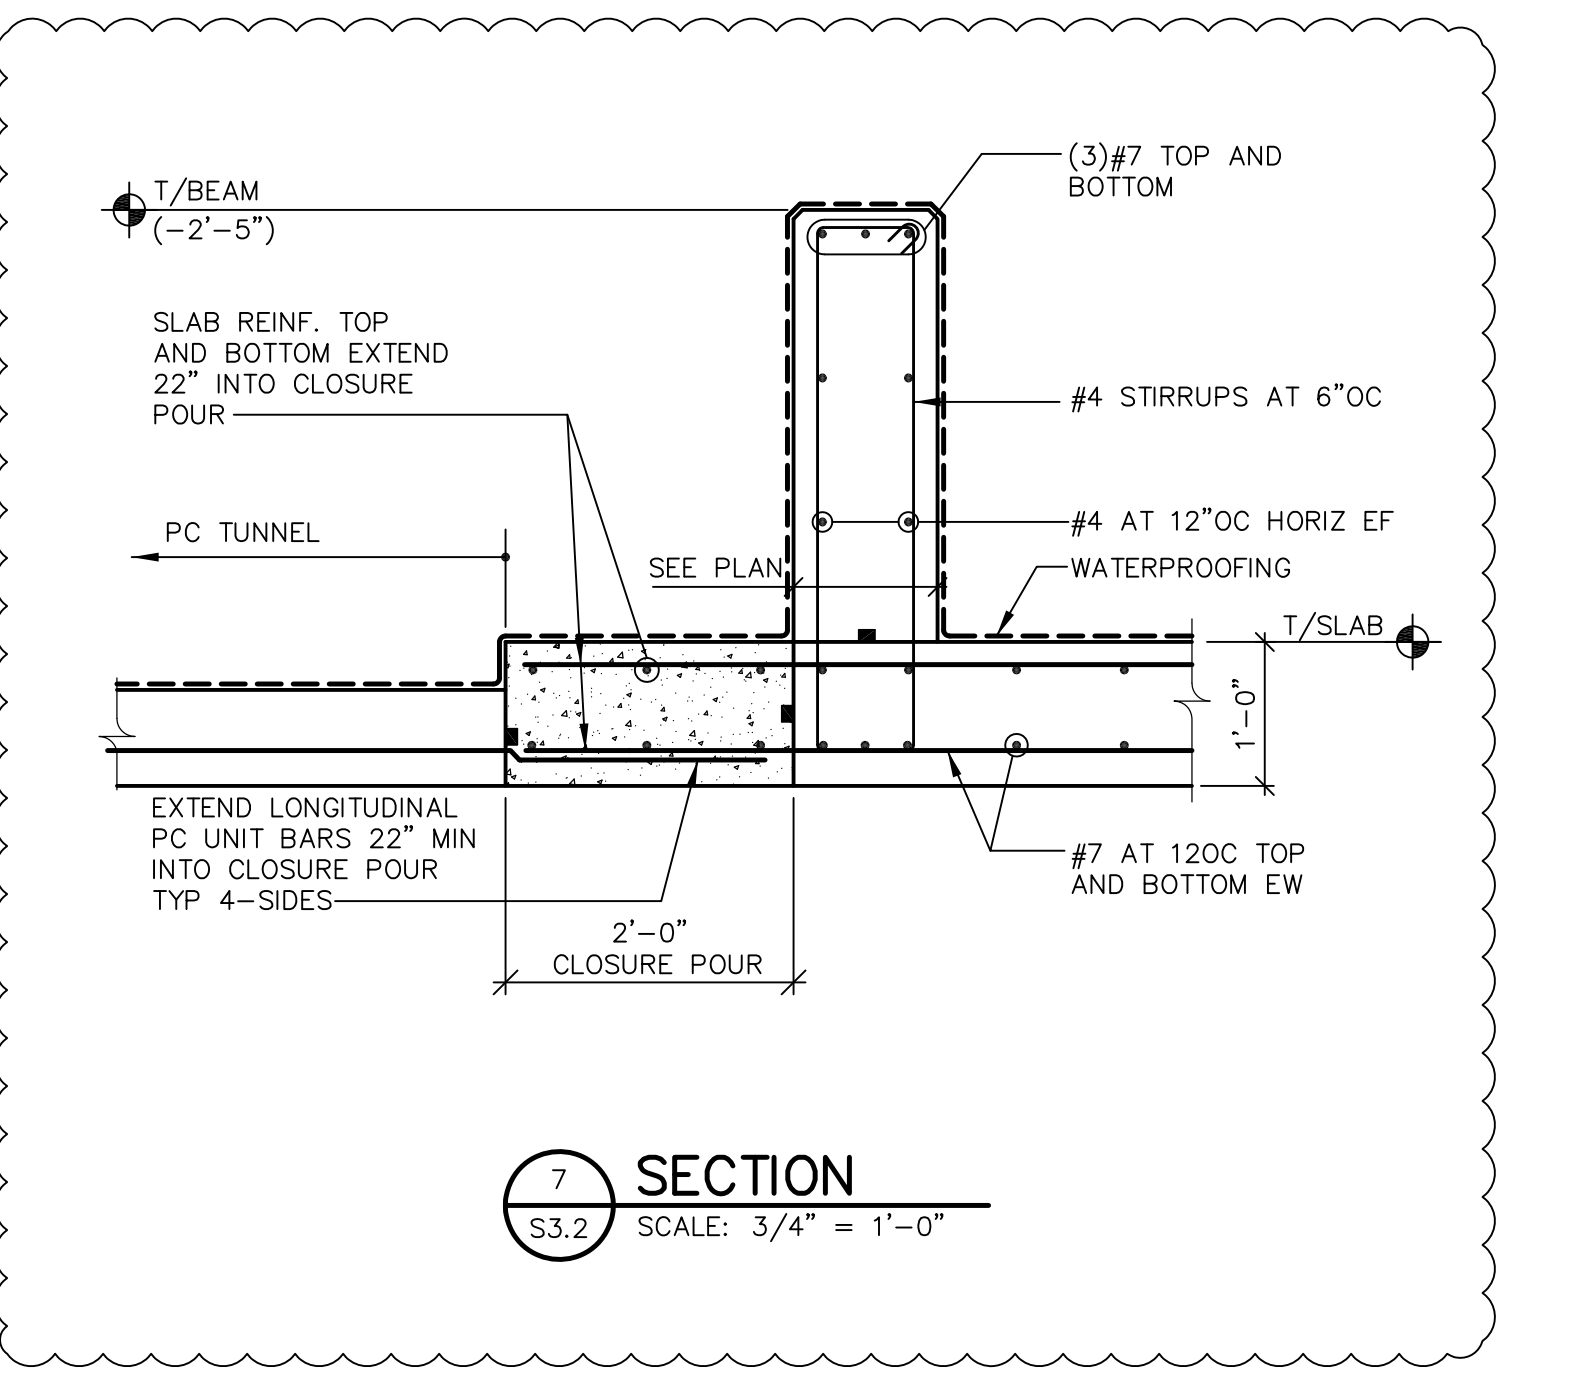
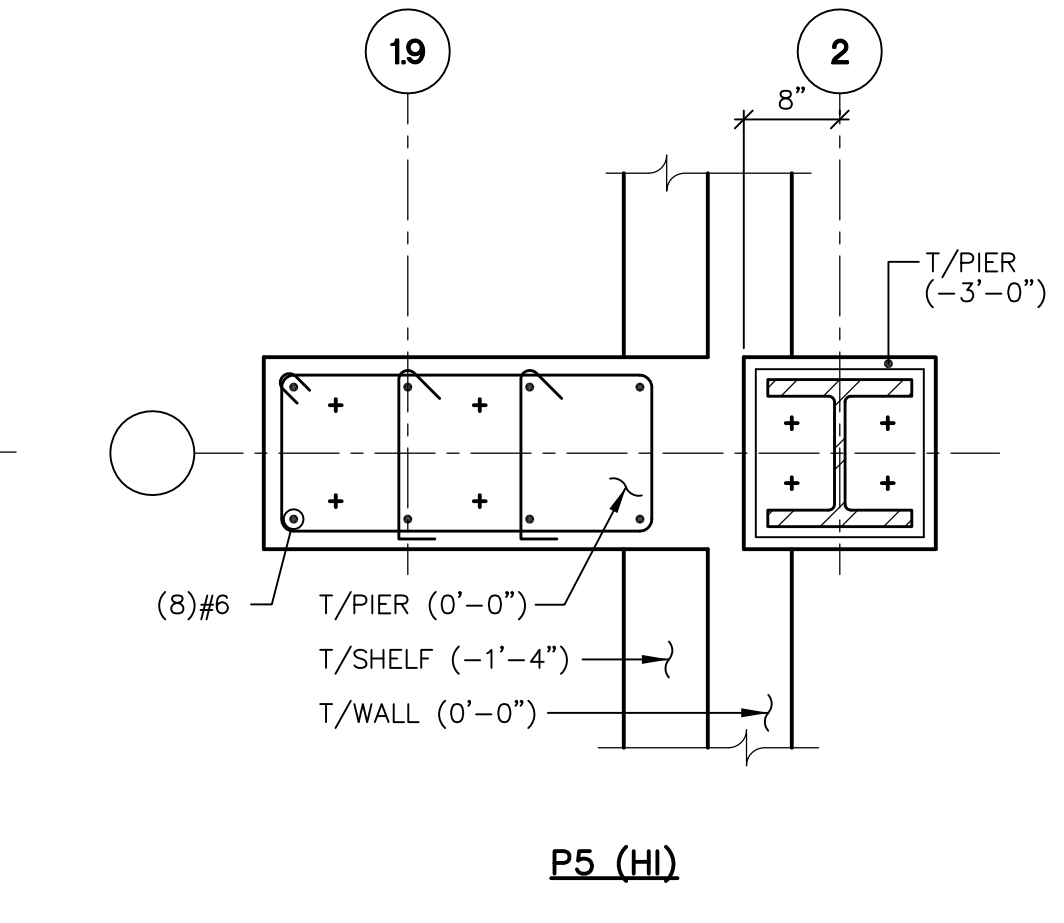
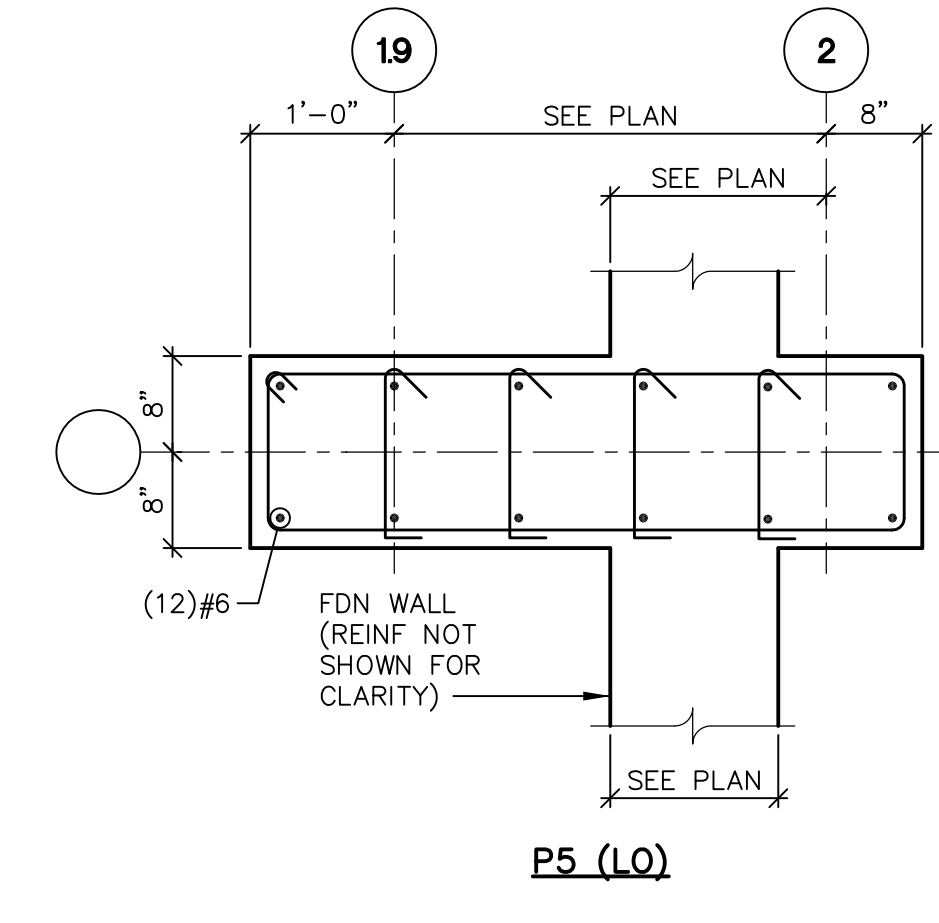
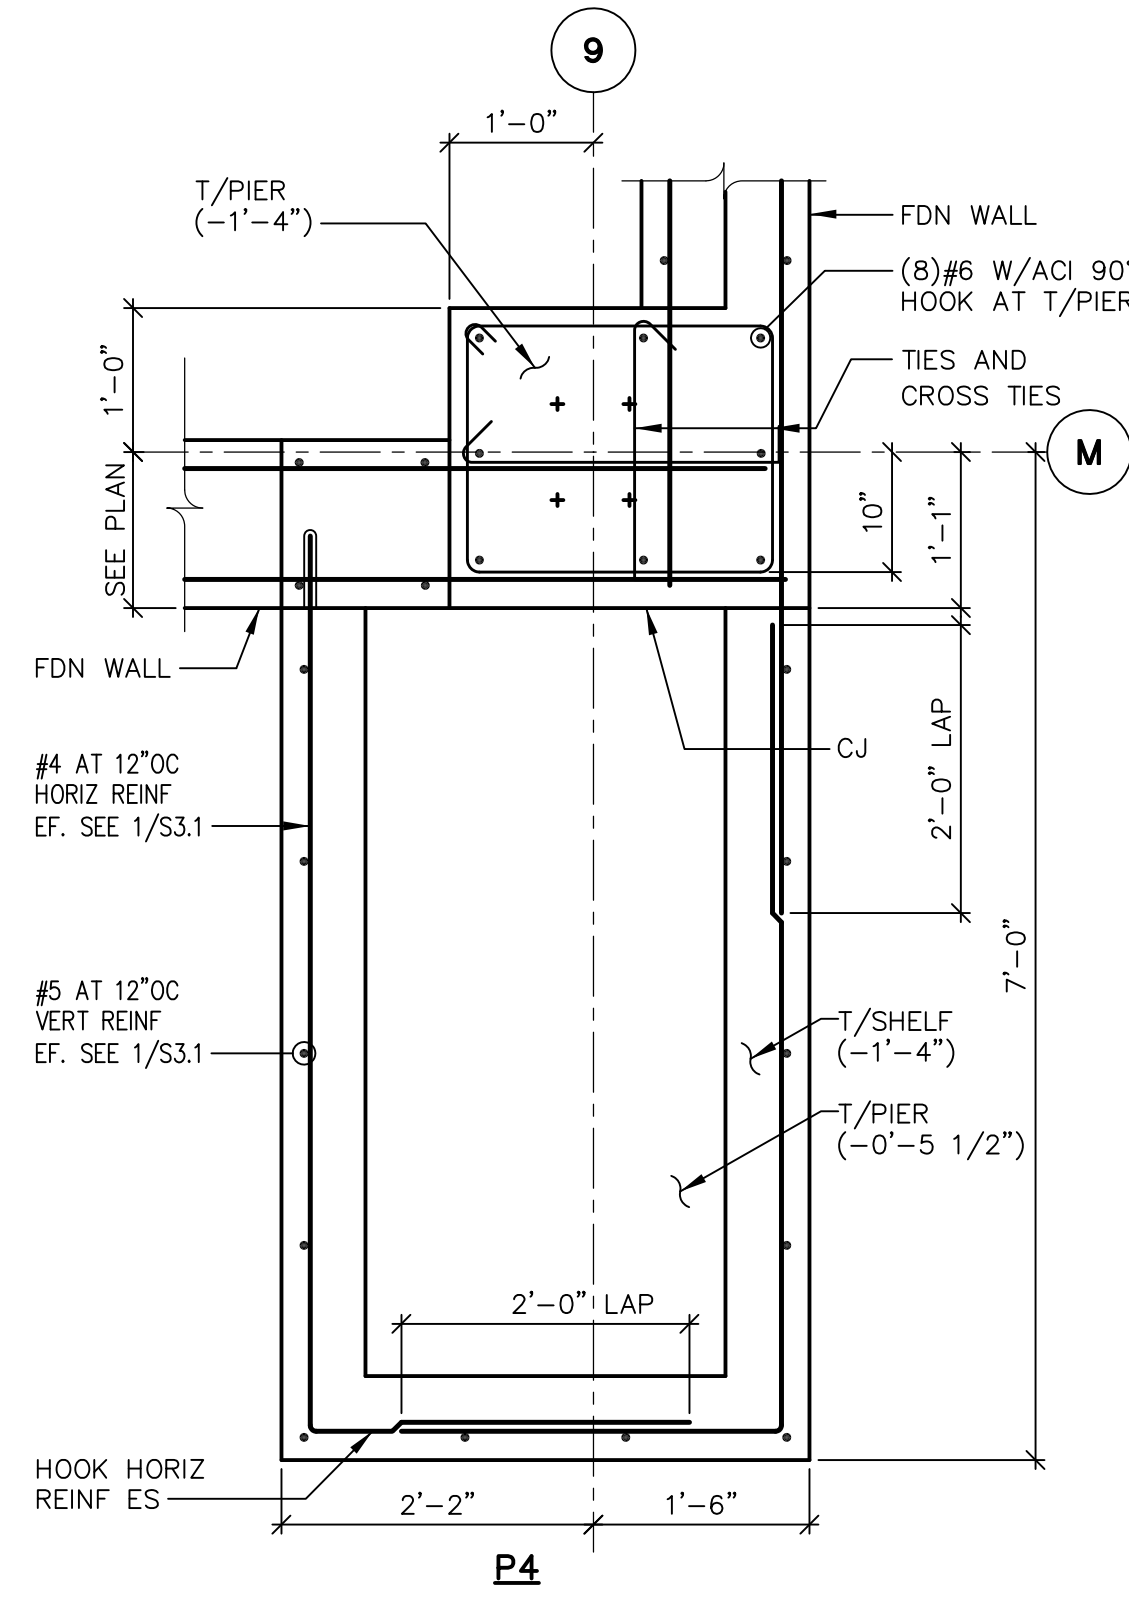
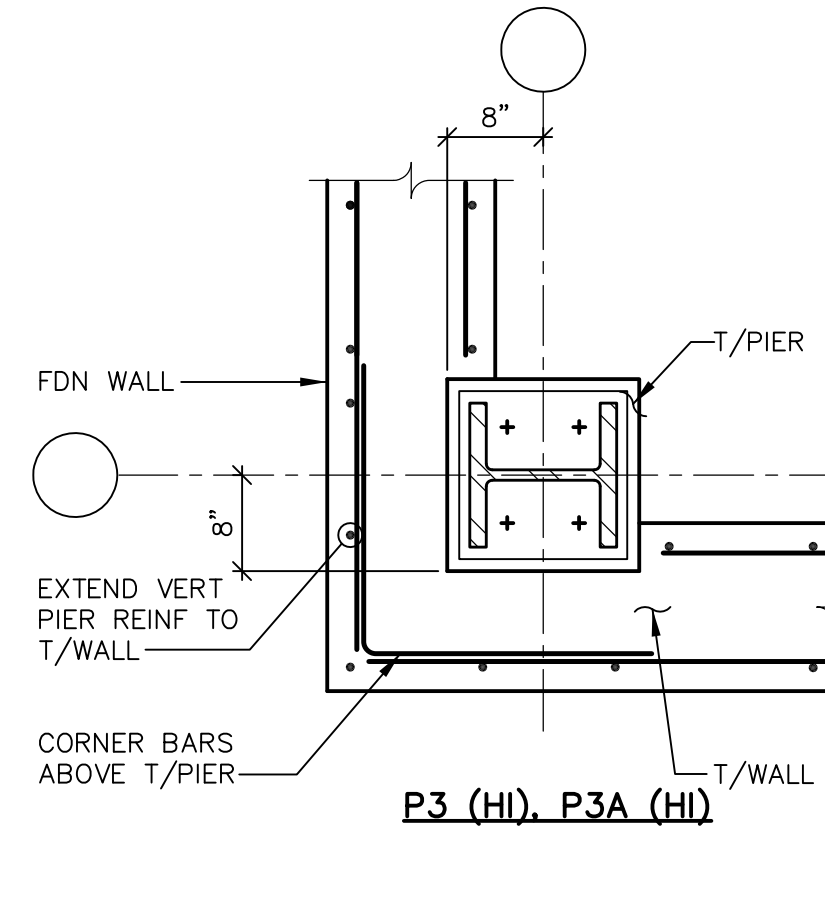
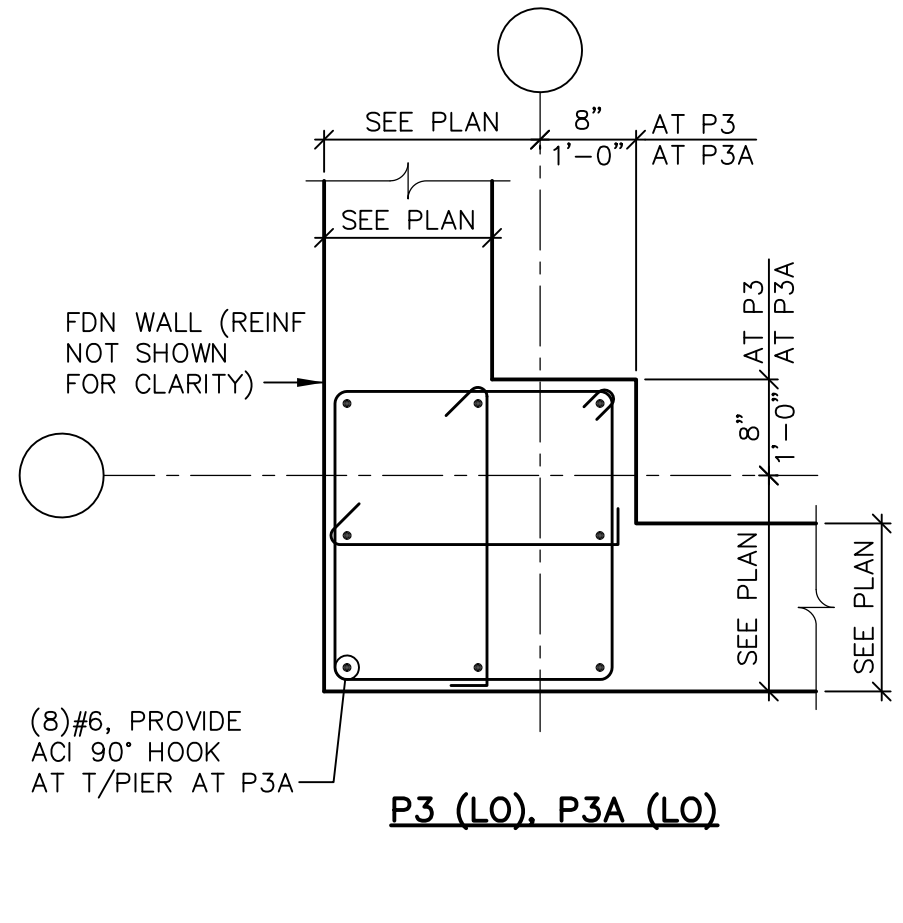
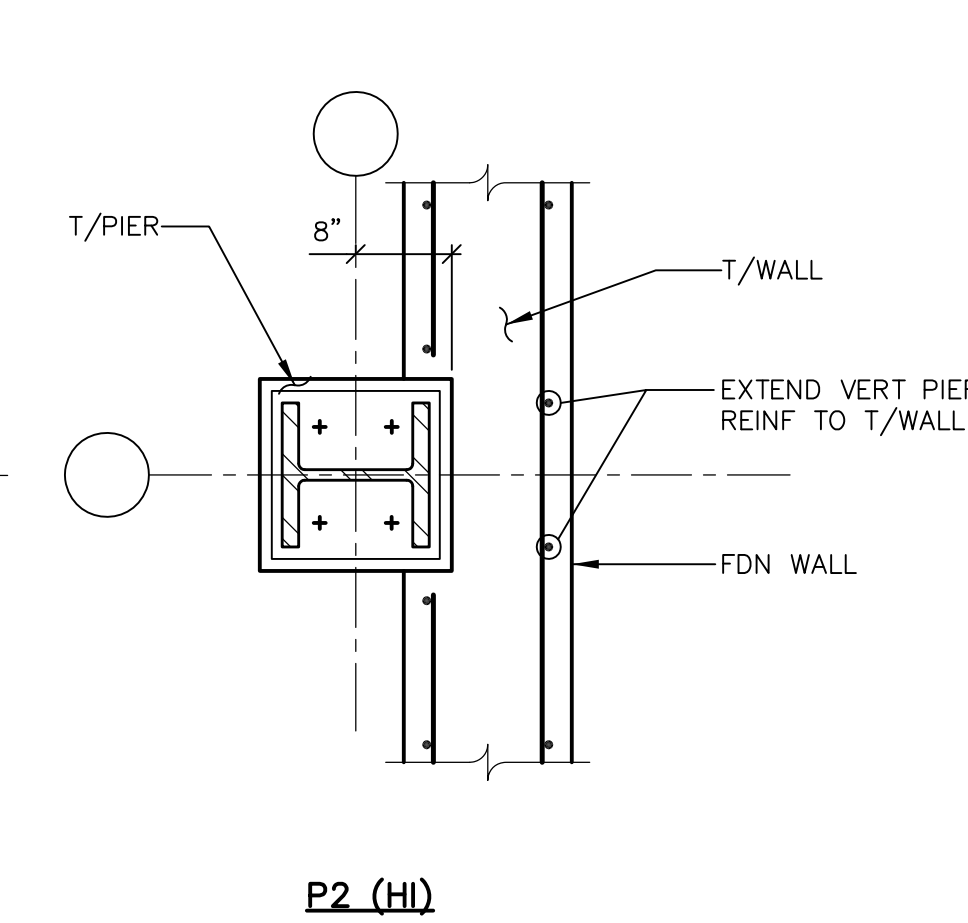
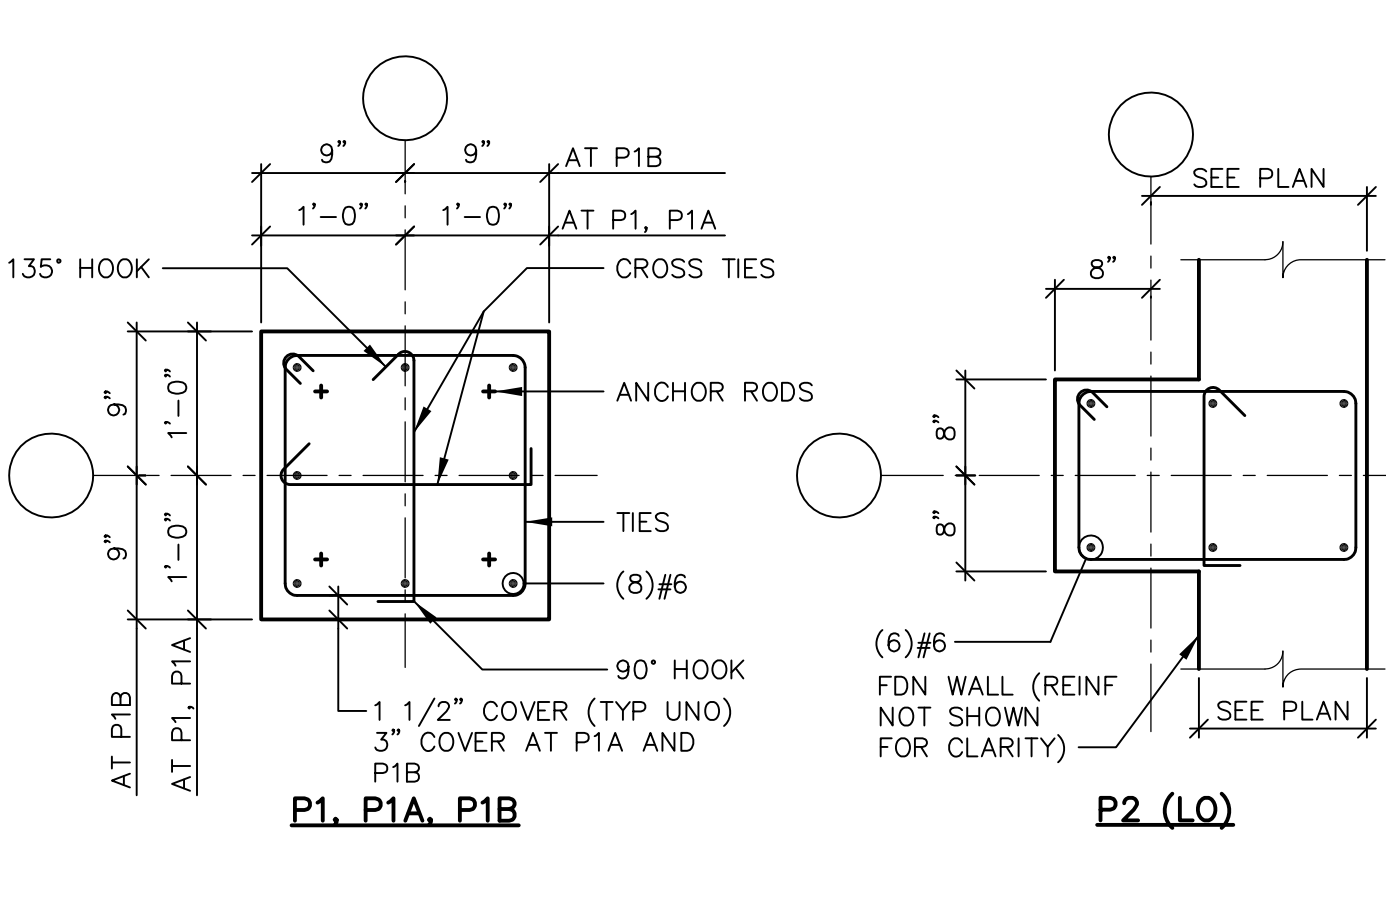
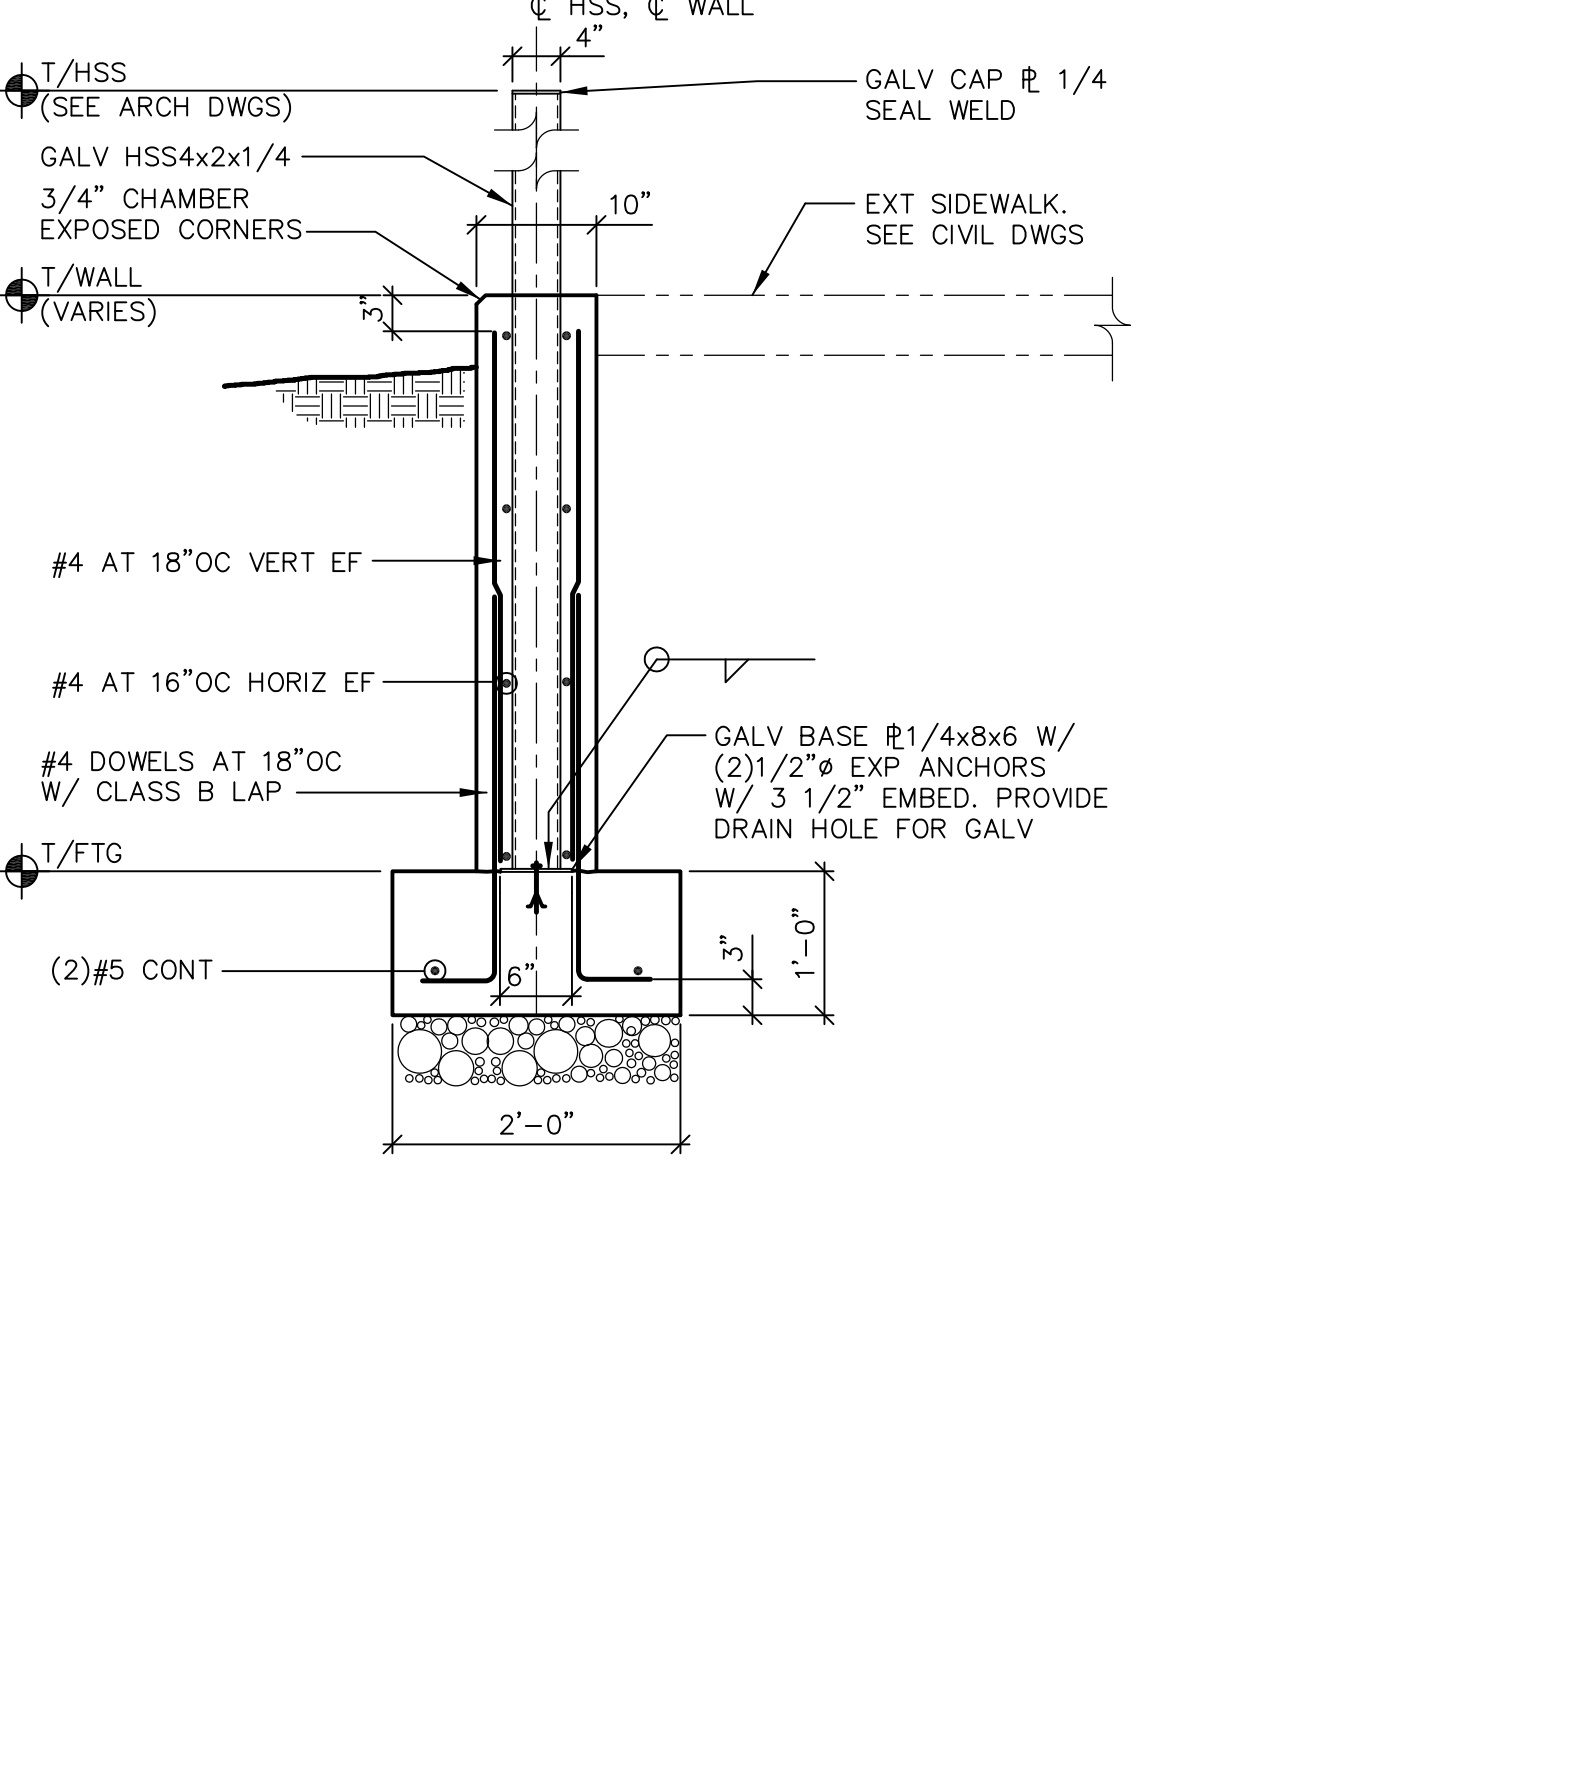
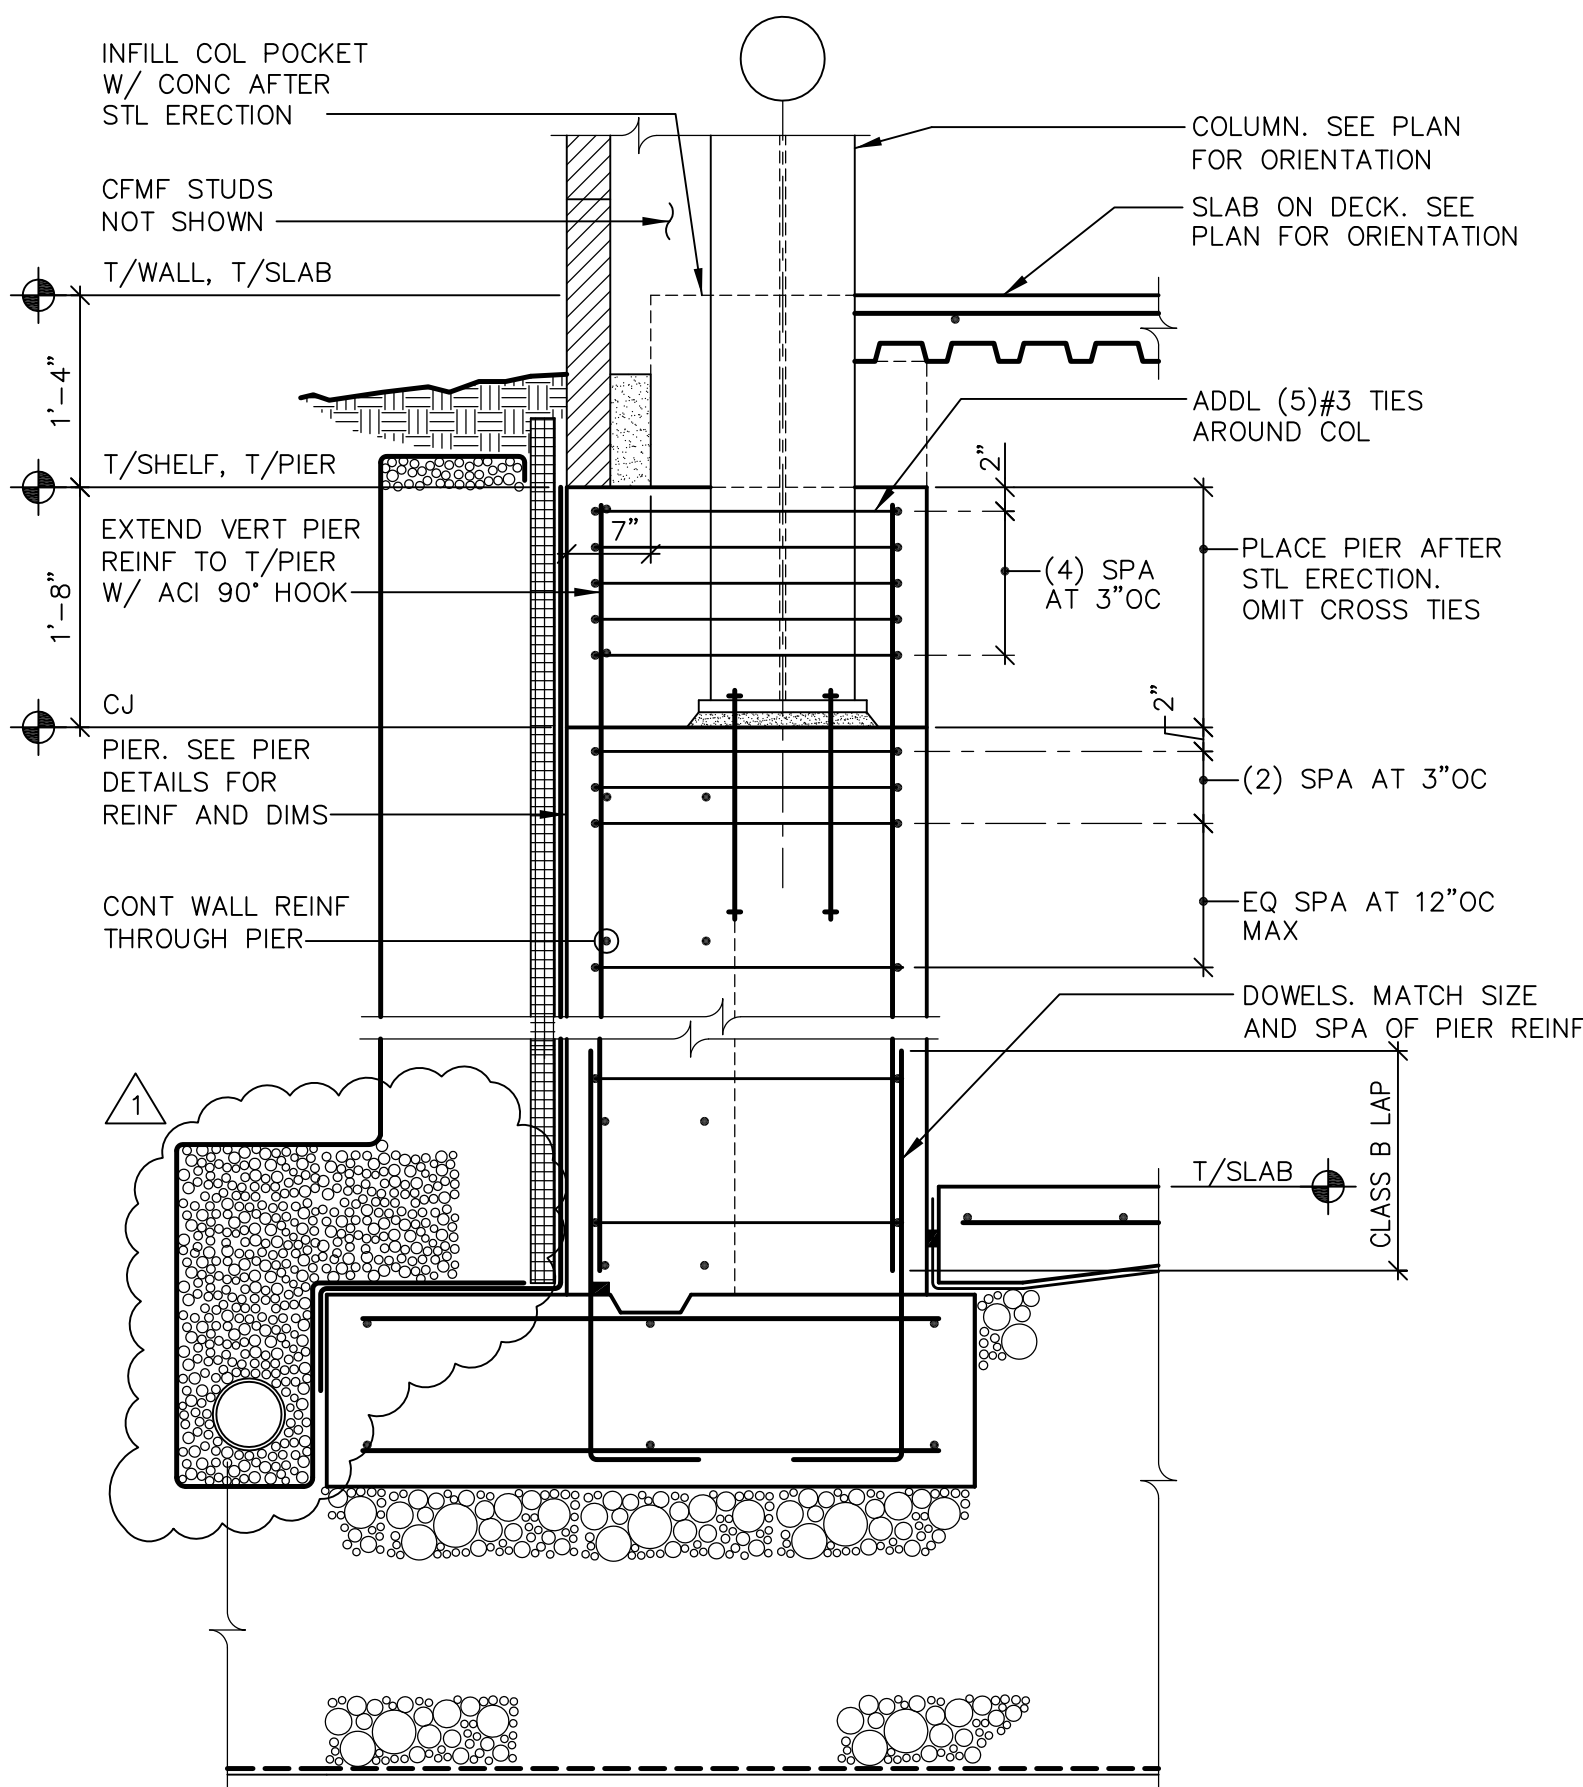
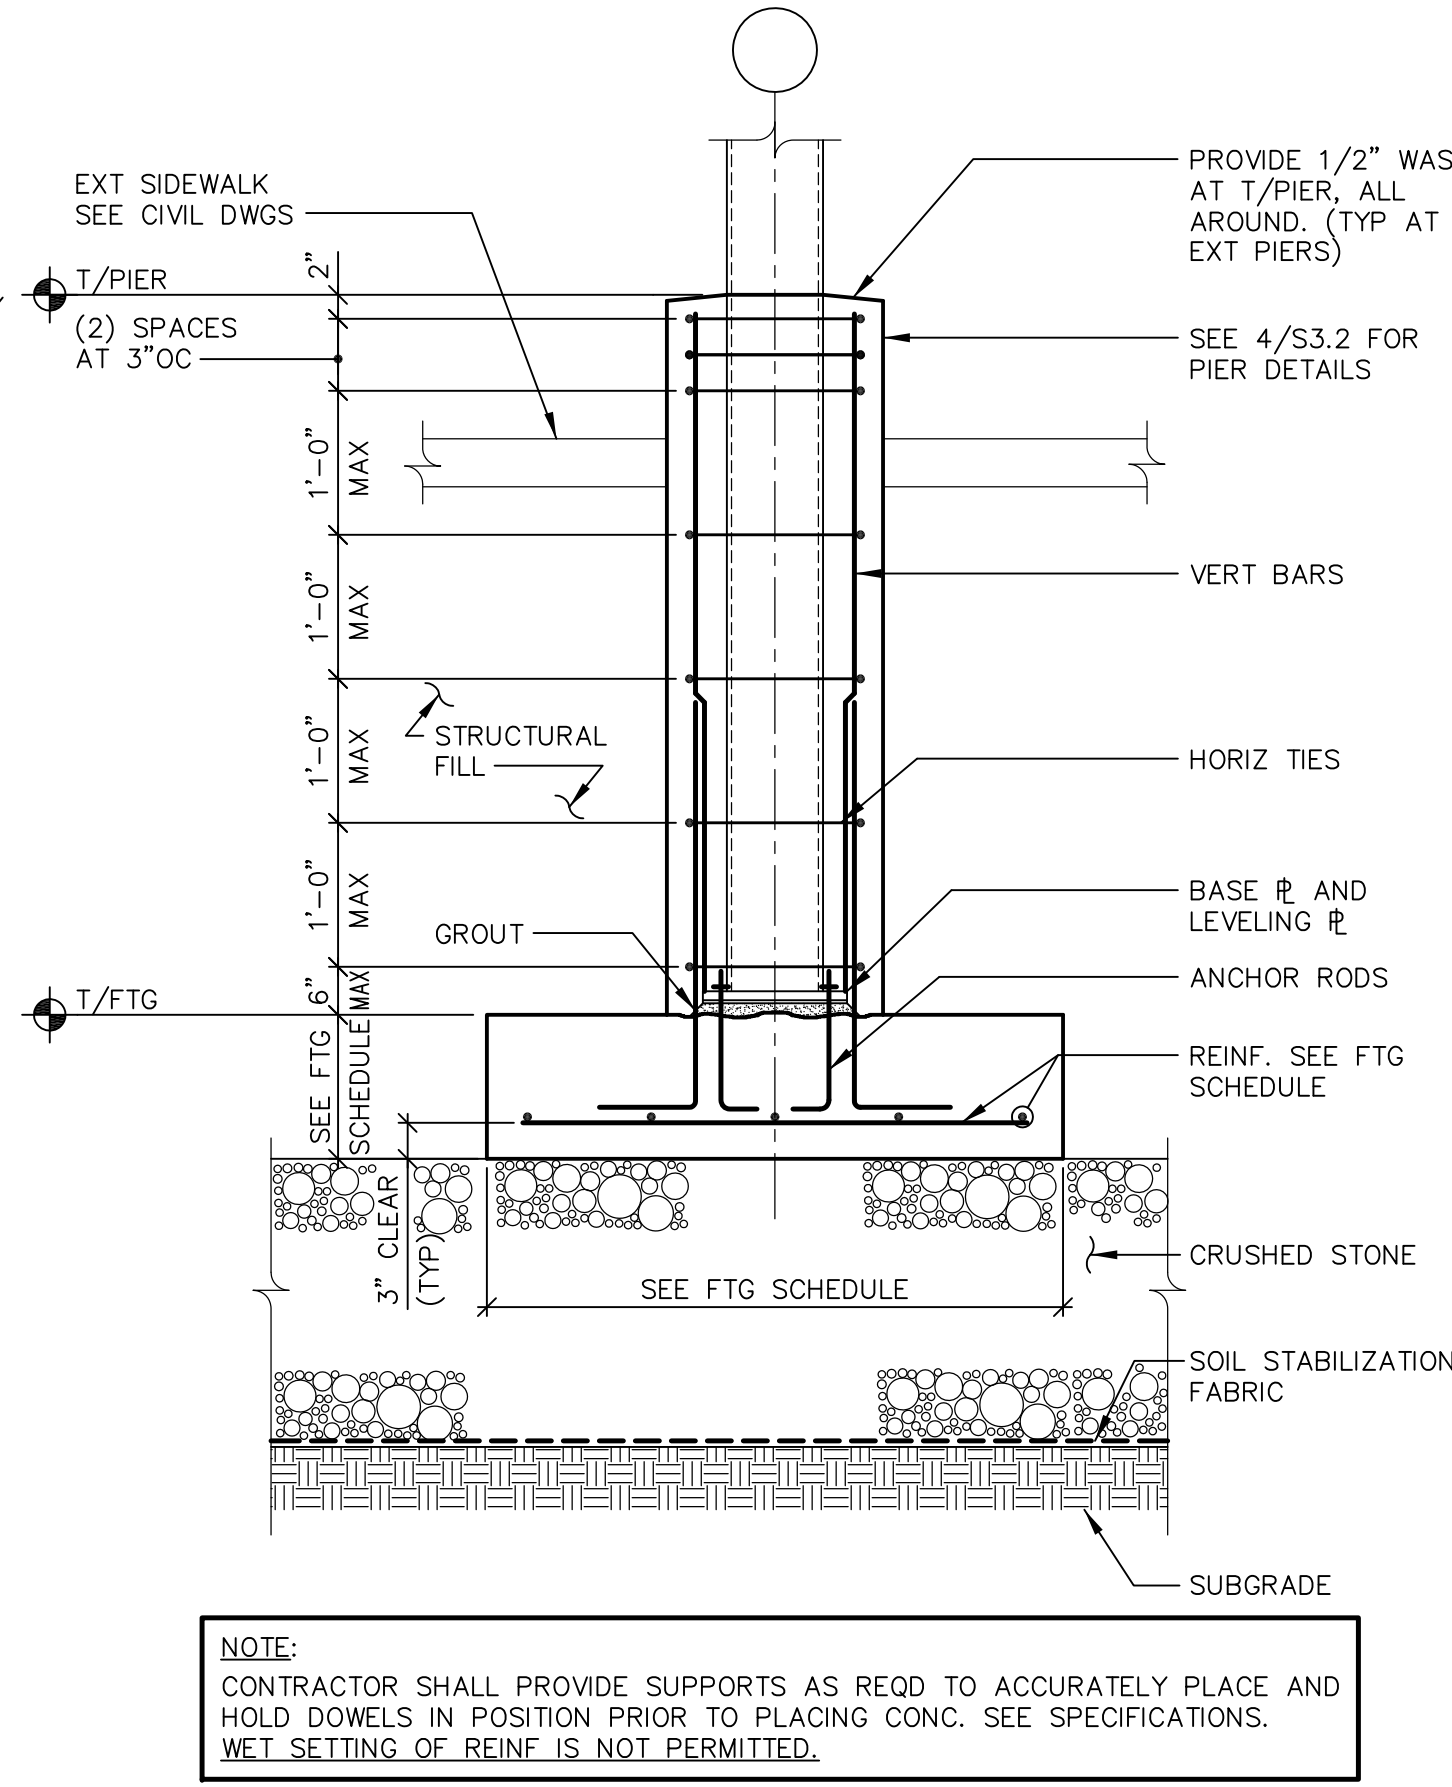



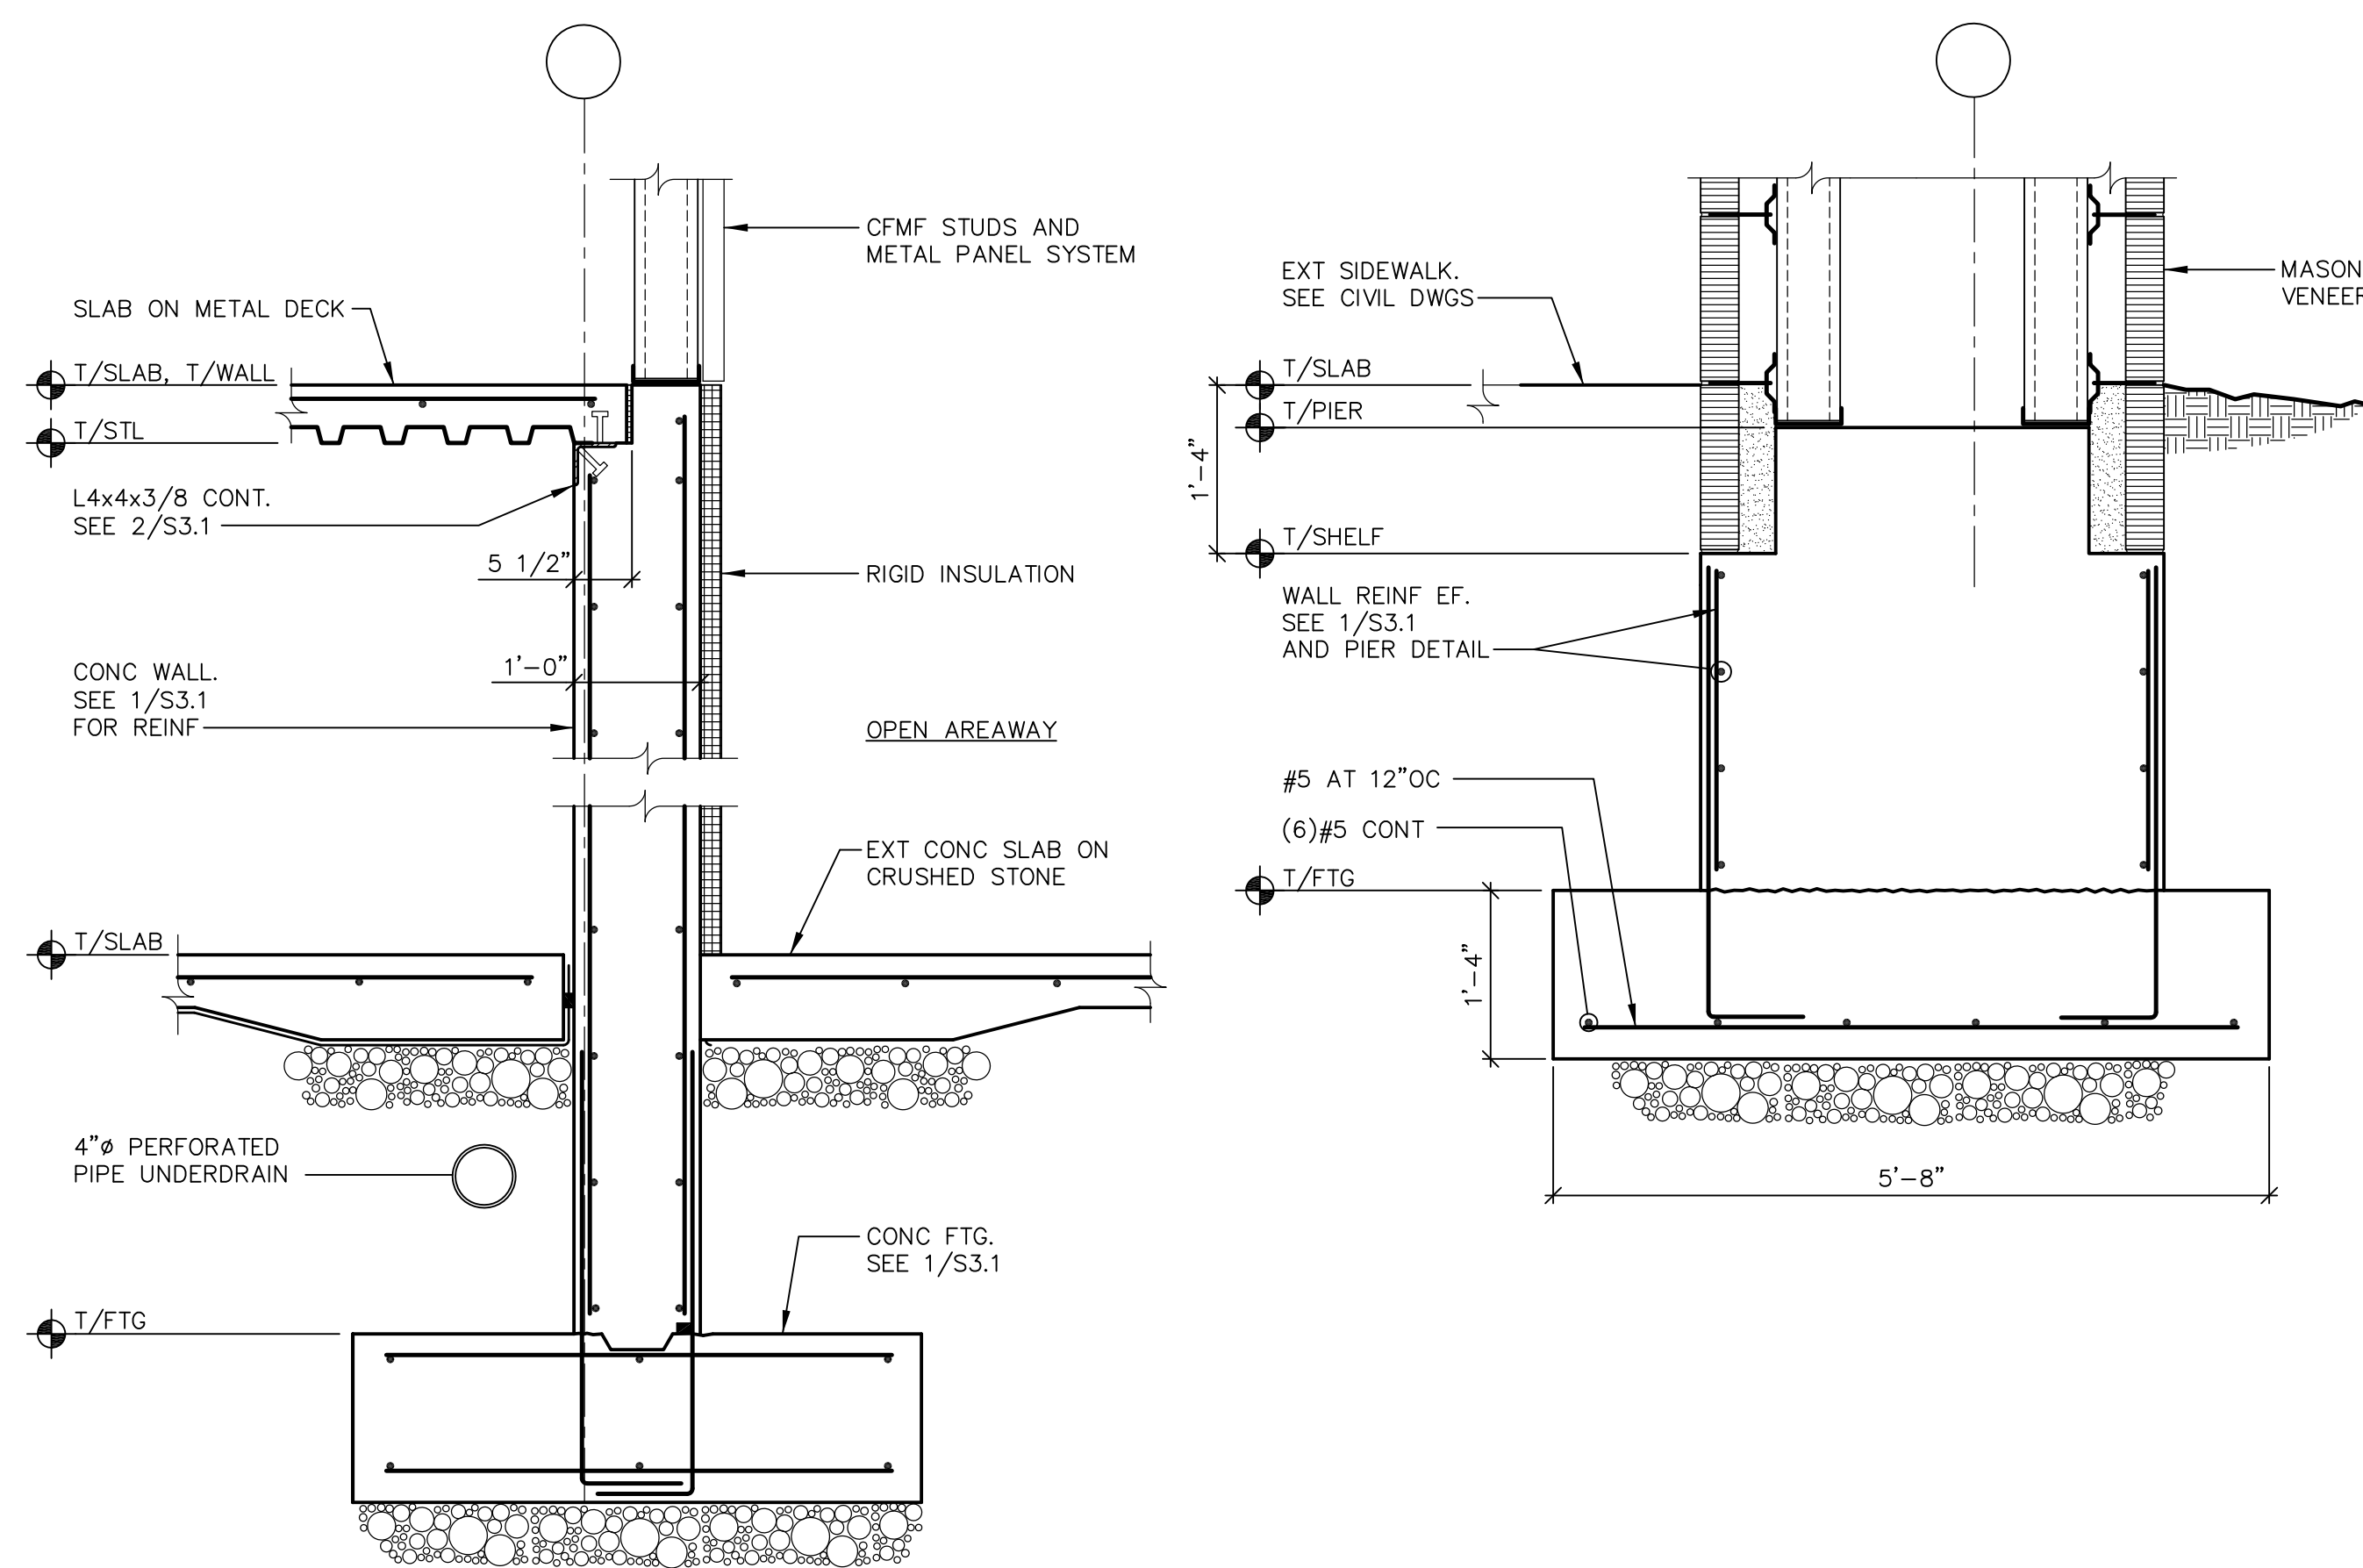



F:\DWG\0856-1S3.2.dwg, 7/24/2012 4:32:41 PM, sjedwebber

three eighths inch = one foot
one eighth inch = one foot
one quarter inch = one foot
one half inch = one foot
three quarters inch = one foot
one inch = one foot
one and one half inches = one foot
two inches = one foot
three inches = one foot
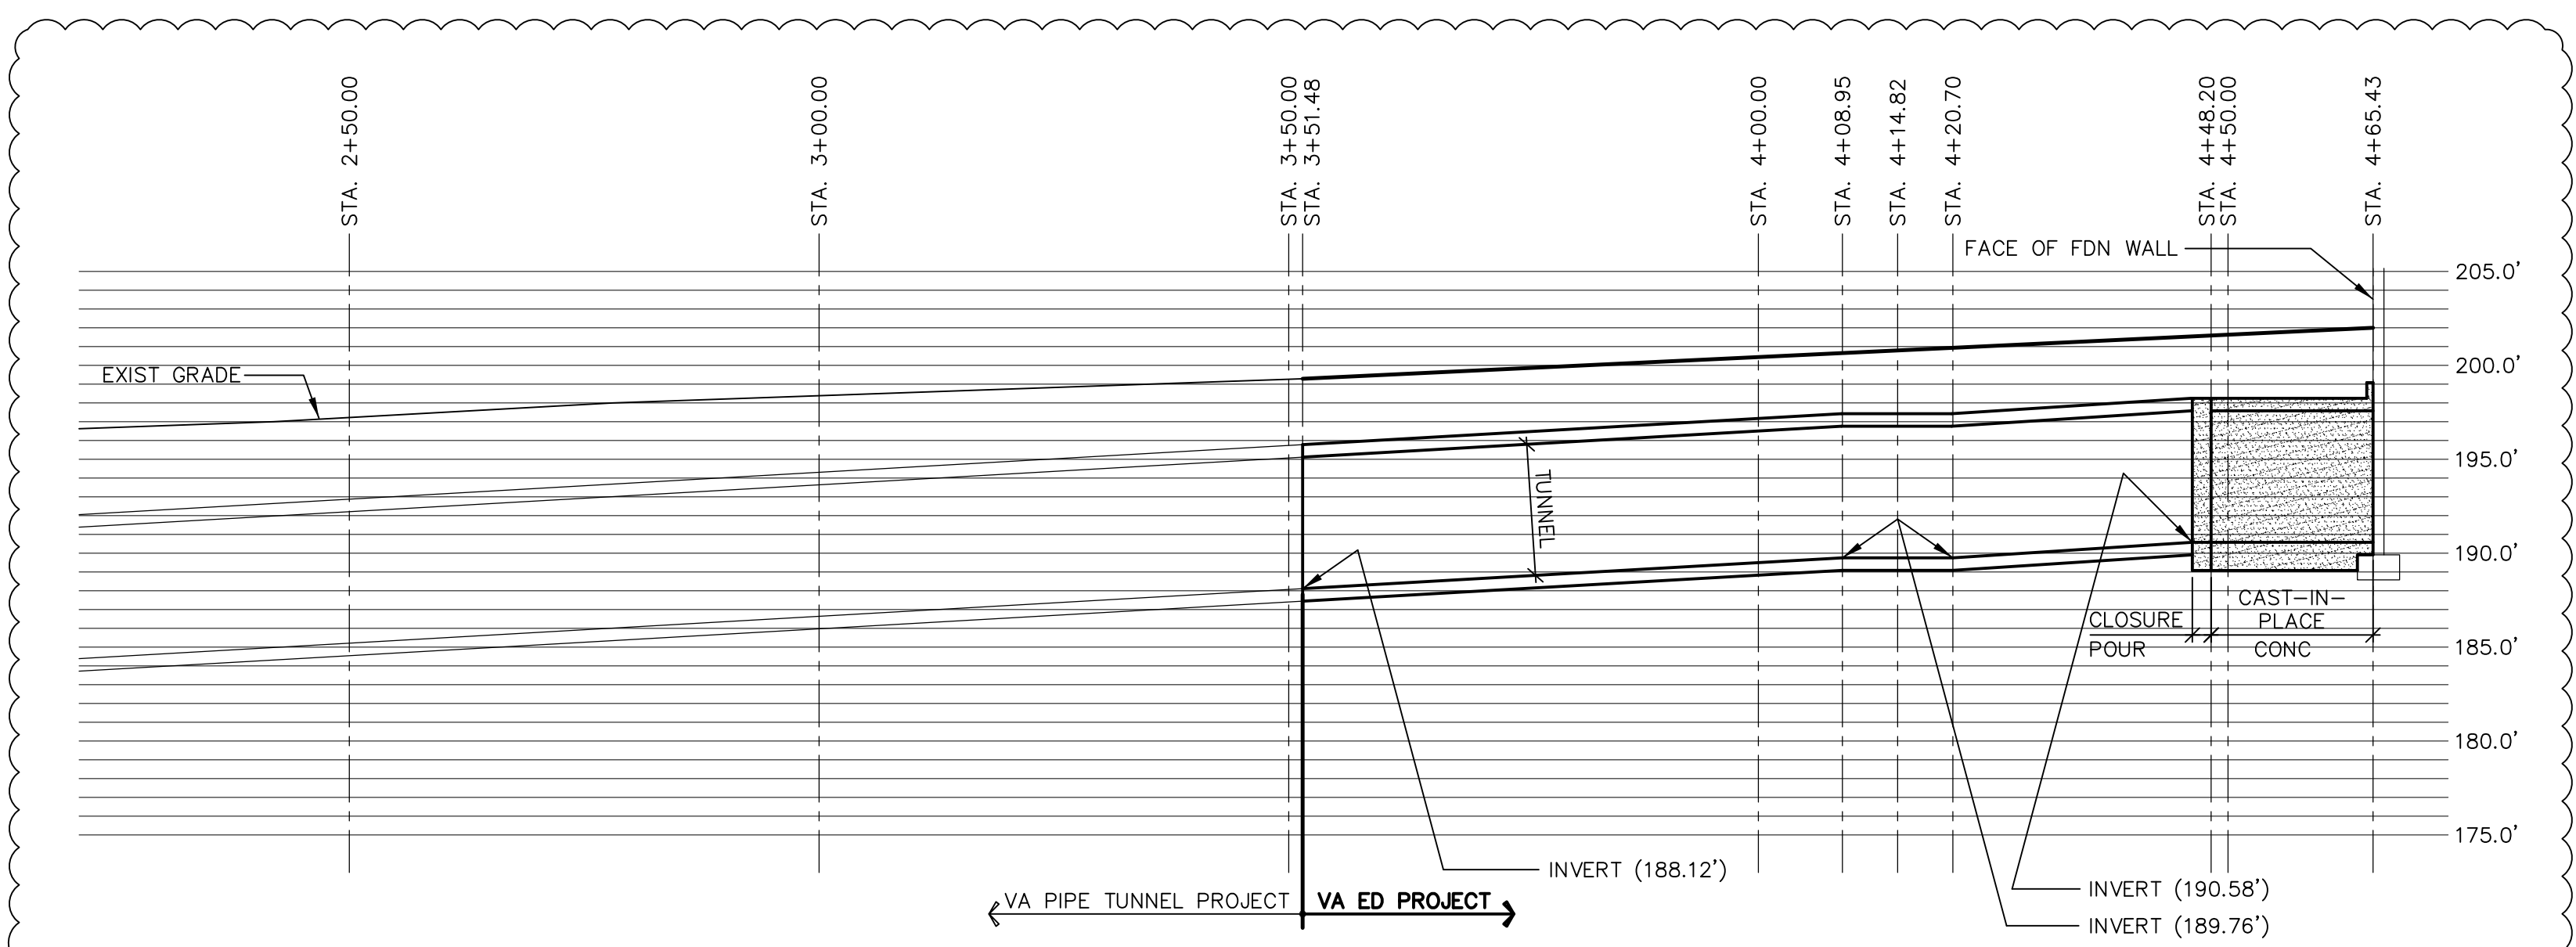

- PIER DETAILS
SCALE: 3/4" = 1'-0"
- PIER NOTES:
1. TIES AND CROSS TIES ARE #3, TYPICAL UNLESS NOTED OTHERWISE. STAGGER HOOK LOCATIONS ON ALTERNATE TIES. STAGGER 90° HOOK LOCATIONS ON CROSS TIES.
 2. SEE 5/S3.1, 10/S3.1, AND 5/S3.2 FOR TIE/CROSS TIE SPACING AND SECTIONS AT PIERS.
 3. CONTINUE WALL REINFORCING THROUGH PIERS.
 4. SEE 1/S3.1 FOR BASE PLATE DETAILS AND ANCHOR ROD INFORMATION. ALSO SEE BASE PLATE SCHEDULE.
 5. VENEER SHELF'S NOT SHOWN IN ALL PIER DETAILS. SEE S2.0 FOR LOCATIONS.

 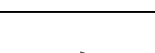

 		CONSULTANTS:				ARCHITECT/ENGINEERS:		Drawing Title FOUNDATION SECTIONS AND DETAILS		Project Title NEW EMERGENCY DEPARTMENT Stratton VA Medical Center		Project Number VA 528-809		Office of Construction and Facilities Management		
		 FRIEDMAN FISHER ASSOCIATES, P.C. <small>Quality Service Since 1944</small> CONSULTING ENGINEERS 22 Aviation Road, Albany, New York 12205 TEL (518) 458-7040 FAX (518) 458-7043 mailto:info@friedmanfisher.com		 RYAN-BIGGS ASSOCIATES, P.C. 257 Wilkes Road p 518 408-5508 Clifton Park, NY 12005 f 518 408-5514 www.rbausa.com				Hyman # Hayes ASSOCIATES 6 WEMBLEY COURT, ALBANY, NEW YORK 12205 (518) 452-3470 (518) 452-3783 Fax HHA Proj. 10046				Building Number 95				
		EBERLIN AND EBERLIN, P.C. 247 ROUTE 100 SUITE 1003 SOMERS NEW YORK 10589 CONSULTING ENGINEERS, PLANNERS, LANDSCAPE ARCHITECTS 914.232.8431 PHONE 914.232.8827 FAX						Approved Project Director		Location Albany, New York		Drawing Number S3.2 Dwg. 20 of 115		 Department of Veterans Affairs		
 ADDENDUM #1 Revisions:		7/24/2012 Date								<table><tr><td>Date JUNE 13, 2012</td><td>Checked AED</td><td>Drawn GRG</td></tr></table>		Date JUNE 13, 2012	Checked AED			Drawn GRG
Date JUNE 13, 2012	Checked AED	Drawn GRG														

FINAL DESIGN (100%)
FULLY SPRINKLERED

