



three inches = one foot
one and one half inches = one foot
one inch = one foot
three quarters inch = one foot
one half inch = one foot
three eighths inch = one foot
one quarter inch = one foot
one eighth inch = one foot
one eighth inch = one foot





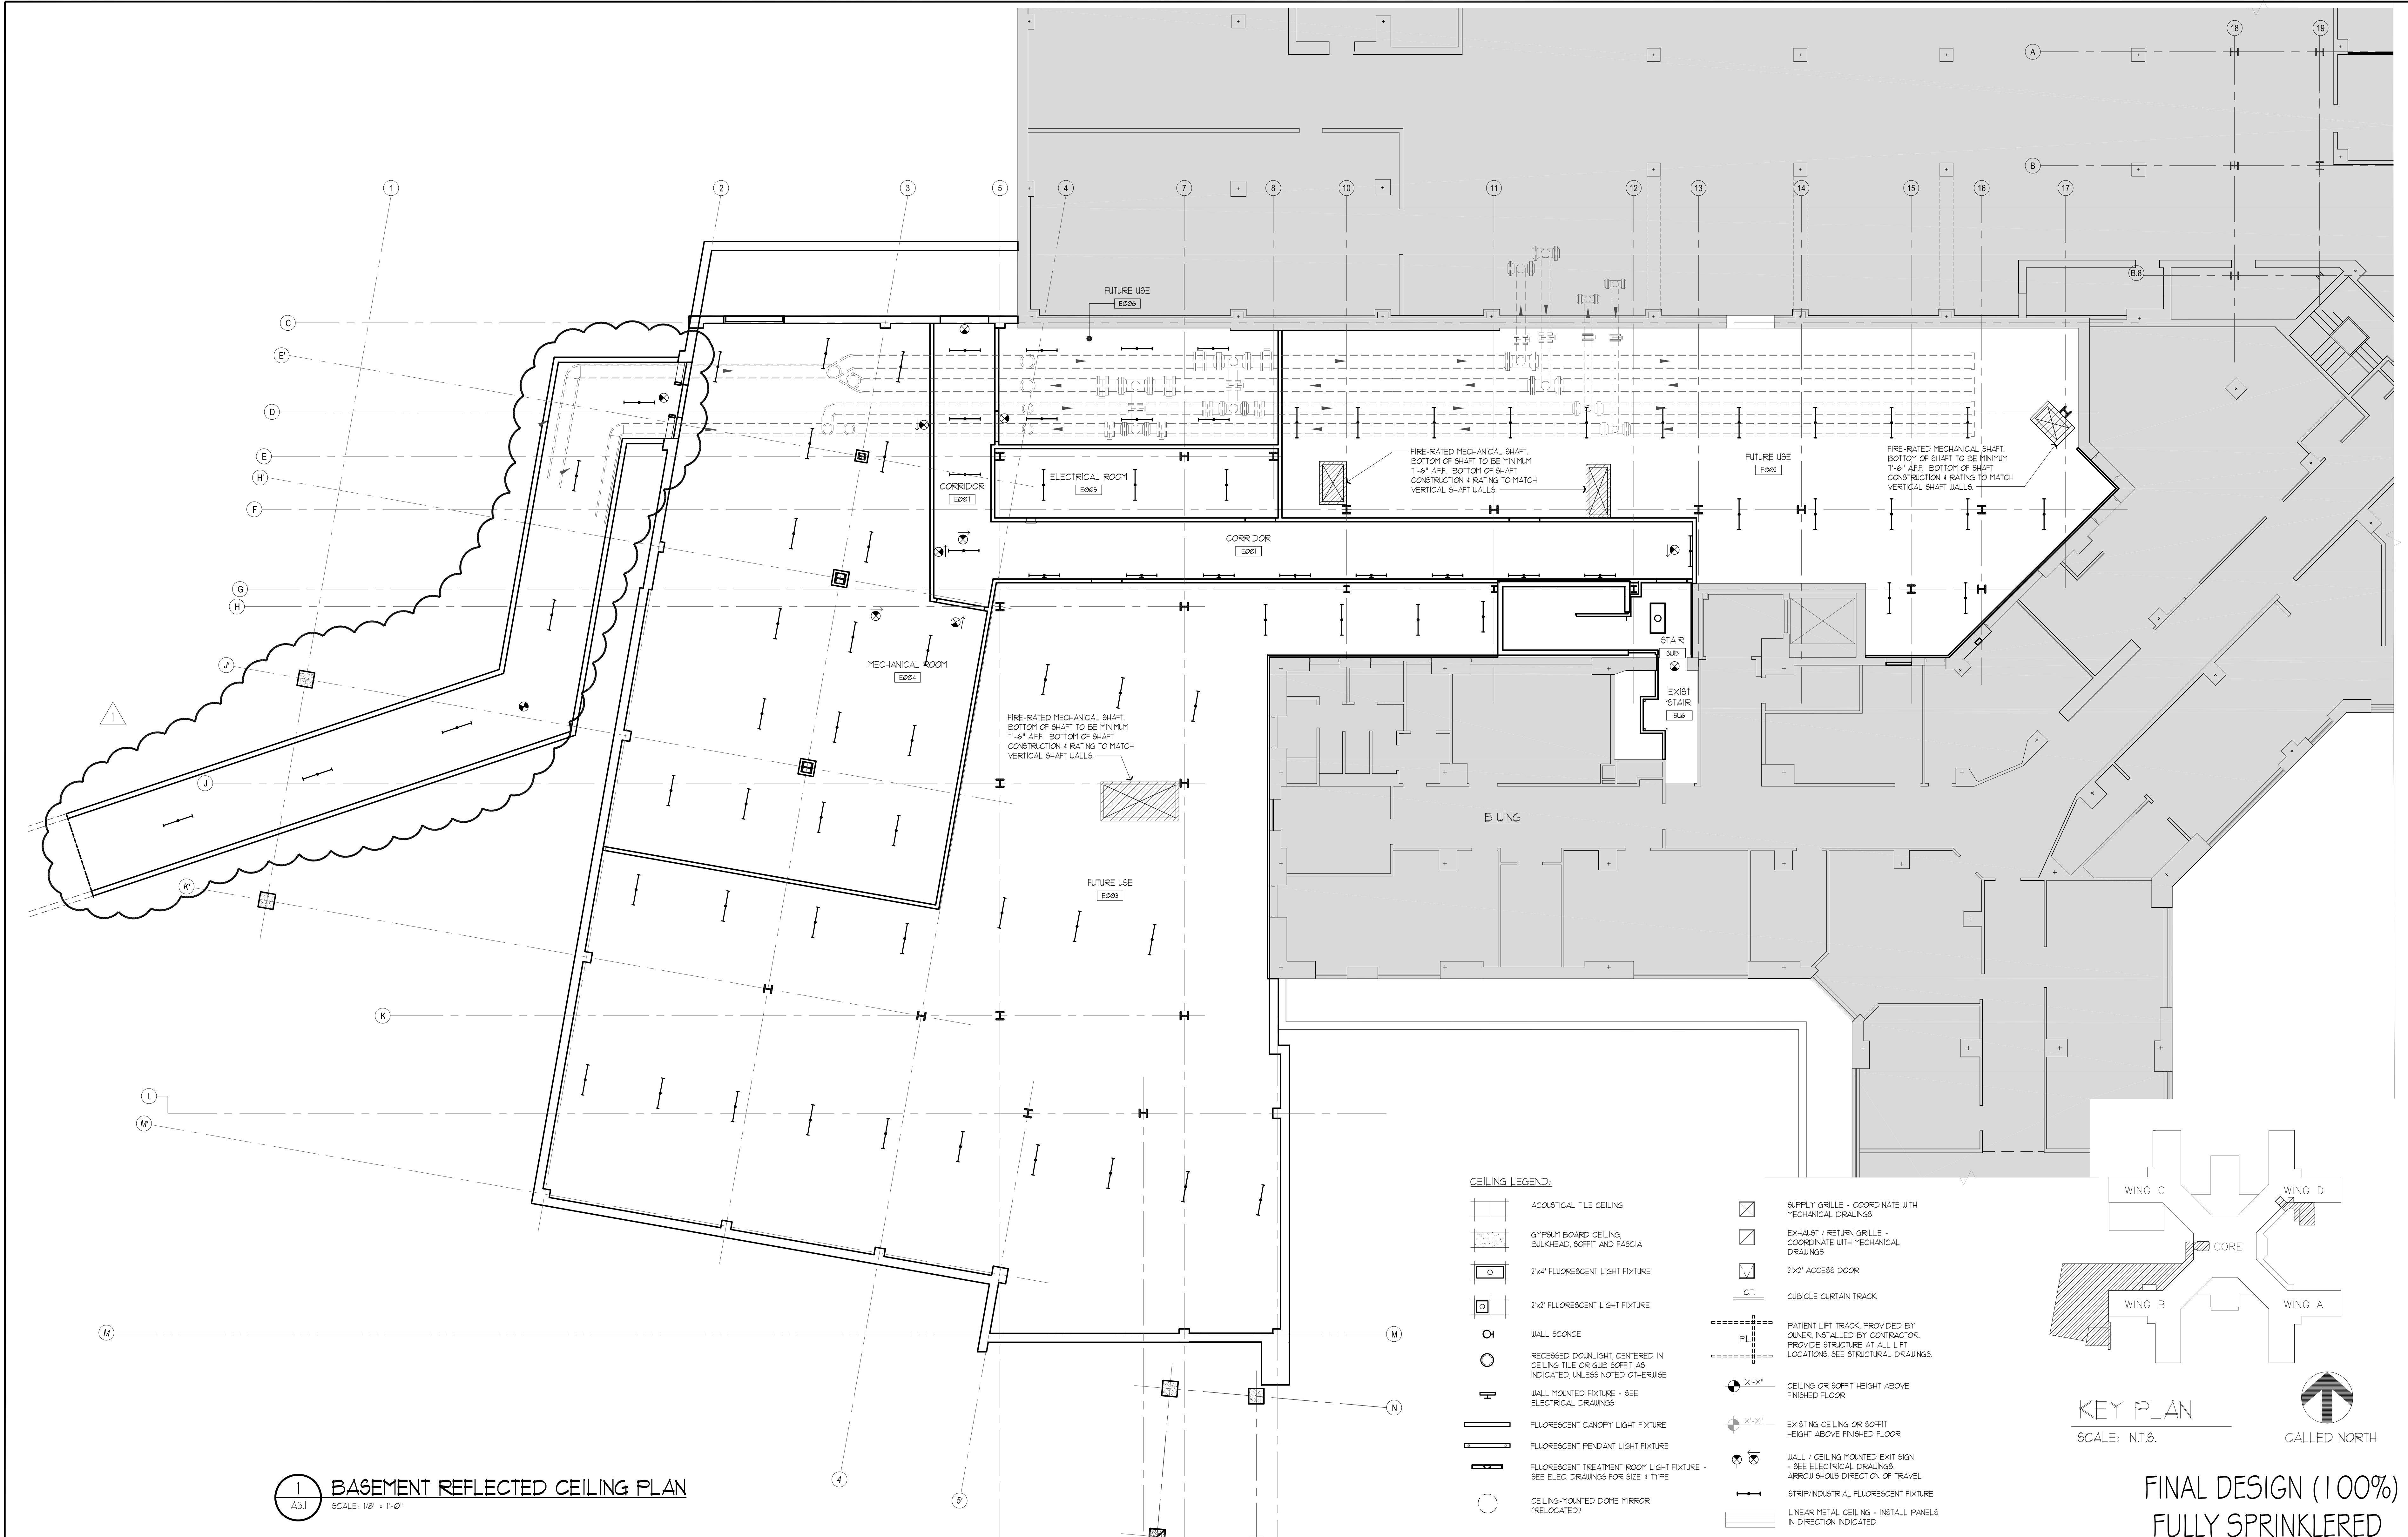

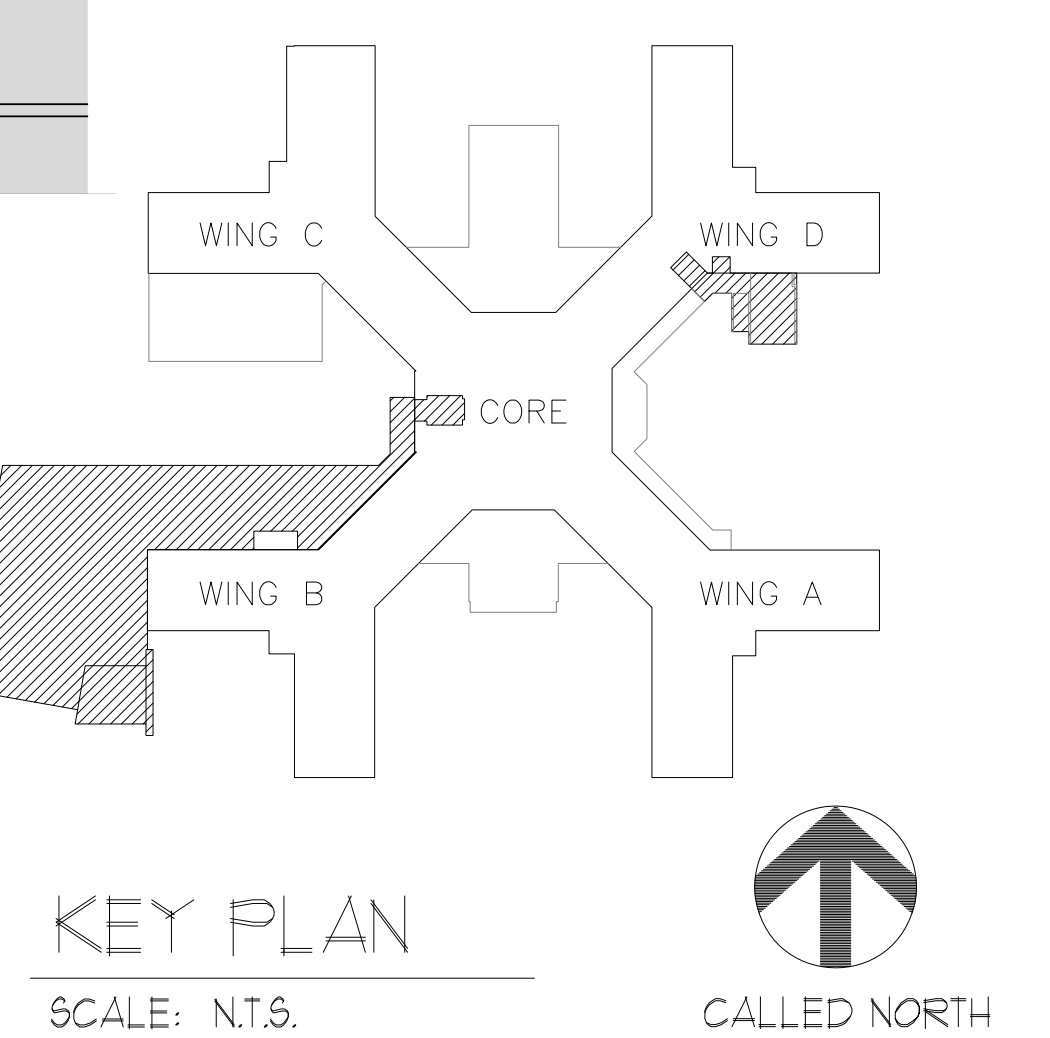


1 BASEMENT REFLECTED CEILING PLAN
SCALE: 1/8" = 1'-0"

- CEILING LEGEND:**
- ACOUSTICAL TILE CEILING
 - GYPSUM BOARD CEILING, BULKHEAD, SOFFIT AND FASCIA
 - 2'x4' FLUORESCENT LIGHT FIXTURE
 - 2'x2' FLUORESCENT LIGHT FIXTURE
 - WALL SCONCE
 - RECESSED DOWNLIGHT, CENTERED IN CEILING TILE OR GUS SOFFIT AS INDICATED, UNLESS NOTED OTHERWISE
 - WALL MOUNTED FIXTURE - SEE ELECTRICAL DRAWINGS
 - FLUORESCENT CANOPY LIGHT FIXTURE
 - FLUORESCENT PENDANT LIGHT FIXTURE
 - FLUORESCENT TREATMENT ROOM LIGHT FIXTURE - SEE ELEC. DRAWINGS FOR SIZE & TYPE
 - CEILING-MOUNTED DOME MIRROR (RELOCATED)
 - SUPPLY GRILLE - COORDINATE WITH MECHANICAL DRAWINGS
 - EXHAUST / RETURN GRILLE - COORDINATE WITH MECHANICAL DRAWINGS
 - 2'x2' ACCESS DOOR
 - CUBICLE CURTAIN TRACK
 - PATIENT LIFT TRACK, PROVIDED BY OWNER, INSTALLED BY CONTRACTOR, PROVIDE STRUCTURE AT ALL LIFT LOCATIONS, SEE STRUCTURAL DRAWINGS
 - CEILING OR SOFFIT HEIGHT ABOVE FINISHED FLOOR
 - EXISTING CEILING OR SOFFIT HEIGHT ABOVE FINISHED FLOOR
 - WALL / CEILING MOUNTED EXIT SIGN - SEE ELECTRICAL DRAWINGS, ARROWS SHOW DIRECTION OF TRAVEL
 - STRIP/INDUSTRIAL FLUORESCENT FIXTURE
 - LINEAR METAL CEILING - INSTALL PANELS IN DIRECTION INDICATED



**FINAL DESIGN (100%)
FULLY SPRINKLERED**

		CONSULTANTS:		ARCHITECT/ENGINEERS:		Drawing Title BASEMENT REFLECTED CEILING PLAN		Project Title NEW EMERGENCY DEPARTMENT Stratton VA Medical Center		Project Number VA 528-809		Office of Construction and Facilities Management			
		 <div>FRIEDMAN FISHER ASSOCIATES, P.C. <i>Quality Service Since 1944</i> CONSULTING ENGINEERS 22 AVENUE BOND, ALBANY, NEW YORK 12205 TEL (518) 458-7040 FAX (518) 458-7043 mail@friedmanfisher.com</div>		 <div>RYAN-BIGGS ASSOCIATES, P.C. 257 USHERS ROAD CLIFTON PARK, NY 12025 TEL (518) 458-7040 FAX (518) 458-7043 www.ryanbiggs.com</div>		 <div>Hyman Hayes ASSOCIATES 6 WEMBLEY COURT, ALBANY, NEW YORK 12205 (518) 452-3470 (518) 452-3783 Fax HHA Proj. 10046</div>		Approved Project Director		Location Albany, New York				Drawing Number A3.1 Dwg. 39 of 115	
 <div>EBERLIN AND EBERLIN, P.C. 247 ROUTE 100 SUITE 1003 SOMERS NEW YORK 10589 CONSULTING ENGINEERS, PLANNERS, LANDSCAPE ARCHITECTS 914.232.9431 PHONE 914.232.6827 FAX</div>								Date JUNE 13, 2012		Checked MW				Drawn MW/NM	
 ADDENDUM 1		Revisions										 Department of Veterans Affairs			