



three inches = one foot  
one and one half inches = one foot  
one inch = one foot  
three quarters inch = one foot  
one half inch = one foot  
three eighths inch = one foot  
one quarter inch = one foot  
one eighth inch = one foot  
one eighth inch = one foot





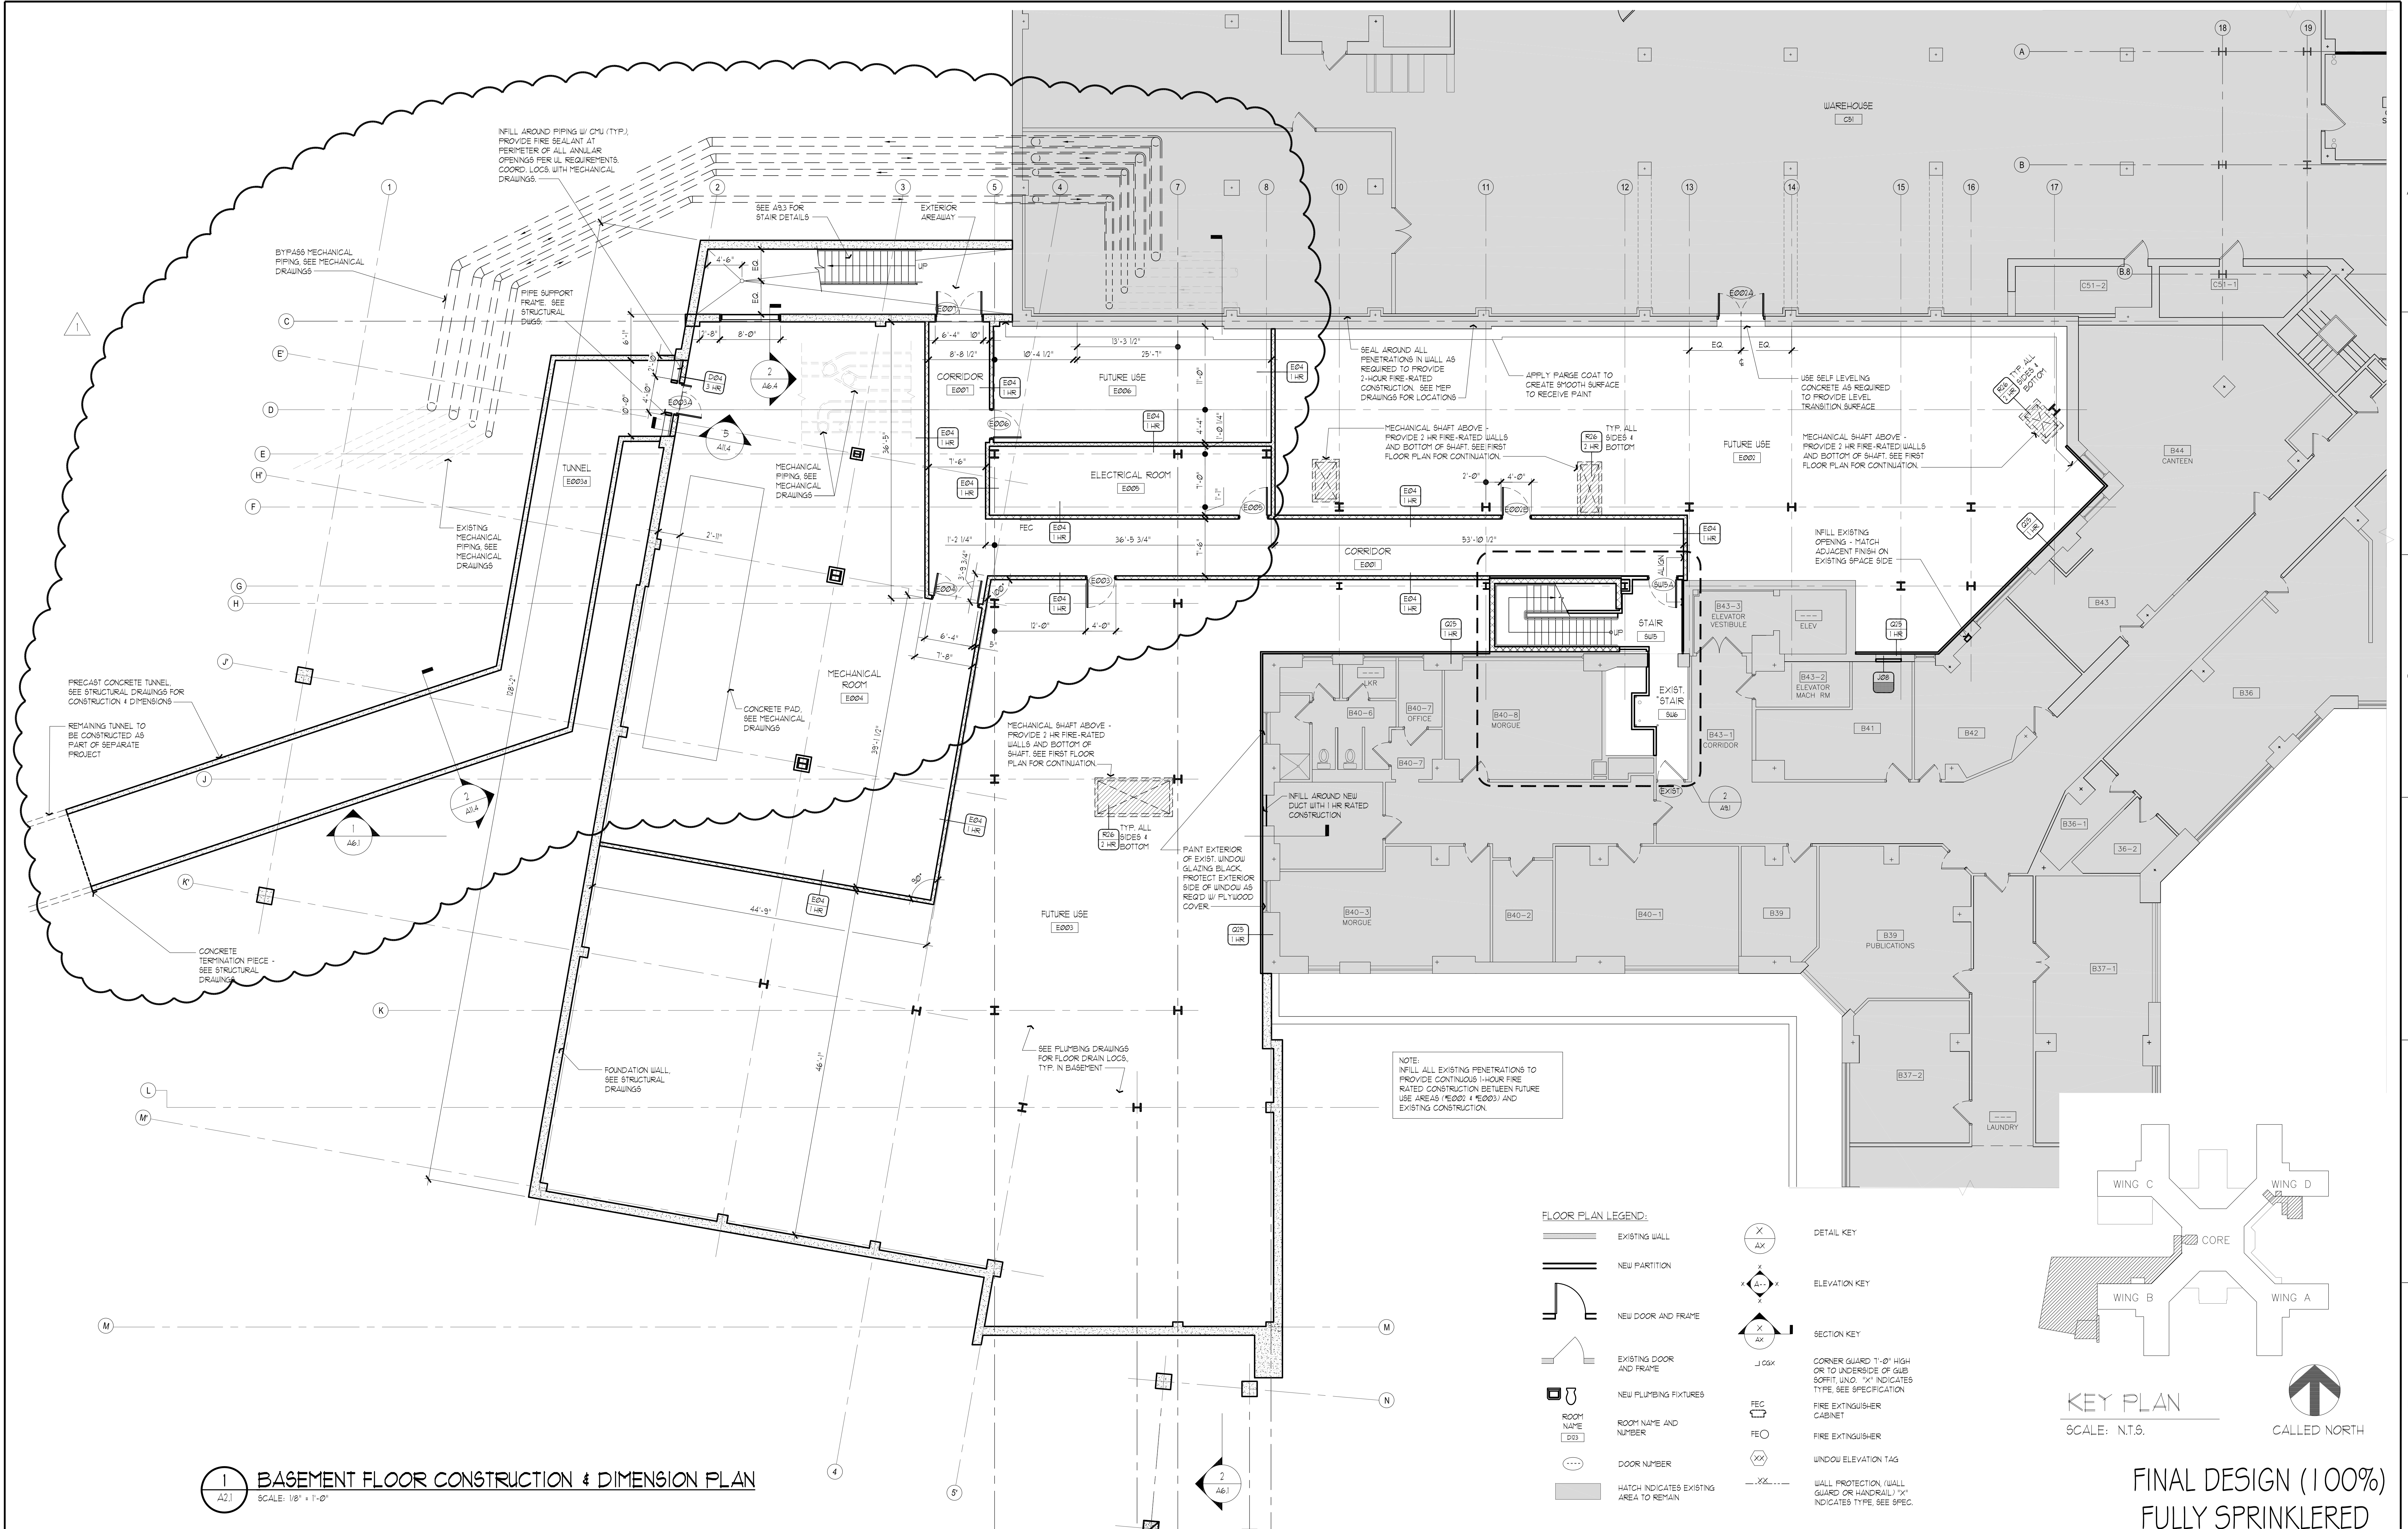

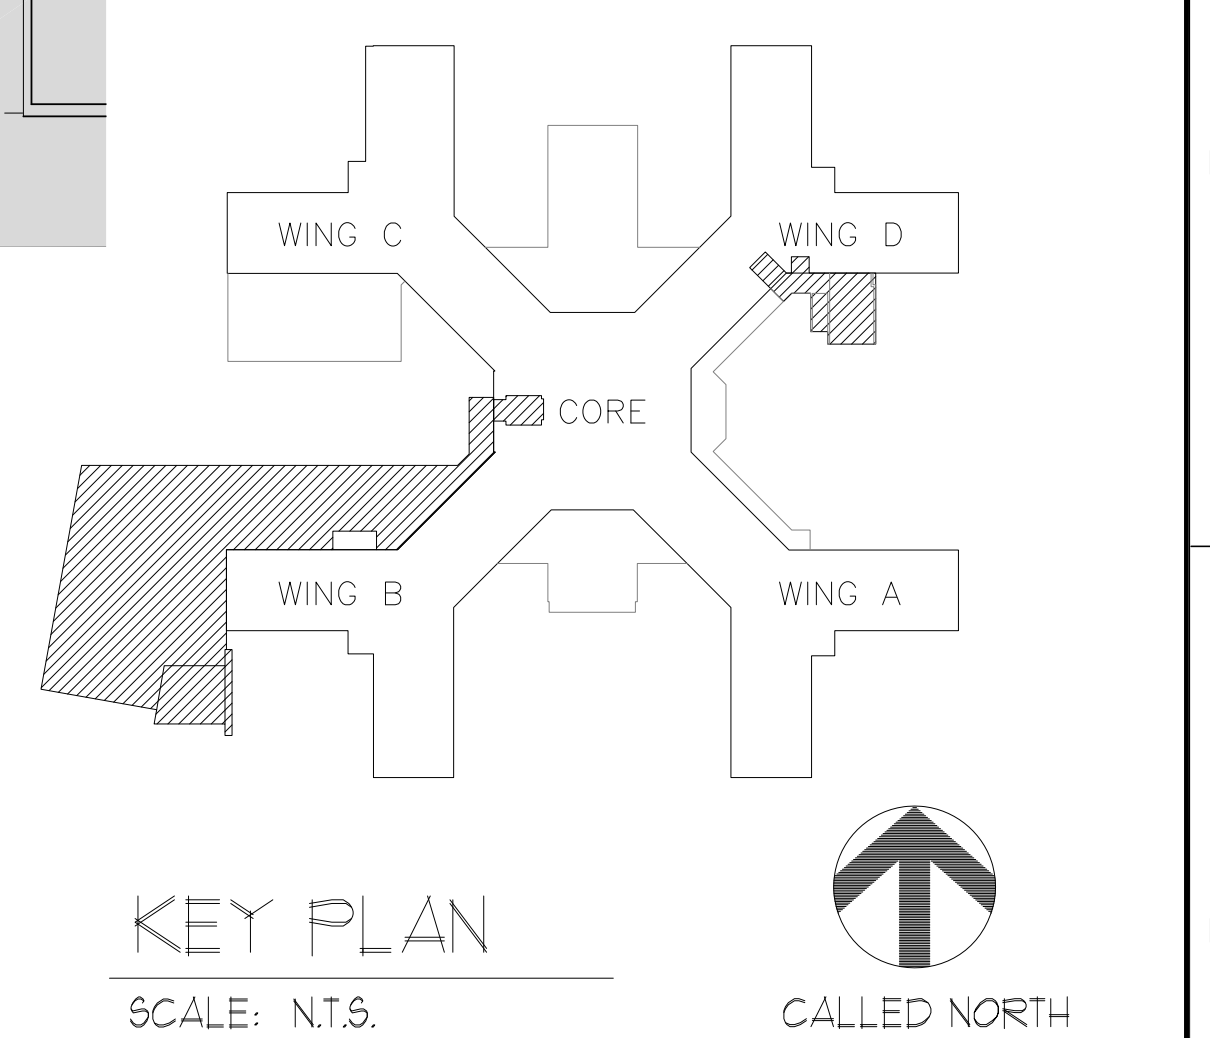

**1 BASEMENT FLOOR CONSTRUCTION & DIMENSION PLAN**  
SCALE: 1/8" = 1'-0"

- FLOOR PLAN LEGEND:**
- EXISTING WALL
  - NEW PARTITION
  - NEW DOOR AND FRAME
  - EXISTING DOOR AND FRAME
  - NEW PLUMBING FIXTURES
  - ROOM NAME AND NUMBER
  - DOOR NUMBER
  - HATCH INDICATES EXISTING AREA TO REMAIN
- DETAIL KEY**
- AX
  - ELEVATION KEY
  - SECTION KEY
  - CORNER GUARD 1'-0" HIGH OR TO UNDERSIDE OF GUB SOFFIT UNO "X" INDICATES TYPE SEE SPECIFICATION
  - FIRE EXTINGUISHER CABINET
  - FIRE EXTINGUISHER
  - WINDOW ELEVATION TAG
  - WALL PROTECTION (WALL GUARD OR HANDRAIL) "X" INDICATES TYPE SEE SPEC.



**FINAL DESIGN (100%)**  
**FULLY SPRINKLERED**

		<b>CONSULTANTS:</b>		<b>ARCHITECT/ENGINEERS:</b>		<b>Drawing Title</b> BASEMENT FLOOR CONSTRUCTION AND DIMENSION PLAN		<b>Project Title</b> NEW EMERGENCY DEPARTMENT Stratton VA Medical Center		<b>Project Number</b> VA 528-809		<b>Office of Construction and Facilities Management</b>			
		 <b>FRIEDMAN FISHER ASSOCIATES, P.C.</b> <i>Quality Service Since 1944</i> 22 AVENUE ROAD, ALBANY, NEW YORK 12205 TEL (518) 458-7040 FAX (518) 458-7043 mailto:info@friedmanfisher.com		 <b>RYAN-BIGGS ASSOCIATES, P.C.</b> 257 USHERS ROAD CLIFTON PARK, NY 12025 www.ryanbiggs.com		 <b>Hyman Hayes</b> ASSOCIATES 6 WEMBLEY COURT, ALBANY, NEW YORK 12205 (518) 452-3470				<b>Building Number</b> 95					
		<b>EBERLIN AND EBERLIN, P.C.</b> 247 ROUTE 100 SUITE 1003 SOMERS NEW YORK 10589 CONSULTING ENGINEERS, PLANNERS, LANDSCAPE ARCHITECTS 914.232.9431 PHONE 914.232.6827 FAX				<b>Approved Project Director</b>		<b>Location</b> Albany, New York		<b>Drawing Number</b> <b>A2.1</b> Dwg. 34 of 115					
 <b>APPENDIX A</b> Revisions		<b>Date</b> 7-24-12				<b>HHA Proj. 10046</b>		<b>Date</b> JUNE 13, 2012		<b>Checked</b> MW		<b>Drawn</b> NM/MW		 <b>Department of Veterans Affairs</b>	