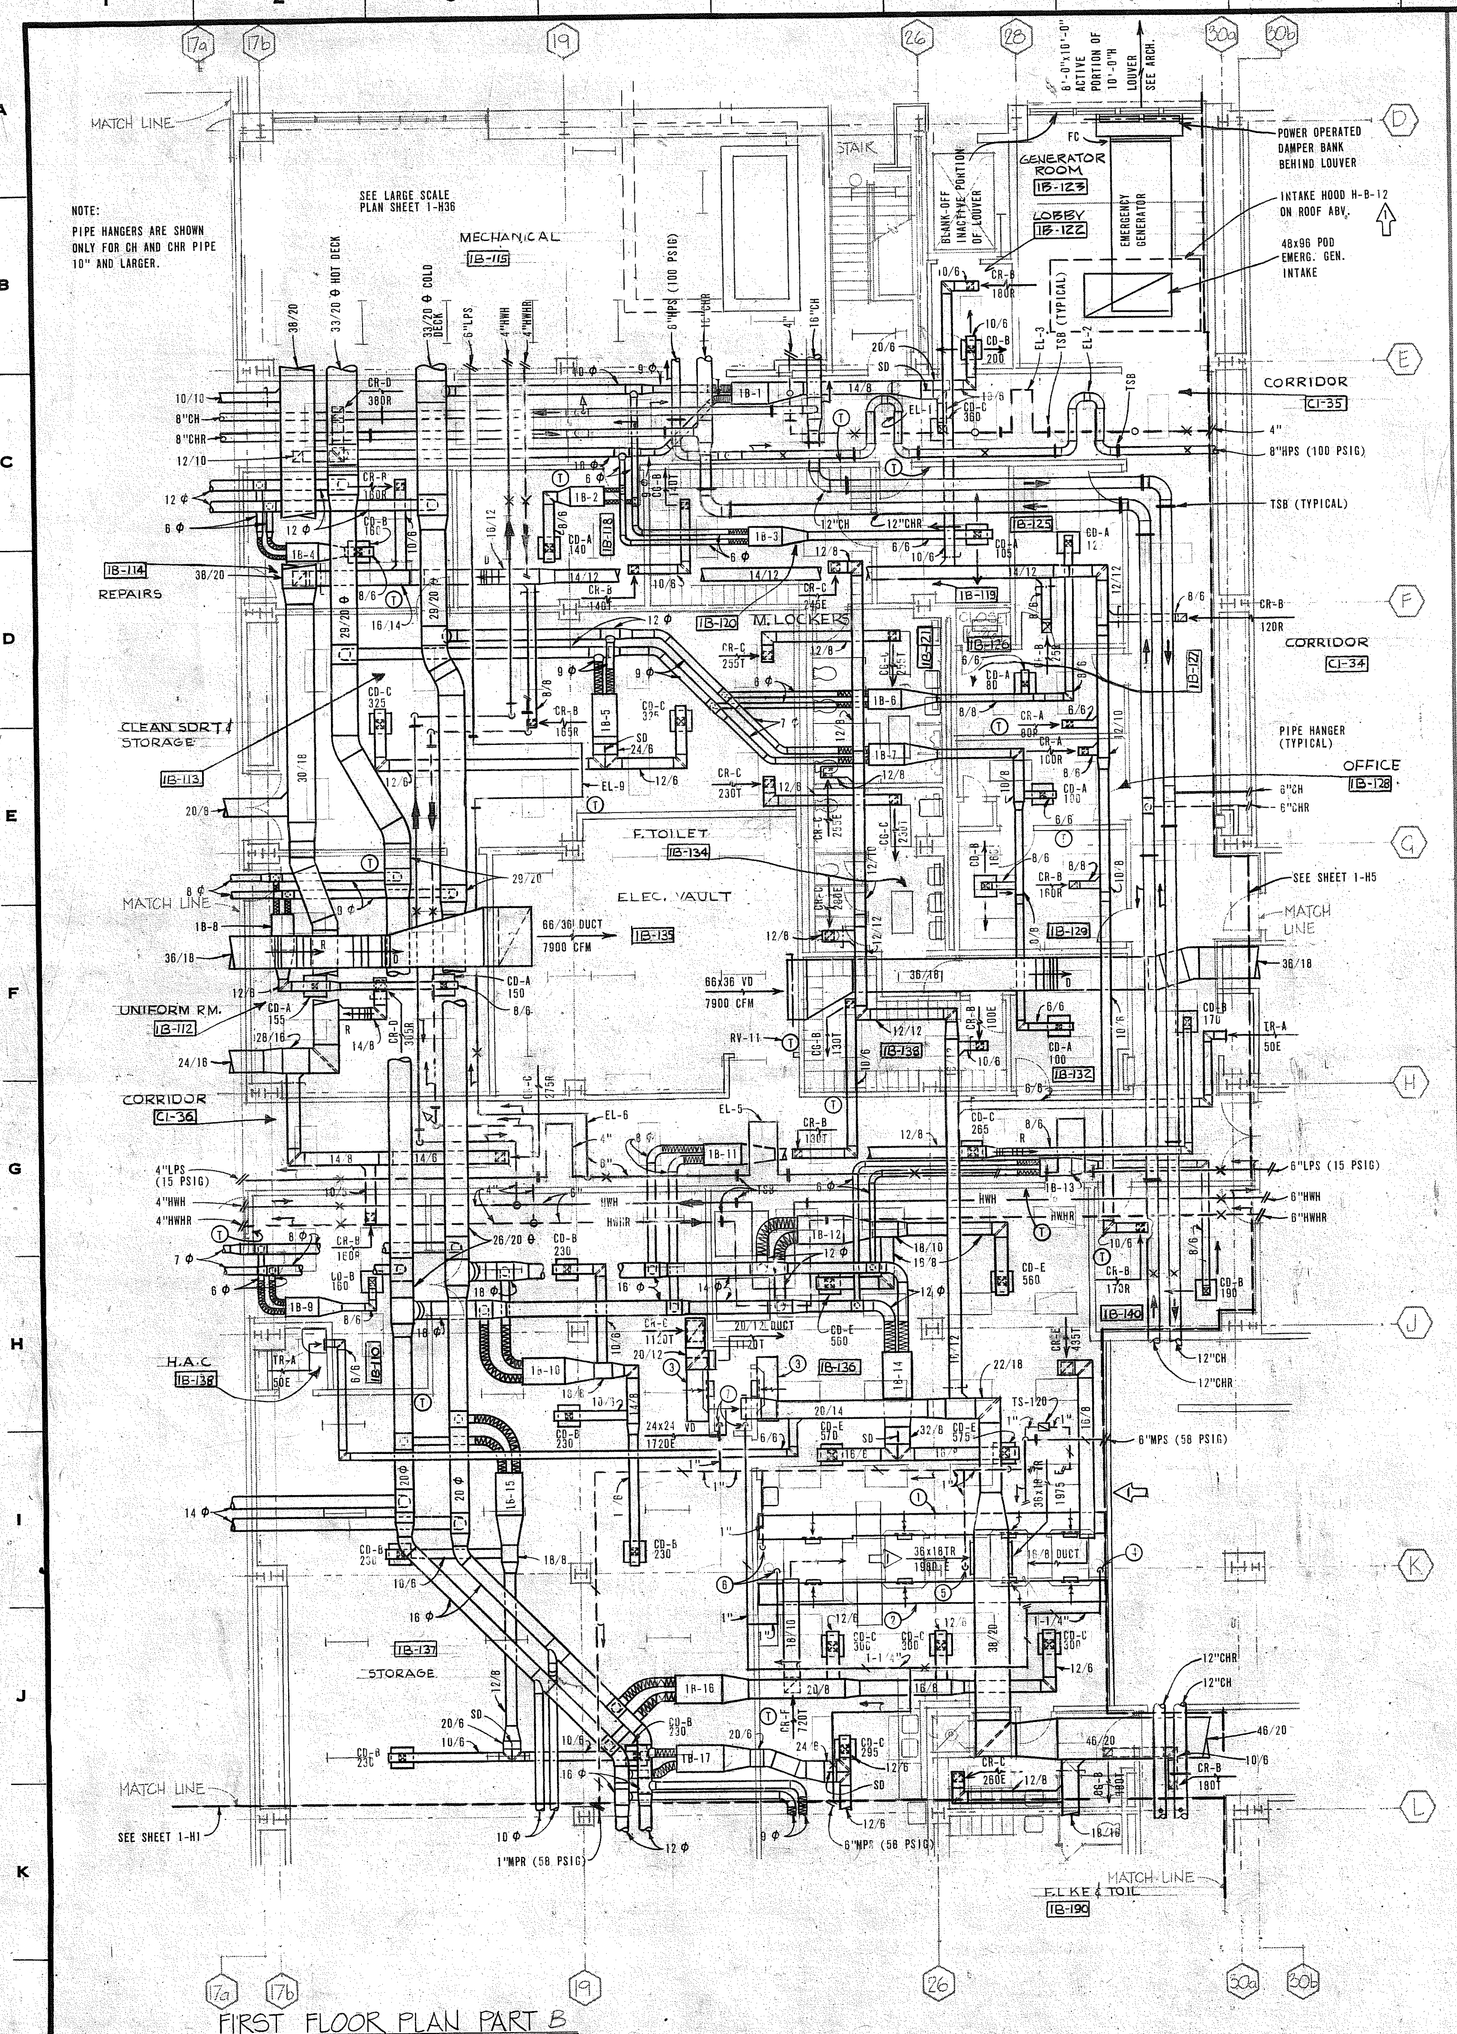

FIRST FLOOR PLAN PART B
SCALE: 1/8 = 1'-0

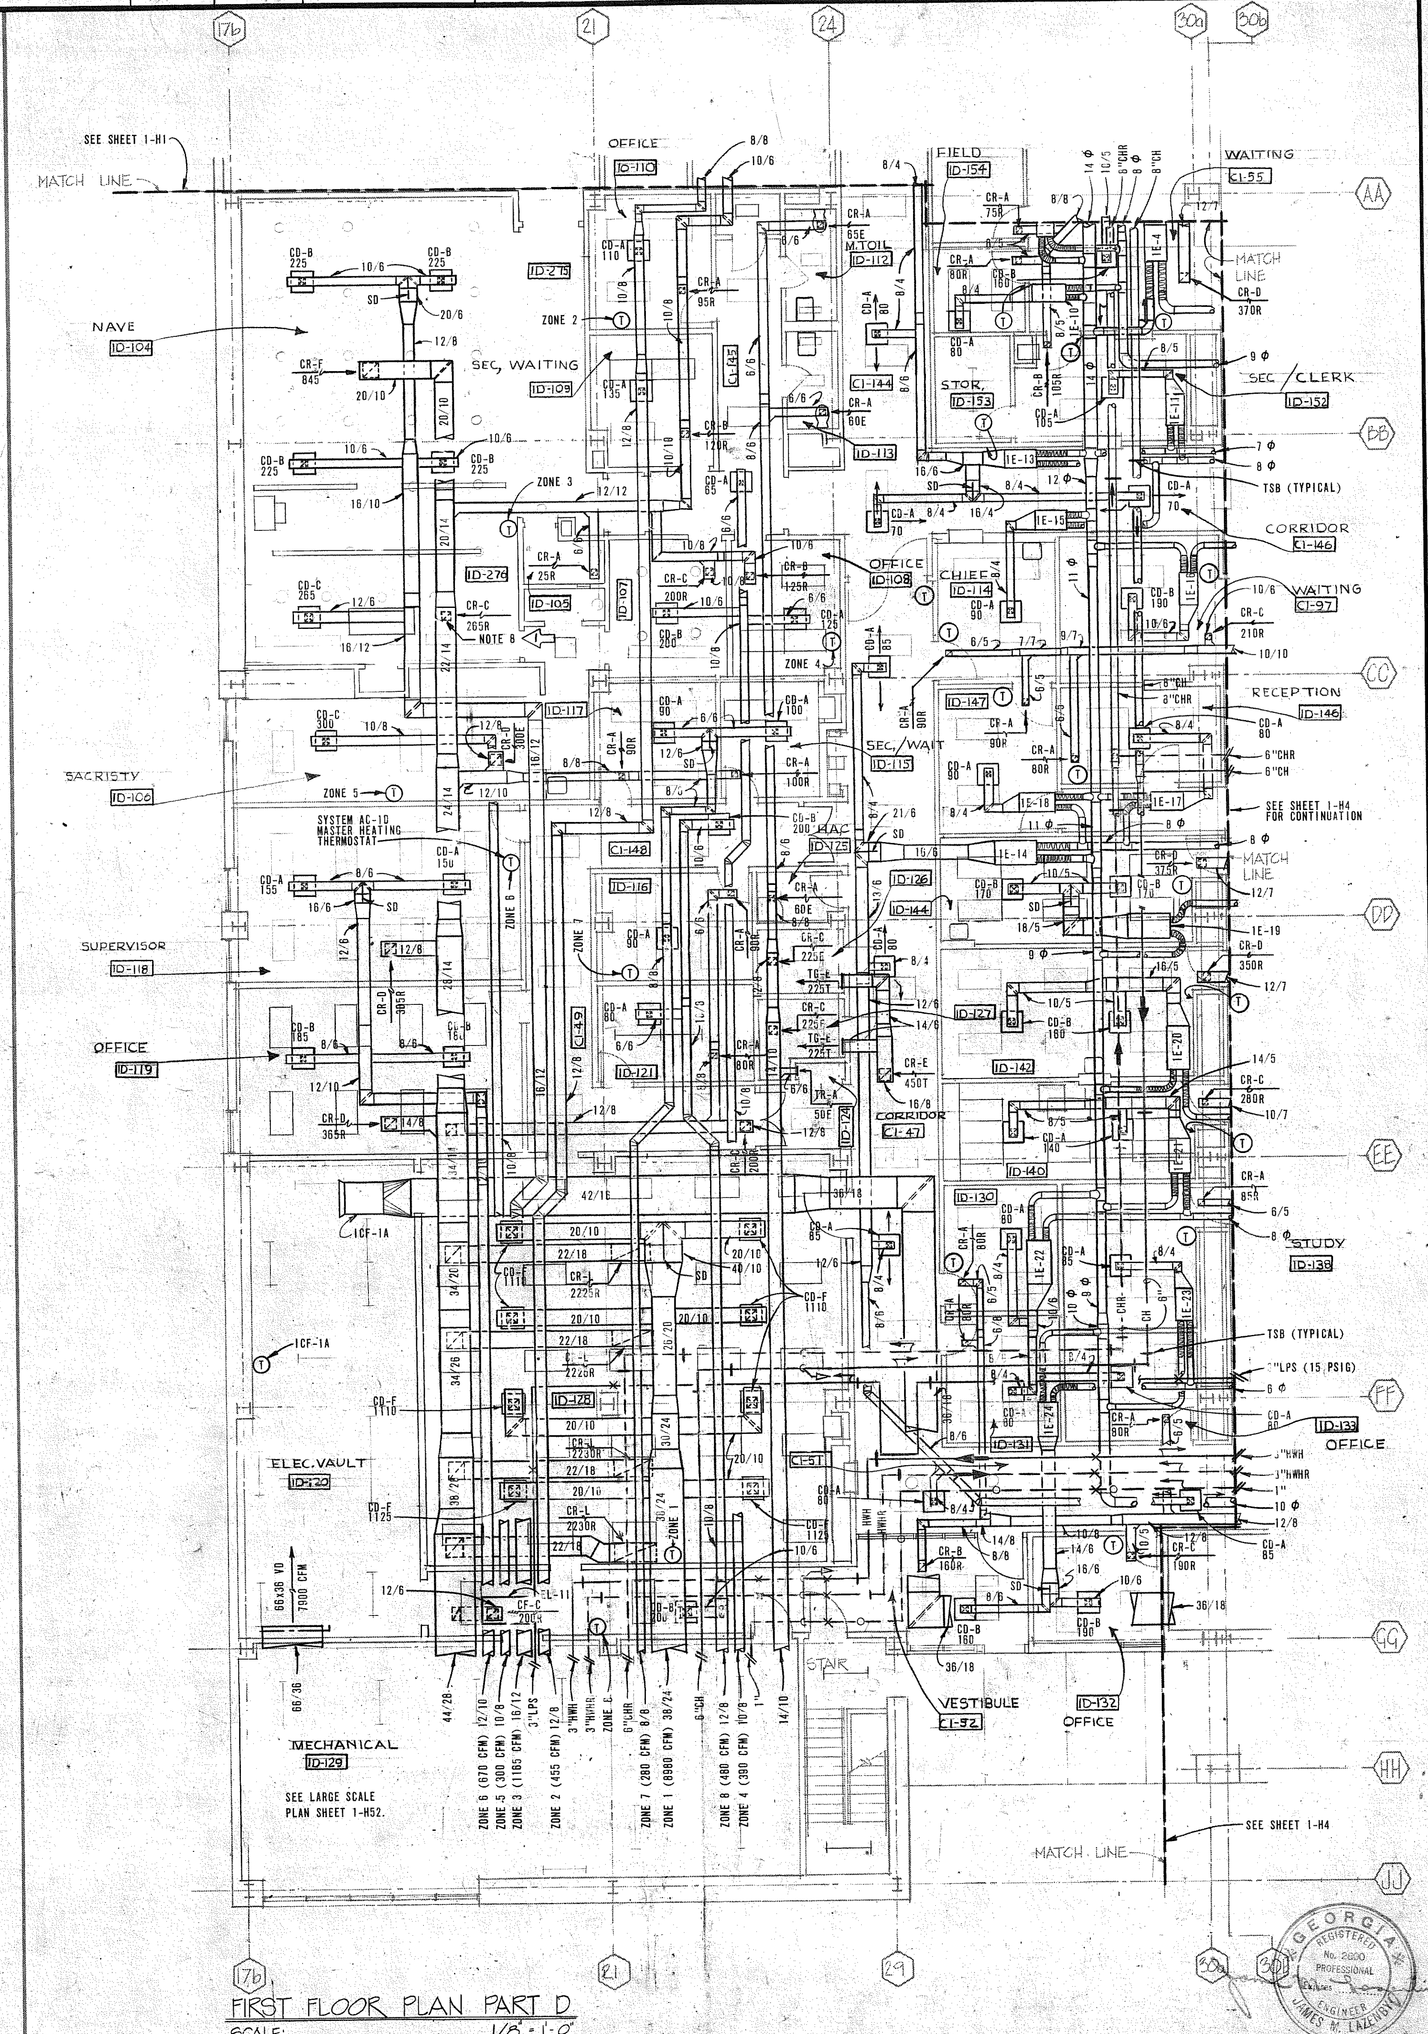

FIRST FLOOR PLAN PART D
SCALE: 1/8 - 1'-0

NOTES:

1. TYPE B HOOD, 2'-0" x APPROXIMATELY 33'-0". FABRICATE HOOD TO ACCOMODATE OFFSET IN WALL. EXHAUST WITH 4 TR-M'S. 1400 CFM.
2. TYPE B HOOD 2'-0" x APPROXIMATELY 33'-0". EXHAUST WITH 4 TR-M'S. 1400 CFM .
3. 2'-0"x6'-0" TYPE B HOOD WITH TR-G. 300 CFM.
4. 1-1/4"MPS DOWN TO 2 VS326 STERILIZERS AND VS210 STERILIZER. PROVIDE RSB AT TOP OF RISER.
5. 1"MPR FROM TS-109. PROVIDE RSB AT TOP OF RISER.
6. 1"MPS DOWN TO VS508 AND 1"MPR FROM TS-108. PROVIDE RSB AT TOP OF EACH RISER.
7. 1"MPS DOWN TO VS210 AND 1"MPR FROM TS-107. PROVIDE RSB AT TOP OF EACH RISER.
8. PROVIDE VOLUME DAMPER IN VERTICAL STUB DUCT TO EXHAUST OR RETIRN REGISTER WHERE INDICATED.

ROOM NUMBER	ROOM TITLE
18-125	OFFICE
18-118	STORAGE
18-119	M. LOUNGE
18-126	STORAGE
18-127	CHIEF
18-138	F. LOCKERS
18-128	DATA PROCESSING
CI-51	CORRIDOR
10-131	OFFICE
10-130	OFFICE
10-140	CALIBRATION
10-142	AURAL REHABILITATION
10-144	GROUP THERAPY
10-147	SECREYARY
10-113	F. TOILET
10-111	CLOSET
CI-124	CORRIDOR
CI-145	CORRIDOR
10-105	CONFESSION
10-107	DEVOTIONAL
10-147	SECRETARY
10-124	TEL-CLO.
10-121	CLOTHING STORE
CI-49	CORRIDOR
10-116	OFFICE
10-126	ELECT.
10-117	OFFICE
18-136	STERILE WORK ROOM
18-140	ON-CALL DINING
10-127	SIGNAL

NO	DATE	DESCRIPTION
1	5-25-80	AS BUILT.

REVISIONS

KEY PLAN – FIRST FLOOR

BLDG. NORTH
MAG. NORTH

SHEET TITLE
FIRST FLOOR PLAN PART B & D

BLDG. NO. I
PROJECT TITLE 420 BED MS & N REPLACEMENT HOSPITAL

DRAWN	CHECKED	DATE
L.A.J.	D.M.M.	20 APRIL 1977

Abreu & Robeson, Inc.
Architects and Engineers
135 Walton Street, NW Atlanta, Ga.

APPROVED: PROJECT DIRECTOR

DRAWING NUMBER 1-H3
DWG. 3 OF 68
PROJECT NUMBER 510-001B

VETERANS ADMINISTRATION

LOCATION VAH, AUGUSTA, GEORGIA

REGISTERED No. 20200 PROFESSIONAL ENGINEER JAMES M. LAZENBY GEORGIA

THREE INCHES EQUALS ONE FOOT
ONE AND ONE HALF INCHES EQUALS ONE FOOT
ONE INCH EQUALS ONE FOOT
THREE QUARTER INCH EQUALS ONE FOOT
ONE HALF INCH EQUALS ONE FOOT
THREE EIGHTH INCH EQUALS ONE FOOT
ONE QUARTER INCH EQUALS ONE FOOT
ONE EIGHTH INCH EQUALS ONE FOOT

VA FORM 08-6231, FEB 1973

3/80
1-H3 AS BUILT
420 BED MS&N REPL. HOSP.
510-001B
EAS FILE CORP. IRVINE, CA
EFH 30