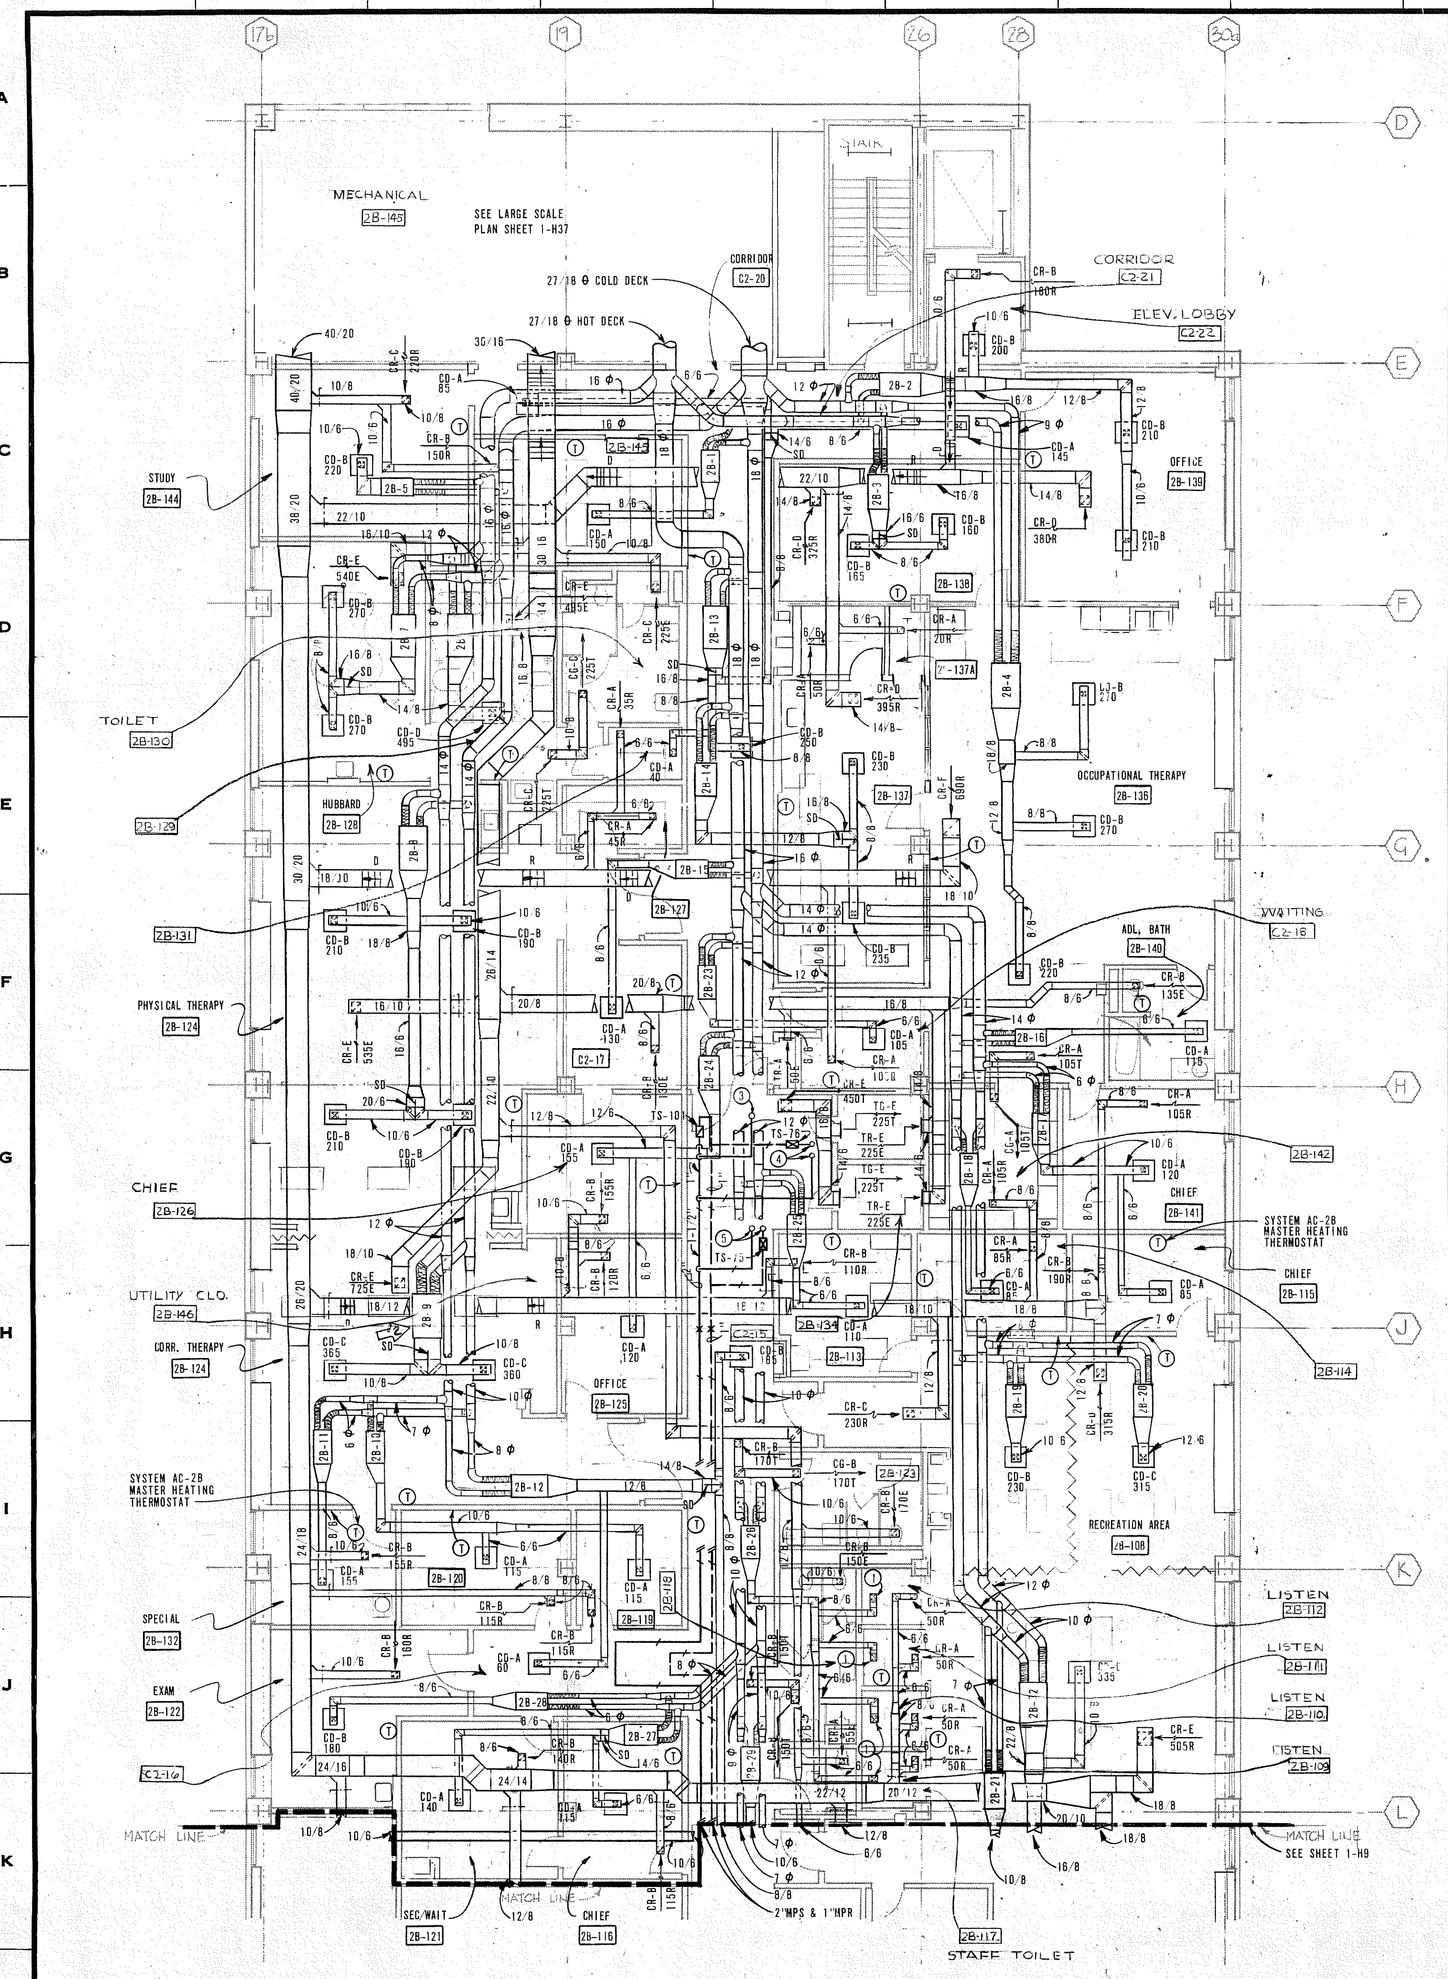

SECOND FLOOR PLAN PART B
SCALE: 1/8" = 1'-0"

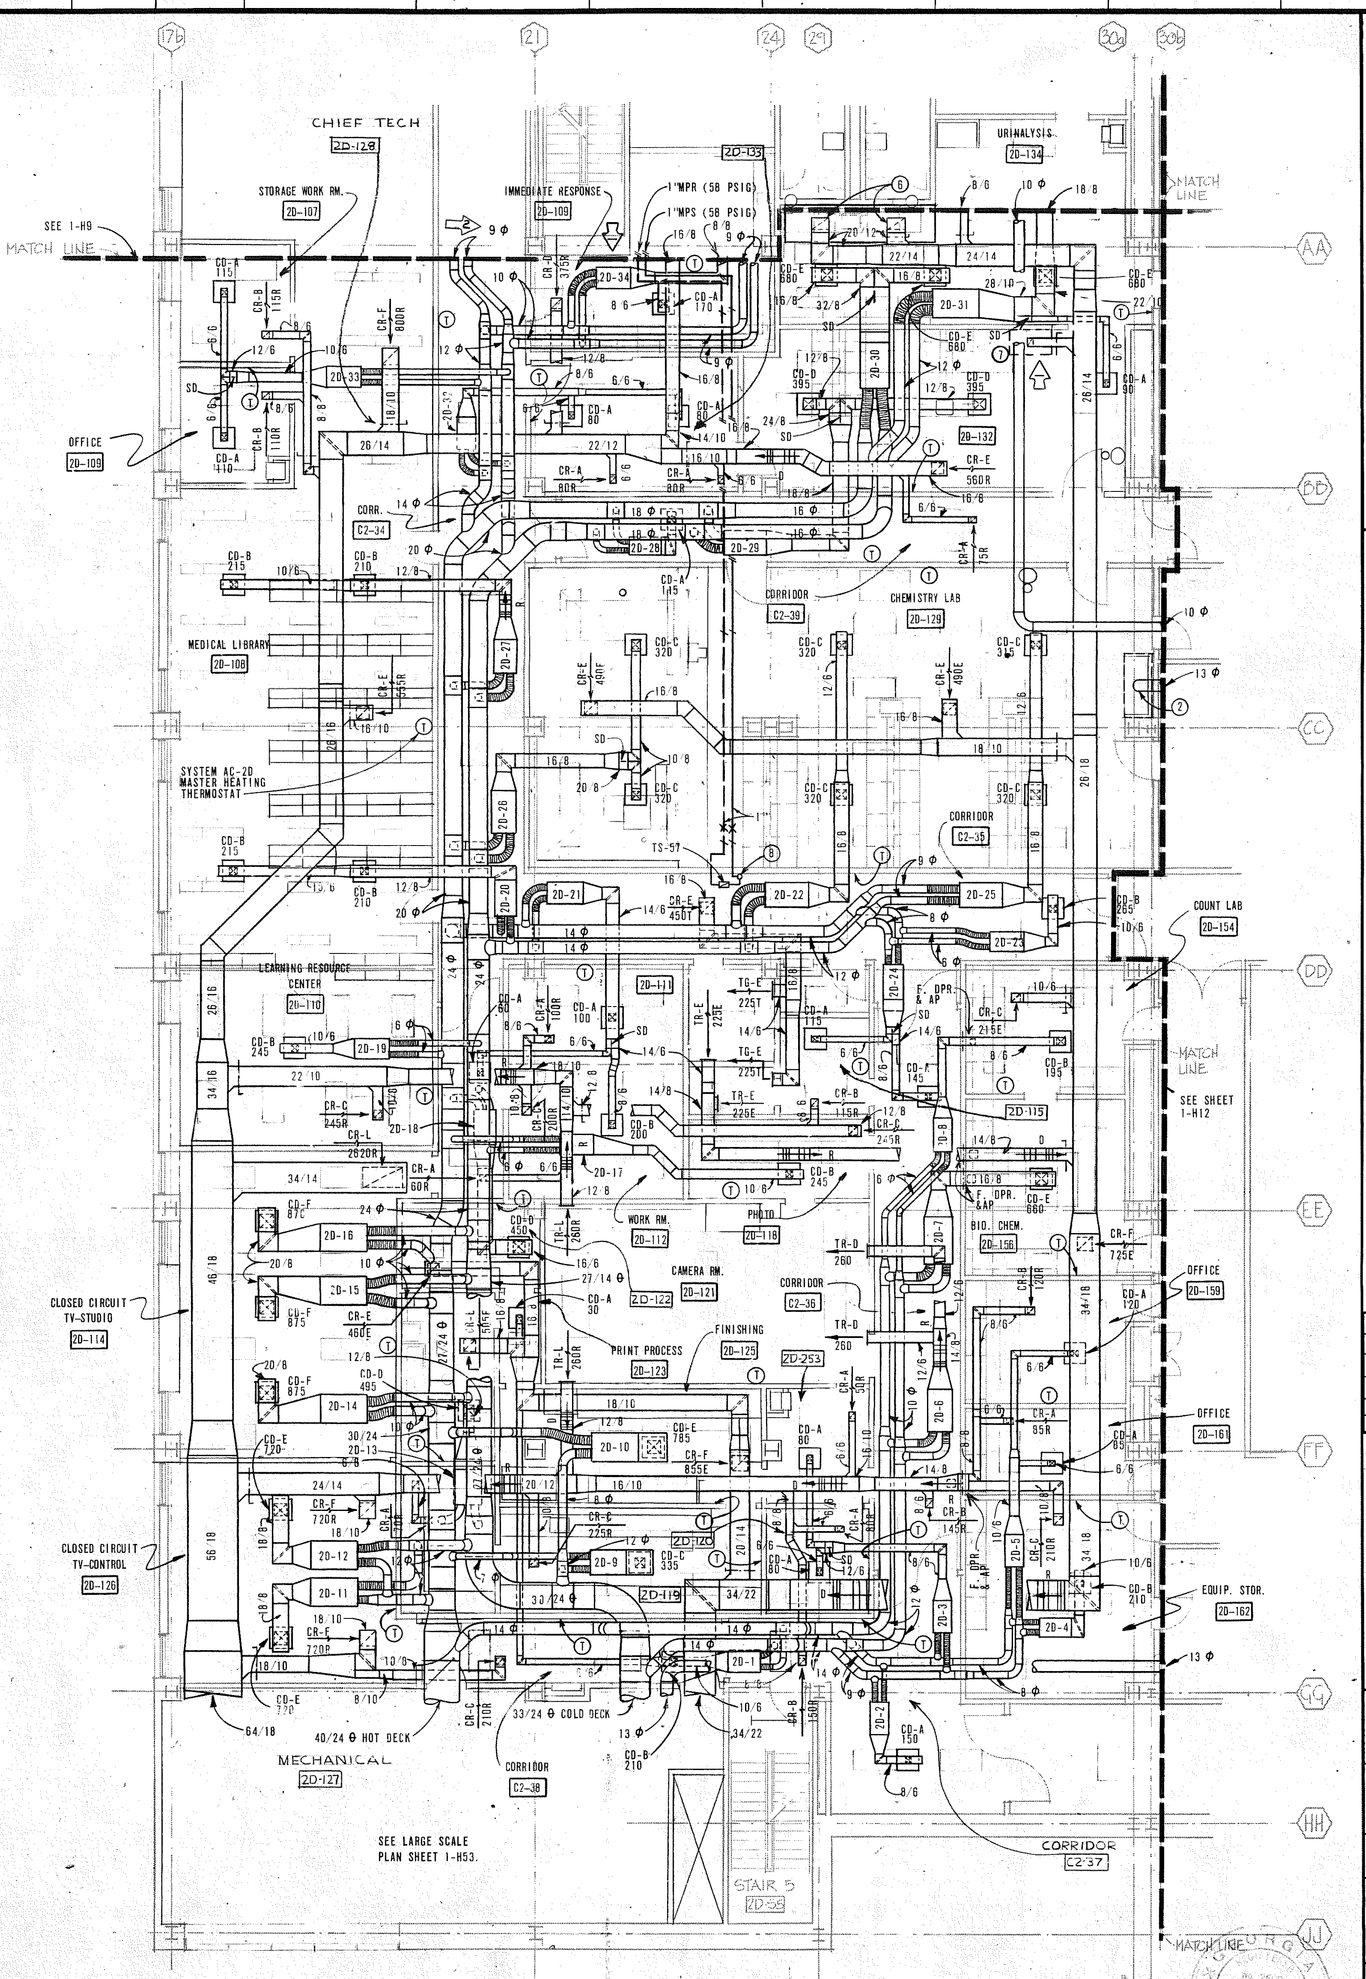

SECOND FLOOR PLAN PART D
SCALE: 1/8" = 1'-0"

NOTES:

1. PROVIDE CD-A AND BALANCE TO 50 CFM.
2. PROVIDE TRANSITION AND CONNECT EXHAUST DUCT TO FUME HOOD SPECIFIED UNDER ANOTHER DIVISION.
3. 1"MPS UP TO VS260 ON THIRD FLOOR.
4. 1"MPS & MPR UP TO OW500 ON THIRD FLOOR.
5. 1"MPS & MPR UP TO HW516 ON THIRD FLOOR.
6. TWO 20/12 DUCTS DOWN TO 14'-0"x3'-6" TYPE C HOOD.
7. TURN 10/8 DUCT DOWN AT BIOLOGICAL AIR FLOW CABINET. SEE DETAIL 11/H-10 FOR DUCT TERMINATION. BALANCE TO EXHAUST 150 CFM.
8. 1"MPS UP TO HW534 ON THIRD FLOOR.

ROOM NUMBER	ROOM TITLE
28-132	BLOOD BANK
28-111	EDIT
28-138	CONFERENCE
28-137A	WOOD STORAGE
28-137	SHOP
28-127	STORAGE
C2-17	WAITING
28-113	ACTIVITY
28-120	OFFICE
28-119	OFFICE
20-115	RECORD
28-133	OFFICE
20-119	ILLUSTRATION
20-120	OFFICE
28-123	F. TOILET
C2-15	CORRIDOR
28-114	CHECK-OUT
28-142	STORAGE
28-134	ELEC. CLO.
28-143	EVALUATION
28-129	WHIRLPOOL
28-131	LINEN
C2-16	CORRIDOR
28-118	M. TOILET

NO	DATE	DESCRIPTION
2	5-25-80	AS BUILT
1	7-12-78	REVISIONS AS INDICATED

REVISIONS

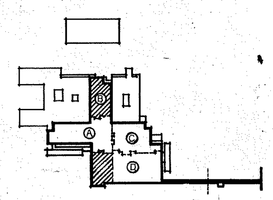

KEY PLAN SECOND FLOOR

SHEET TITLE

SECOND FLOOR PLAN PART B&D

BLDG. NO.	PROJECT TITLE
1	420 BED MS & N REPLACEMENT HOSPITAL

DRAWN	CHECKED	DATE
L.A.J.	D.M.M.	20 APRIL 1977

Abreu & Robeson, Inc.
Architects and Engineers
135 Walton Street, N.W. Atlanta, Ga.

DRAWING NUMBER 1-H11
DRG. 11 OF 68
PROJECT NUMBER 510-001B

APPROVED: PROJECT DIRECTOR

VETERANS ADMINISTRATION

LOCATION VAH, AUGUSTA, GEORGIA

THREE INCHES EQUALS ONE FOOT
ONE AND ONE HALF INCHES EQUALS ONE FOOT
ONE INCH EQUALS ONE FOOT
THREE QUARTER INCH EQUALS ONE FOOT
ONE HALF INCH EQUALS ONE FOOT
THREE EIGHTH INCH EQUALS ONE FOOT
ONE QUARTER INCH EQUALS ONE FOOT
ONE EIGHTH INCH EQUALS ONE FOOT

VA FORM 08-6231, FEB 1973

1-H11 2ND FL. 420 BED MS&N HOSP.
EASI FILE DORR-IRVING, CA