


Piston Rings : 9.000" Cylinder Bore Diameter
7.875" Groove Root Diameter
1/2" Groove Width
Carbon Filled Teflon or Better 4 pcs. Angle Cut

Rider Rings : 9.000" Cylinder Bore Diameter
8.250" Groove Root Diameter
2.250" Groove Width
Carbon Filled Teflon or better 2 pcs. Angle Cut

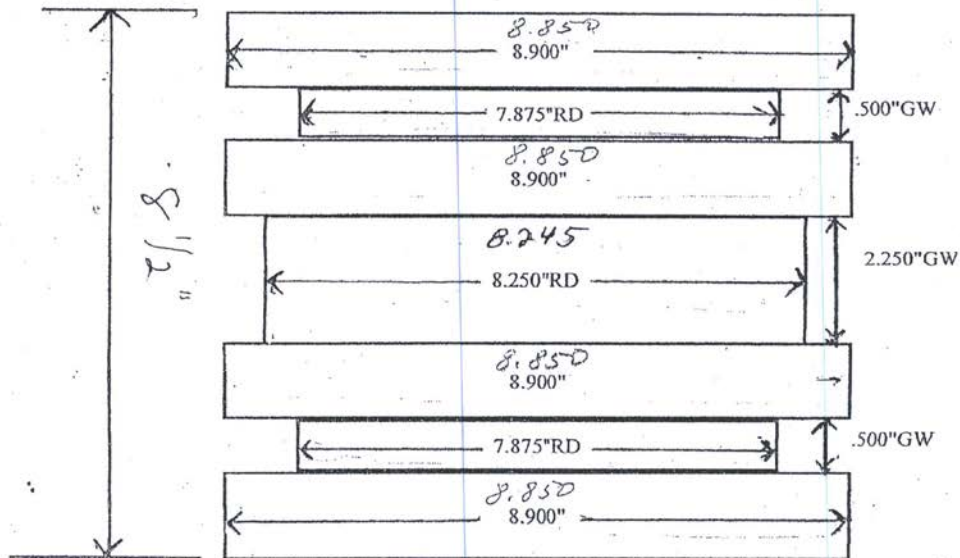

2 peice Aluminum Piston

Reference:

Renewal Belts for Your "American"
Air Compressors; Size 8-1/2 X 9, Type AFO-1,
30 HP, Non-Lube, 100 psi, Sn's 50748 and 50748B