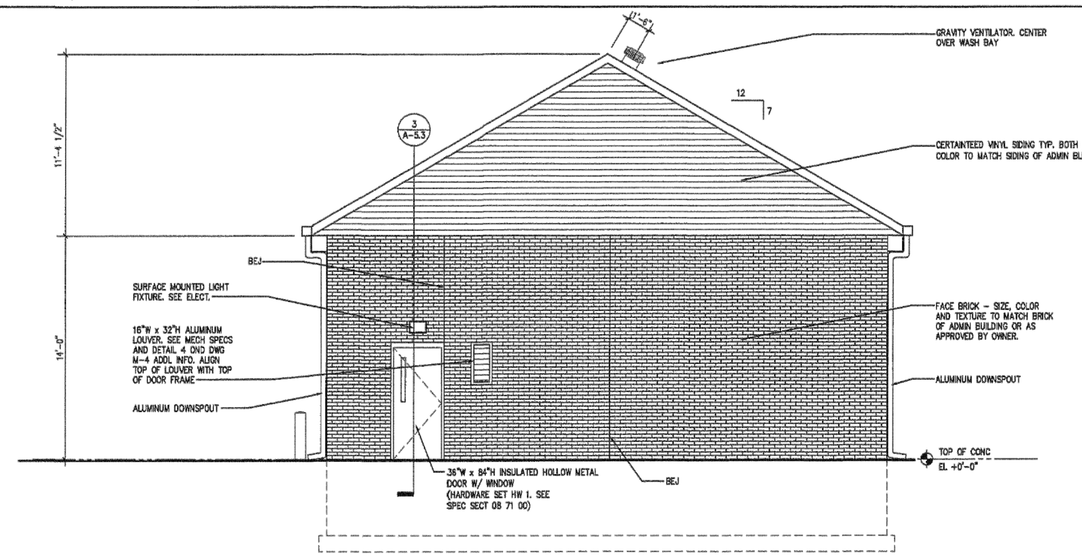

2 NORTH ELEVATION
SCALE: 1/4"=1'-0"

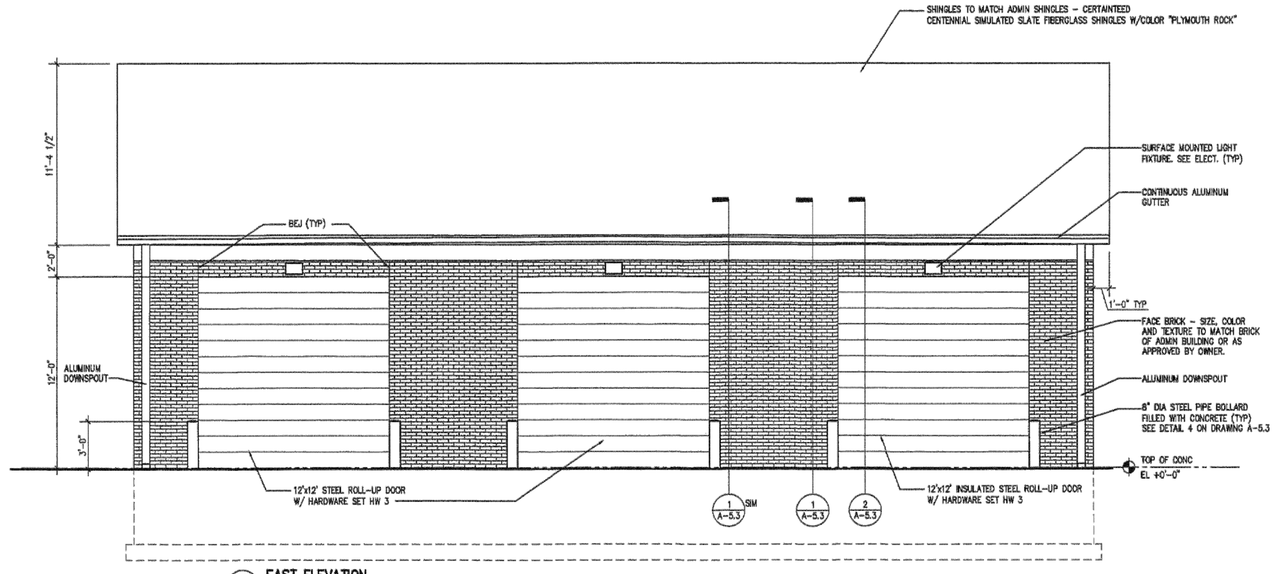

3 EAST ELEVATION
SCALE: 1/4"=1'-0"

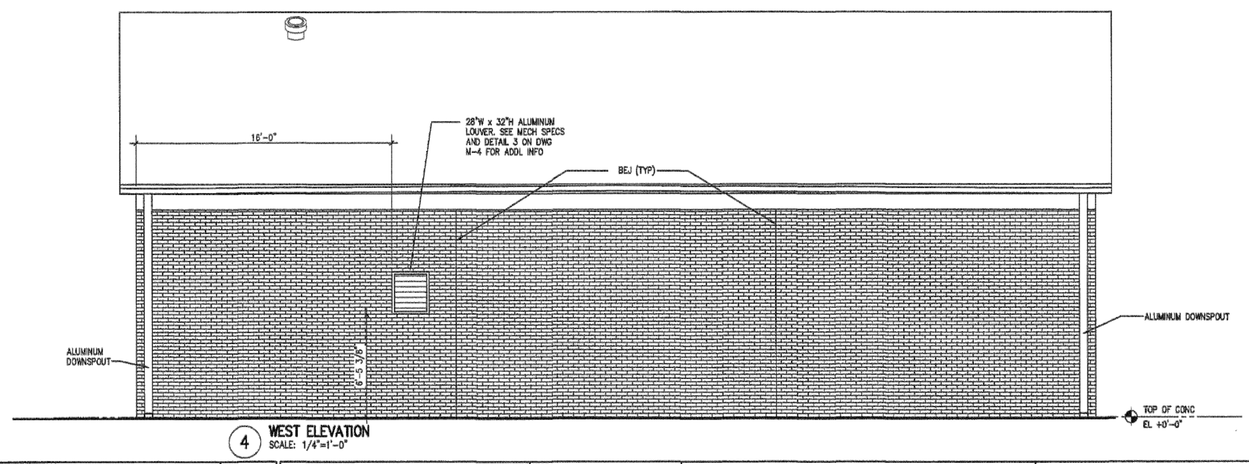

4 WEST ELEVATION
SCALE: 1/4"=1'-0"

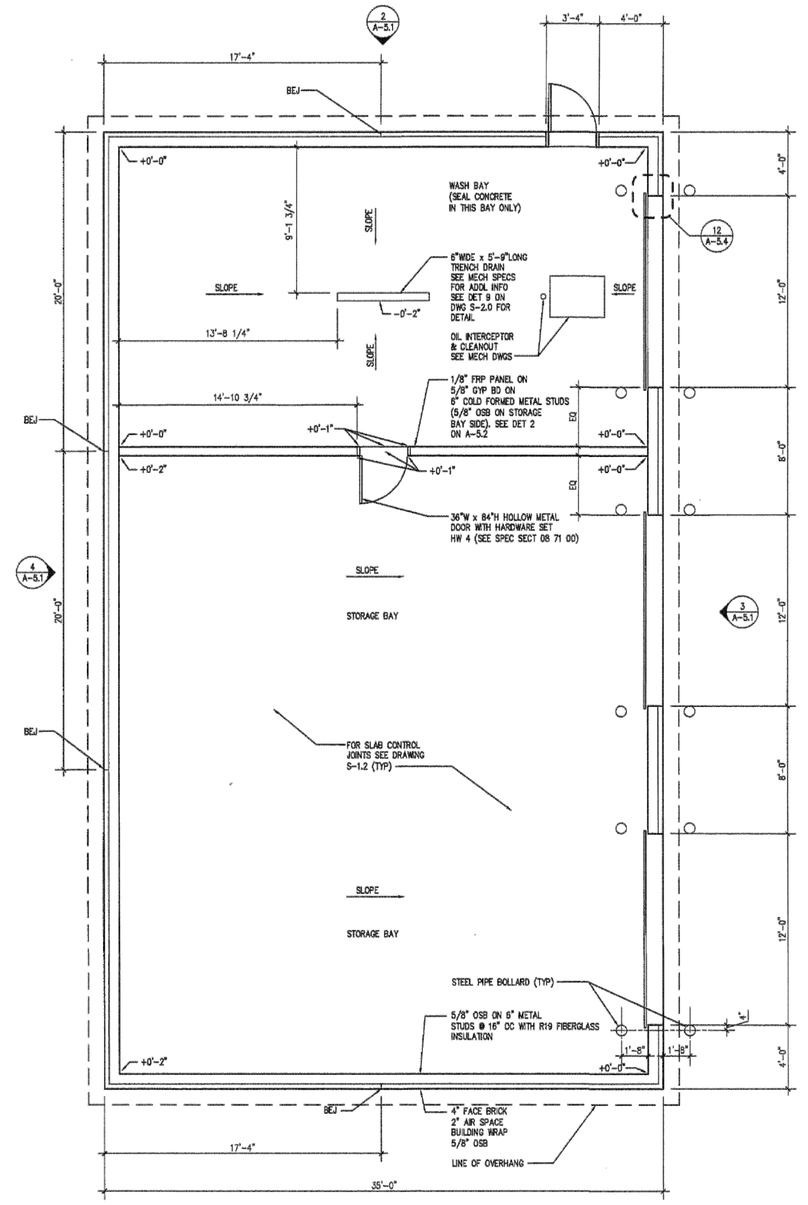

1 FLOOR PLAN
SCALE: 1/4"=1'-0"

GENERAL NOTES

1. SEAL ALL PENETRATIONS TO FACADE.
2. INSTALL ALL CONTROL JOINTS AT BRICK JOINTS.

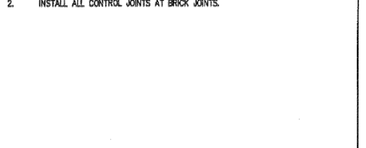

100% CONSTRUCTION DOCUMENTS SUBMITTAL

Revisions	Date

SMITHGROUP
architecture engineering interiors planning
SMITHGROUP, INC.
500 GRISWOLD
SUITE 1700
DETROIT, MICHIGAN 48226
T 313.983.3600
F 313.983.3836
www.smithgroup.com

Anderson Engineering of Minnesota, LLC
18005 1st AVENUE NORTH, SUITE 500, PLYMOUTH, MN 55441
TEL (763) 412-4000 FAX (763) 412-4000
www.ae-mn.com

NATIONAL CEMETERY ADMINISTRATION

Drawing Title	EQUIPMENT STORAGE & WASH BAY BUILDING
Project Title	CEMETERY SITE & HISTORIC BUILDING IMPROVEMENTS, WASHBAY, STORAGE BINS, ADMIN. BLDG. IMPROVEMENT
Date	FEB. 20, 2009
Project No.	817-CM3018
Approved: Director, Office of Construction Management	Building Number / Checked / Drawn
Approved: Director, Project Management Service	Location: MARION NATIONAL CEMETERY
DRAWING NO.	A-5.1
	Dwg. 48 OF 66

MAINTENANCE BUILDING AS-BUILT - ARCHITECTURAL PLAN

NOT TO SCALE

one inch = one hundred feet
0 100 200
10

Revisions	Date

NATIONAL CEMETERY ADMINISTRATION

FINAL FOR CONSTRUCTION

Drawing Title: **MAINT BLDG AS-BUILT ARCHITECTURAL PLAN**	Project Title: **ADMIN & MAINT BLDG IMPROVEMENTS**		Date: **3/22/2018**
Approved: Division Chief	Building Number: -----	Checked	Drawn: **RNE**
Approved: Service Director	Location: **MARION NATIONAL CEMETERY**		Project No.: **817-18-106**
			DRAWING NO. **L-2**
			Dwg. **3** Of **6**