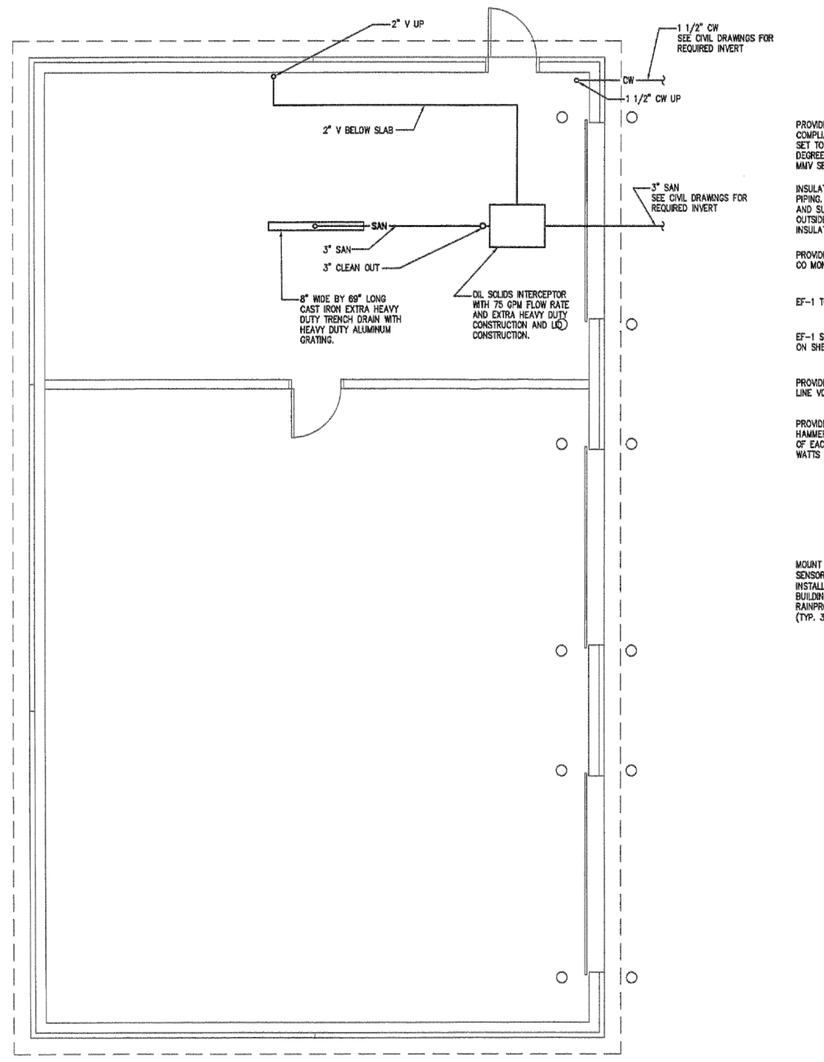

2 UNDERGROUND PLUMBING FLOOR PLAN
SCALE: 1/4"=1'-0"

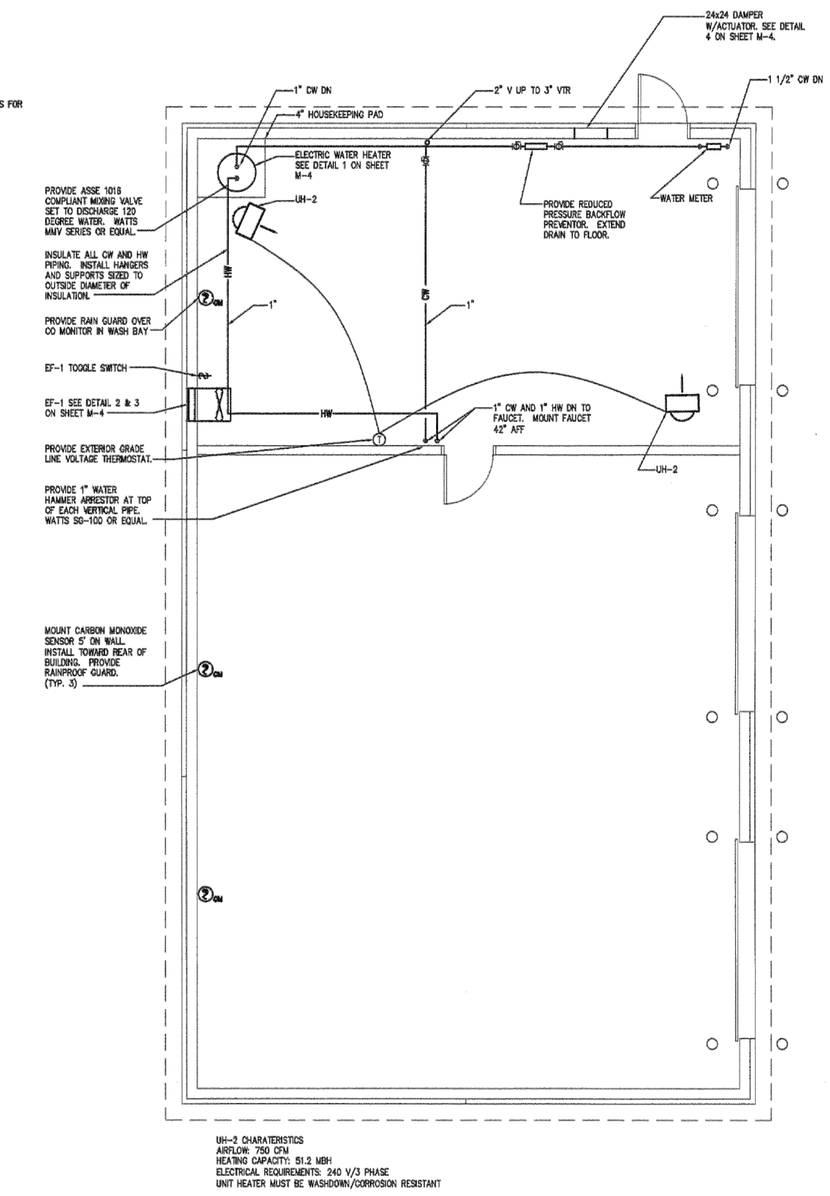

UH-2 CHARATERISTICS
AIRFLOW: 750 CFM
HEATING CAPACITY: 51.2 MBH
ELECTRICAL REQUIREMENTS: 240 V/3 PHASE
UNIT HEATER MUST BE WASHDOWN/CORROSION RESISTANT

1 MECHANICAL AND PLUMBING FLOOR PLAN
SCALE: 1/4"=1'-0"

100% CONSTRUCTION DOCUMENTS SUBMITTAL

Revisions	Date

SMITHGROUP
architecture engineering interiors planning
SMITHGROUP, INC.
500 GRISWOLD
SUITE 1700
DETROIT, MICHIGAN 48226
T 313.983.3800
F 313.983.3836
www.smithgroup.com

Anderson Engineering of Minnesota, LLC
10900 1st AVENUE NORTH, SUITE 100, PLYMOUTH, MN 55441
TEL (763) 412-4000 FAX (763) 412-4020
www.ae-mn.com

NATIONAL CEMETERY ADMINISTRATION

Drawing Title	WASH BAY BUILDING MECHANICAL AND PLUMBING PLAN
Approved: Director, Office of Construction Management	
Approved: Director, Project Management Service	
Project Title	CEMETERY SITE & HISTORIC BUILDING IMPROVEMENTS, WASHBAY, STORAGE BINS, ADMIN. BLDG. IMPROVEMENT
Building Number	
Checked	
Drawn	
Location	MARION NATIONAL CEMETERY
Date	FEB. 20, 2009
Project No.	817-CM3018
DRAWING NO.	M-3
Dwg. 61 Of 66	

MAINTENANCE BUILDING AS-BUILT - MECHANICAL AND PLUMBING PLAN

NOT TO SCALE

Revisions	Date

one inch = one hundred feet
0 100 200
10

NATIONAL CEMETERY ADMINISTRATION

FINAL FOR CONSTRUCTION

Drawing Title	MAINT BLDG AS-BUILT MECHANICAL AND PLUMBING PLAN
Approved: Division Chief	
Approved: Service Director	
Project Title	ADMIN & MAINT BLDG IMPROVEMENTS
Building Number	-----
Checked	
Drawn	RNE
Location	MARION NATIONAL CEMETERY
Date	3/22/2018
Project No.	817-18-106
DRAWING NO.	L-3
Dwg. 4 Of 6	